
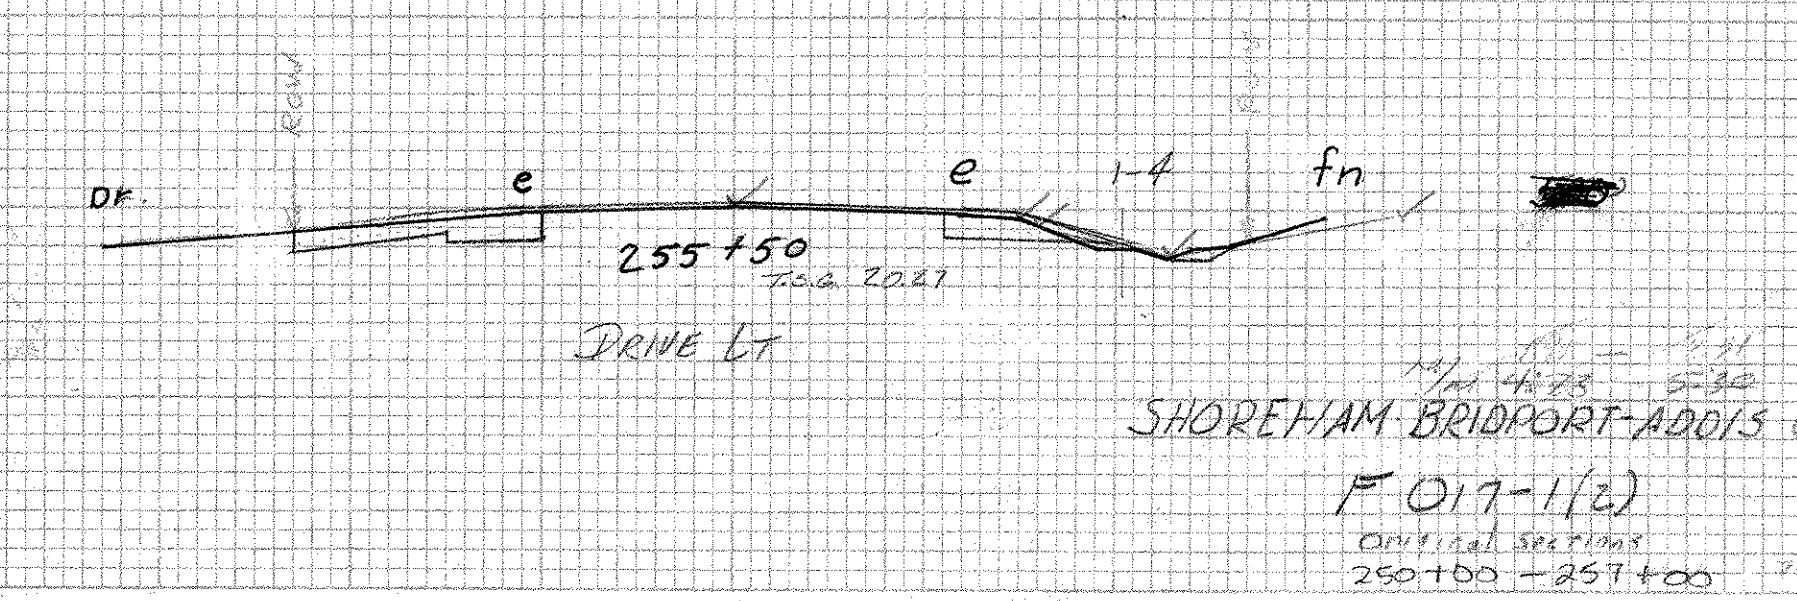
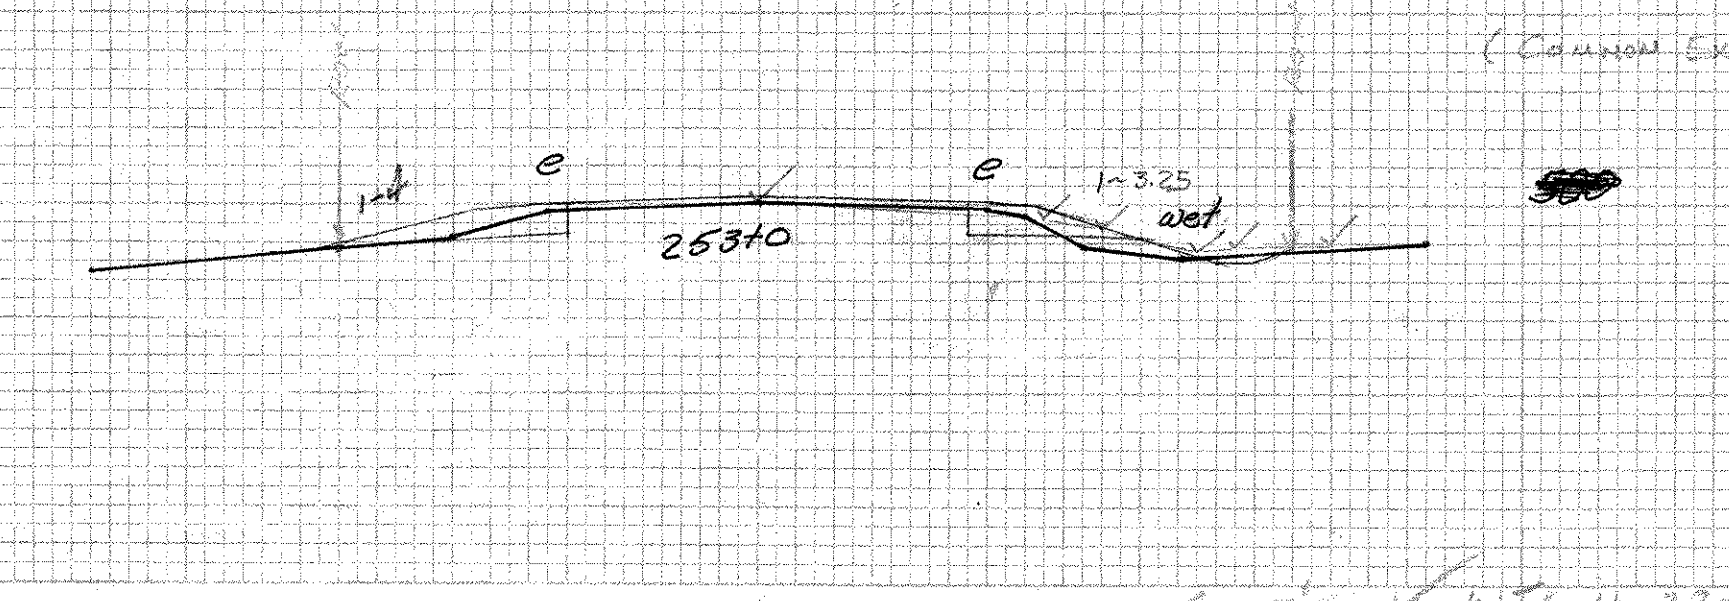
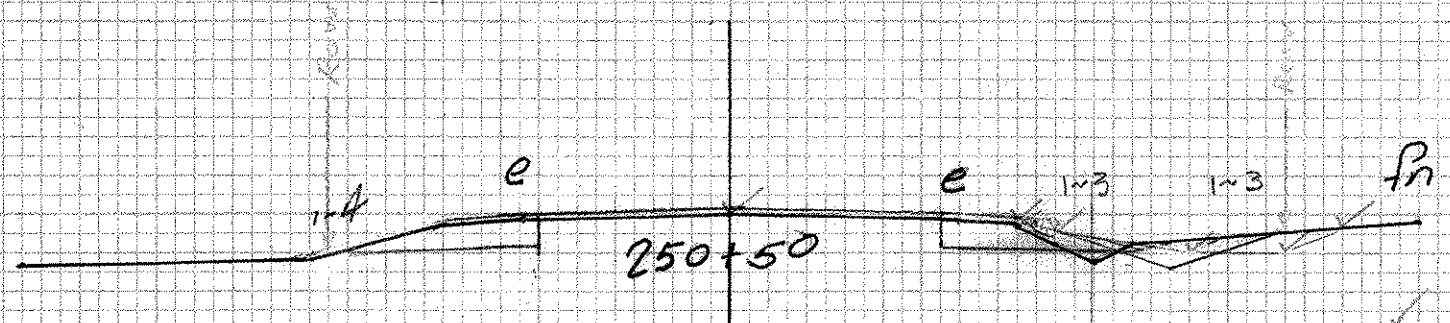
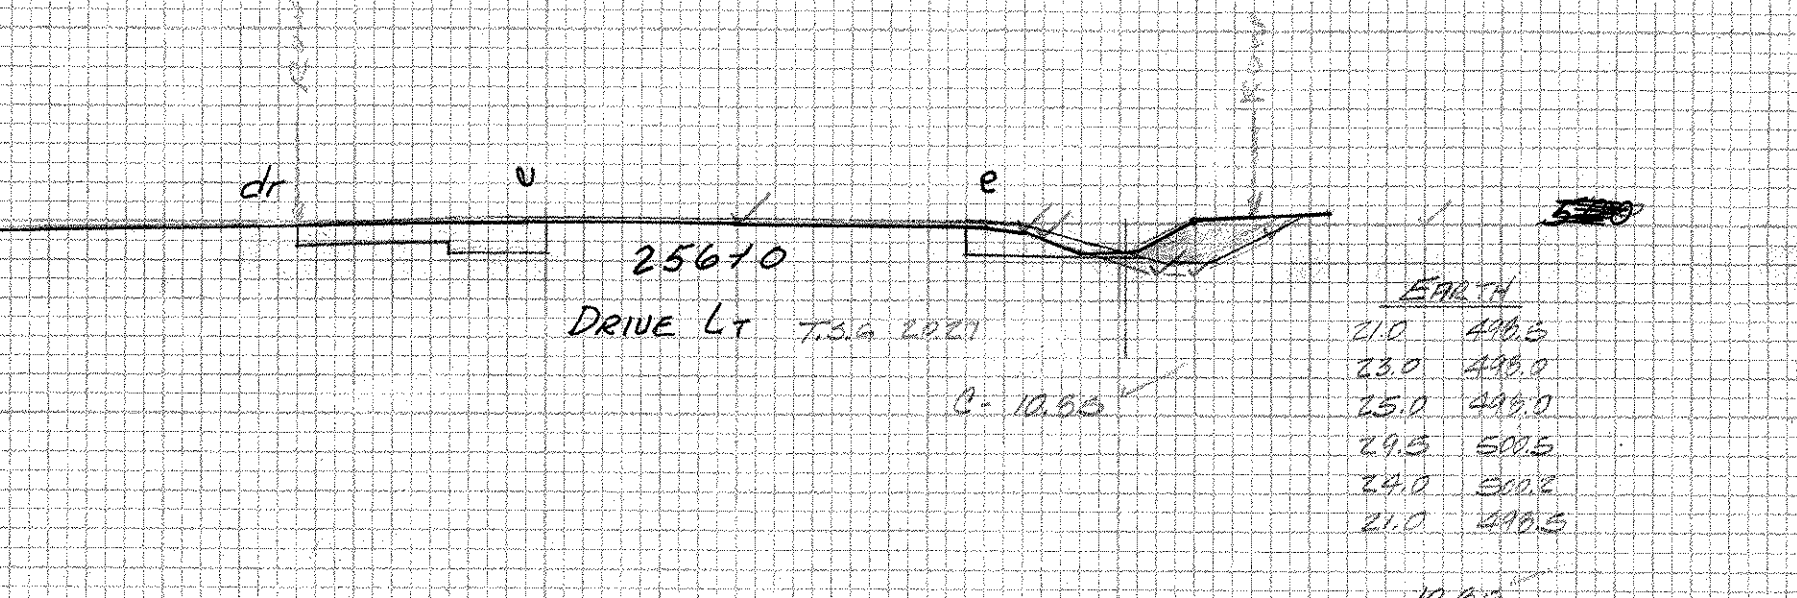
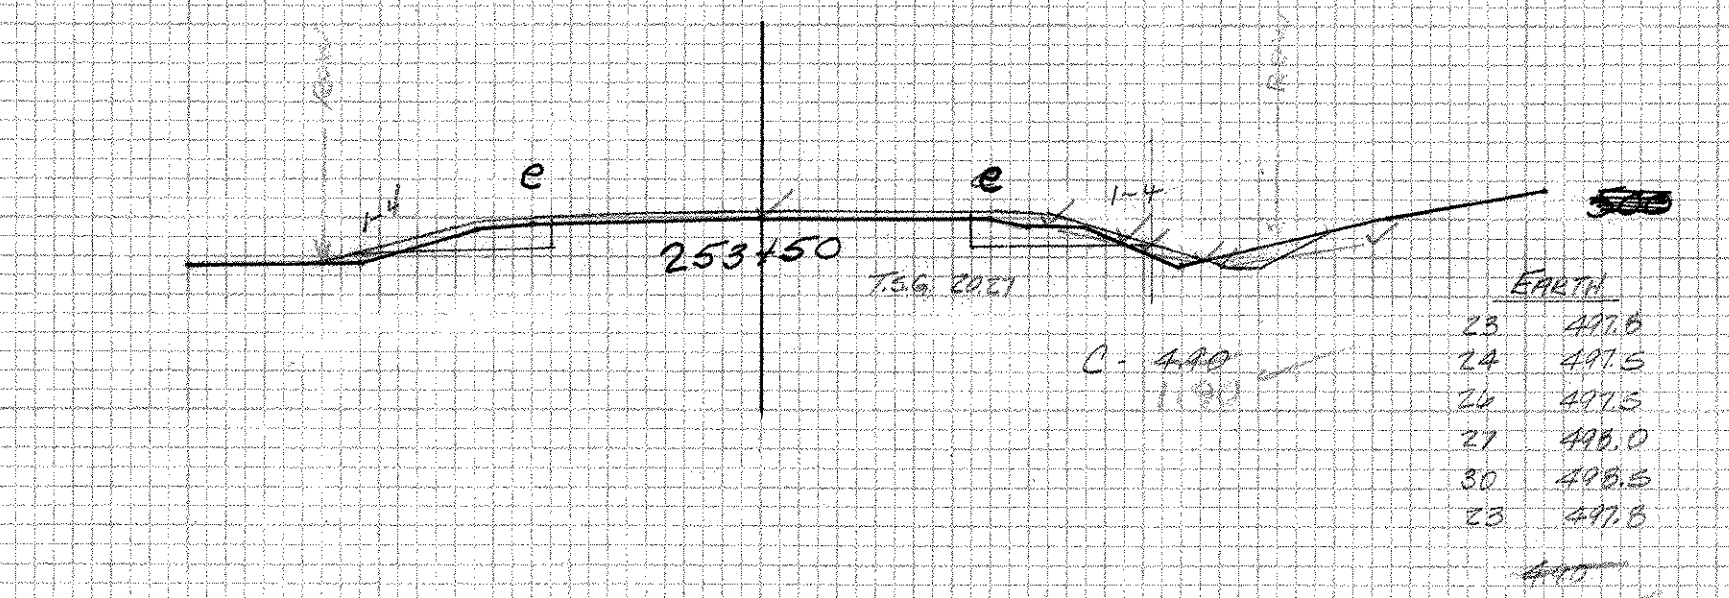
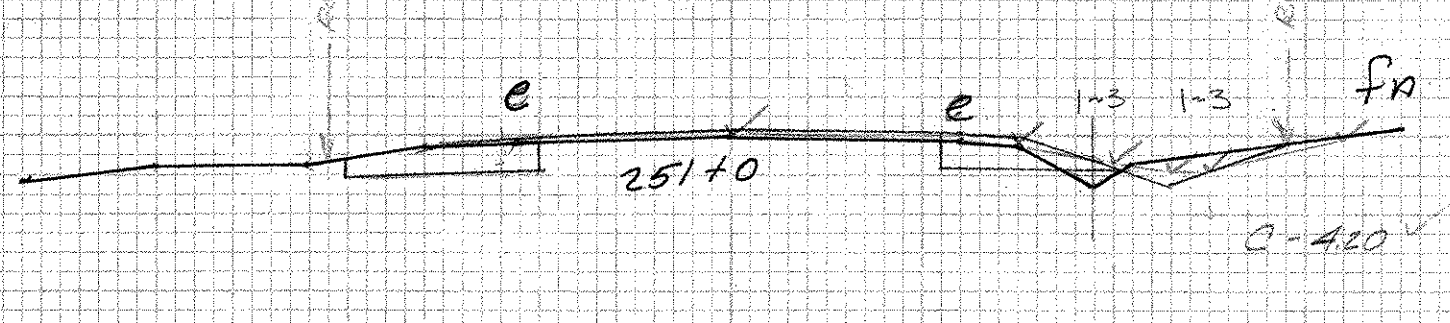
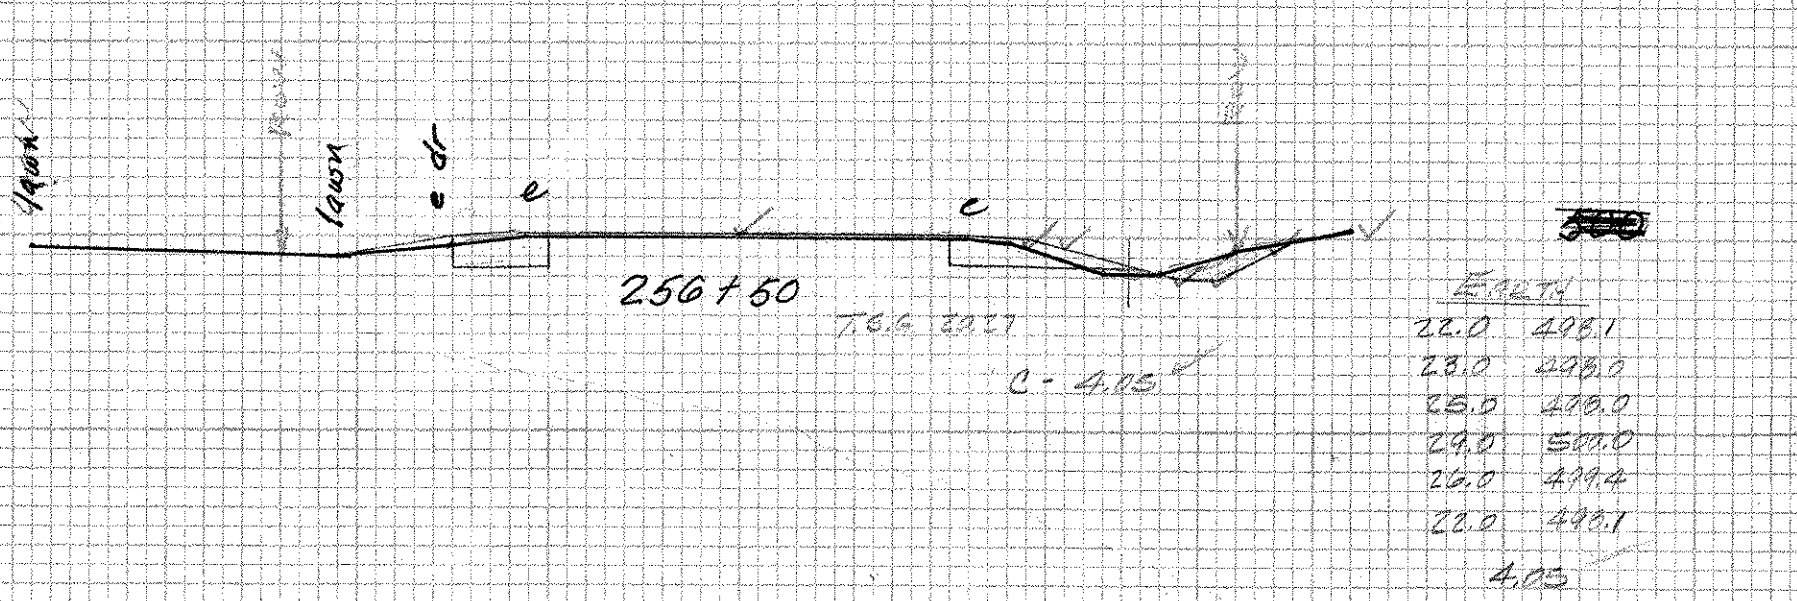
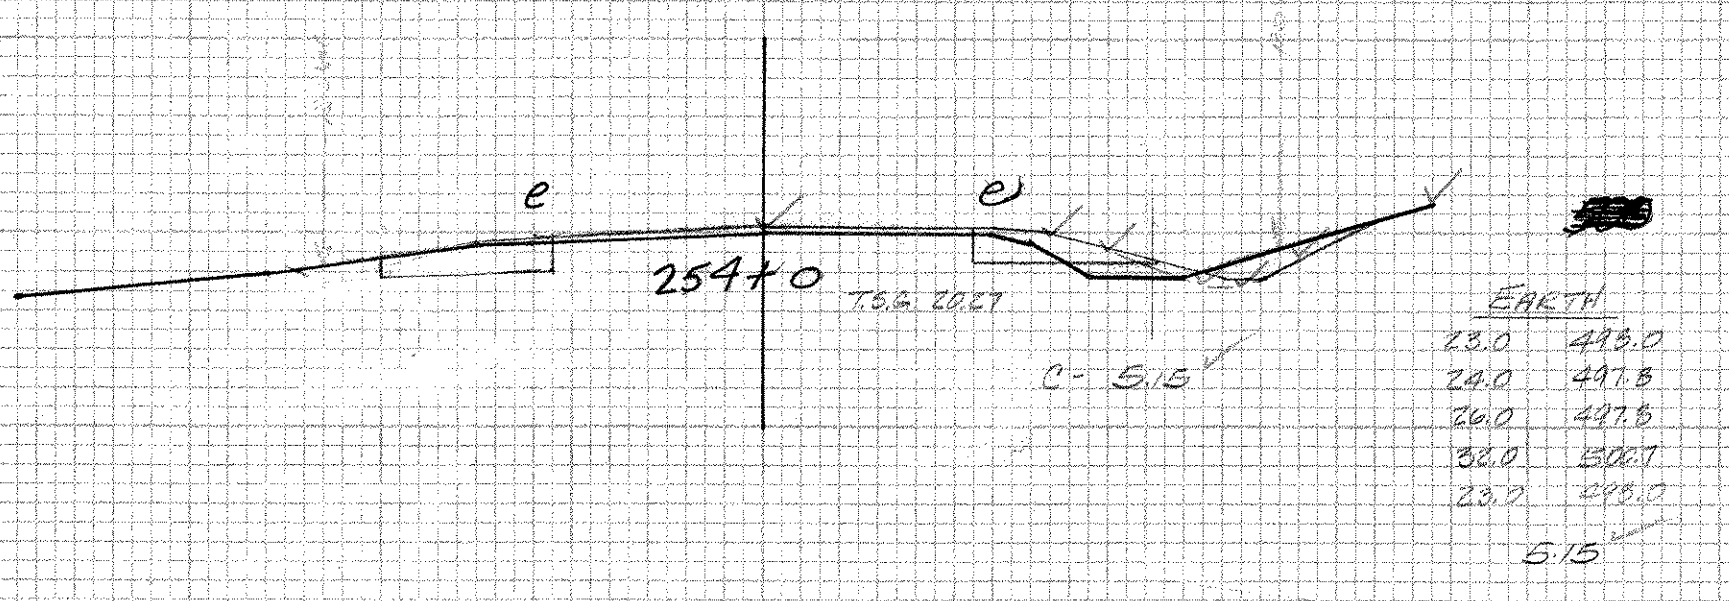
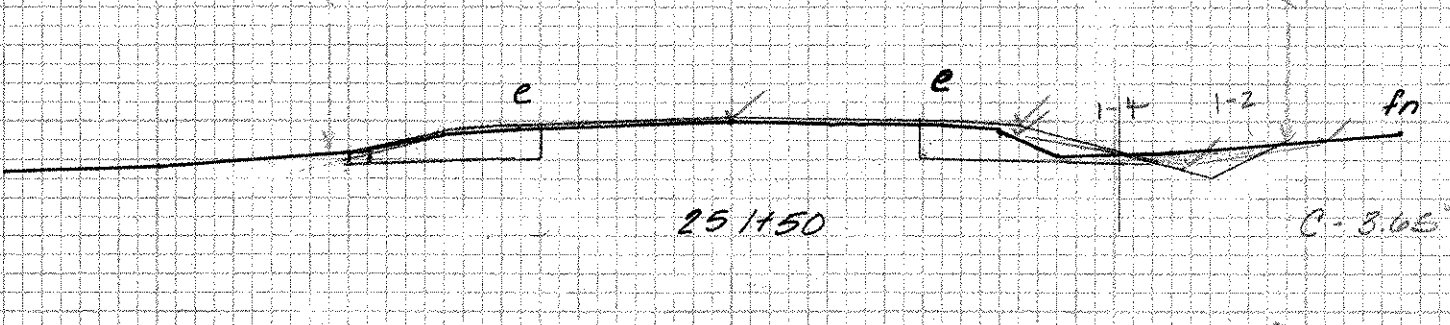
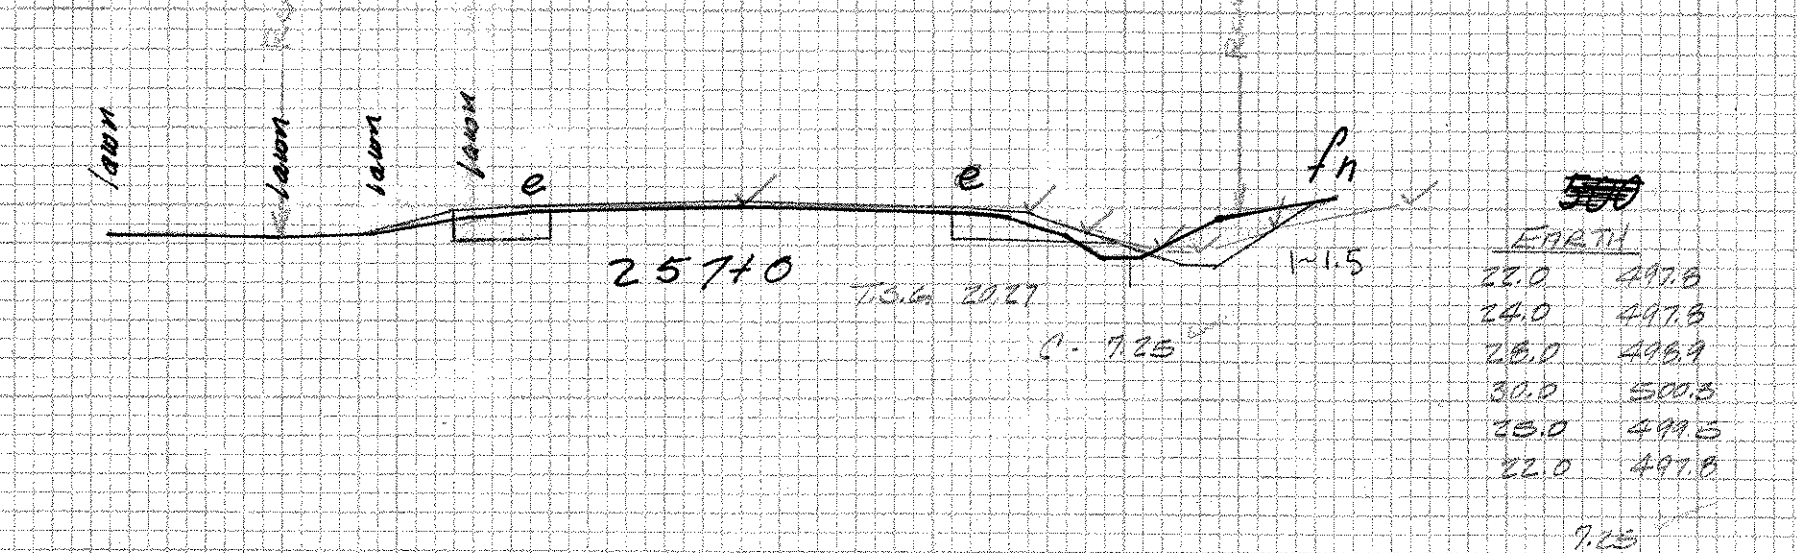
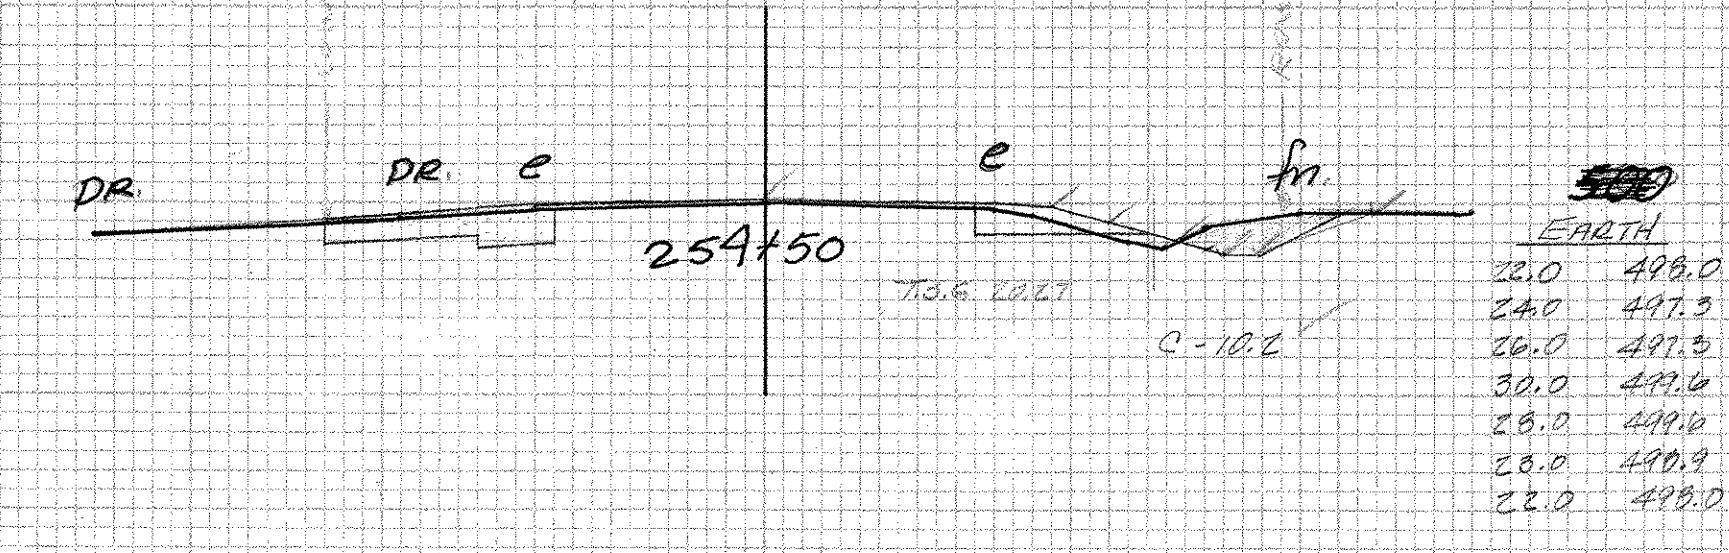
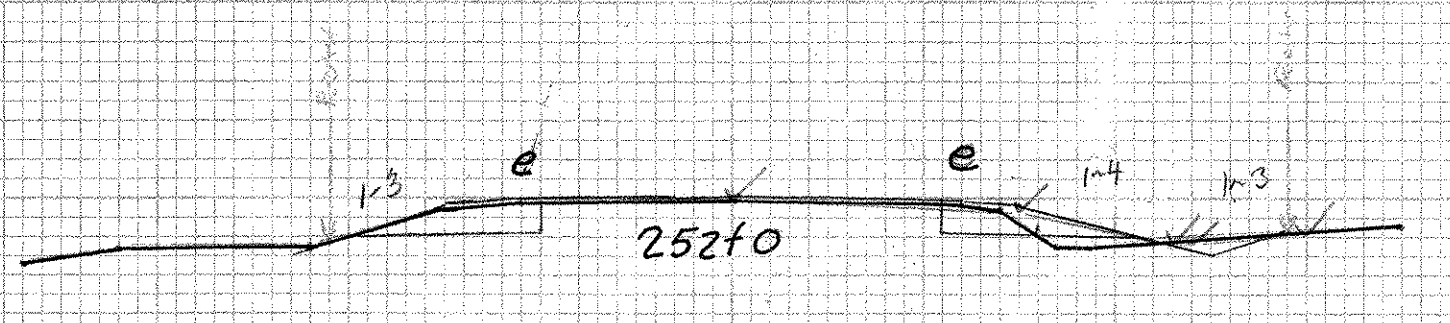
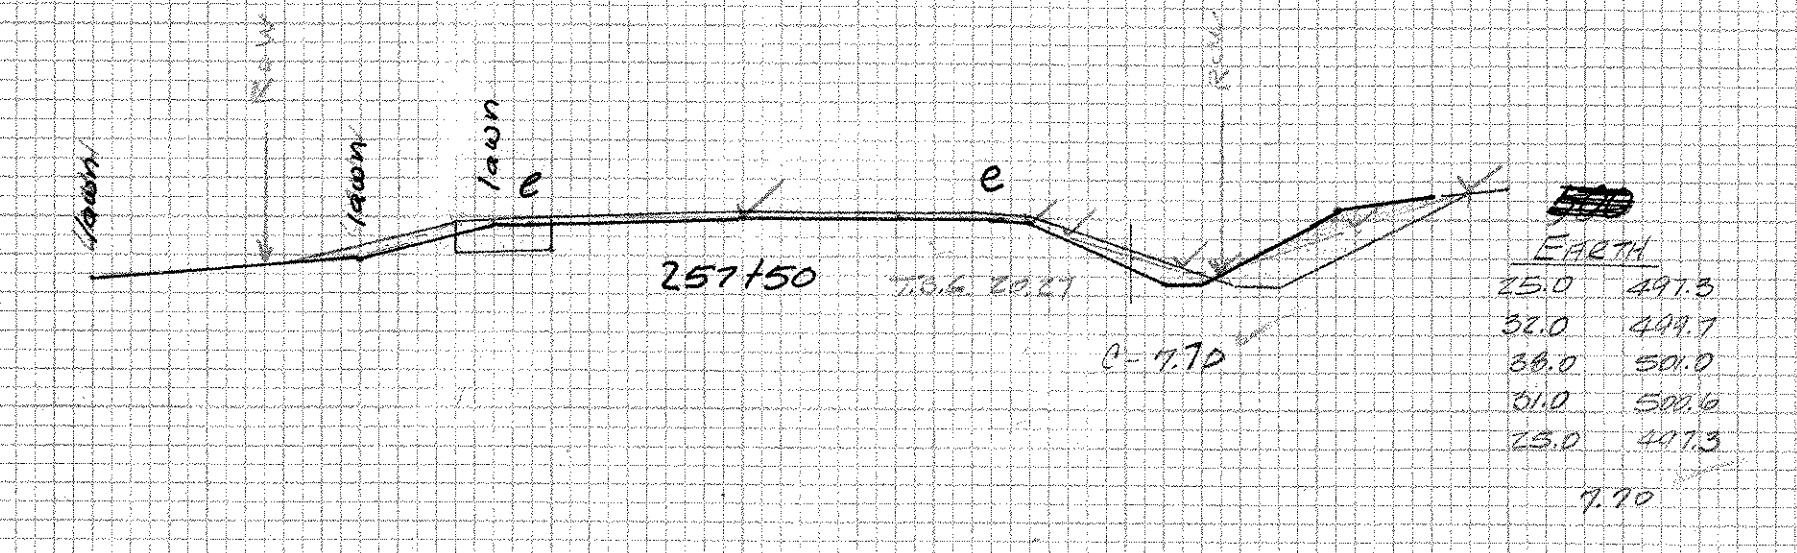
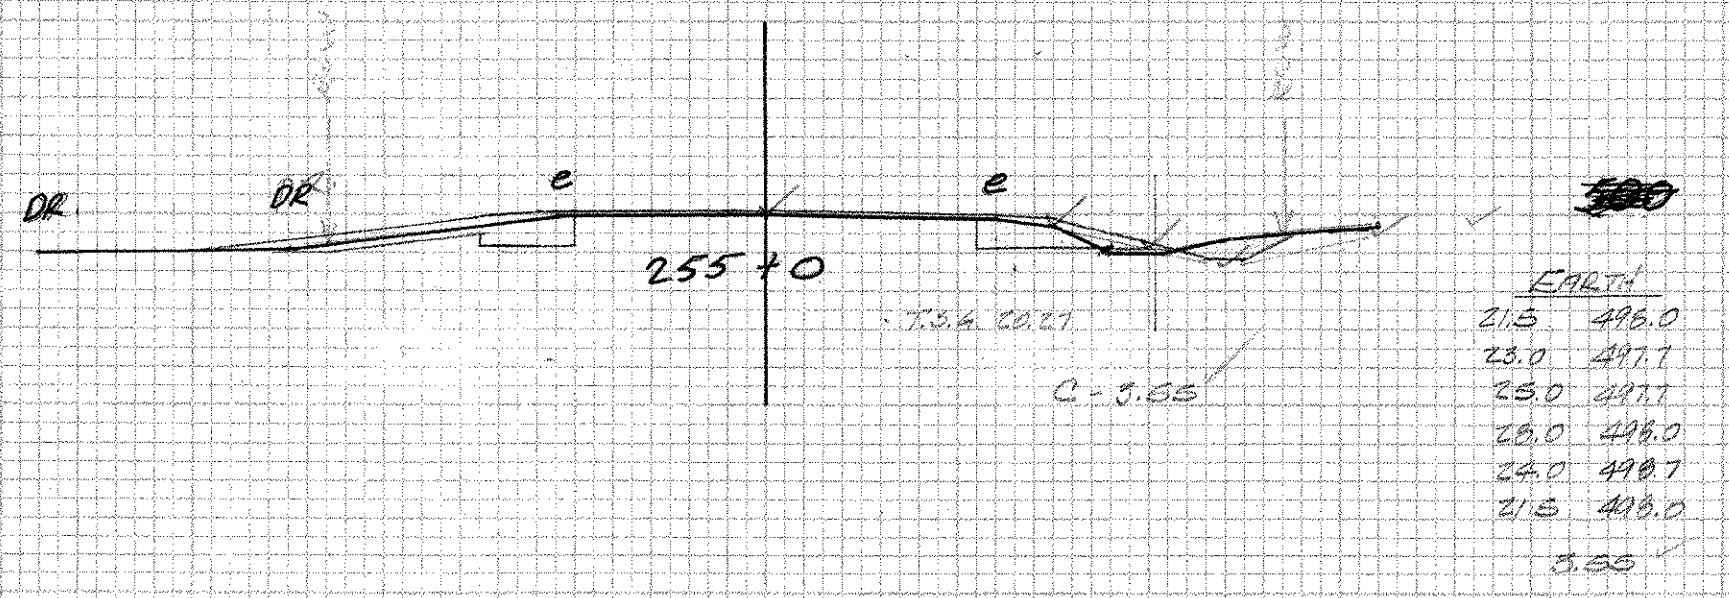


DATE _____ BY _____
 SURVEYED _____ BY _____
 ORIGINAL SURVEY NOTE BOOK NO. _____
 SURVEYED _____ BY _____
 ORIGINAL SURVEY NOTE BOOK NO. _____

DATE _____ BY _____
 SURVEYED _____ BY _____
 ORIGINAL SURVEY NOTE BOOK NO. _____
 SURVEYED _____ BY _____
 ORIGINAL SURVEY NOTE BOOK NO. _____

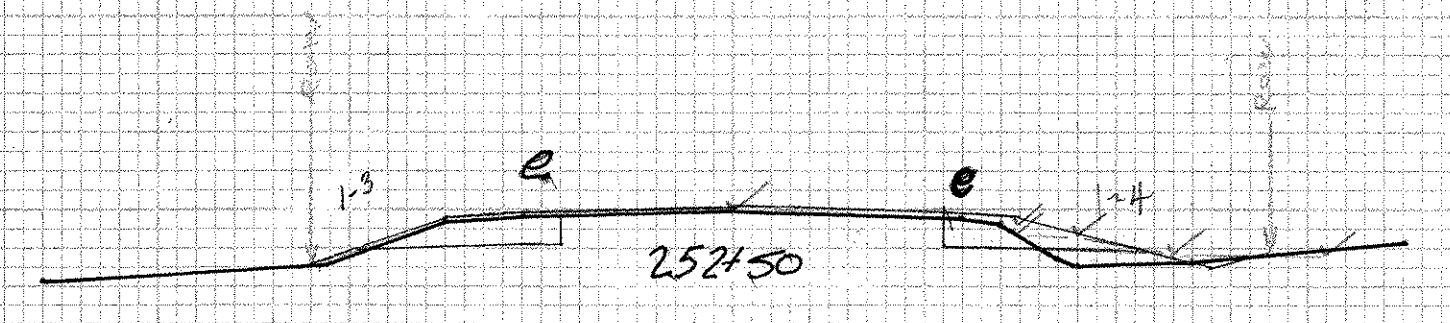

CONSTRUCT SPECIAL DITCH
 STA. 253+00 TO RT
 (COMMON EXC.)

SHOREHAM BRIDPORT ADJIS ON
 F 017-1(2)
 ORIGINAL SECTION
 250+00 - 257+00