

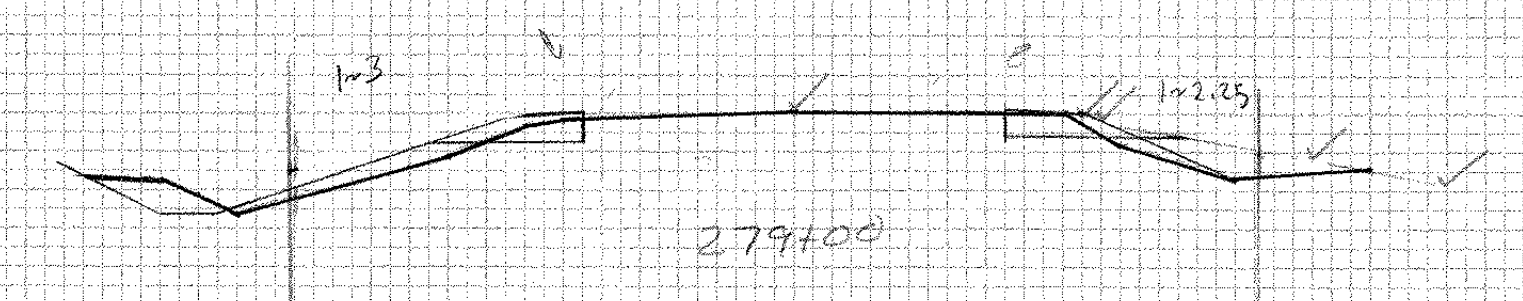


EARTH

22.0	498.5
24.5	500.2
32.5	501.9
34.0	501.9
26.0	499.1
22.0	498.5
8.15	

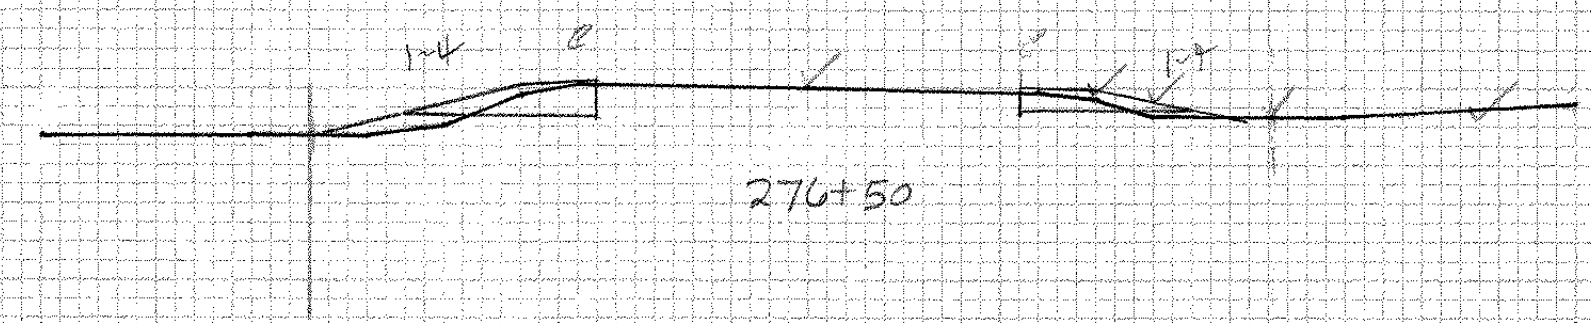


279+25 ~ 280+25 LT
CONSTRUCT SPECIAL DITCH
(COMMON EXCAV.)


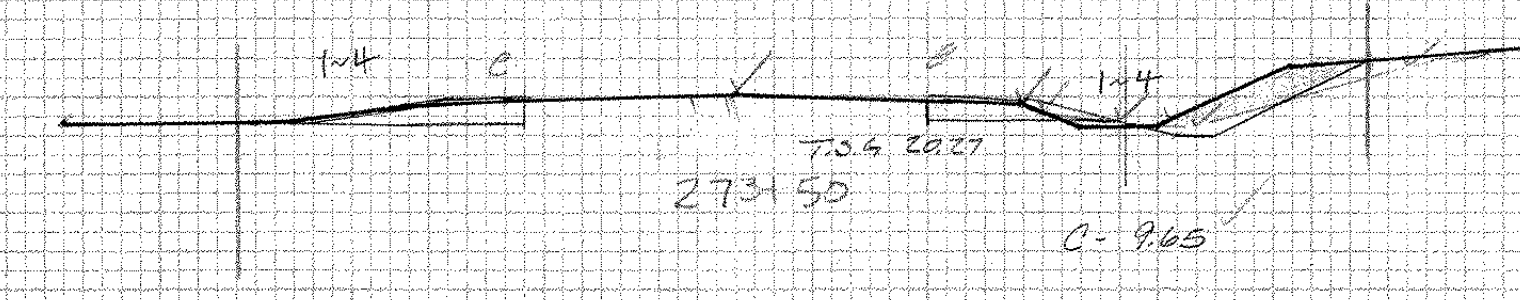


EARTH

22.0	498.5
24.0	498.6
27.0	500.0
32.0	502.0
27.0	500.7
22.0	498.5
9.65	


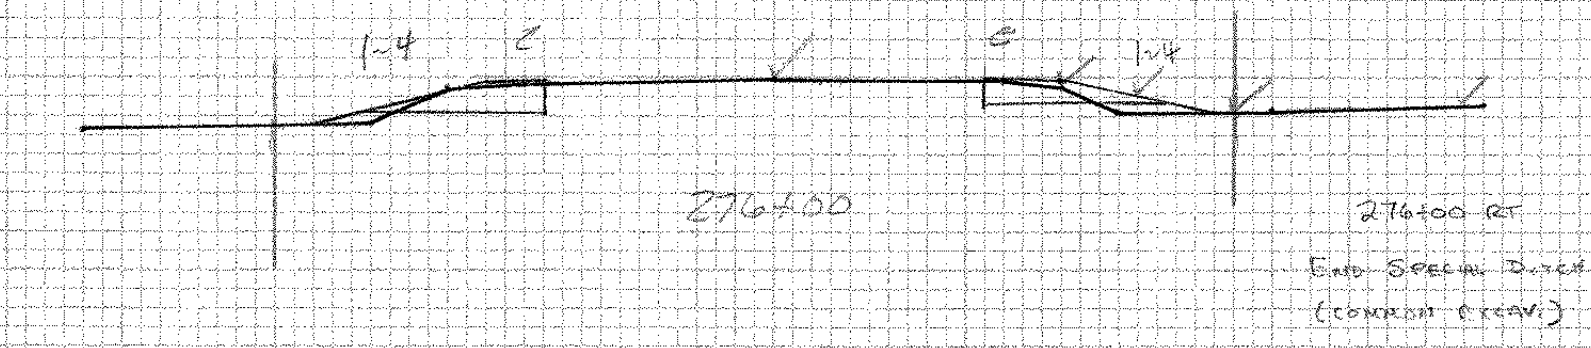


276+00 or
Exc. Special Ditch
(COMMON EXCAV.)

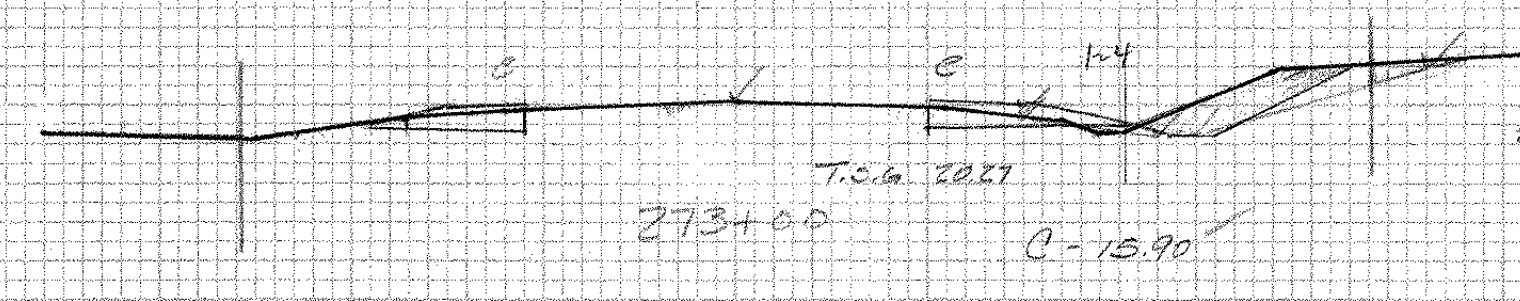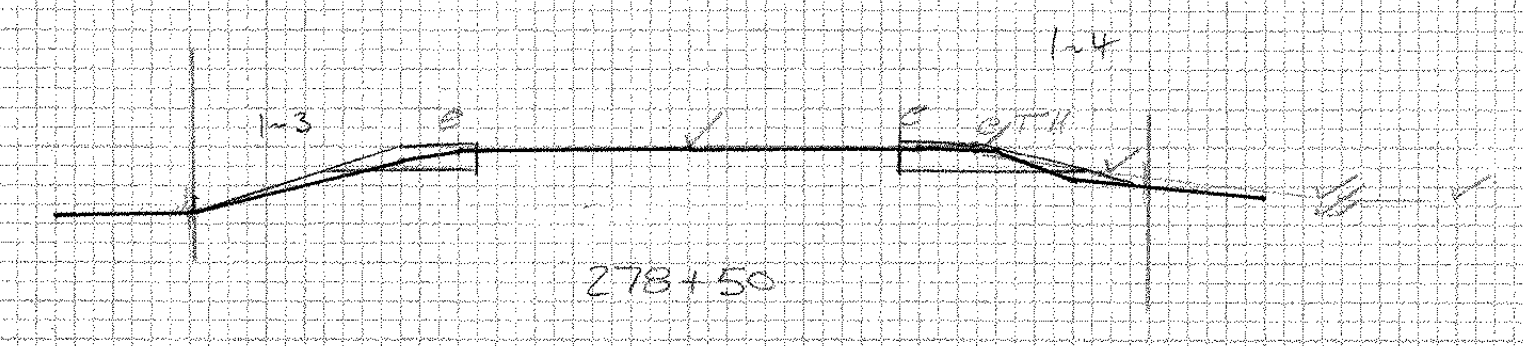


EARTH

21.0	499.0
23.0	498.4
25.0	499.2
32.0	502.0
23.0	500.0
21.0	499.0
15.90	

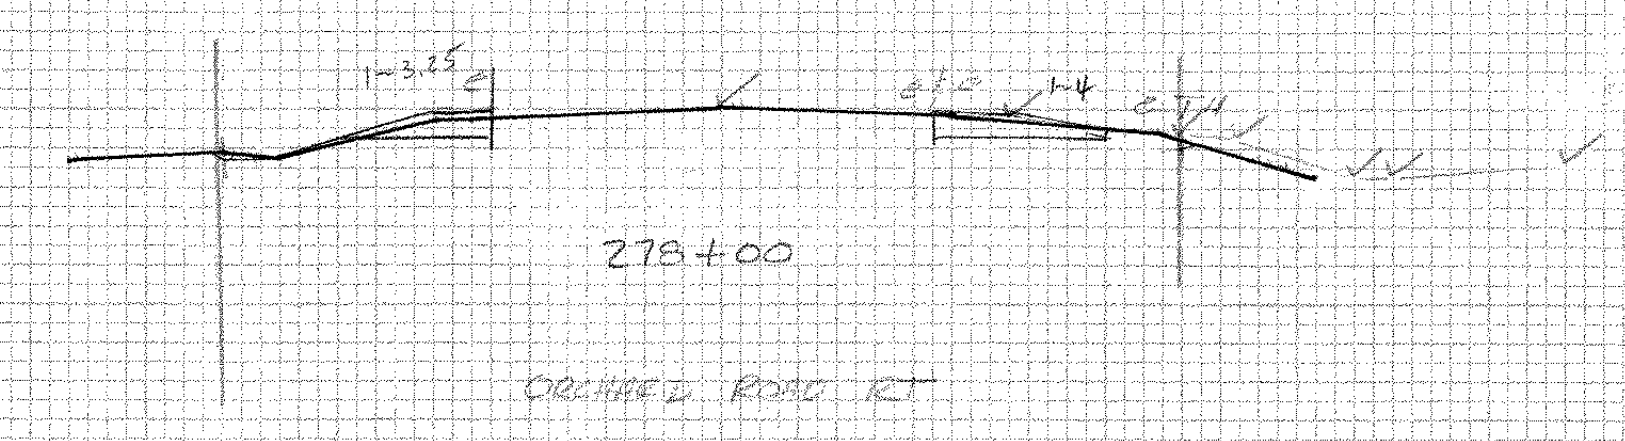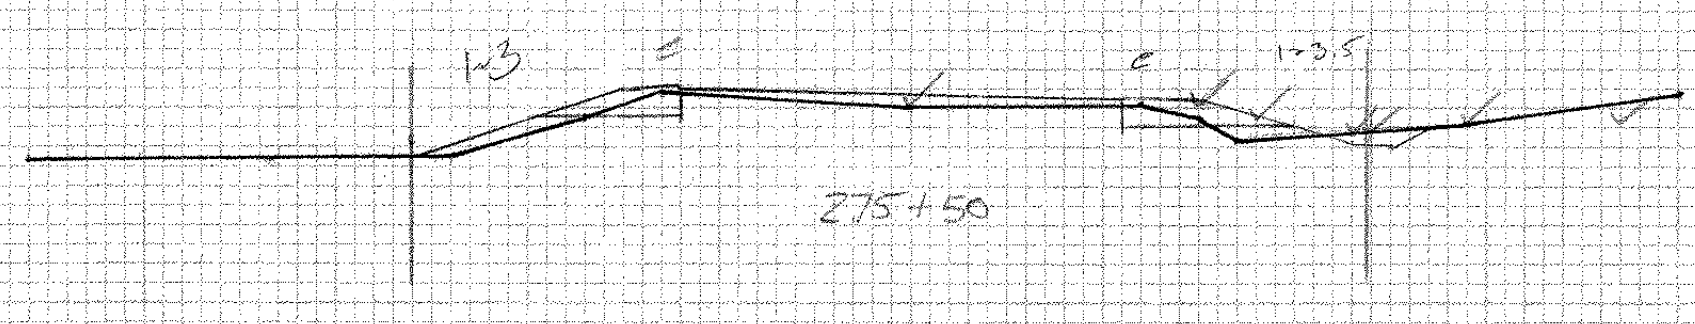


CONSTRUCT ROAD RT

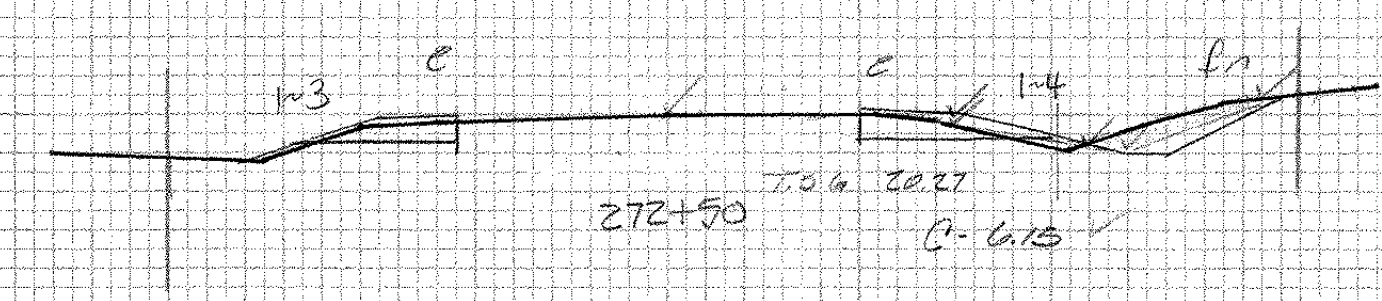


EARTH

24.0	498.5
24.0	498.5
28.0	500.9
24.0	500.6
22.0	498.5
6.15	

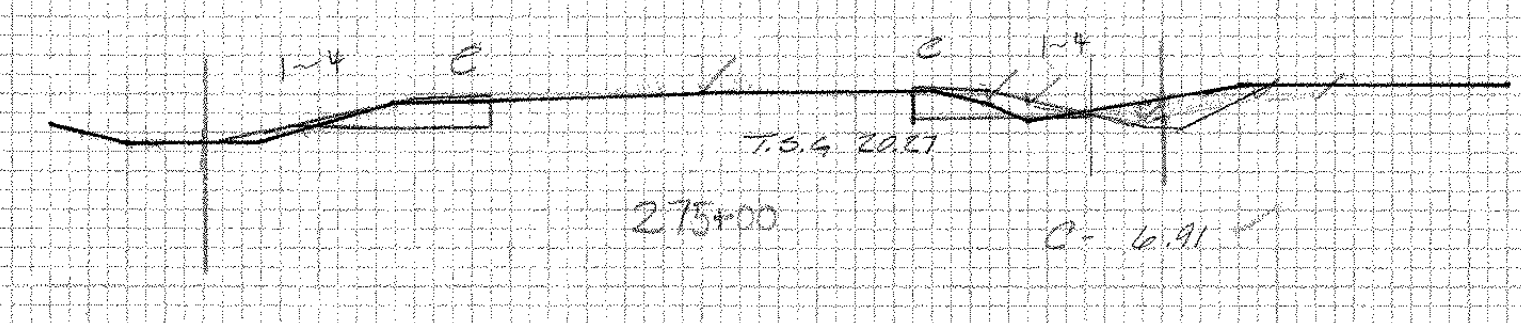


EARTH

20.27	499.0
23.0	498.5
26.0	499.6
29.5	500.5
28.0	500.5
20.27	499.0
6.91	

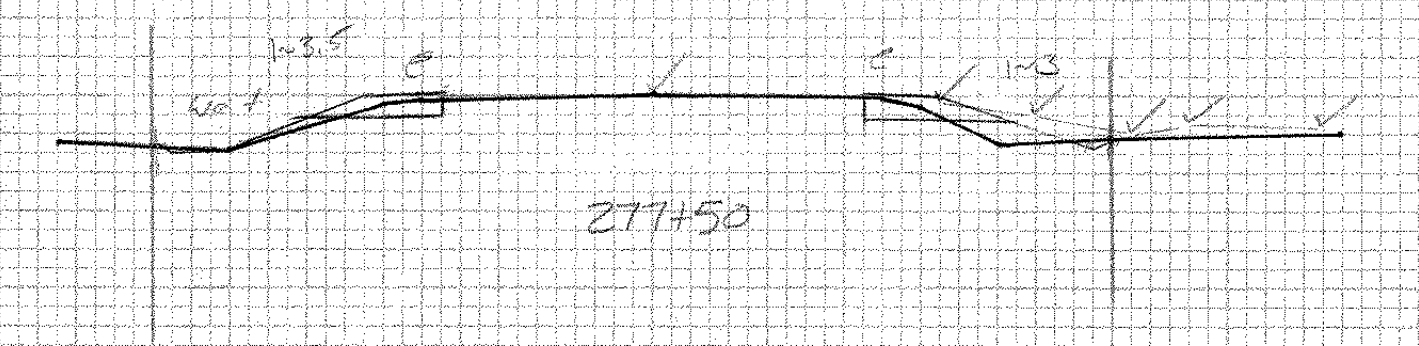


277+25 ~ 278+25
DITCH CLEANING TO R.O.W.
(TO BE PAID TRUCK & EXC. EQUIP.)

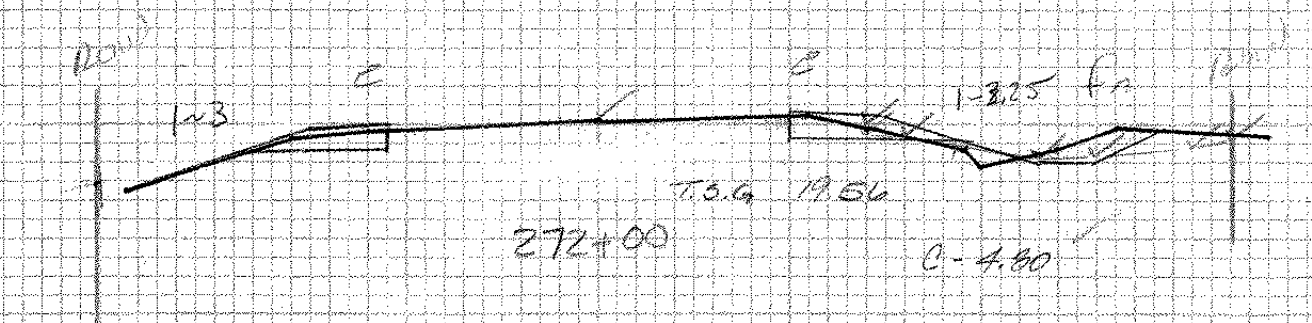


EARTH

25.0	498.5
26.0	498.3
27.0	498.4
29.2	499.7
27.0	499.7
23.0	498.3
4.80	

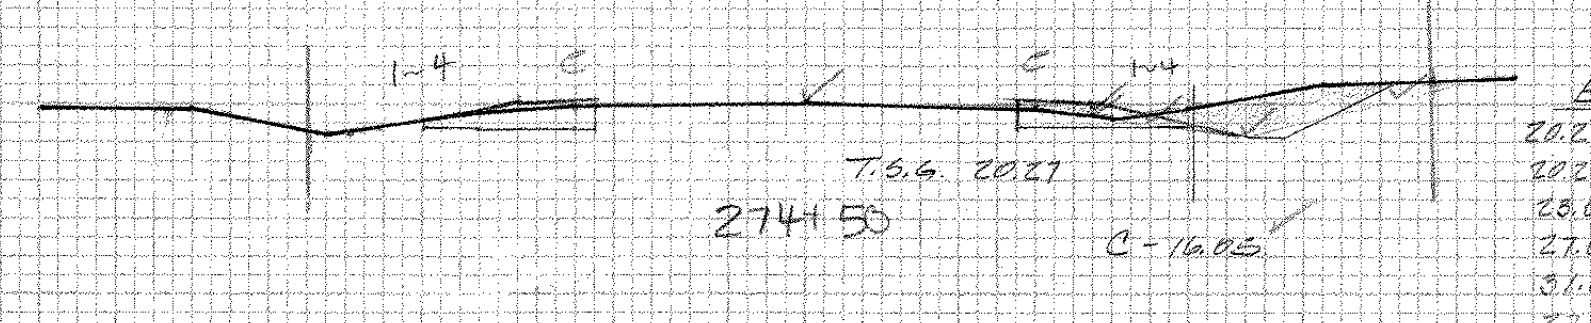

EARTH

20.27	499.1
20.27	498.6
20.0	498.4
27.0	499.0
31.0	501.0
27.0	501.0
20.27	499.1
16.05	

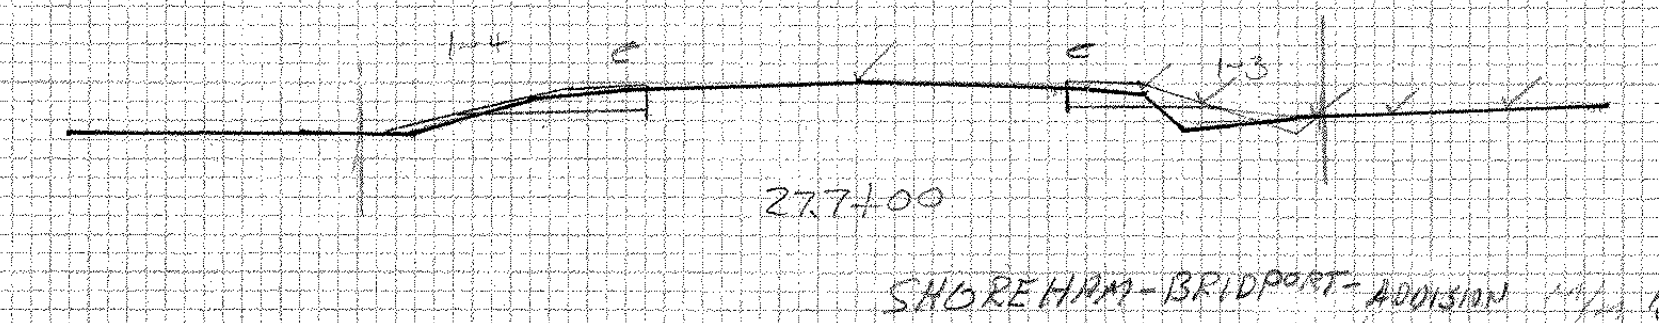

SHOREHAM-BRIDPORT DIVISION 11/14/2001
277-1(2)
15/1/02

272+00 - 279+00

918 W. St. George

FINAL SURVEY NOTE BOOK NO. DATE BY

ORIGINAL SURVEY NOTE BOOK NO. DATE BY