
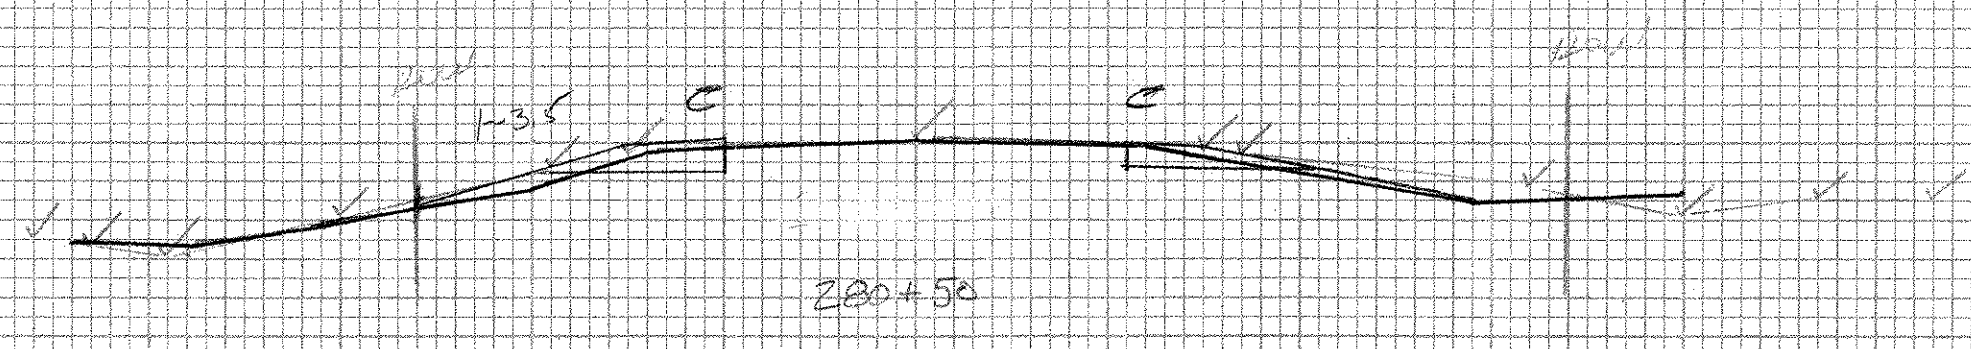
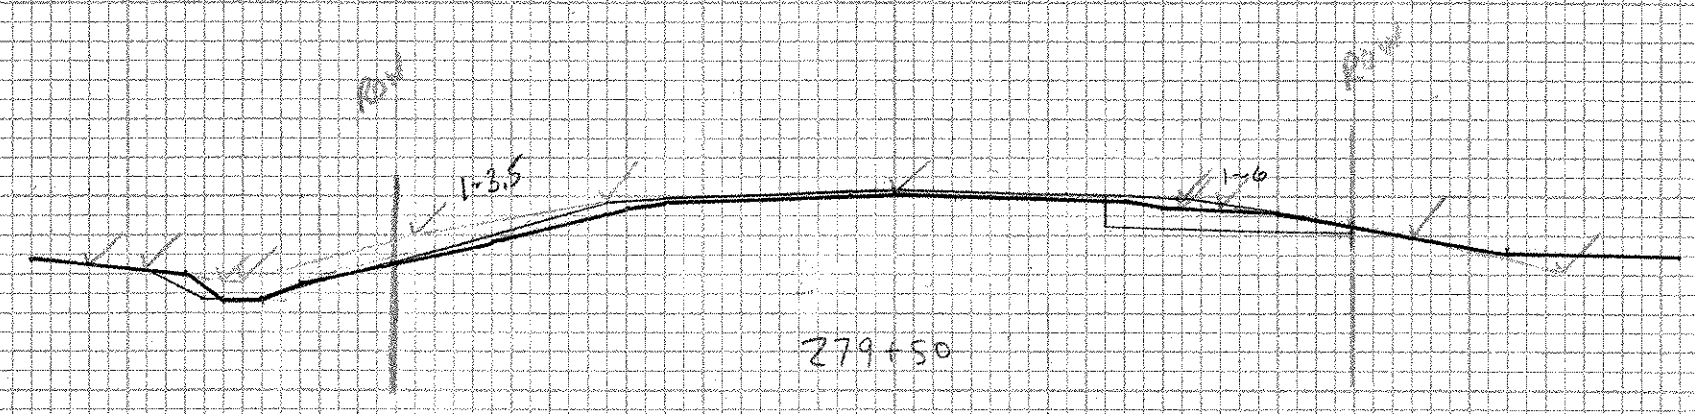


280+25 LT  
END SPECIAL DRIVE  
(COMMON CENTER)

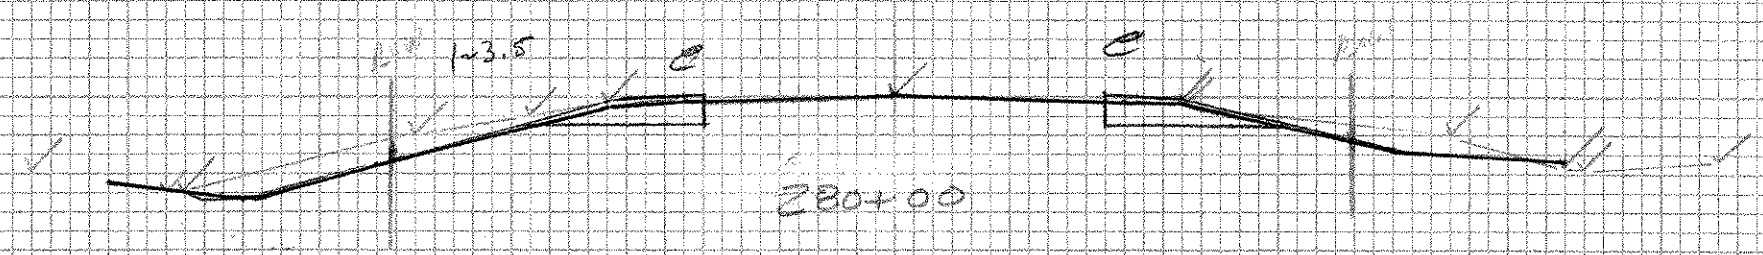

SHOREHAM - BRIDPORT - ADDISCON  
FO17-107  
ORIGINAL SECTIONS

279+50 = 280+50

Plotted by W.J. GIDSEY

DATE	
BY	
SURVEYED	
TEMPERATURE	
WIND	
FIELD CORRECTIONS	
FINAL SURVEY NOTE BOOK No.	

DATE	
BY	
SURVEYED	
TEMPERATURE	
WIND	
FIELD CORRECTIONS	
ORIGINAL SURVEY NOTE BOOK No.	