


FINAL SURVEY NOTE BOOK No. _____
 SURVEYED BY _____
 DATE _____


ORIGINAL SURVEY NOTE BOOK No. _____
 SURVEYED BY _____
 DATE _____

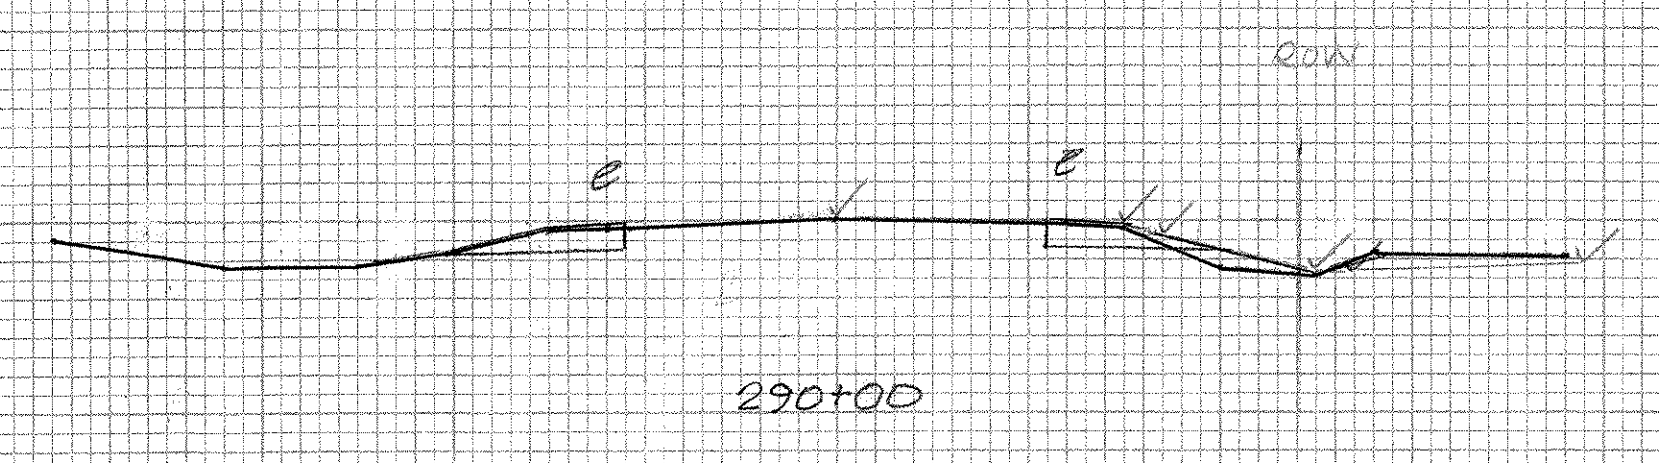

Earth

28.0	498.5
24.0	498.4
26.0	498.7
28.0	498.5
25.0	498.3
23.0	498.0











2.65

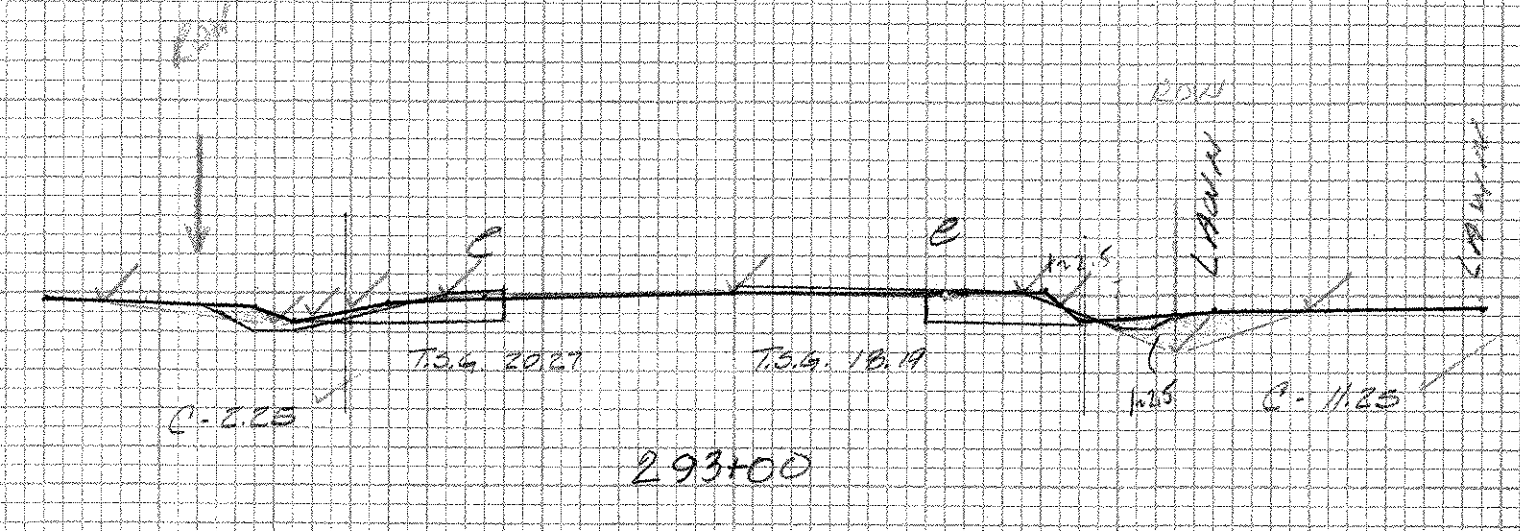

Earth

19.0	498.8
23.0	498.0
26.0	498.1
25.0	498.1
19.0	498.5

11.25

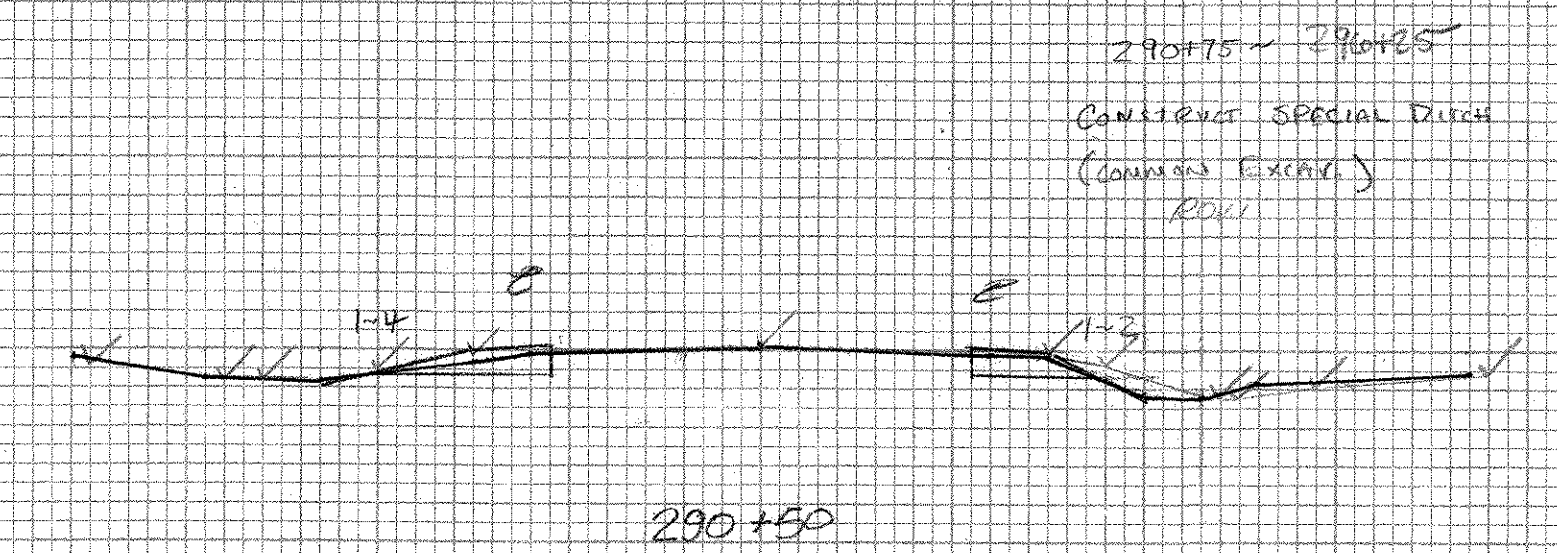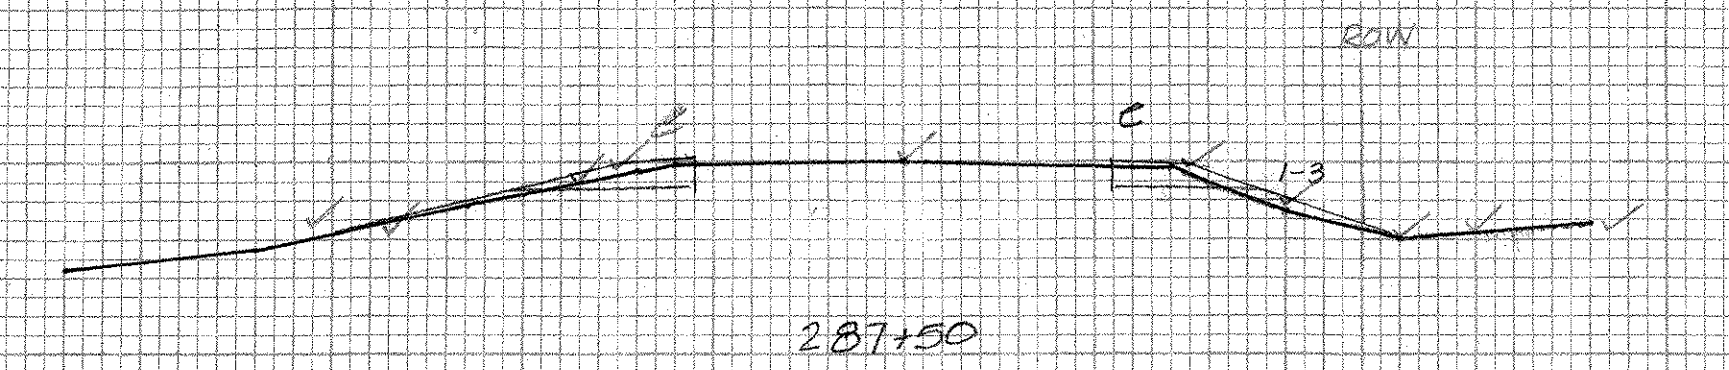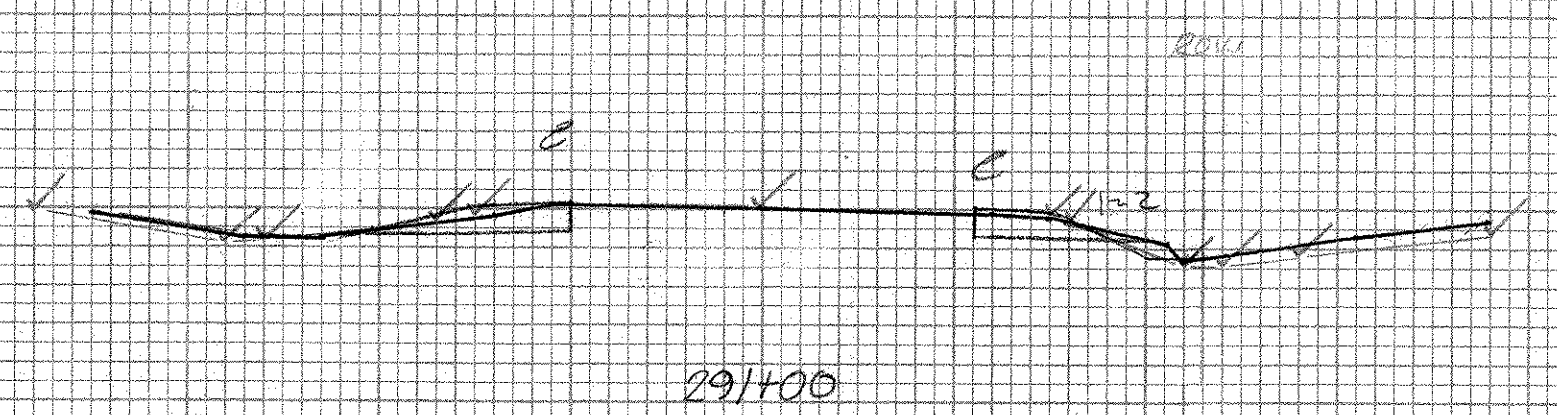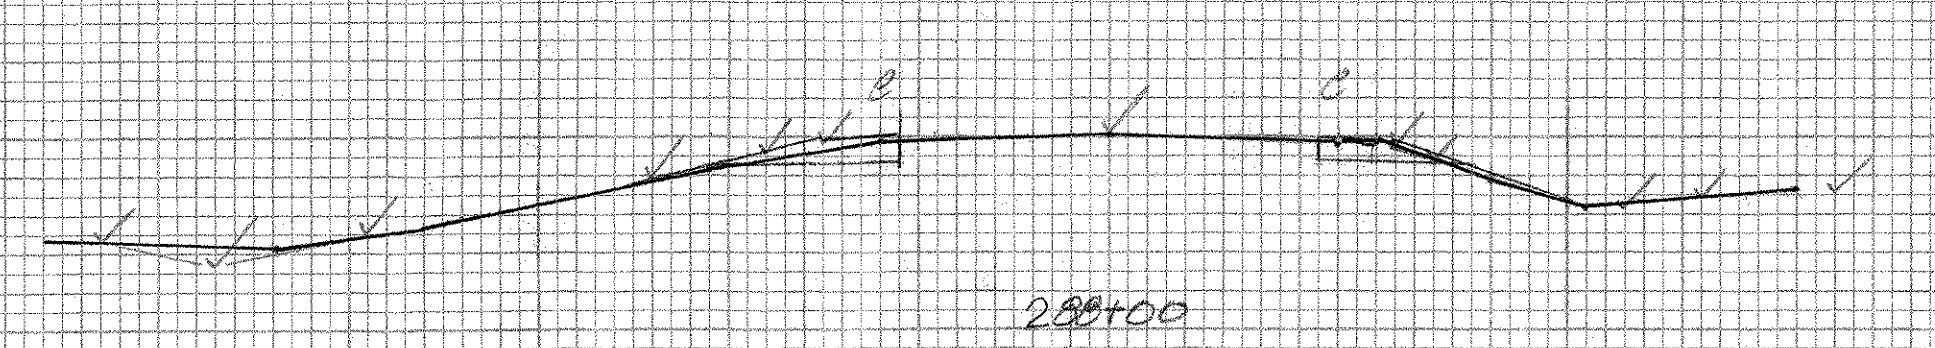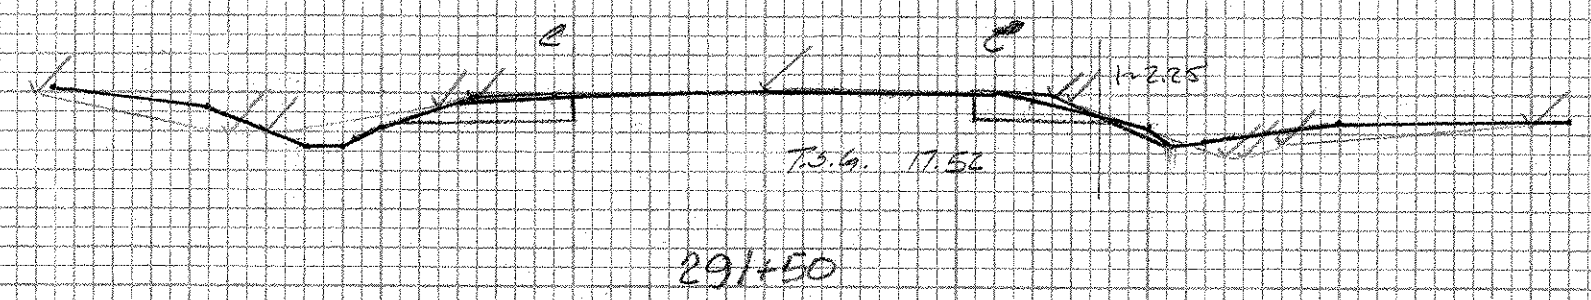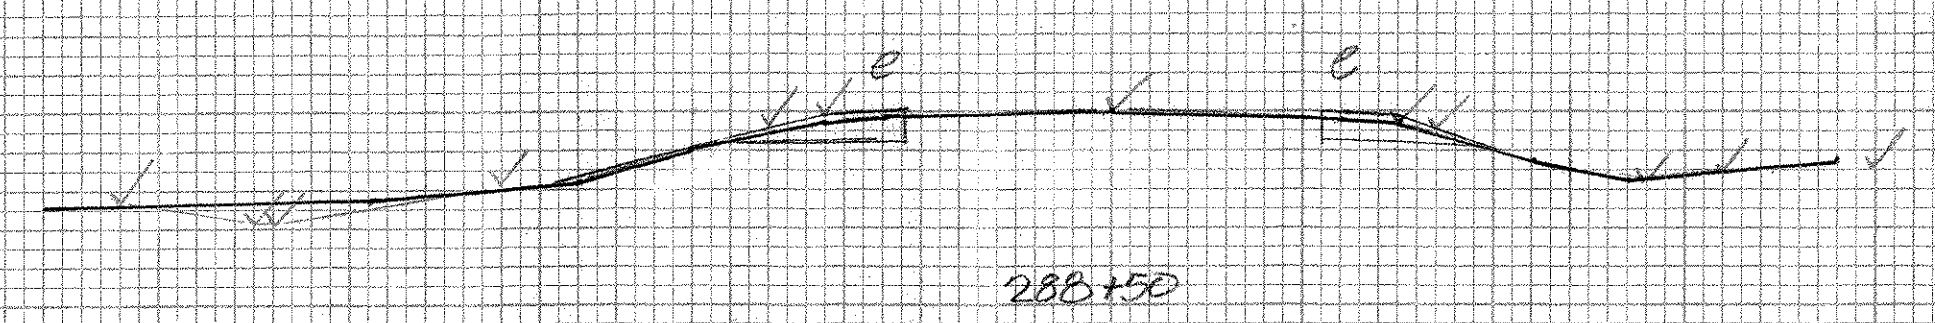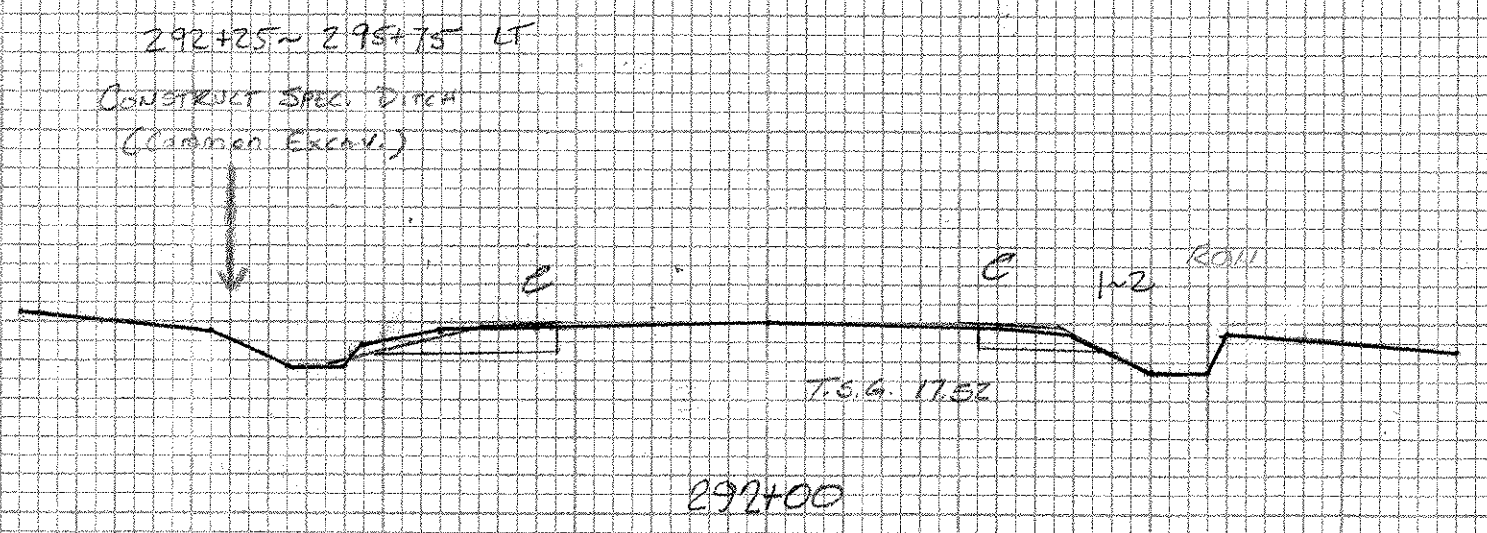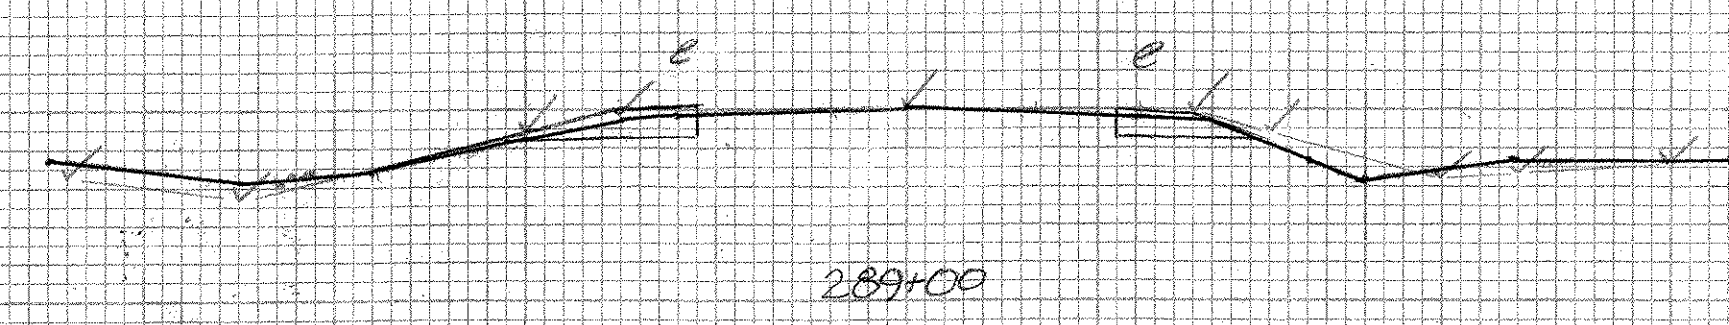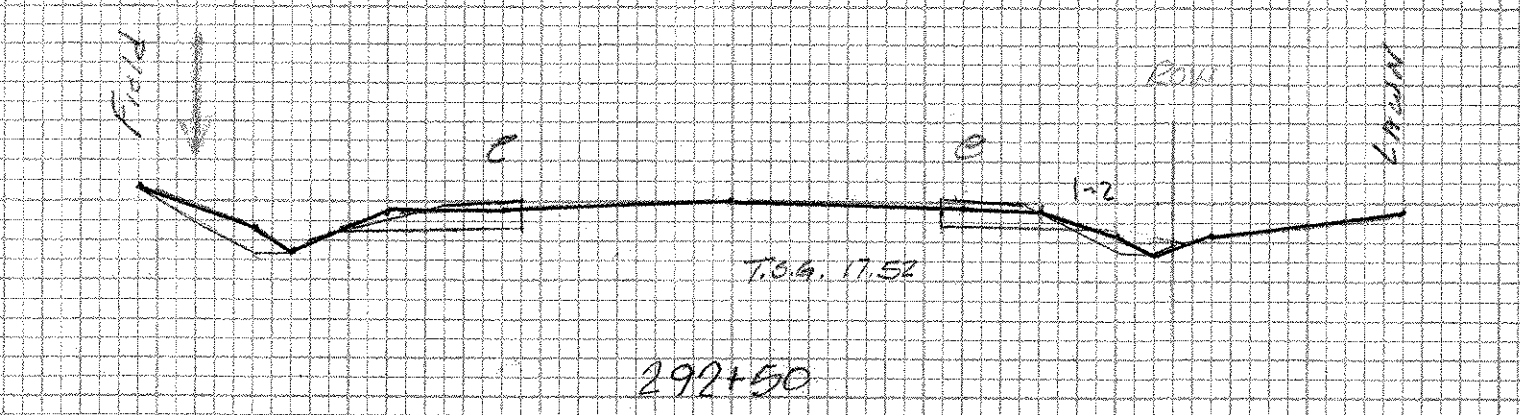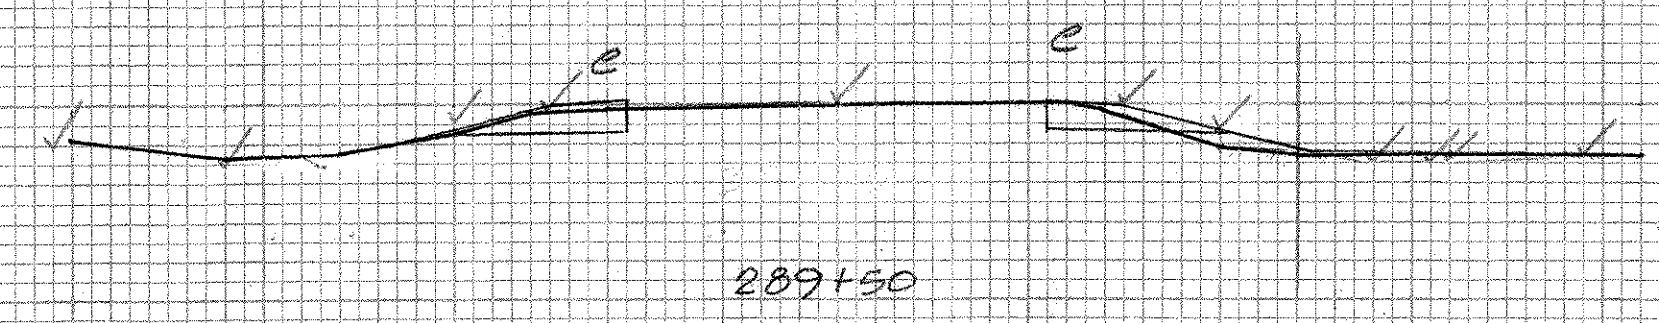

SHOREHAM-BRIDPORT HADDISWY
 F017-1C2)
 ORIGINAL SECTIONS

Plotted by A.J. [unclear]
 1-3-91