


161+50

290


161+23 ~ 161+90 Rt.  
Ditching ~ To be paid as All  
Purpose Excavator Rental & Truck Rental

161+23 Rt.  
12" CGMP ~ Retain

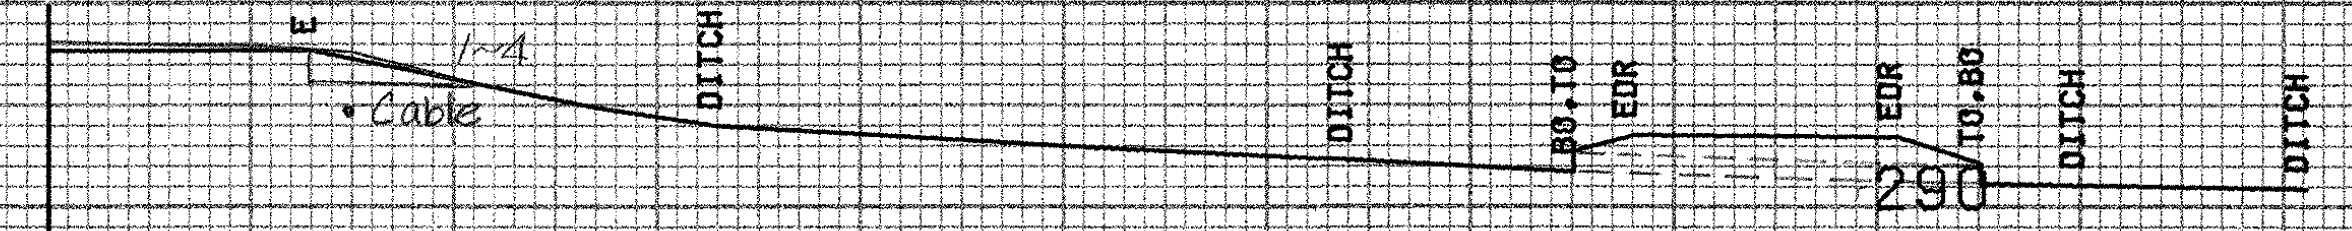

161+23


290

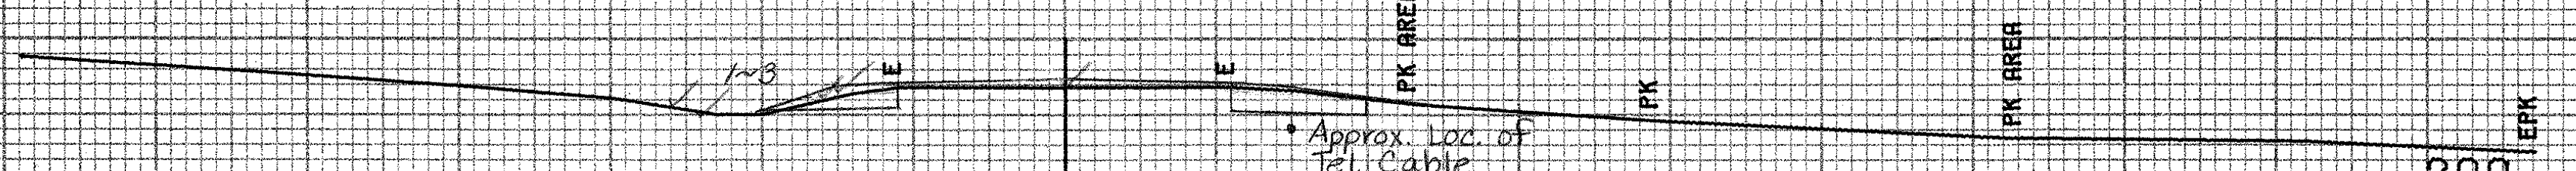

161+00

290

Approx. Loc. of  
Tel. Cable  
C-300  
F-300  
30'-10"

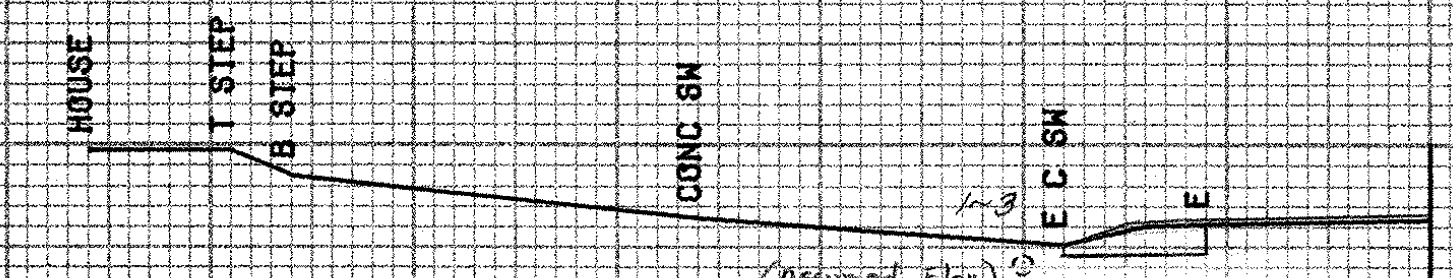

160+89  
HOUSE & CONC. S.W. LT.

290

160+89 Lt.  
12" GMP ~ Retain

BRIDPORT MM 2.94 ~ MM 3.54

FROM STA.	160+89	TO STA.	161+50
PROJECT NAME	SHOREHAM-BRIDPORT-ADDISON MAIN		
NO.	F017-1(2)	PLOTTED	04/11/85
SURVEYED BY	BUSHEY	FEB	1985
SHEET	309	OF 420 SHEETS	SHEET 309 OF 477

SCALE 10 FEET