
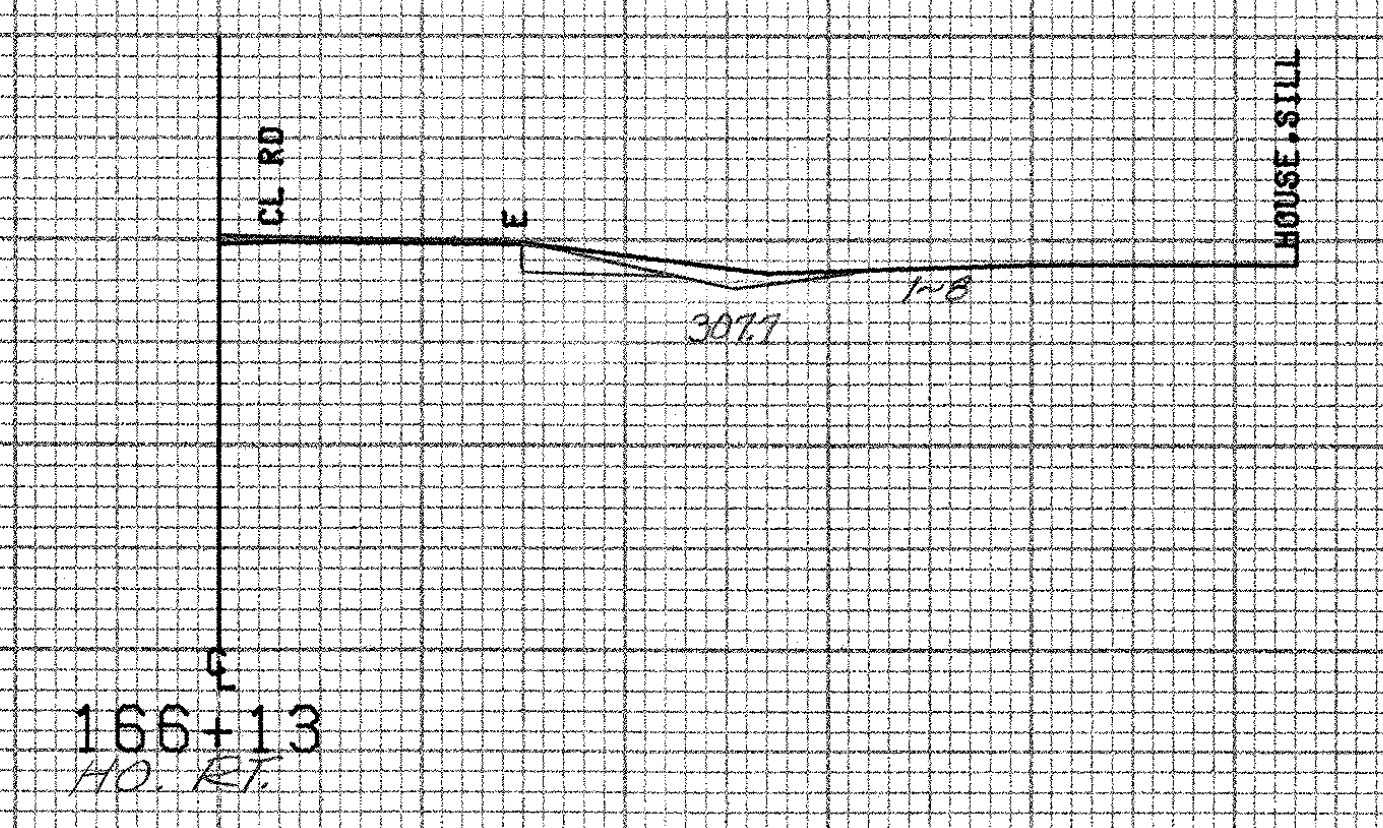
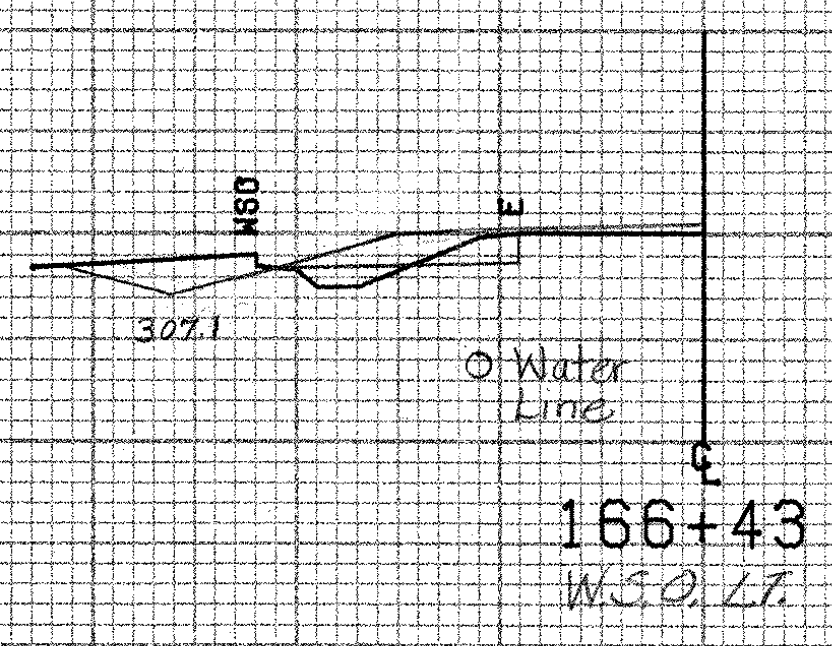
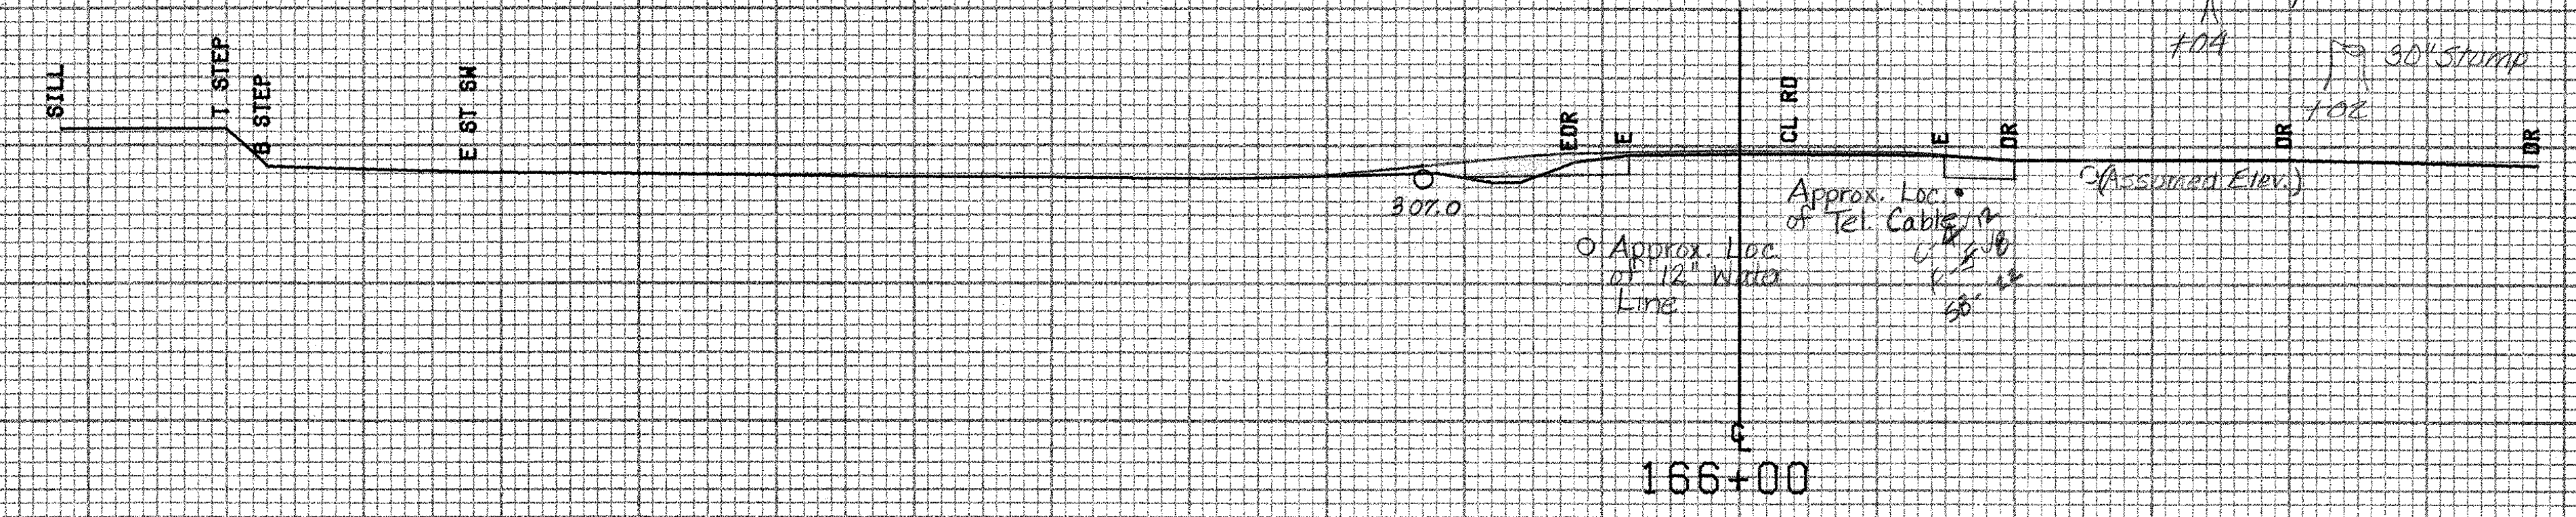


Shoulder Transition Detail

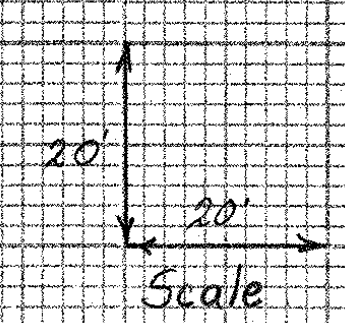

166+05 RT.
Begin Special Ditch - Ends @ 166+15 RT.
(To be paid as Common Excavation)

SCALE 1" = 10 FEET

BRIDPORT MM 2.94 ~ MM 3.54

FROM STA.	166+00	TO STA.	166+43
PROJECT NAME	SHOREHAM-BRIDPORT-ADDISON MAIN		
NO.	F017-1(2)	PLOTTED	04/11/85
SURVEYED BY	BUSHEY	FEB	1985
SHEET	314	OF	420 SHEETS
		SHEET	314 OF 477