



167+50 LT.
End Shoulder Taper (3'-8")
(See Detail Sheet 314 of 420)

167+50
Begin Taper of Full Depth Typical

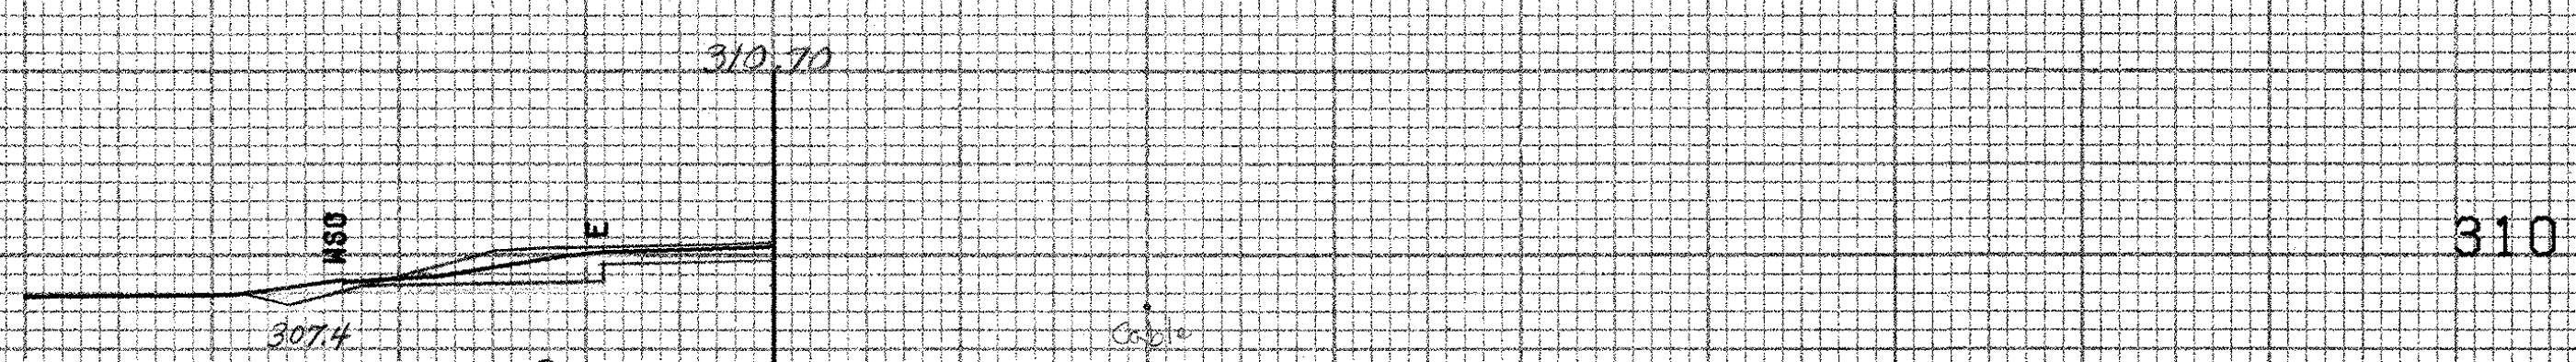


167+09
MSO LT.

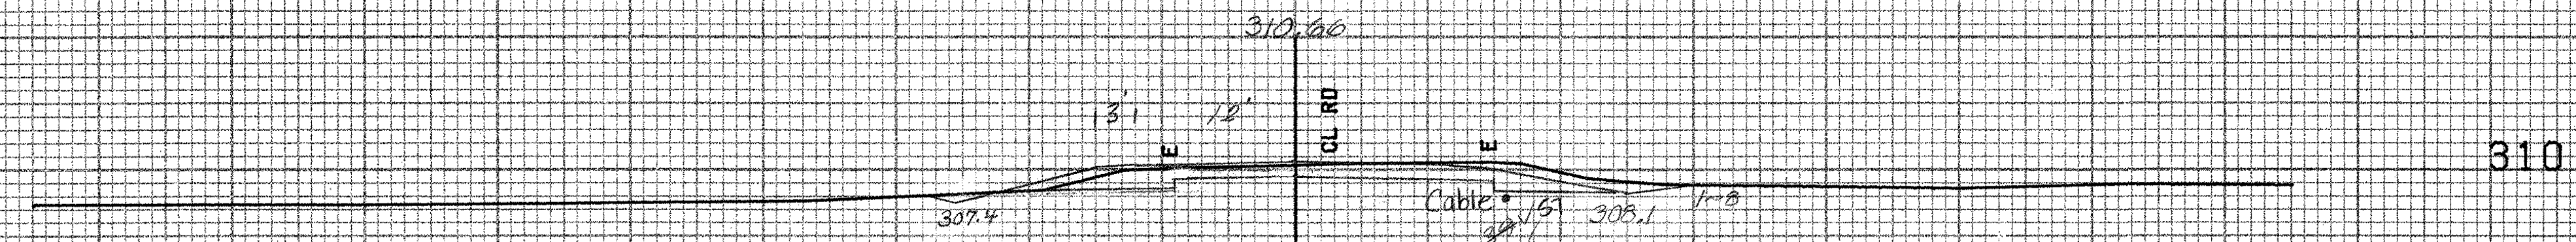

167+00 LT.
Begin Shoulder Taper (3'-8")
(See Detail Sheet 314 of 420)

167+00
End Cold Planing - 4" Depth
Begin Excavation of Bit. Conc. Pav't.
(Paid under Common Excavation)

166+50 LT.
End Special Bit. Conc. Pav't.
(Paid under Common Excavation) Begins @ 167+55 LT.

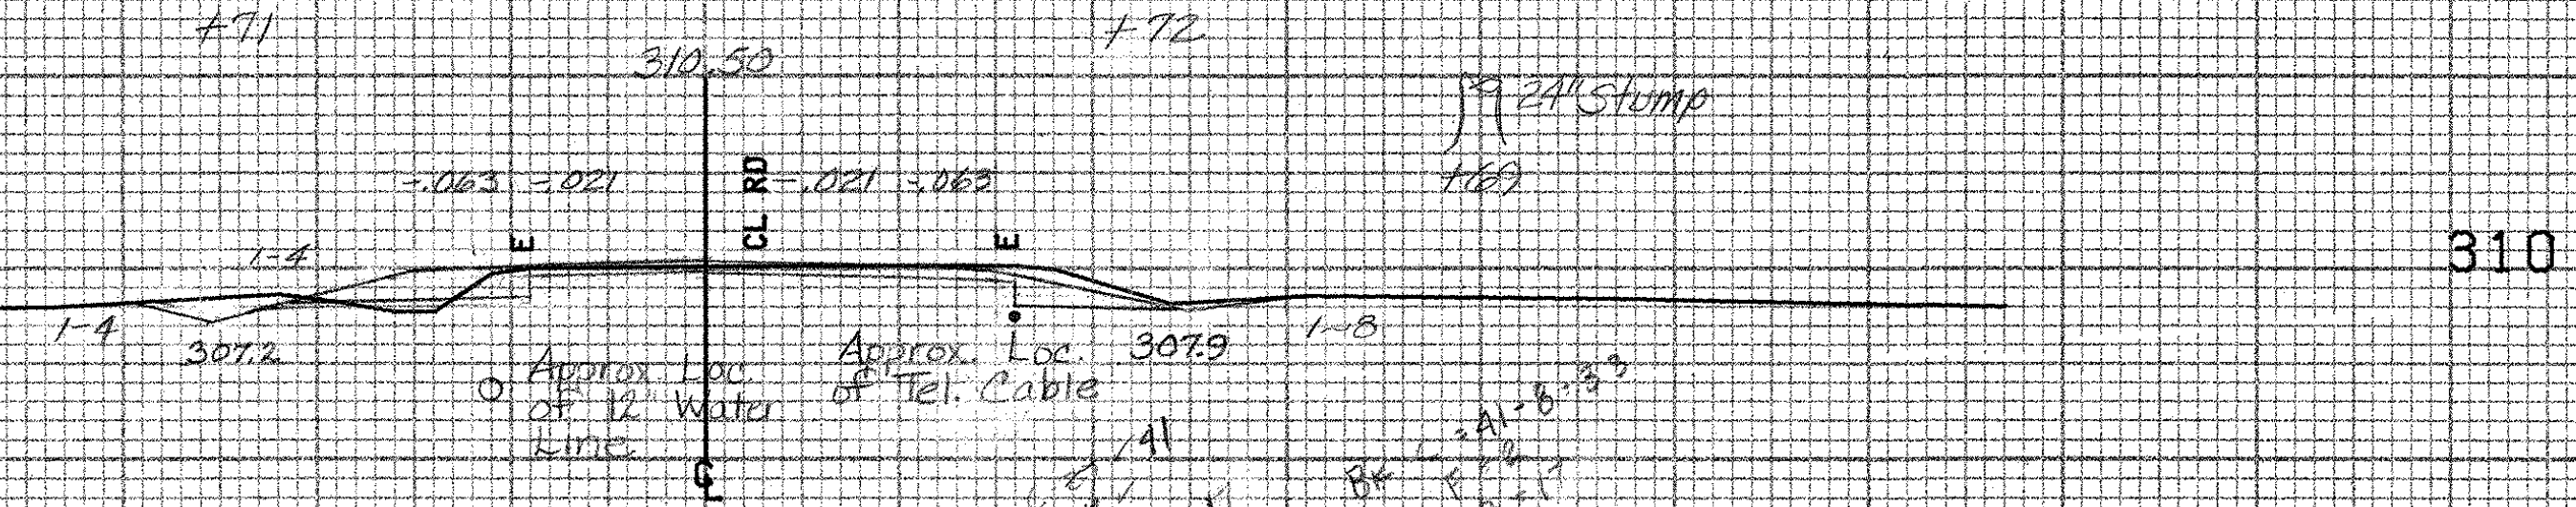

166+50
Begin Cold Planing - 4" Depth
STOP Project F017-1(R)
Begin Project HES-F017-1(R)

BRIDPORT MM 2.94 ~ MM 3.34

FROM STA.	166+50	TO STA.	167+50
PROJECT NAME	SHOREHAM-BRIDPORT-ADDISON MAIN		
NO.	F017-1(2)	PLOTTED	04/11/85
SURVEYED BY	BUSHEY	FEB	1985
SHEET	315 OF 420 SHEETS	SHEET	315 OF 477

SCALE 1" = 10 FEET