




173+00 L.T.
Begin Special Ditch - Ends @ 172+59 RT
(To be paid as Common Excavation)

172+95 L.T.
Construct Drive
(12' Gravel)

172+00 ~ 172+90 L.T.
Construct Special Ditch
(To be paid as Common Excavation)

172+20 RT
Begin Bituminous Concrete Gutter
(See Detail Above)
Ends @ 174+25 RT

171+60 ~ 172+20 RT
Construct Special Ditch
(To be paid as Common Excavation)

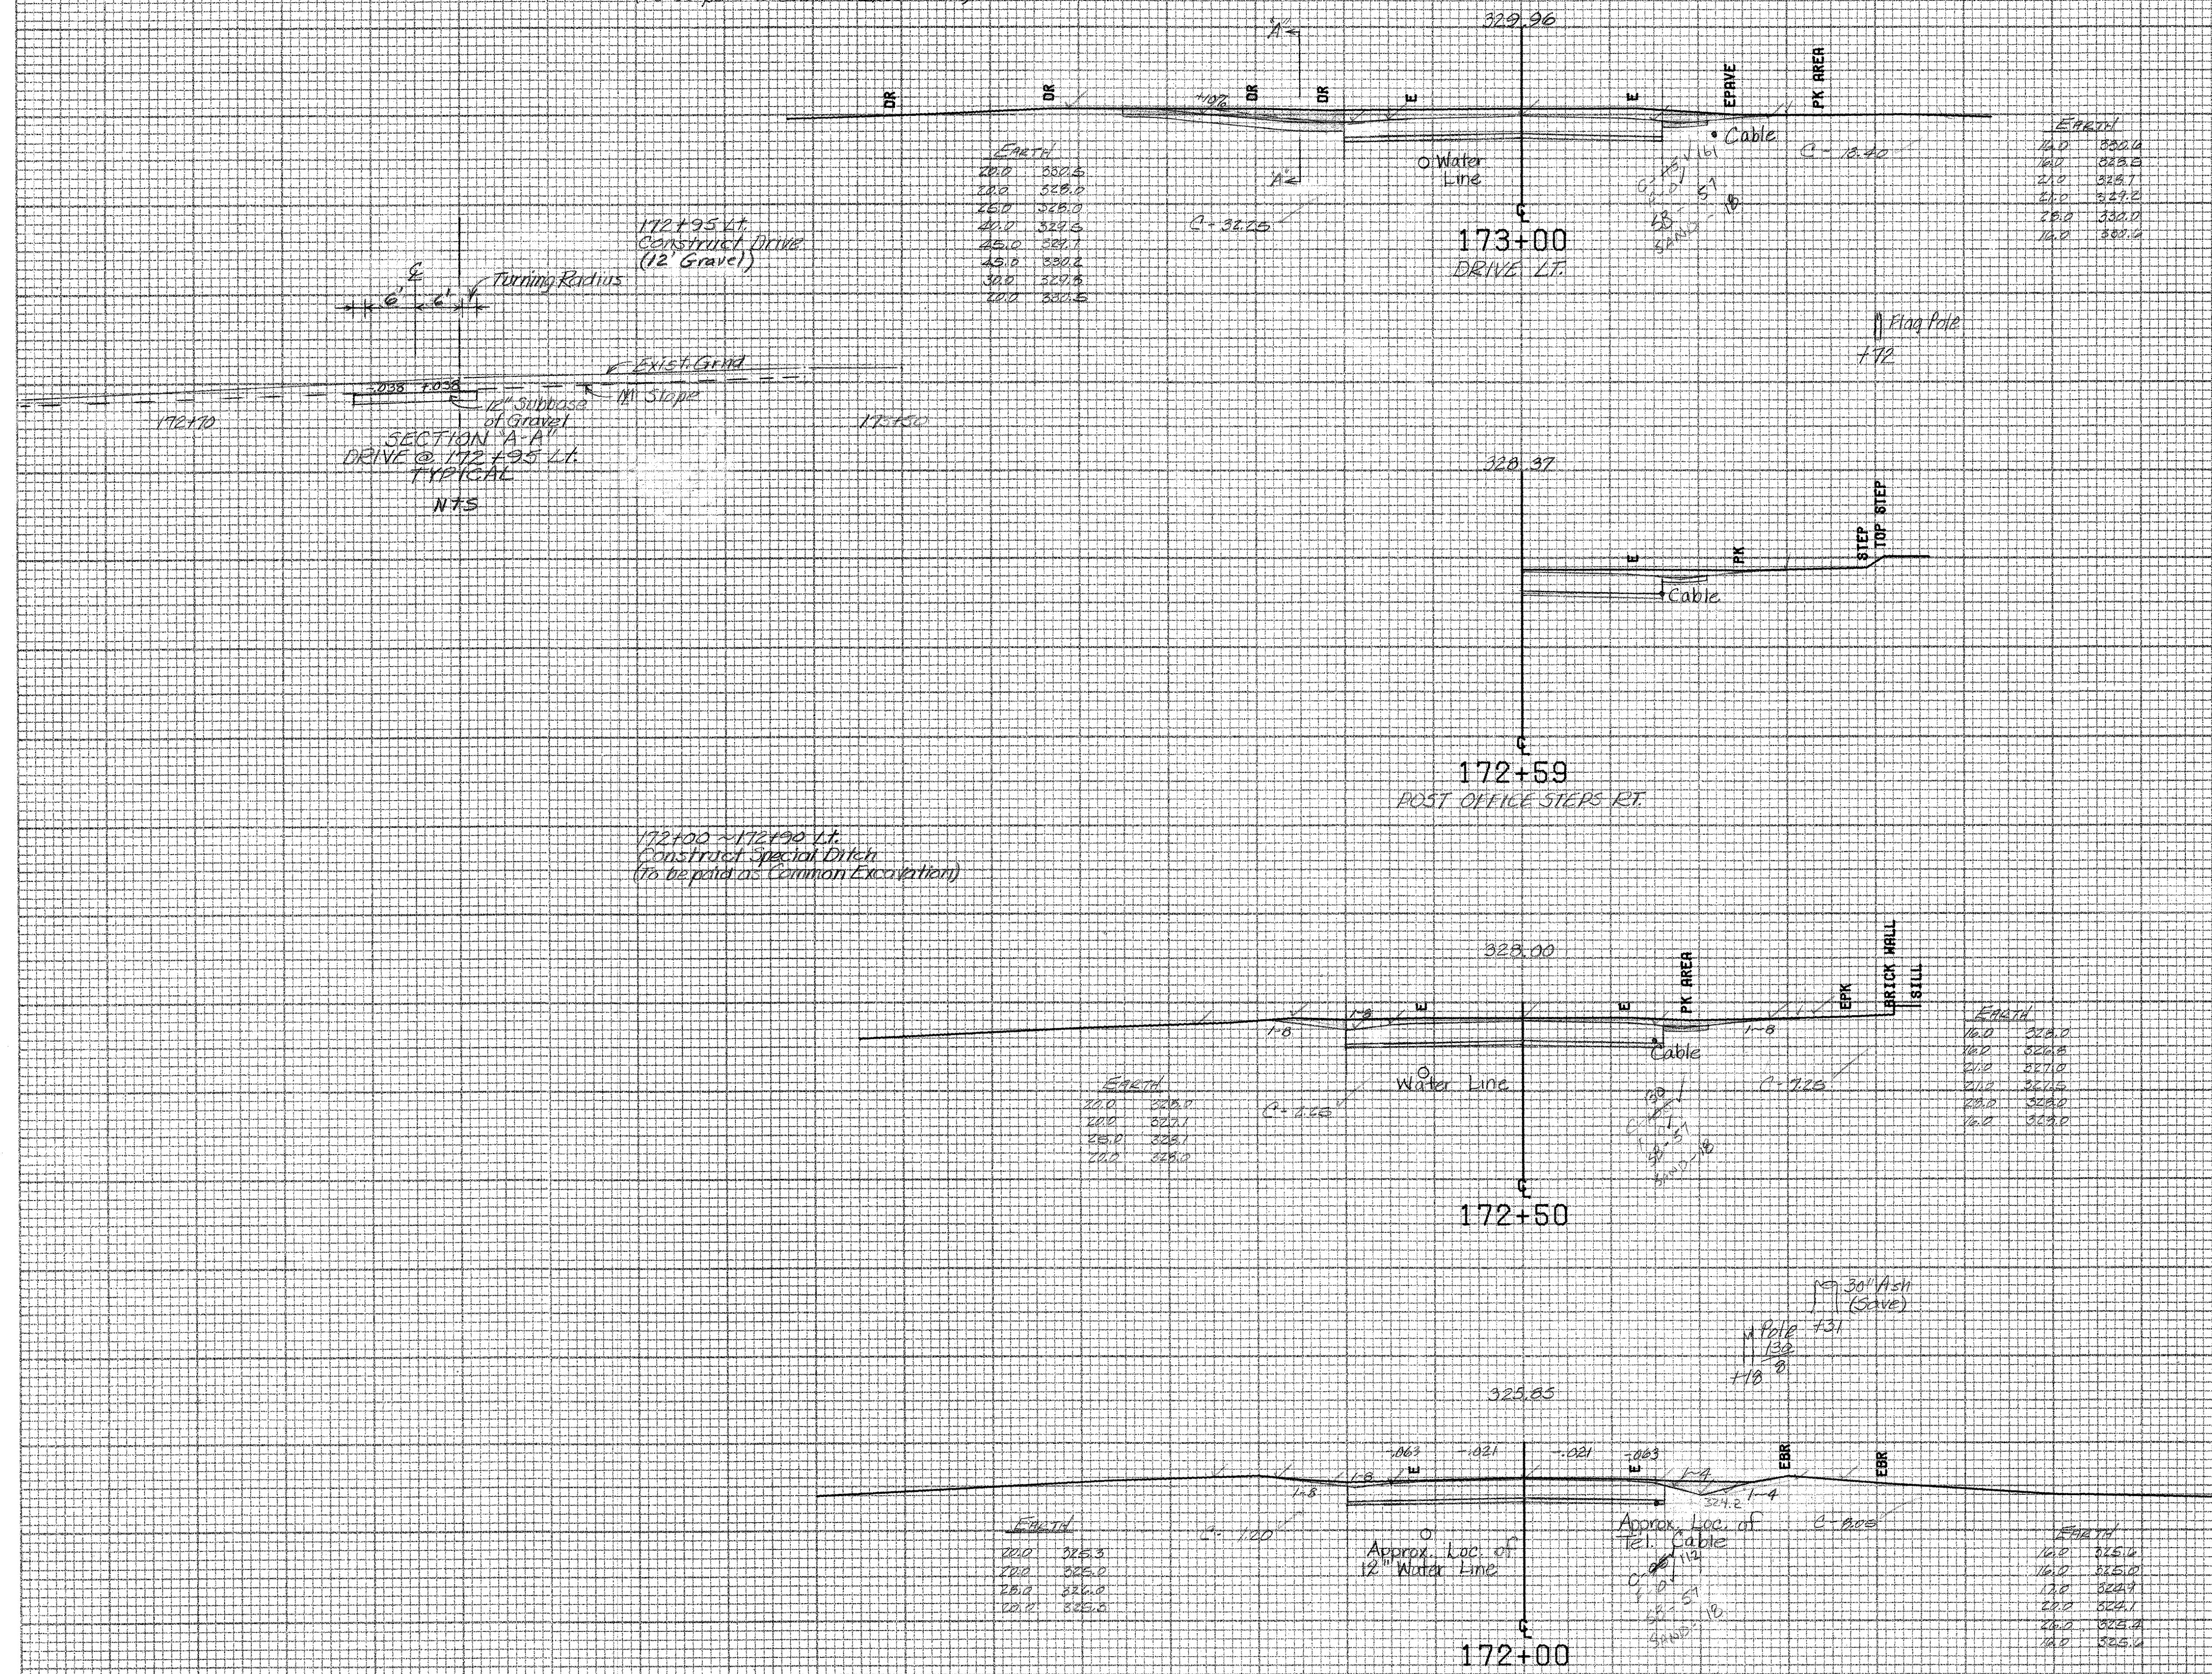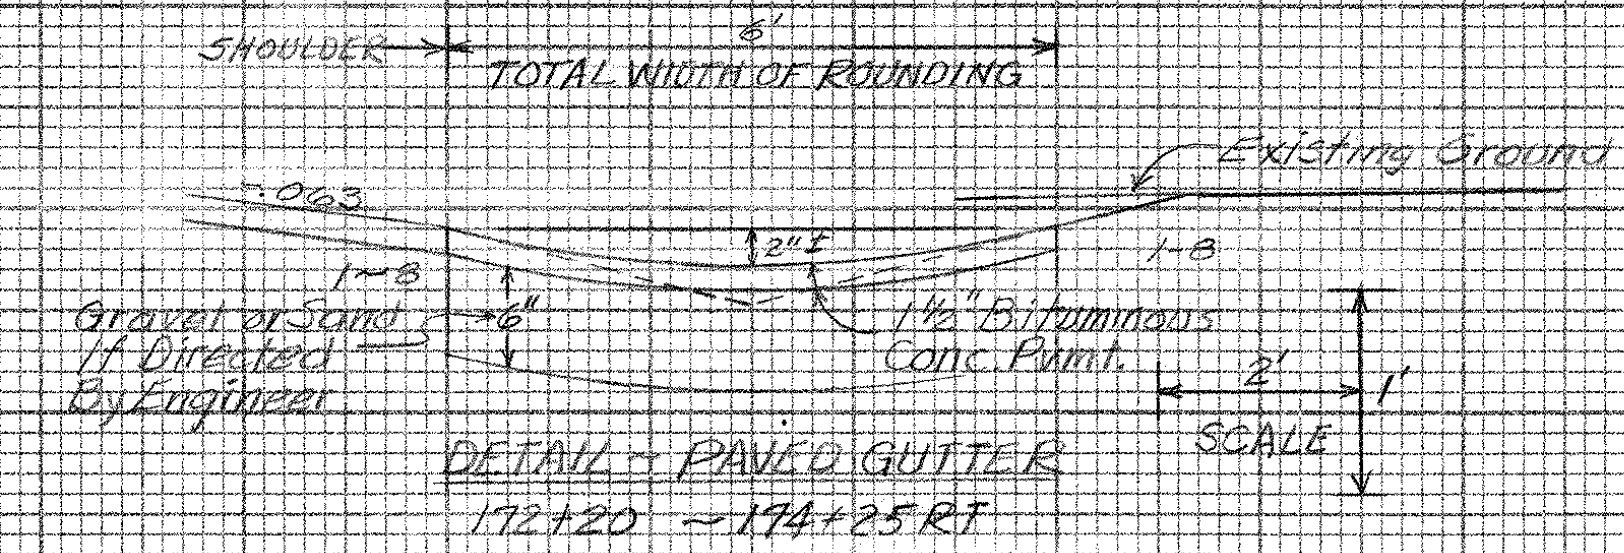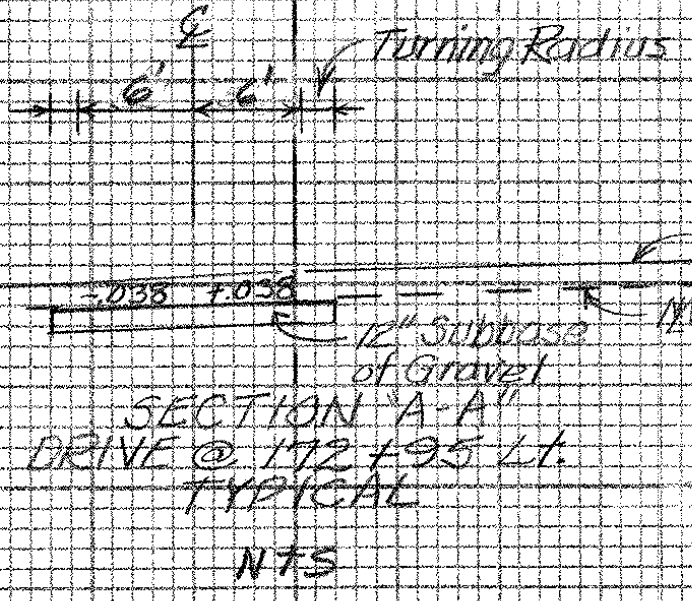

EARTH	
20.0	329.5
20.0	329.0
25.0	328.0
40.0	327.5
45.0	327.1
45.0	330.2
30.0	329.8
10.0	330.5

EARTH	
10.0	330.0
10.0	328.0
21.0	328.1
50.0	327.2
25.0	330.0
10.0	330.4

EARTH	
20.0	328.7
20.0	328.1
25.0	328.1
10.0	328.0

EARTH	
10.0	328.0
10.0	328.0
21.0	327.0
21.0	327.5
20.0	328.0
10.0	328.0

EARTH	
20.0	325.3
20.0	325.0
25.0	326.0
20.0	325.0

EARTH	
10.0	325.4
10.0	325.0
10.0	324.9
20.0	324.1
20.0	325.9
10.0	325.4

BRIDPORT MM 2.94 ~ MM 3.54

FROM STA. 172+00	TO STA. 173+00
PROJECT NAME SHOREHAM-BRIDPORT-ADDISON MAIN	
NO. F017-1(2)	PLOTTED 04/11/85
SURVEYED BY BUSHEY	FEB 1985
SHEET 320 OF 420 SHEETS	SHEET 320 OF 477

SCALE 1" = 10 FEET