



FINAL SURVEY NOTE BOOK No.	BY	DATE
REVISIONS	BY	DATE
PLOTTED		
TEMP. AIR		
AREAS CHECKED		

ORIGINAL SURVEY NOTE BOOK No.	BY	DATE
REVISIONS	BY	DATE
PLOTTED		
TEMP. AIR		
AREAS CHECKED		

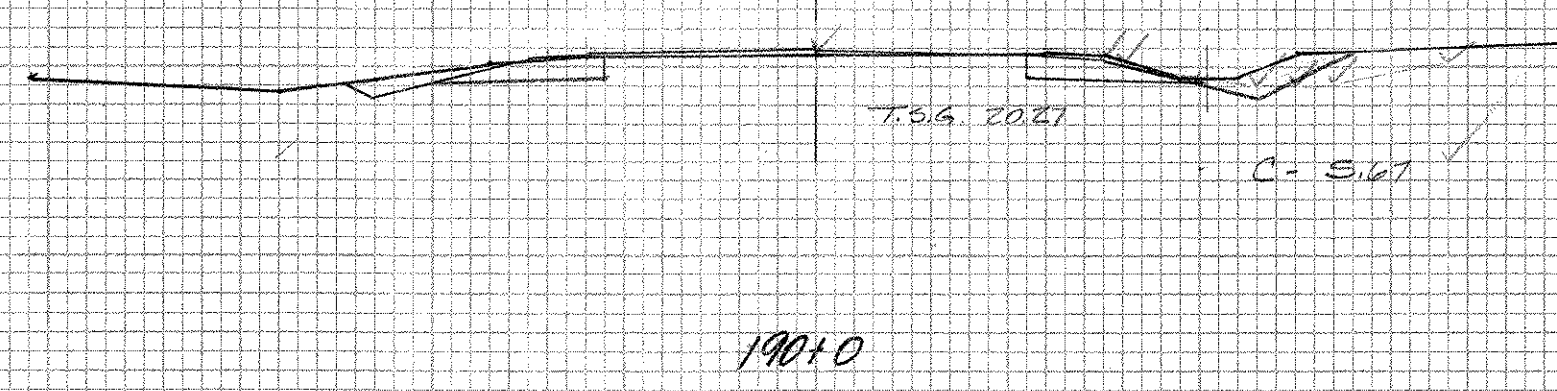


EARTH	
10.27	329.4
10.0	329.0
24.8	330.0
25.7	330.7
25.0	330.5
22.9	329.4
20.27	327.4
5.47	

330

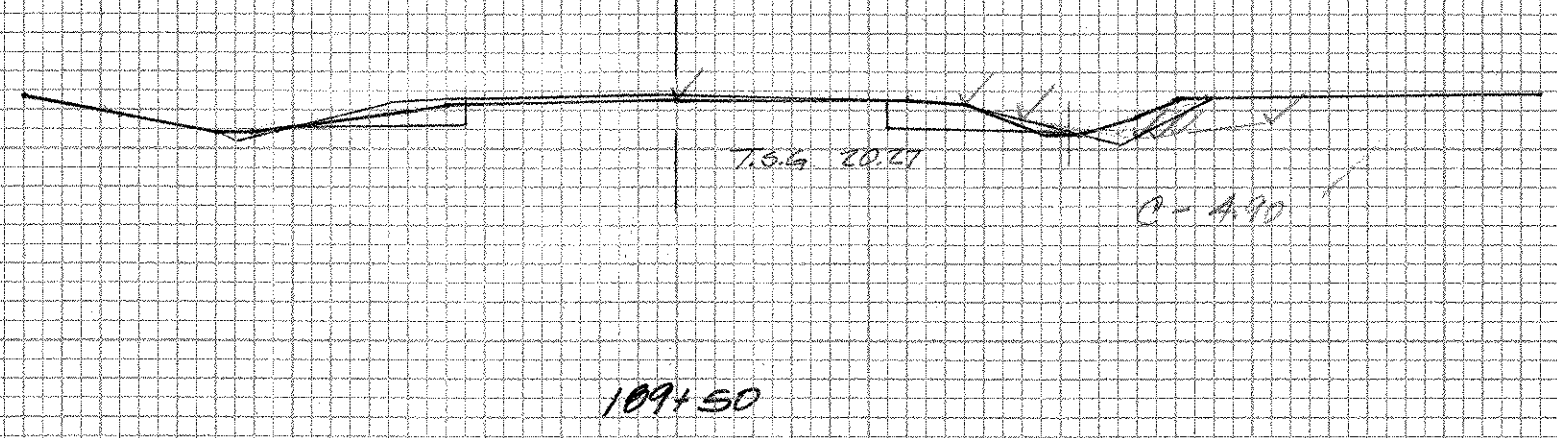


EARTH	
22.0	331.0
22.0	330.5
22.0	330.7
22.0	330.7
22.0	331.0
4.90	

330

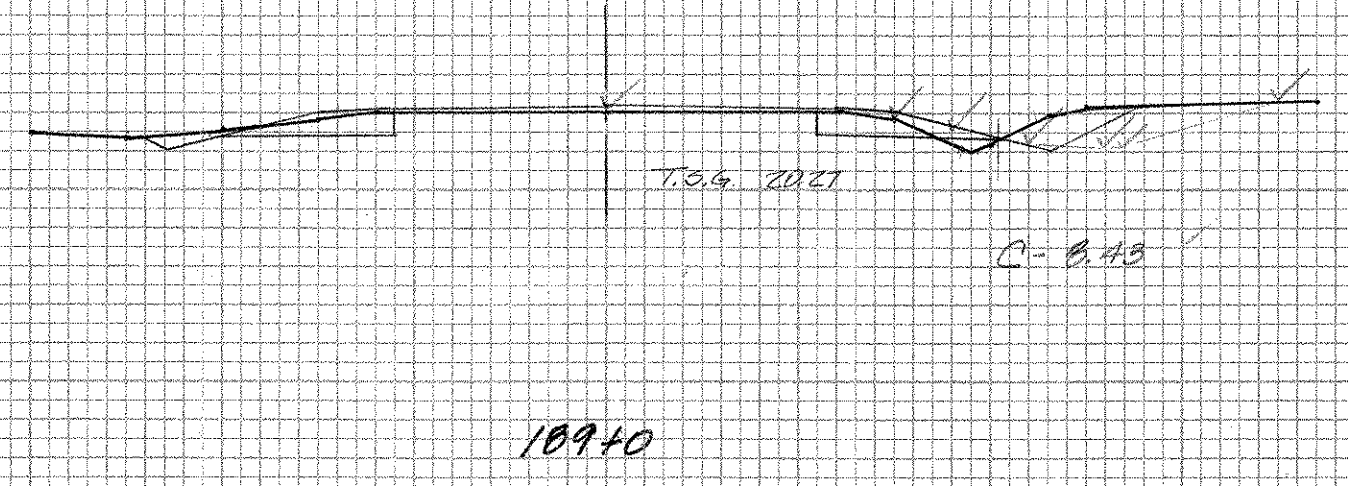

EARTH	
20.27	332.5
22.0	332.7
23.7	332.7
22.0	332.5
25.0	334.2
22.0	333.9
20.27	332.5
5.43	

330

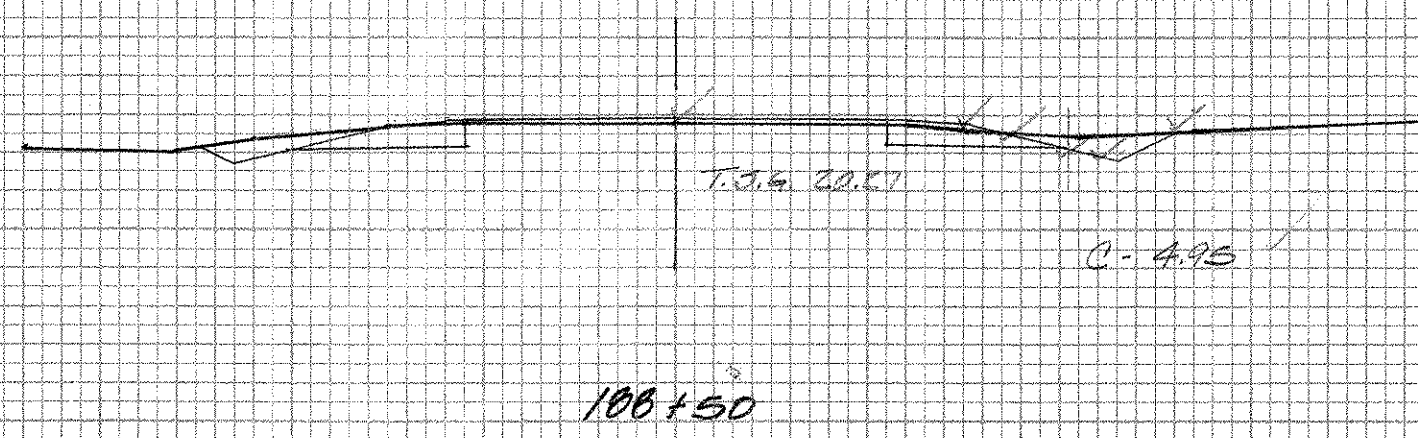

EARTH	
10.27	335.0
10.27	334.7
25.0	333.7
20.0	335.1
20.27	335.0
4.95	

330

BED ROCK HAS BEEN FOUND  
 IN THE CROSS SECTIONS  
 188+50 - 190+00  
 SHEET B OF 477