



FINAL SURVEY	REVISIONS	DATE
	PLOTTED	
NOTE BOOK	TEMPERATURE	
	AREA CHECKED	
No.		


ORIGINAL SURVEY	REVISIONS	DATE
	PLOTTED	
NOTE BOOK	TEMPERATURE	
	AREA CHECKED	
No.		

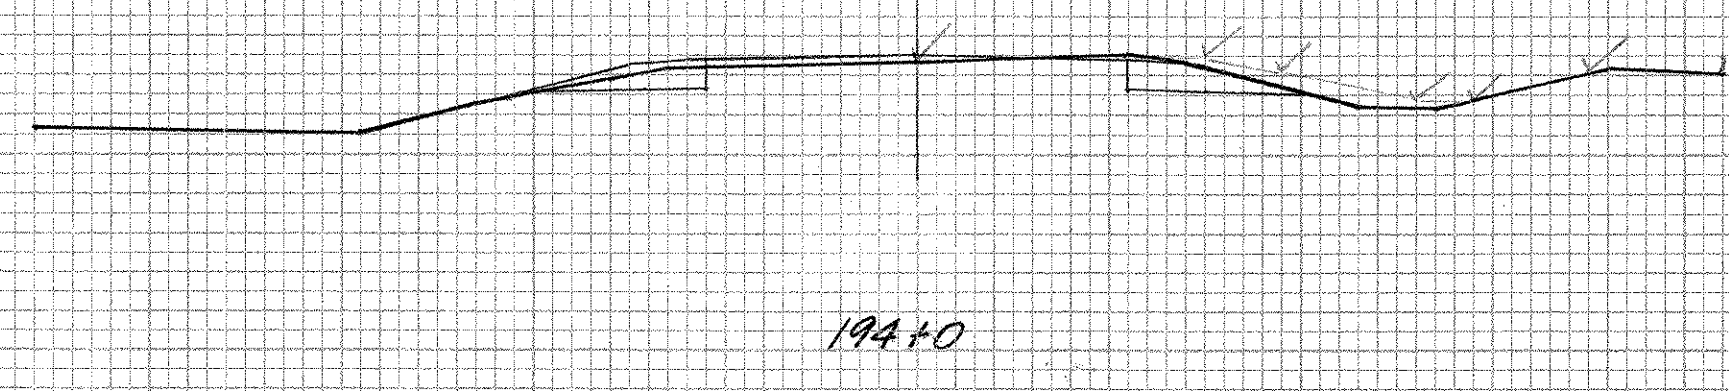


320

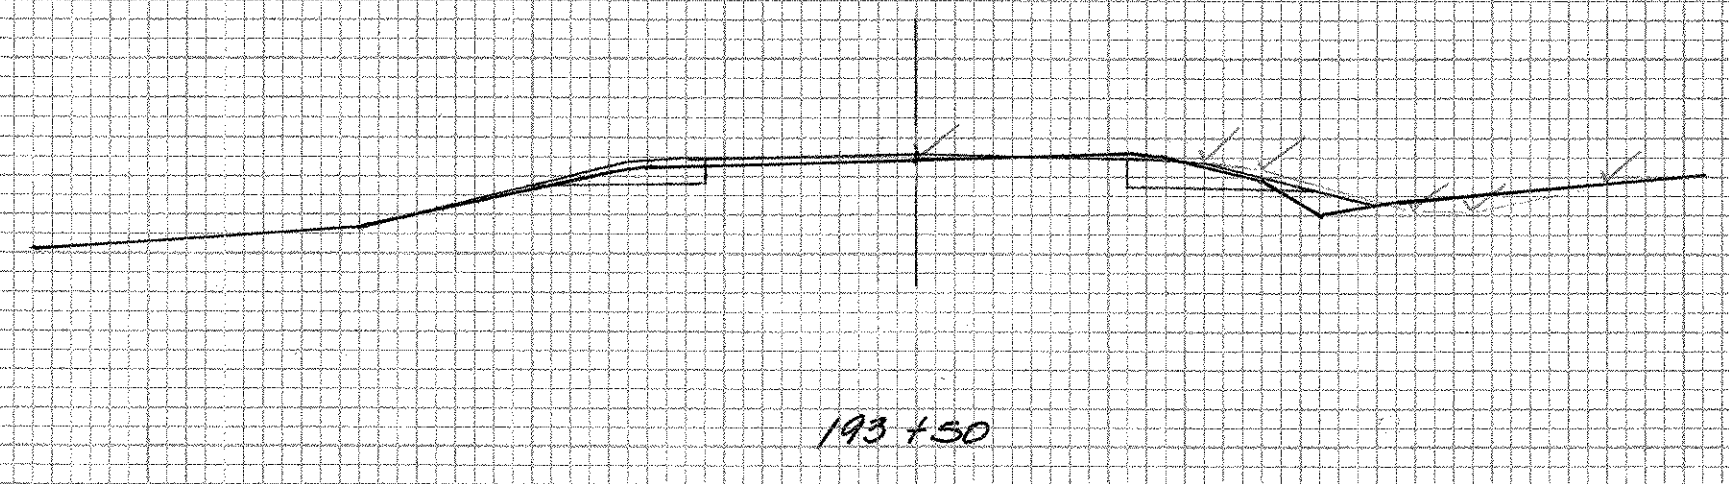

320

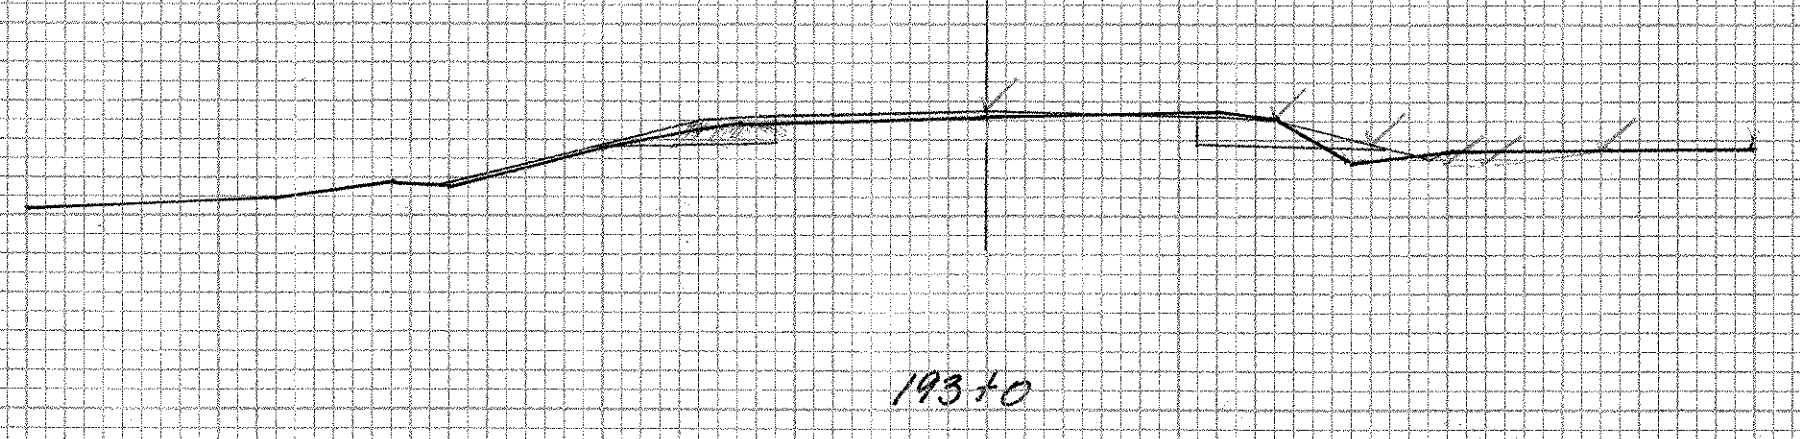

320

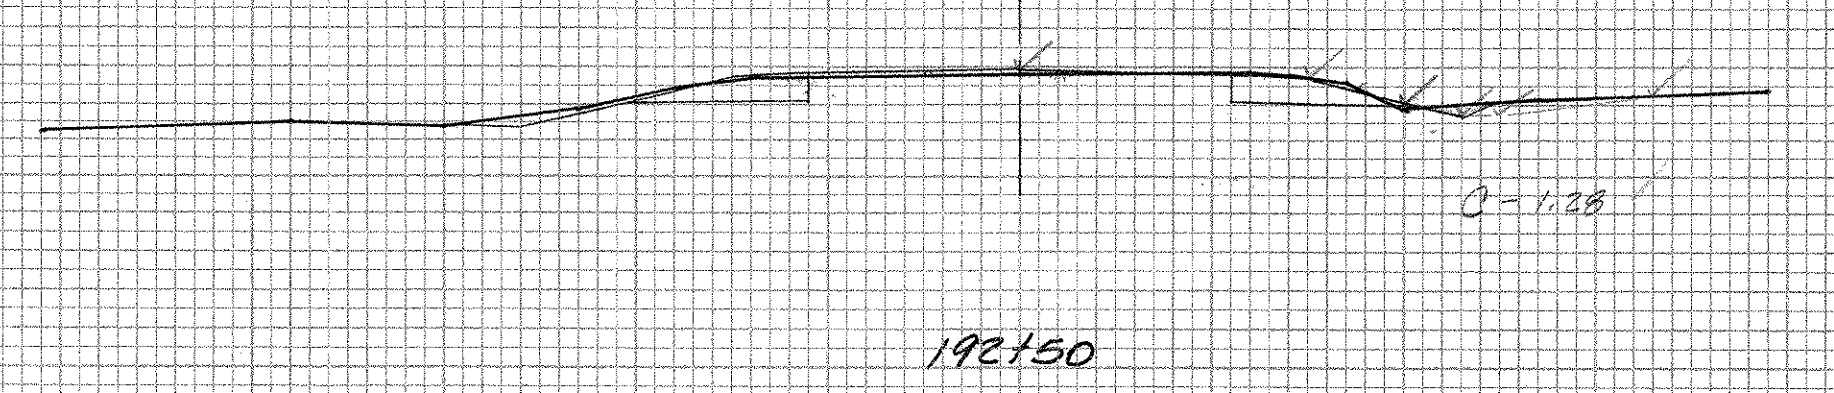

320

ELEVATION	
21.0	324.0
24.0	325.5
25.5	324.1
21.0	324.0

1.28

BRIDPORT HES FO17-1(2)  
ORIGINAL SECTIONS  
192+50 - 194+00  
SHEET D OF 477