



FINAL SURVEY	SURVEYED	DATE
NOTE BOOK	PLOTTED	BY
No.	DATE	
	BY	
	DATE	
	BY	
	DATE	

ORIGINAL SURVEY	SURVEYED	DATE
NOTE BOOK	PLOTTED	BY
No.	DATE	
	BY	
	DATE	
	BY	
	DATE	

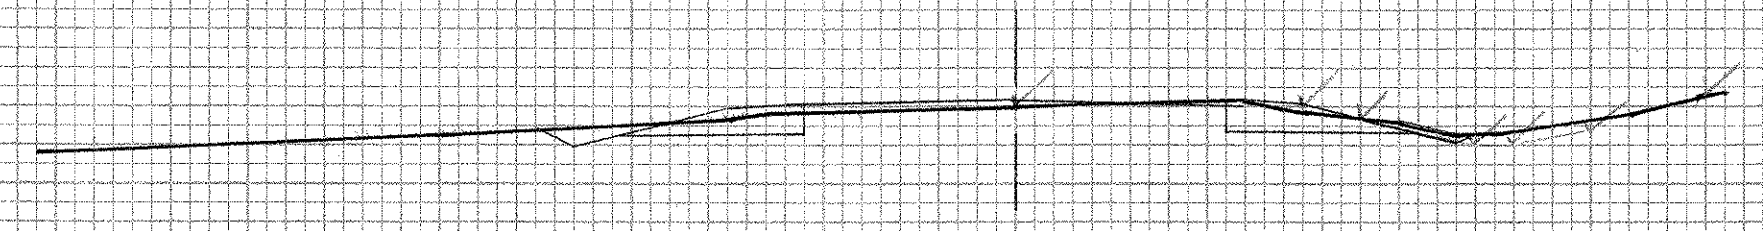


196+0

320

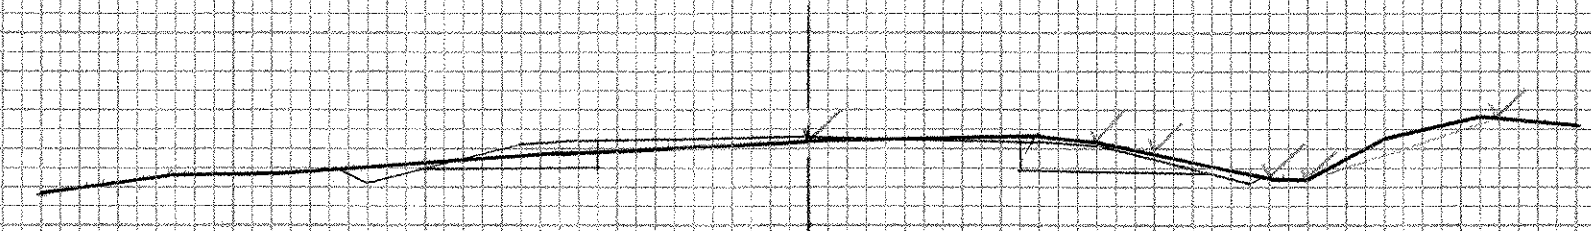


195+50

320

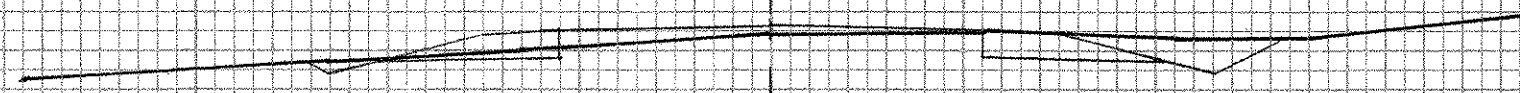

195+0

320

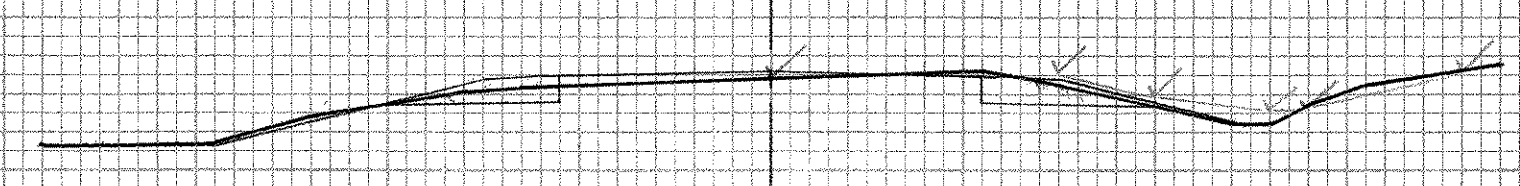

194+50

320

Q

BRIDGPORT WES FORT-1(2)  
 ORIGINAL SECTIONS  
 194+50 - 196+00  
 SHEET E OF 477