


FINAL SURVEY	REVIEWED	BY	DATE
	PLOTTED		
NOTE BOOK	TEMP. DATE		
	AREAS CHECKED		
No.			

ORIGINAL SURVEY	REVIEWED	BY	DATE
	PLOTTED		
NOTE BOOK	TEMP. DATE		
	AREAS CHECKED		
No.			

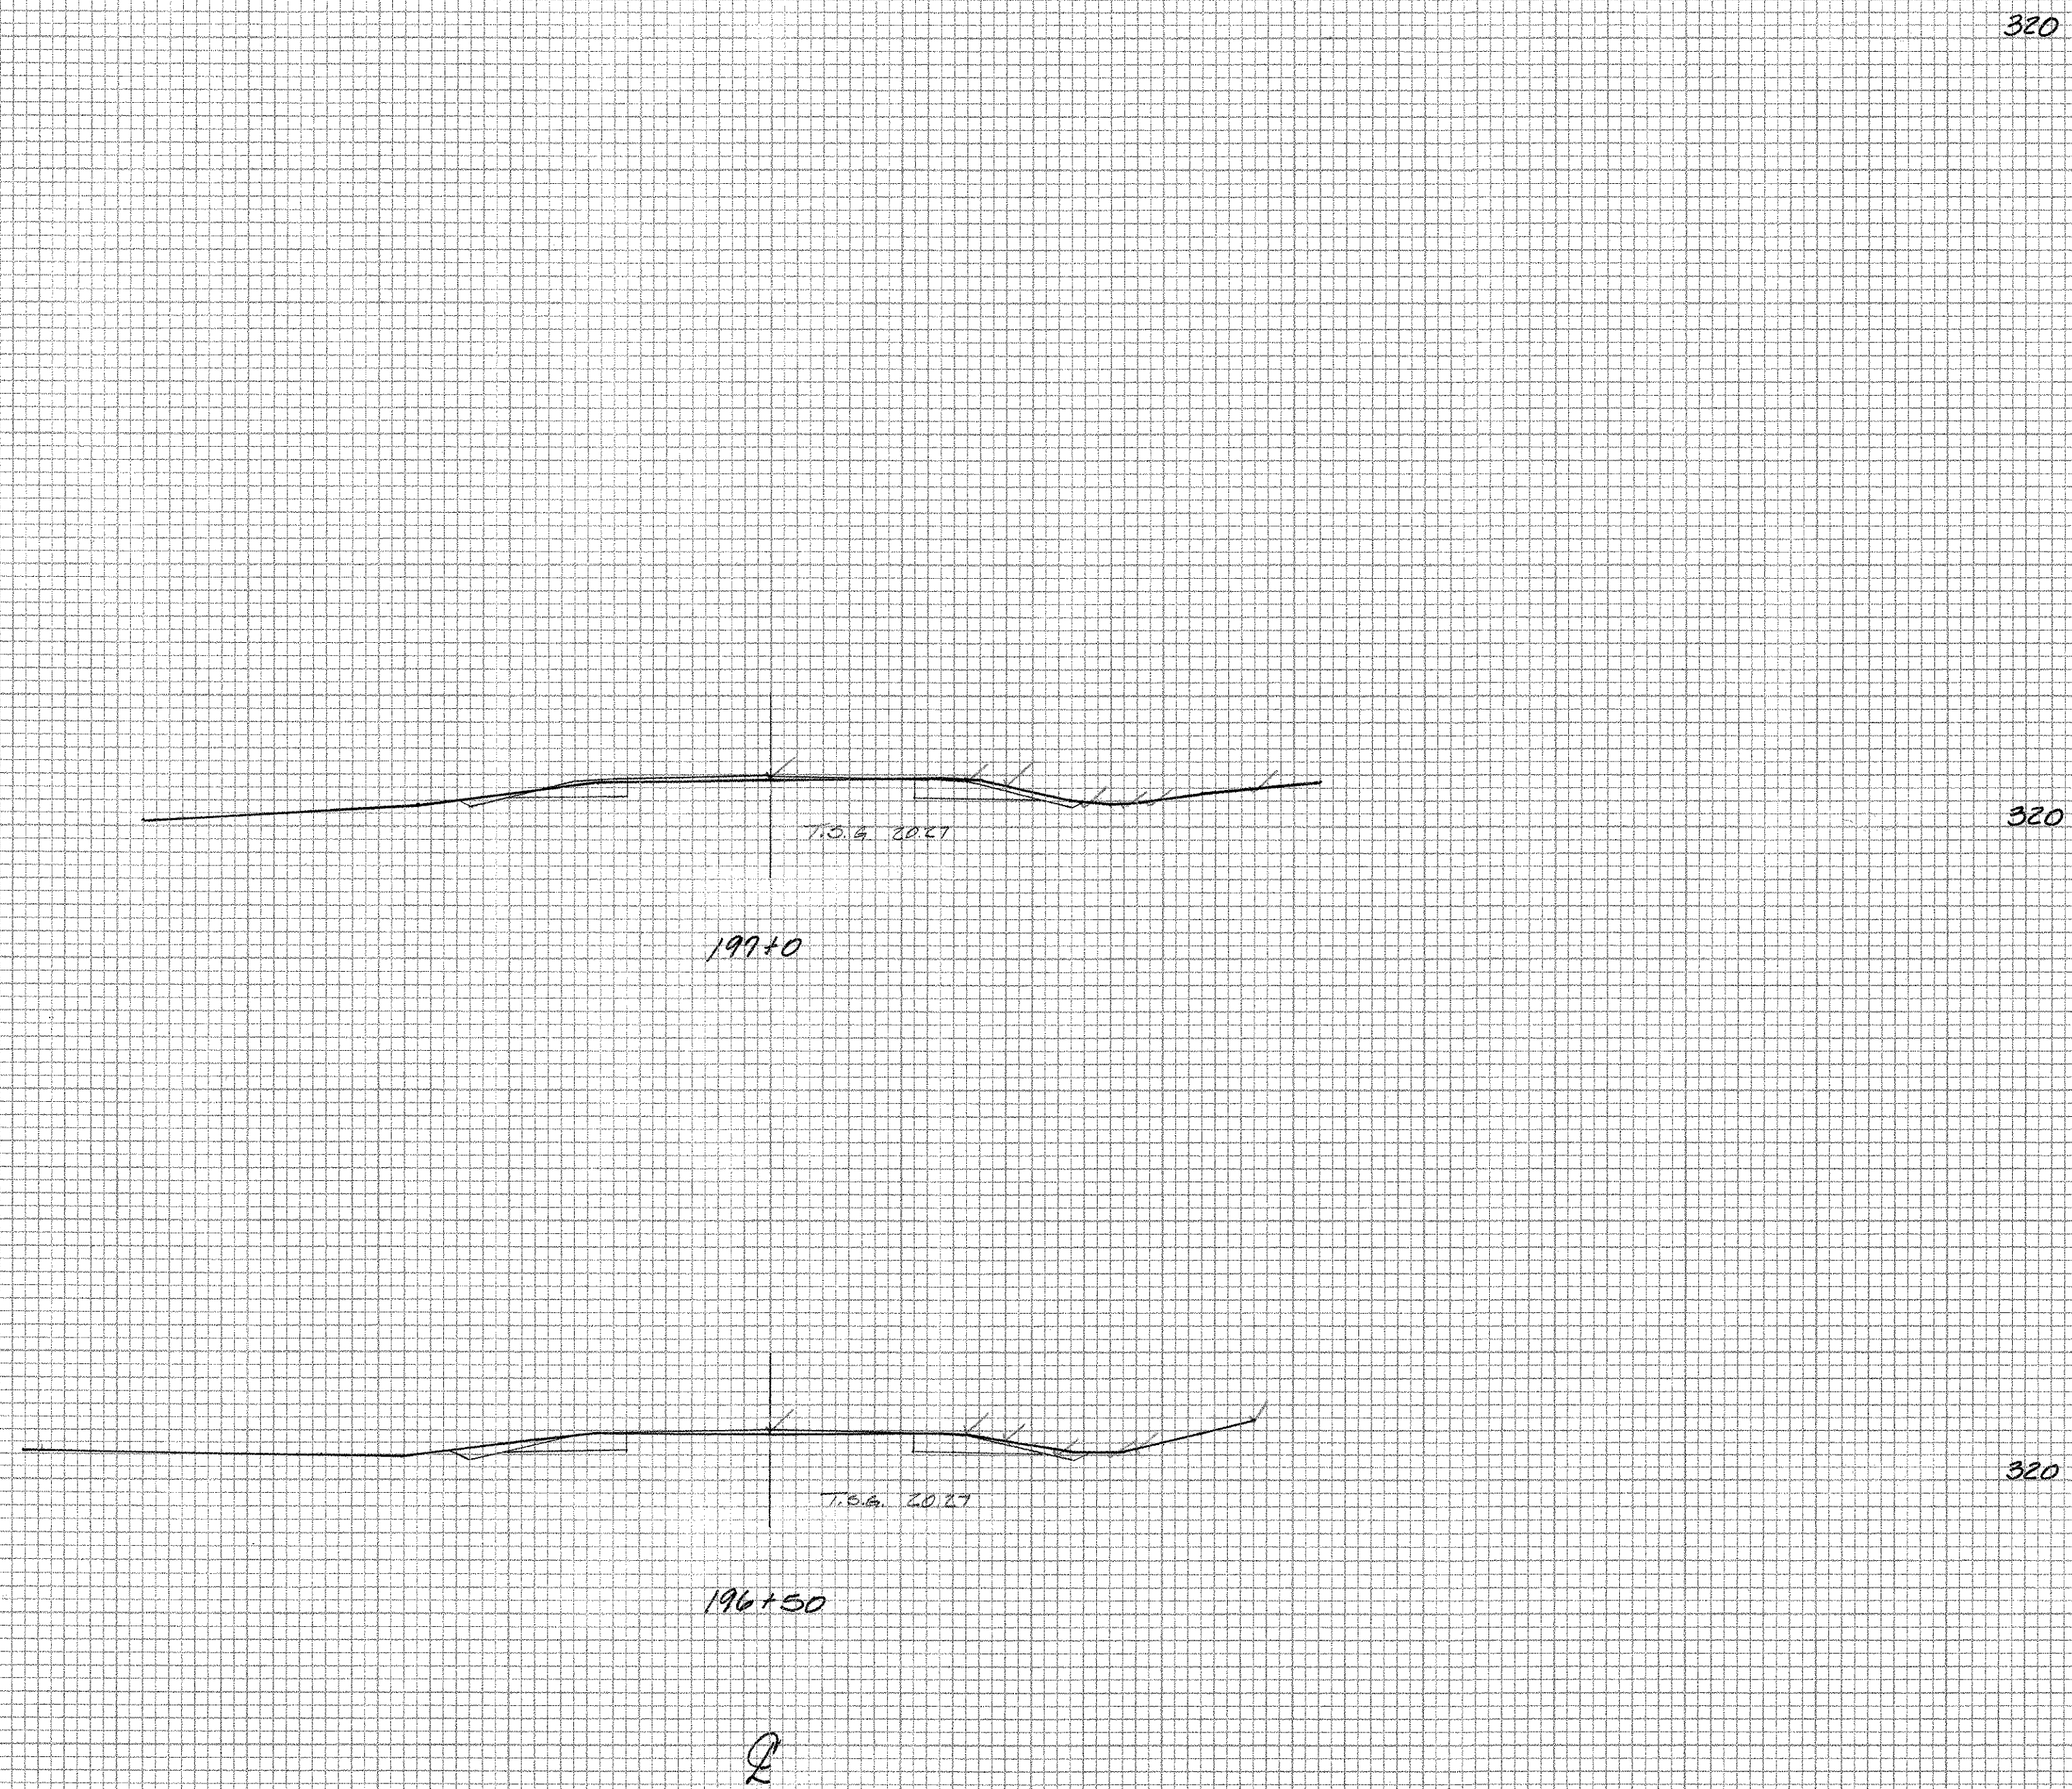

BRIDPORT HES FO17-1(2)
 ORIGINAL SECTIONS
 196+50 - 1971+50
 SHEET F OF 497