


195#30 LT.
 Begin Cast In Place Cement
 Concrete Curb, Type A
 (Ands V.125 Rev. 276x78 RT.)
 See Sheet 410 of 420 for Detail

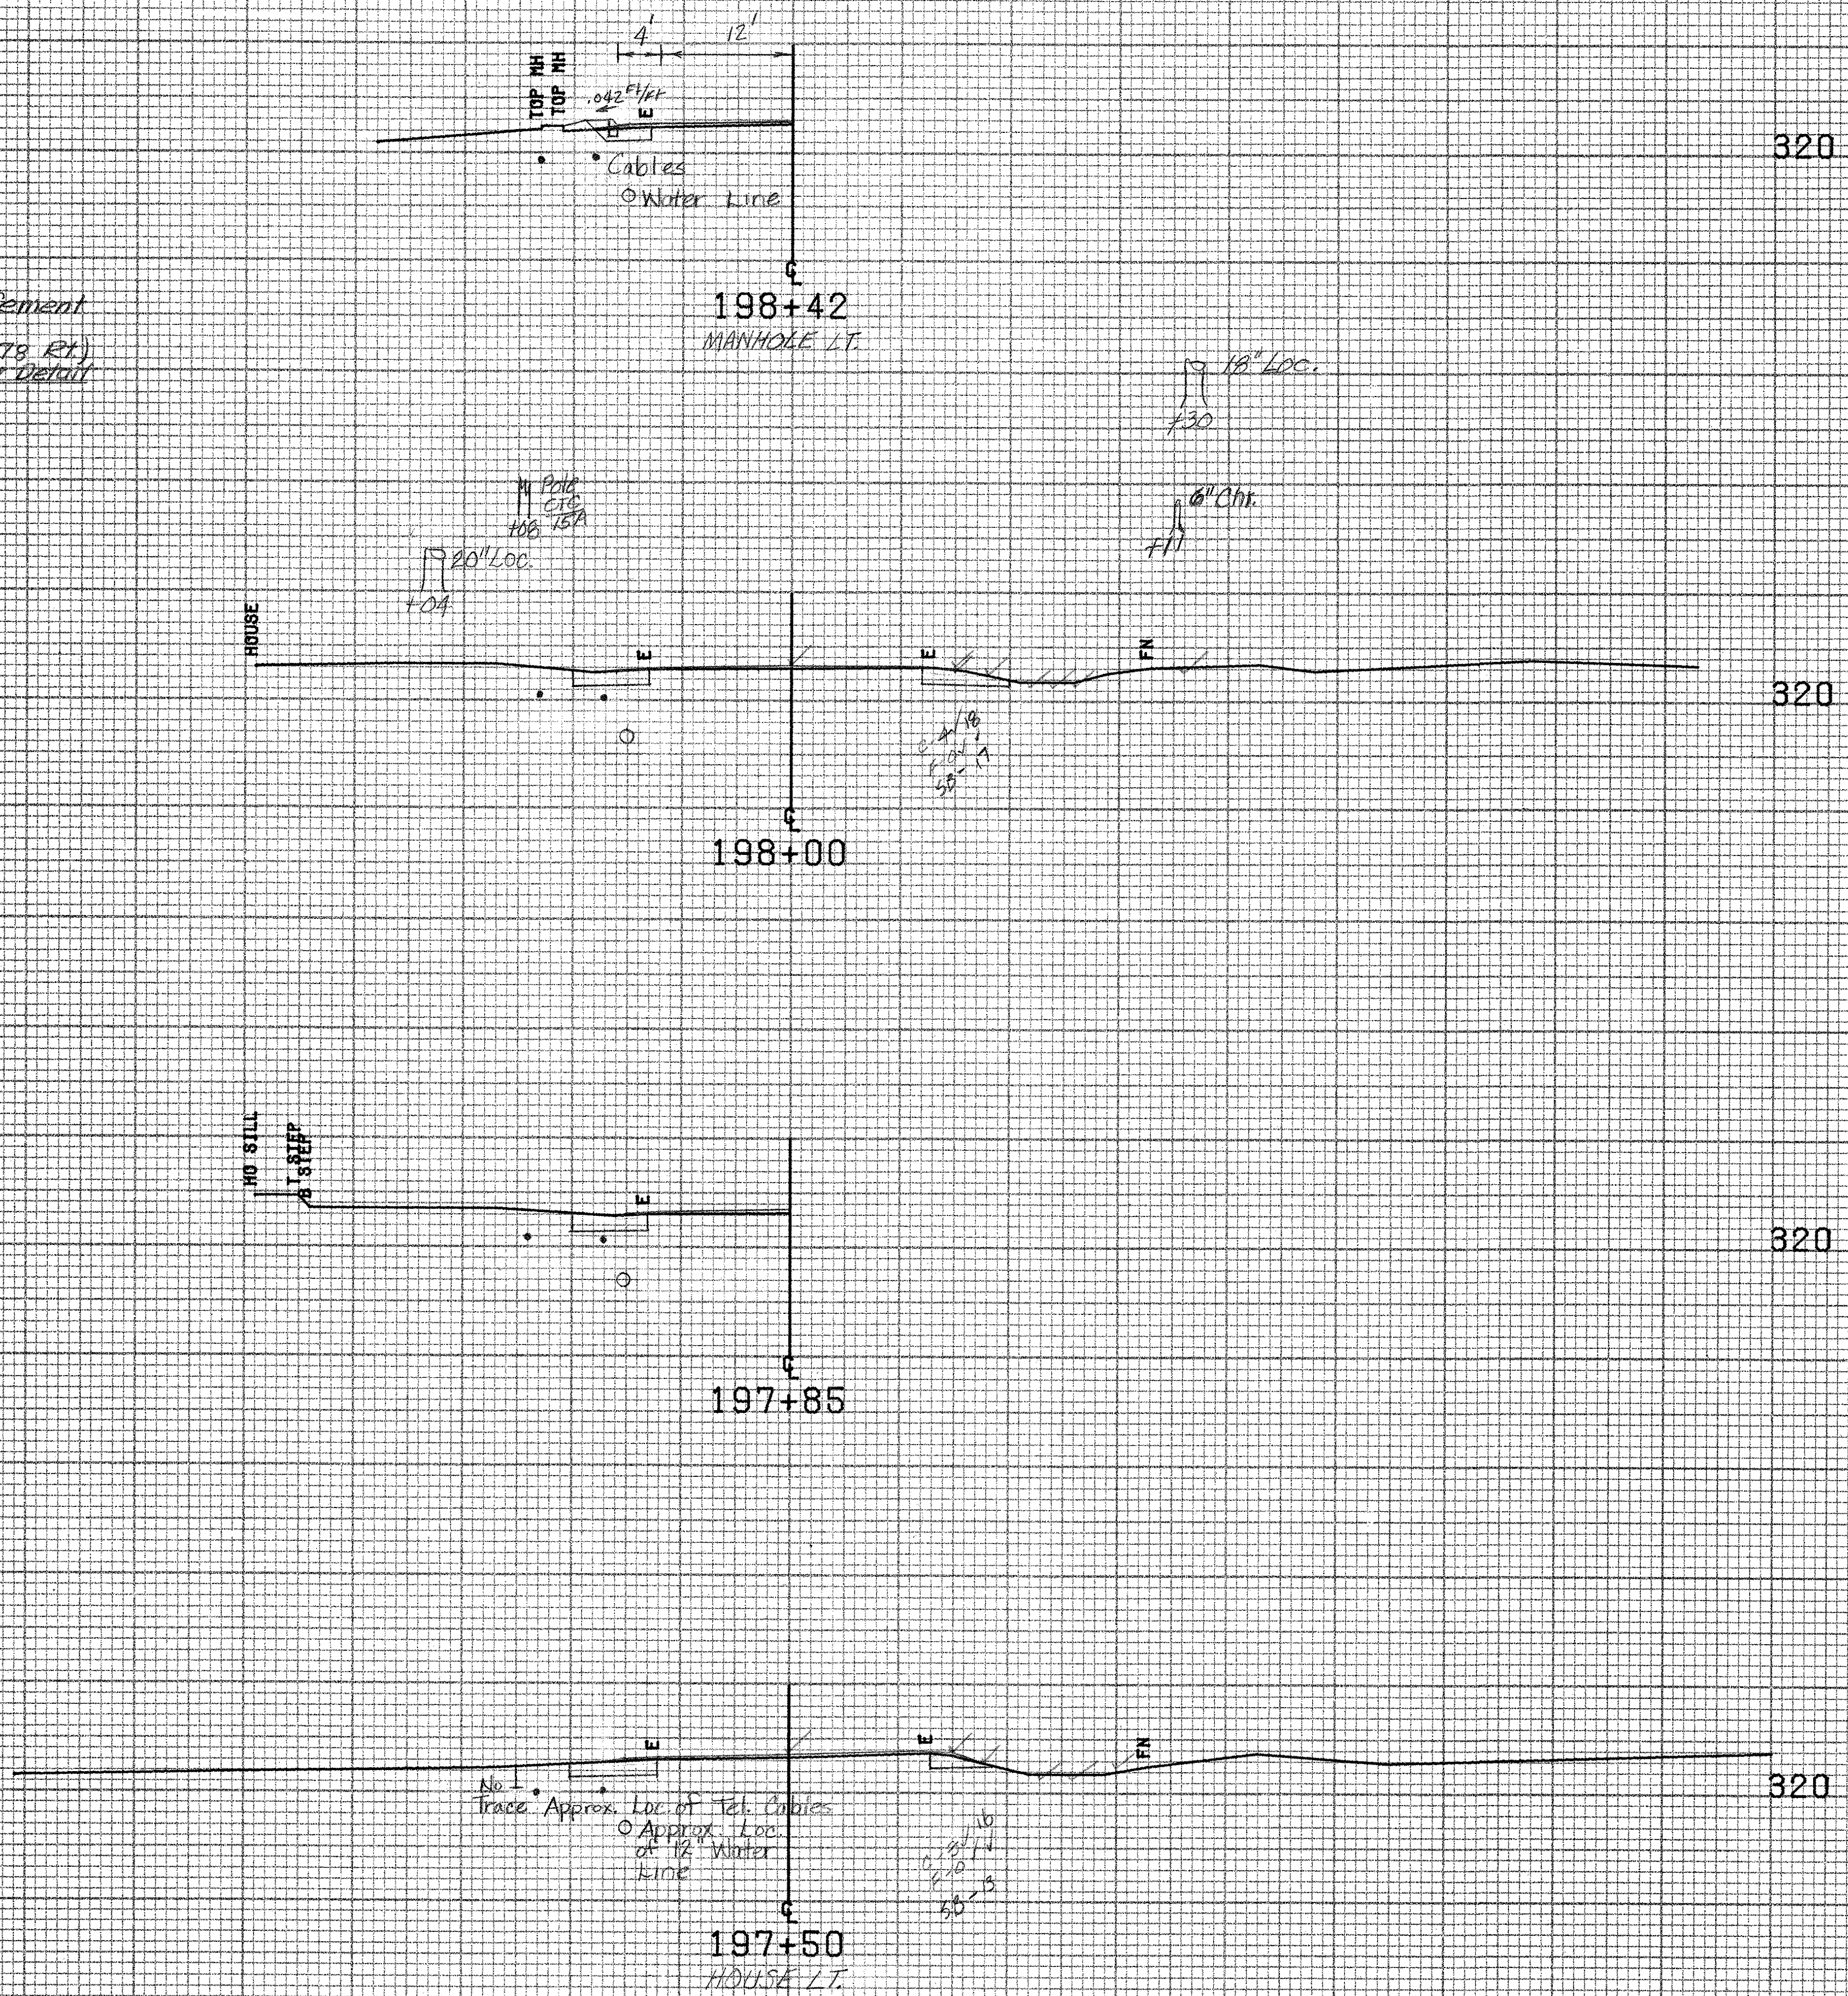

BRIDPORT MM 3.75 ~ MM 3.81

FROM STA.	197+50	TO STA.	198+42
PROJECT NAME	SHOREHAM-BRIDPORT-ADDISON MAIN		
NO.	F017-1(2)	PLOTTED	04/11/85
SURVEYED BY	BUSHEY	FEB	1985
SHEET	391 OF 420 SHEETS	SHEET	351 OF 477

SCALE 1" = 10 FEET