



EARTH	
22.0	324.6
27.0	323.7
28.0	323.8
32.0	324.0
36.0	324.4
22.0	324.6

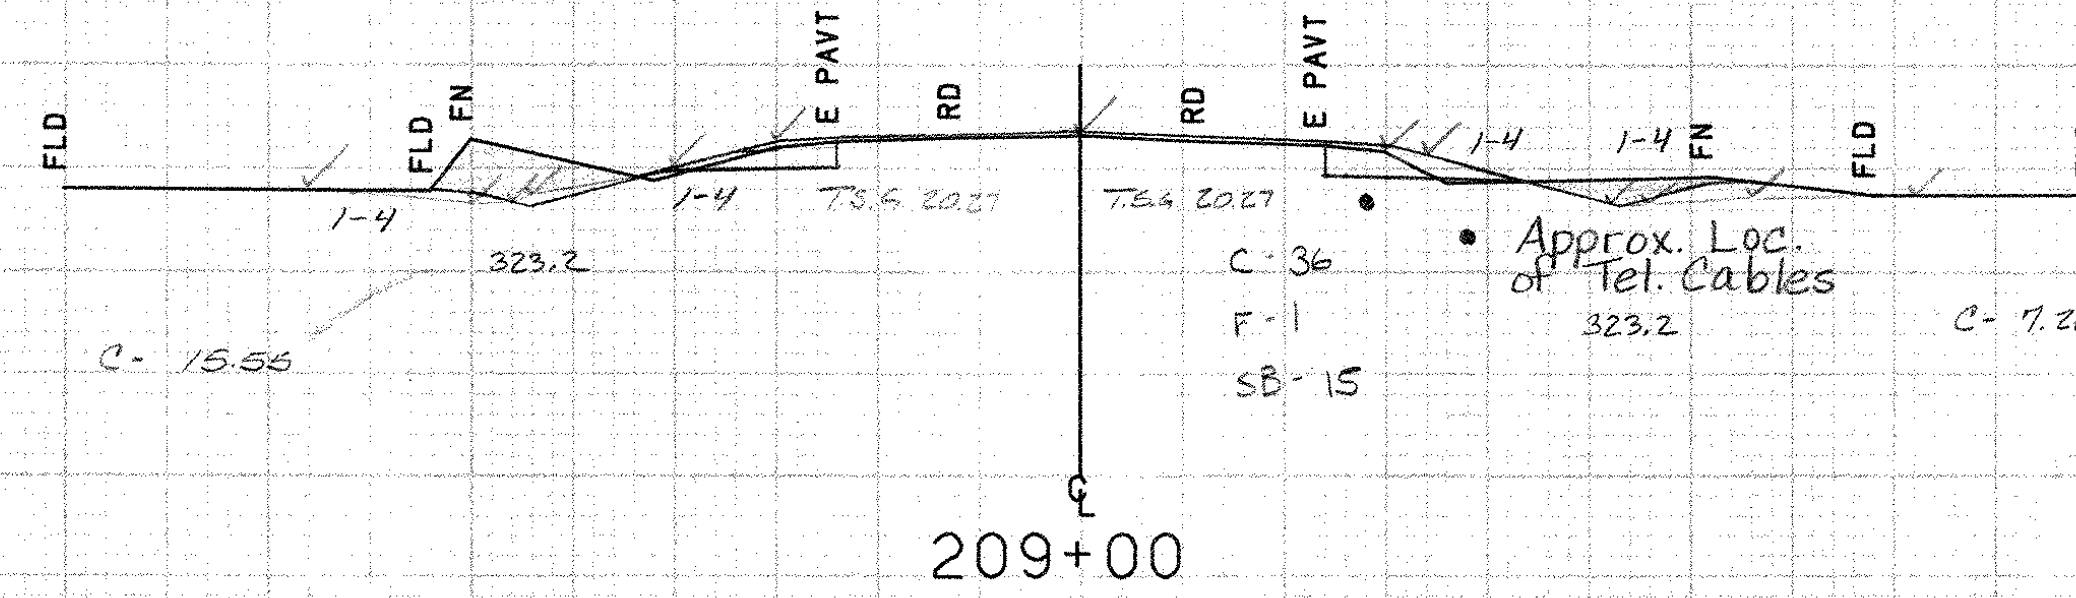

EARTH	
22.0	324.4
26.0	323.7
28.0	323.2
31.0	324.6
22.0	324.4

320


EARTH	
28.0	325.0
27.0	324.2
27.0	324.0
33.0	324.3
36.0	325.7
23.0	325.0

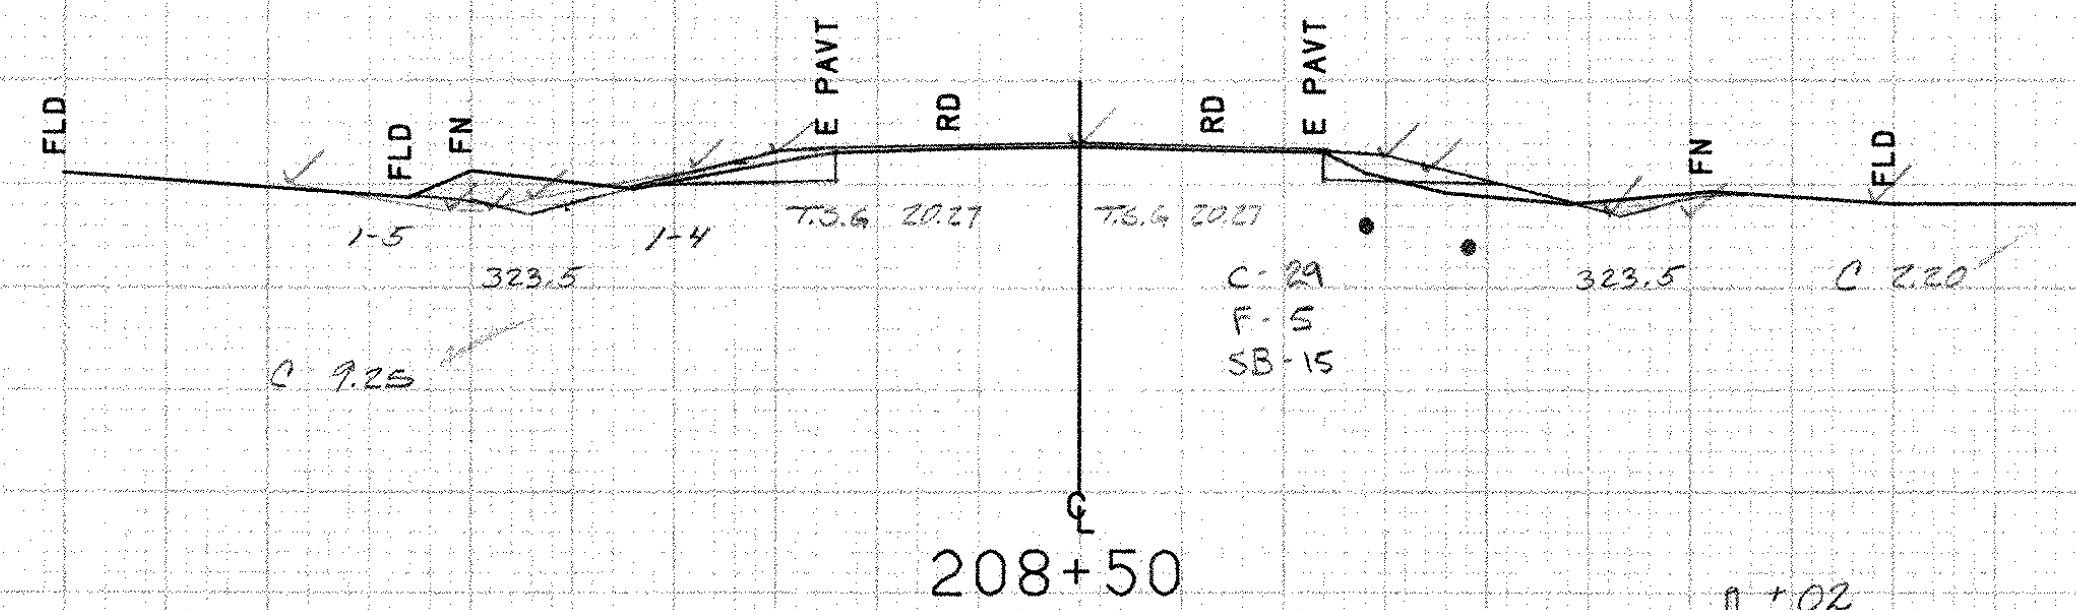

EARTH	
24.0	324.0
25.5	323.5
31.0	324.6
24.0	324.0

320


EARTH	
22.0	325.0
28.0	323.8
34.0	324.6
31.0	326.2
29.0	326.2
24.0	325.1
22.0	325.0

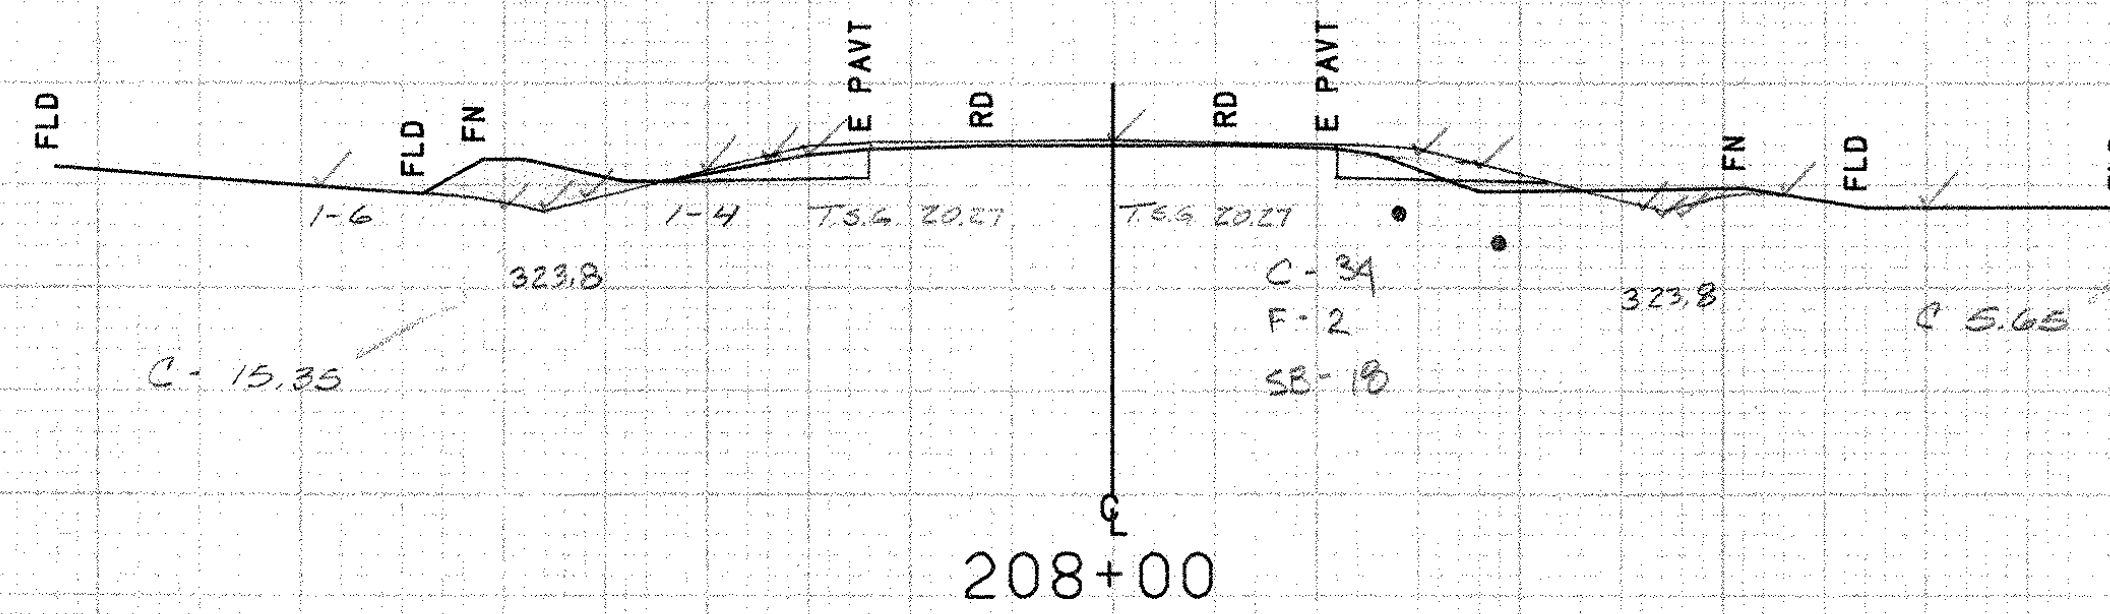

EARTH	
23.0	324.8
26.0	323.5
27.0	323.5
31.0	325.0
23.0	324.8

320


EARTH	
27.5	325.3
27.0	324.0
33.0	325.0
34.0	324.0
27.5	325.3

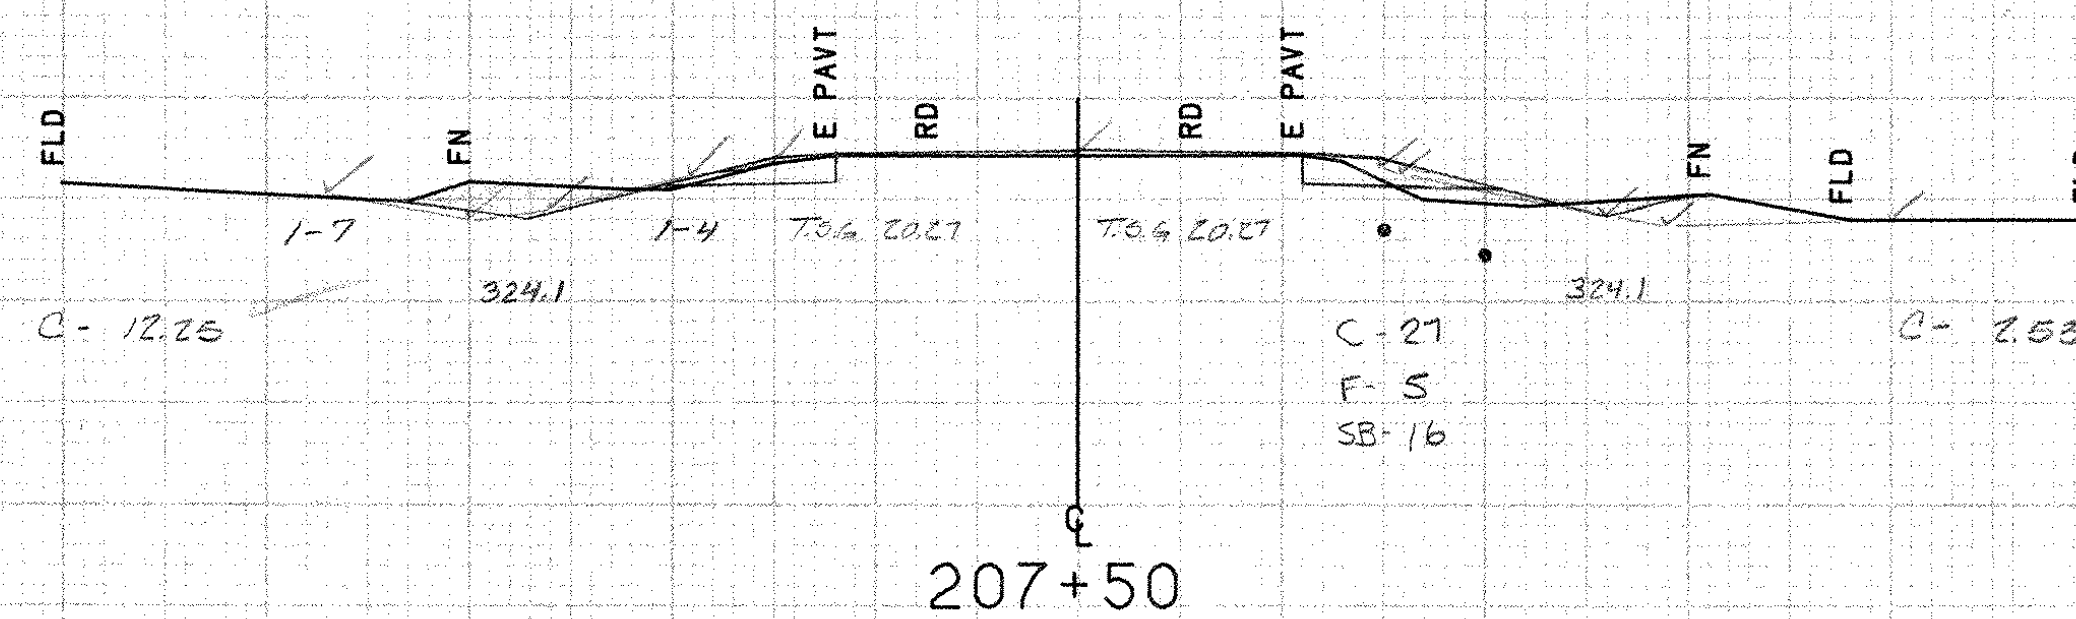

EARTH	
23.5	324.9
26.0	324.2
30.0	325.1
23.5	324.9

320

EARTH	
20.27	326.0
25.0	325.0
30.0	326.0
35.0	327.0
23.0	327.2
24.0	326.3
20.27	326.0

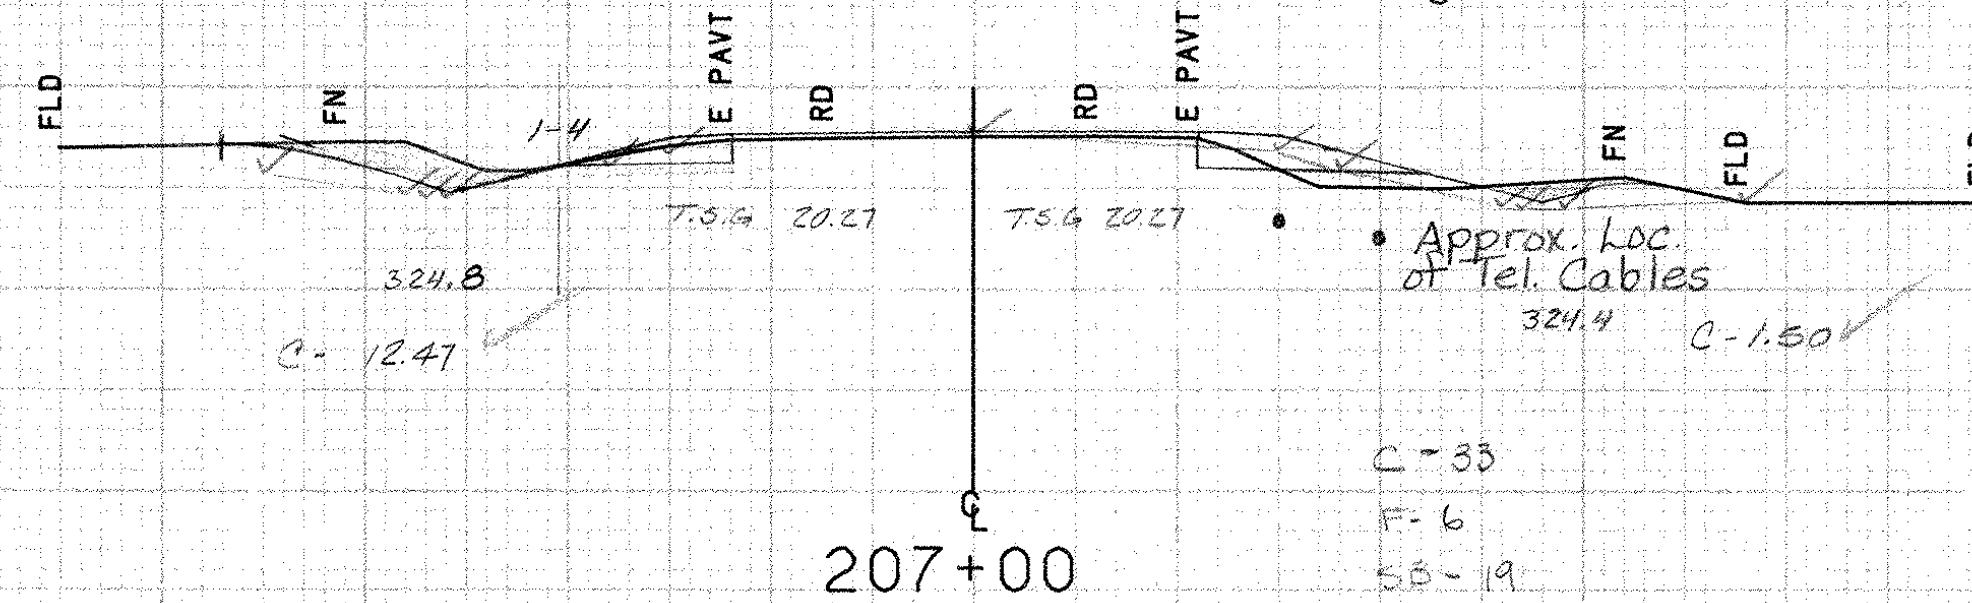

EARTH	
25.0	326.0
23.0	325.4
32.0	325.4
25.0	326.0

320

Bridport MM 3.86 ~ MM 4.06

FROM STA.	207+00	TO STA.	209+00
PROJECT NAME	SHOREHAM-BRIDPORT-ADDISON		
NO.	F017-1 (2)	PLOTTED	05/27/88
SURVEYED BY	MOREAU	05/88	0130
SHEET	338	OF 420 SHEETS	SHEET 338 OF 477

SCALE 1" = 10 FEET

cuts 5-6-92 456