


EARTH	
21.0	316.0
26.0	315.0
28.0	314.3
29.0	314.0
32.0	314.8
25.0	316.0
21.0	316.0

214+00 Lt
 End Special Ditch w/
 Erosion Matting
 Begin Ditch Cleaning
 (To be paid as All
 Purpose Excavator Rental,
 Type I.)

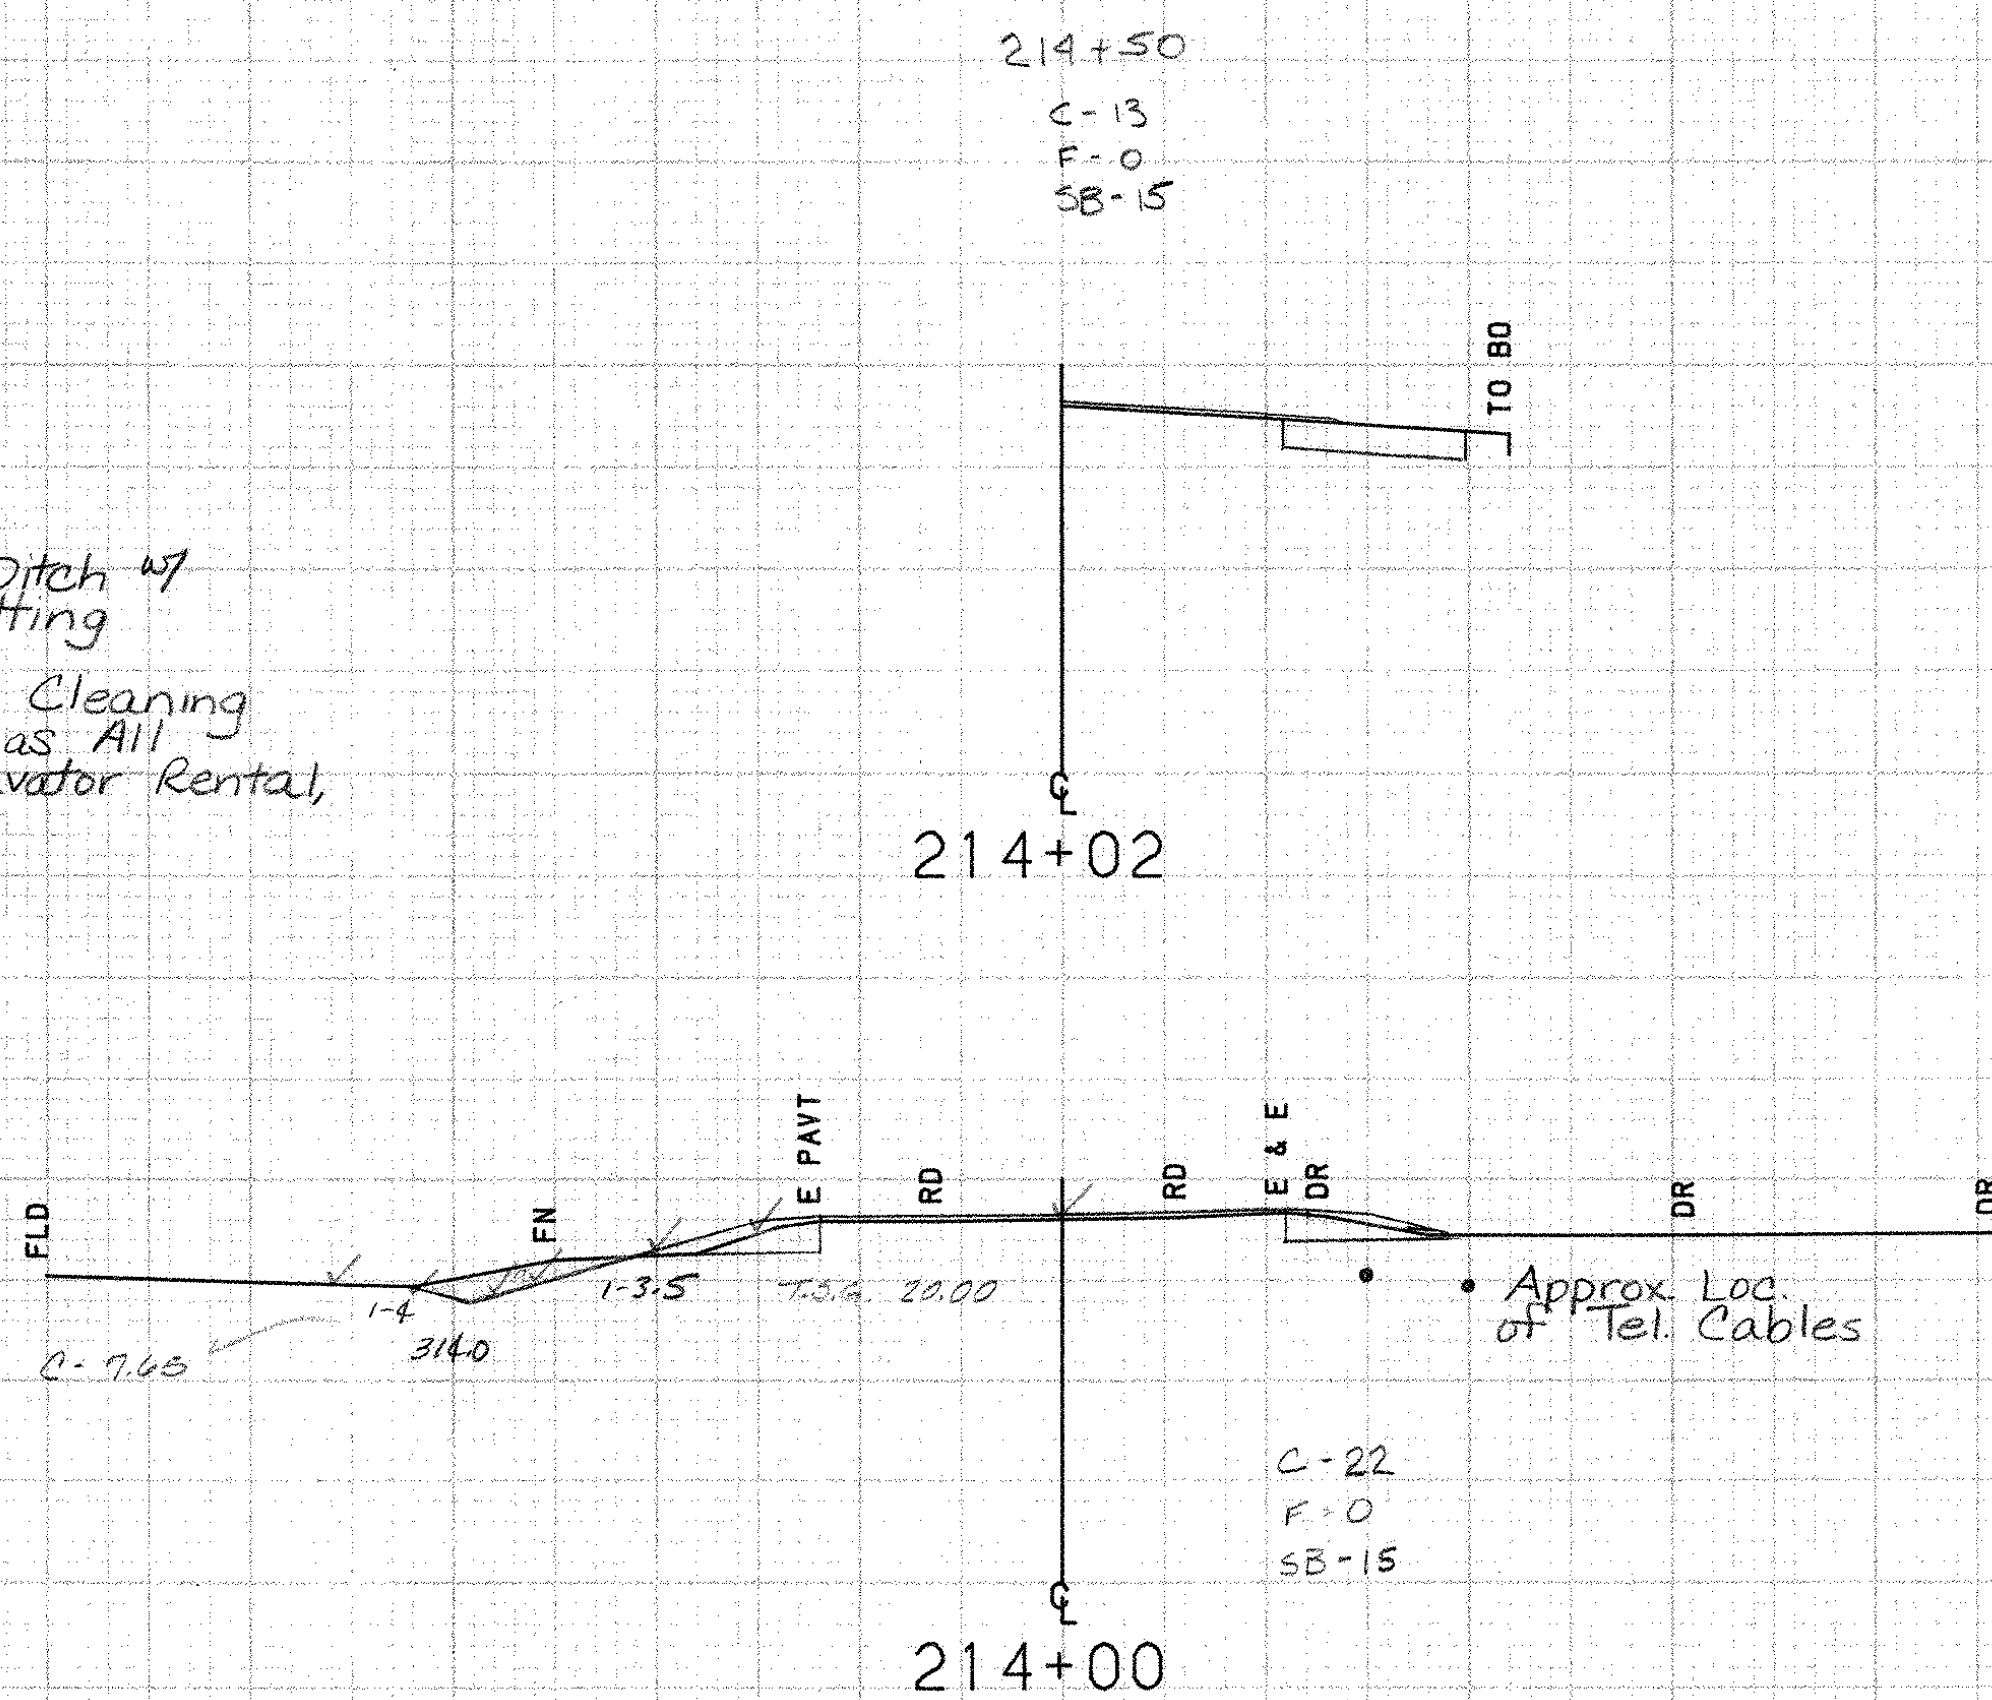

310

310

213+96 RT
 15" CMP - Retain

Bridport MM 3.86 ~MM 4.06

FROM STA.	214+00	TO STA.	214+02
PROJECT NAME	SHOREHAM-BRIDPORT-ADDISON		
NO.	F017-1 (2)	PLOTTED	05/27/88
SURVEYED BY	MOREAU	05/88	0130
SHEET	341	OF	420 SHEETS

SCALE 1" = 10 FEET

Cont. ✓ 5-6-92 WJG