

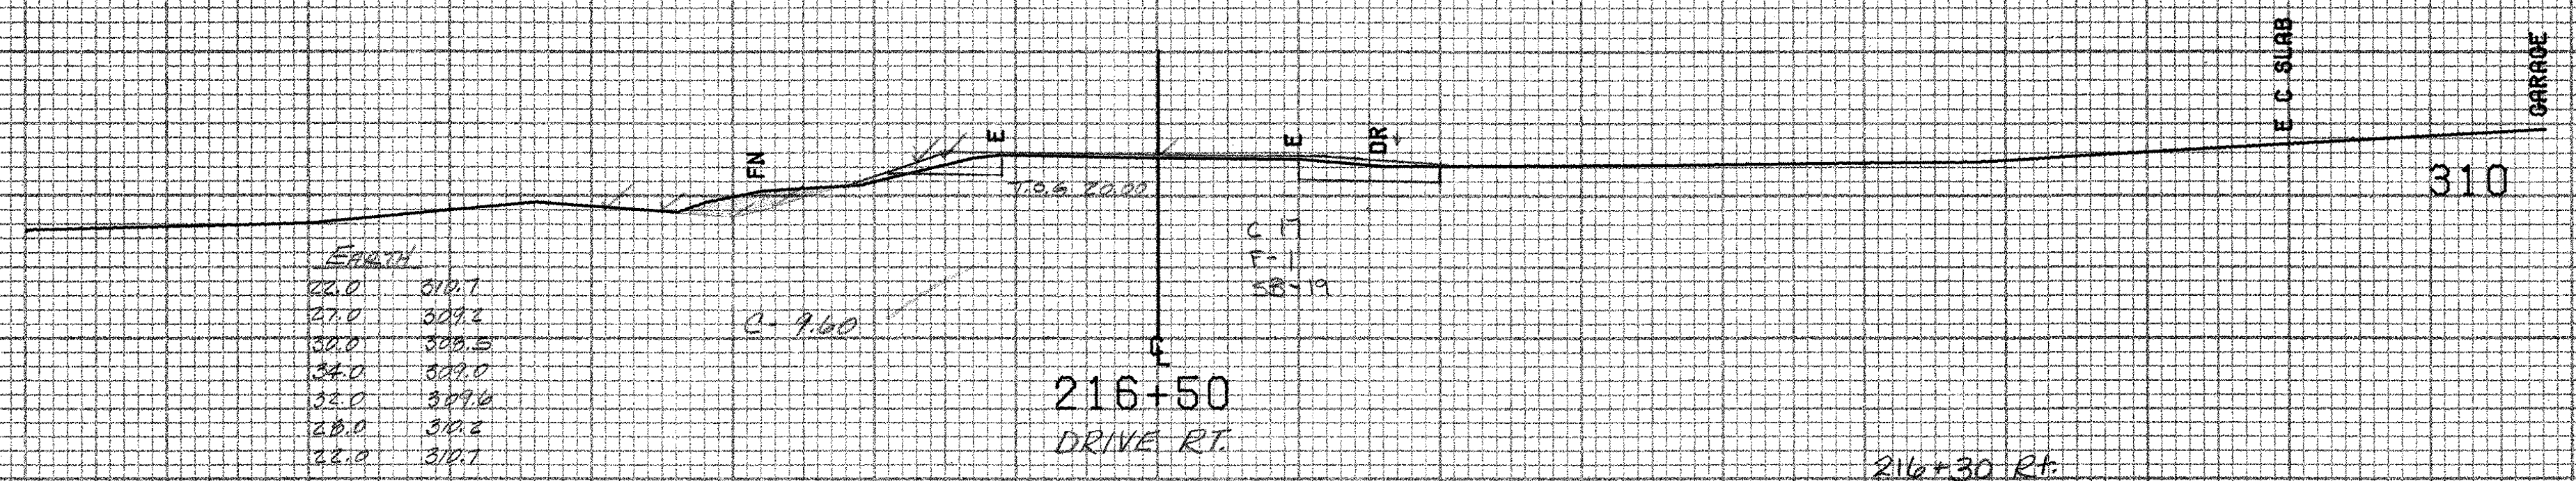
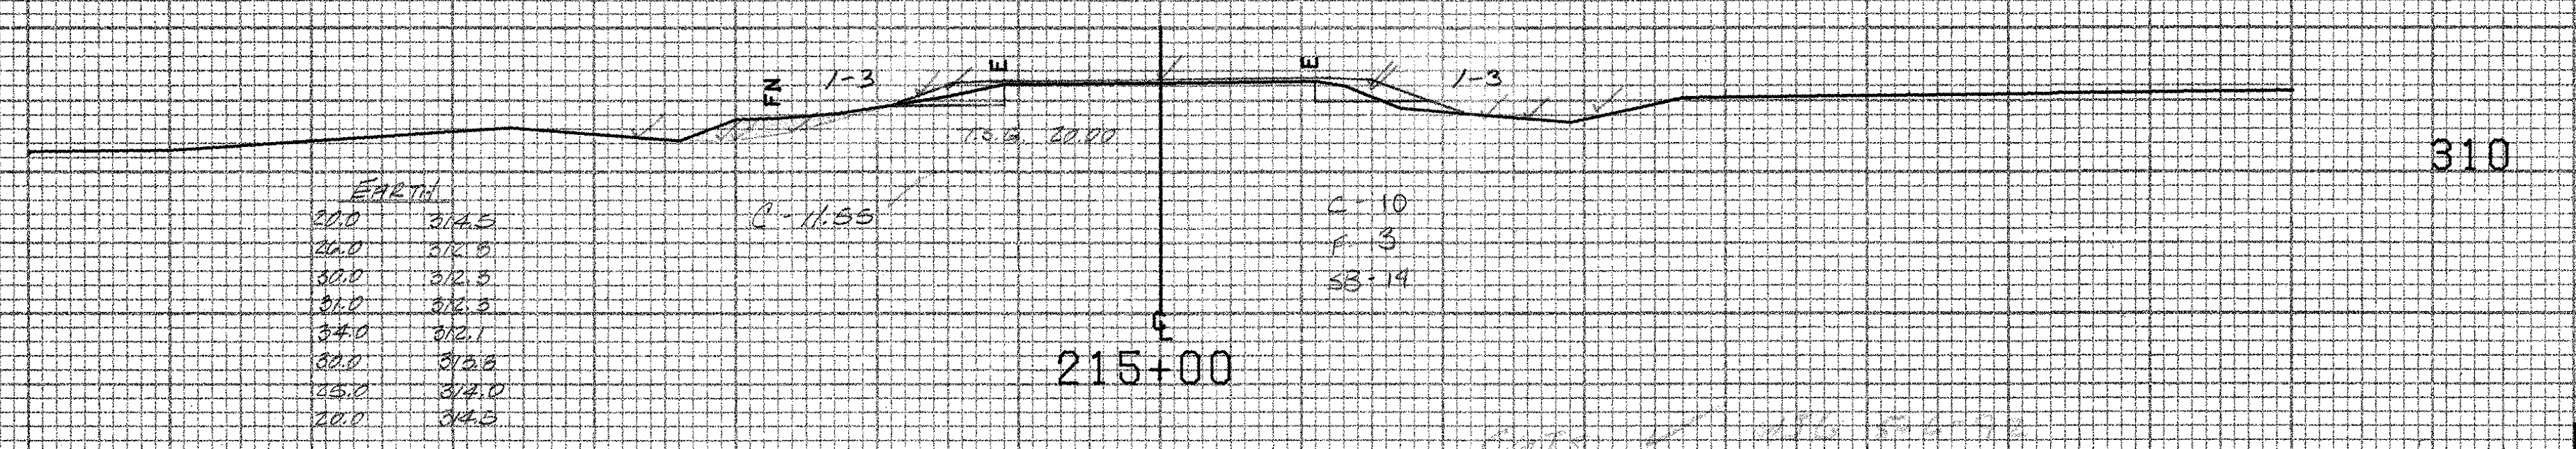


216+52 RT
 12" CMP - Remove
 New 15" x 42" GSP (.064) OR
 RCP CL III

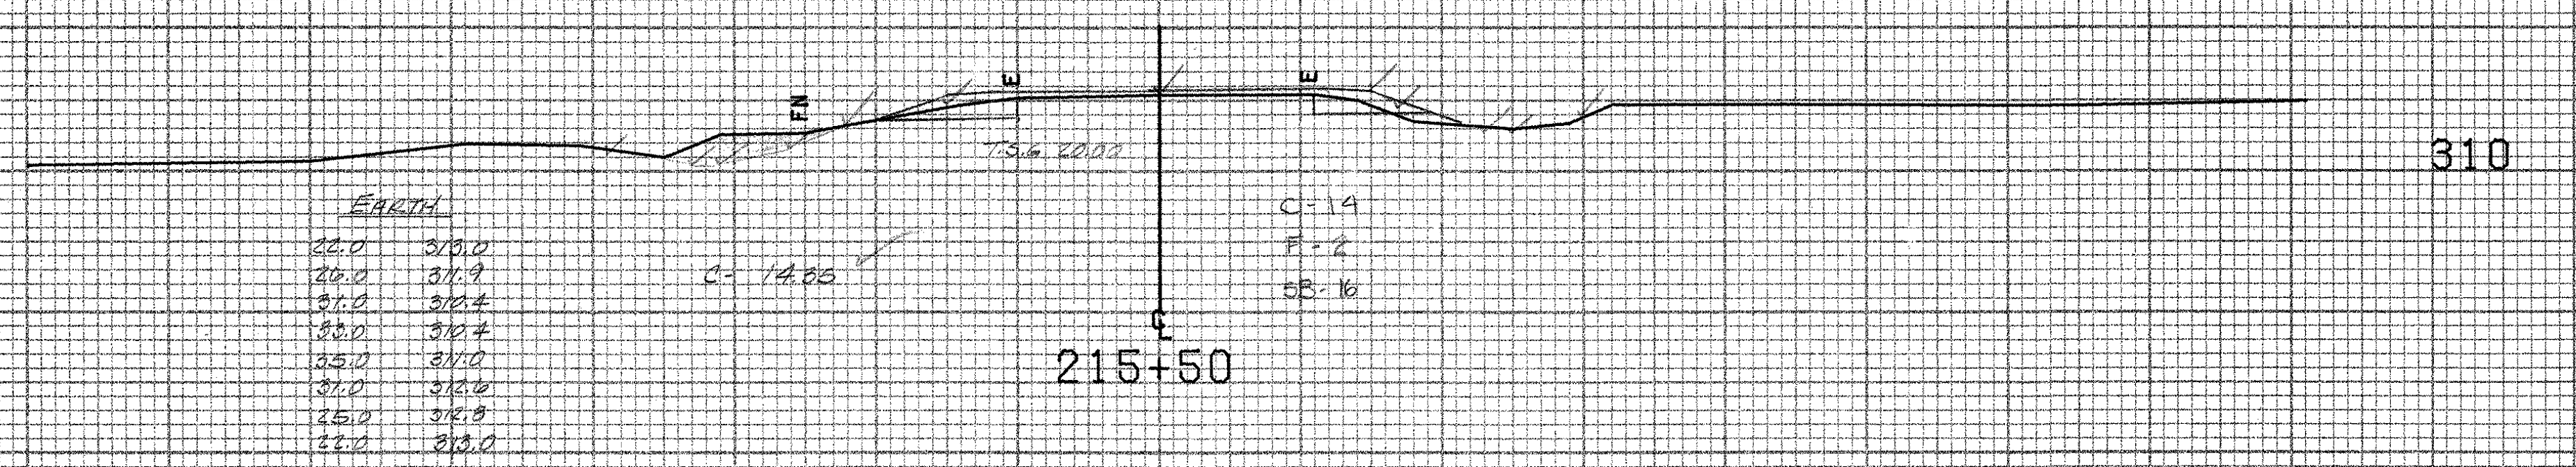

216+30 Rt.
 End Ditch Cleaning
 (To be Paid as All
 Purpose Excavator
 Rental, Type F)

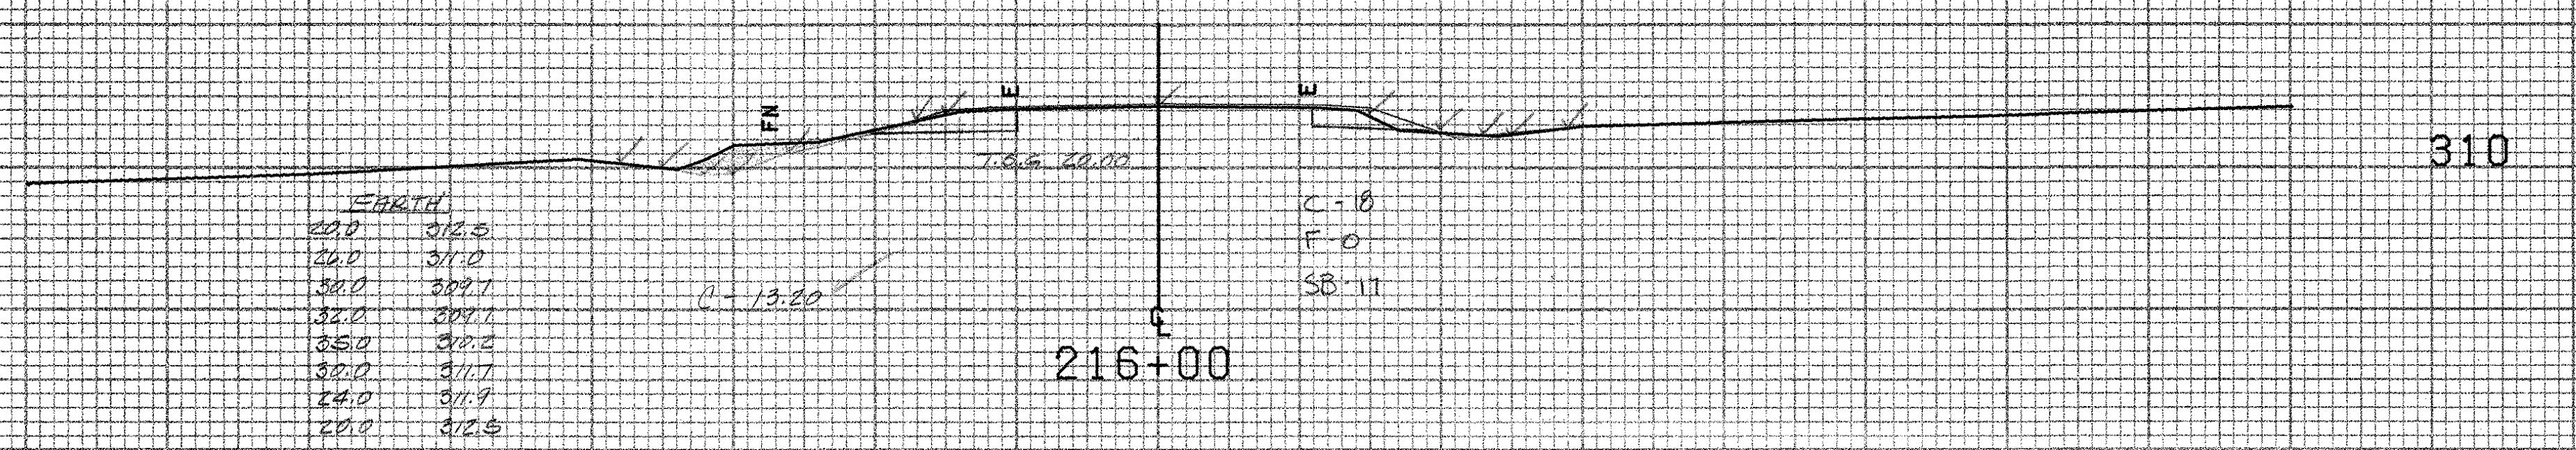

Bridport MM 4.06 ~ 4.24

FROM STA.	215+00	TO STA.	216+50
PROJECT NAME	SHOREHAM-BRIDPORT-ADDISON MAIN		
NO.	F017-1(2)	PLOTTED	04/11/85
SURVEYED BY	BUSHEY	FEB	1985
SHEET	342	OF	420 SHEETS
		SHEET	342 OF 420

SCALE 1" = 10 FEET