
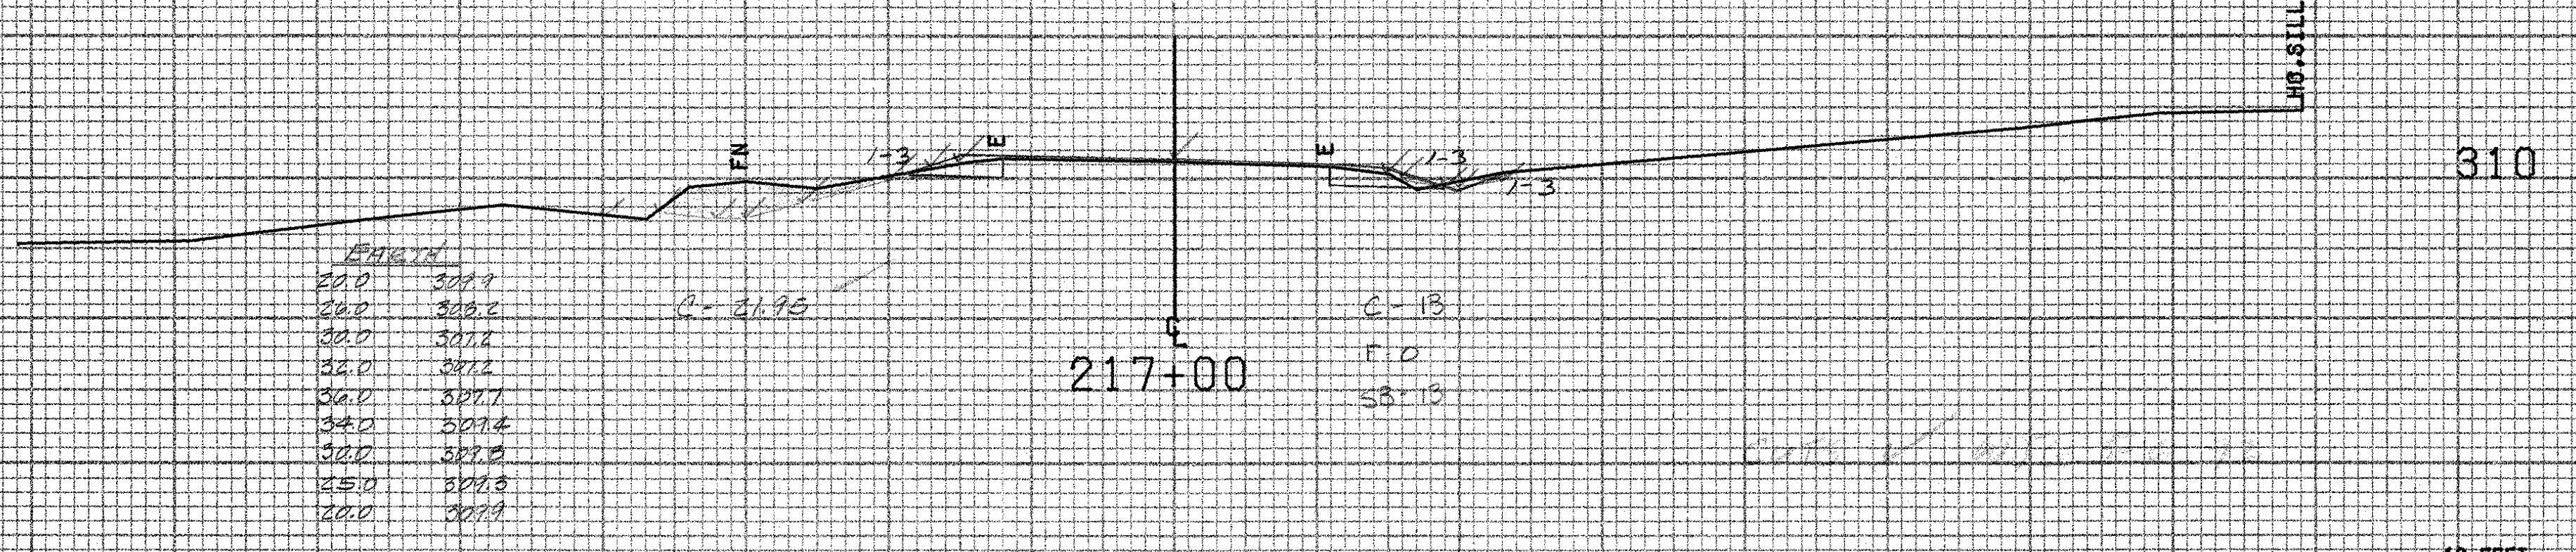
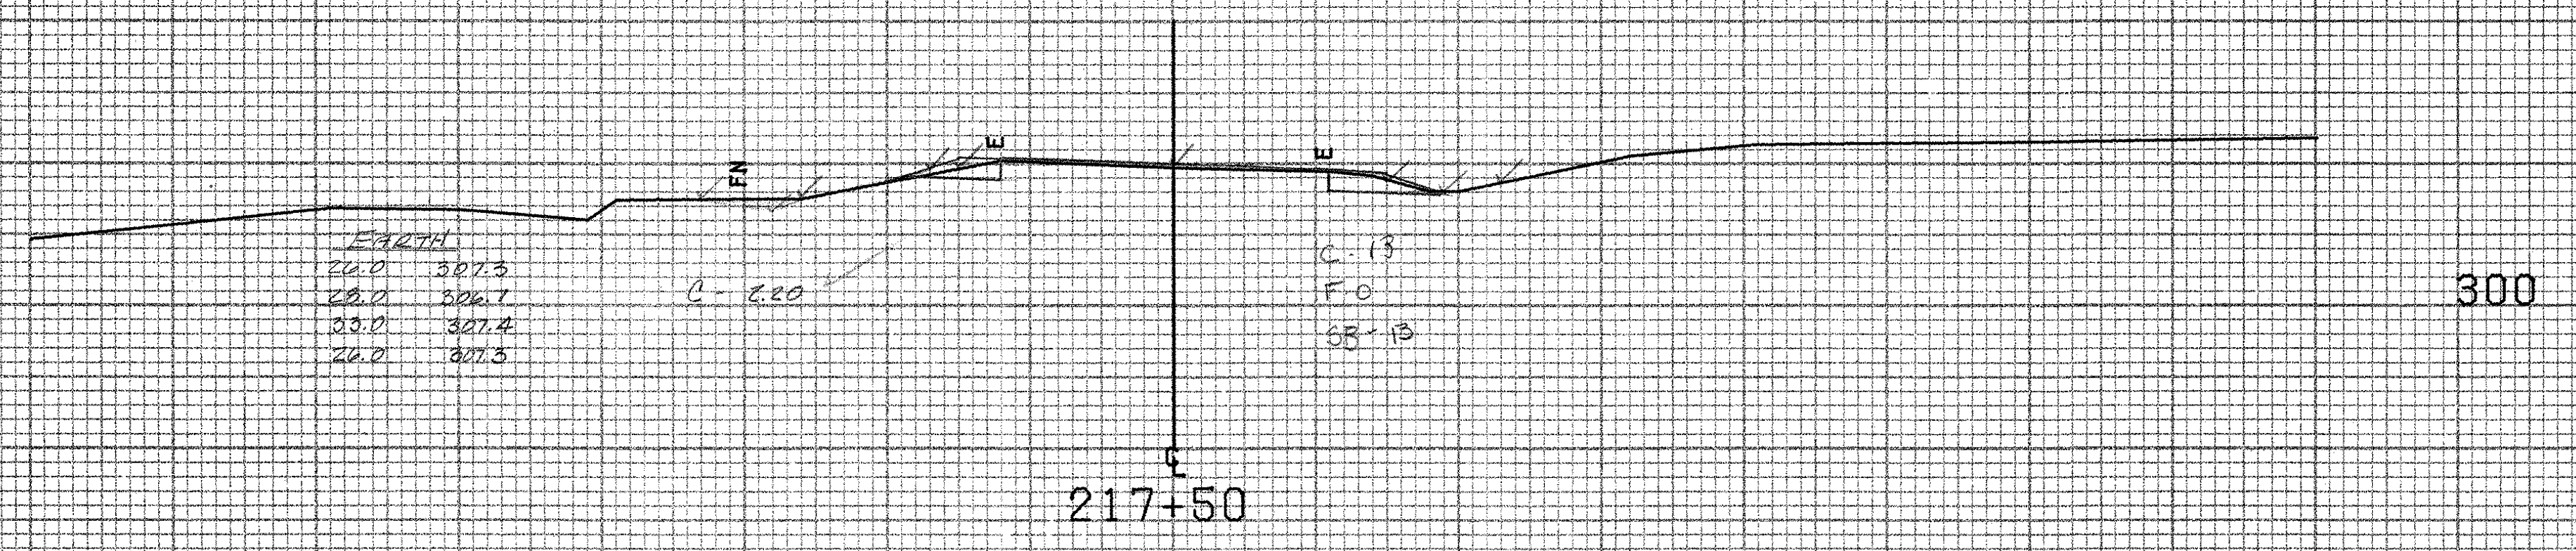


218+10 LT  
 End Removing and  
 Resetting Fence  
 End Temporary Barbed Wire Fence (4-Strand)  
 END REMOVAL OF EXISTING FENCE

218+00 LT  
 End Ditch Cleaning  
 (to be paid as All  
 Purpose Excavator  
 Rental, Type I)

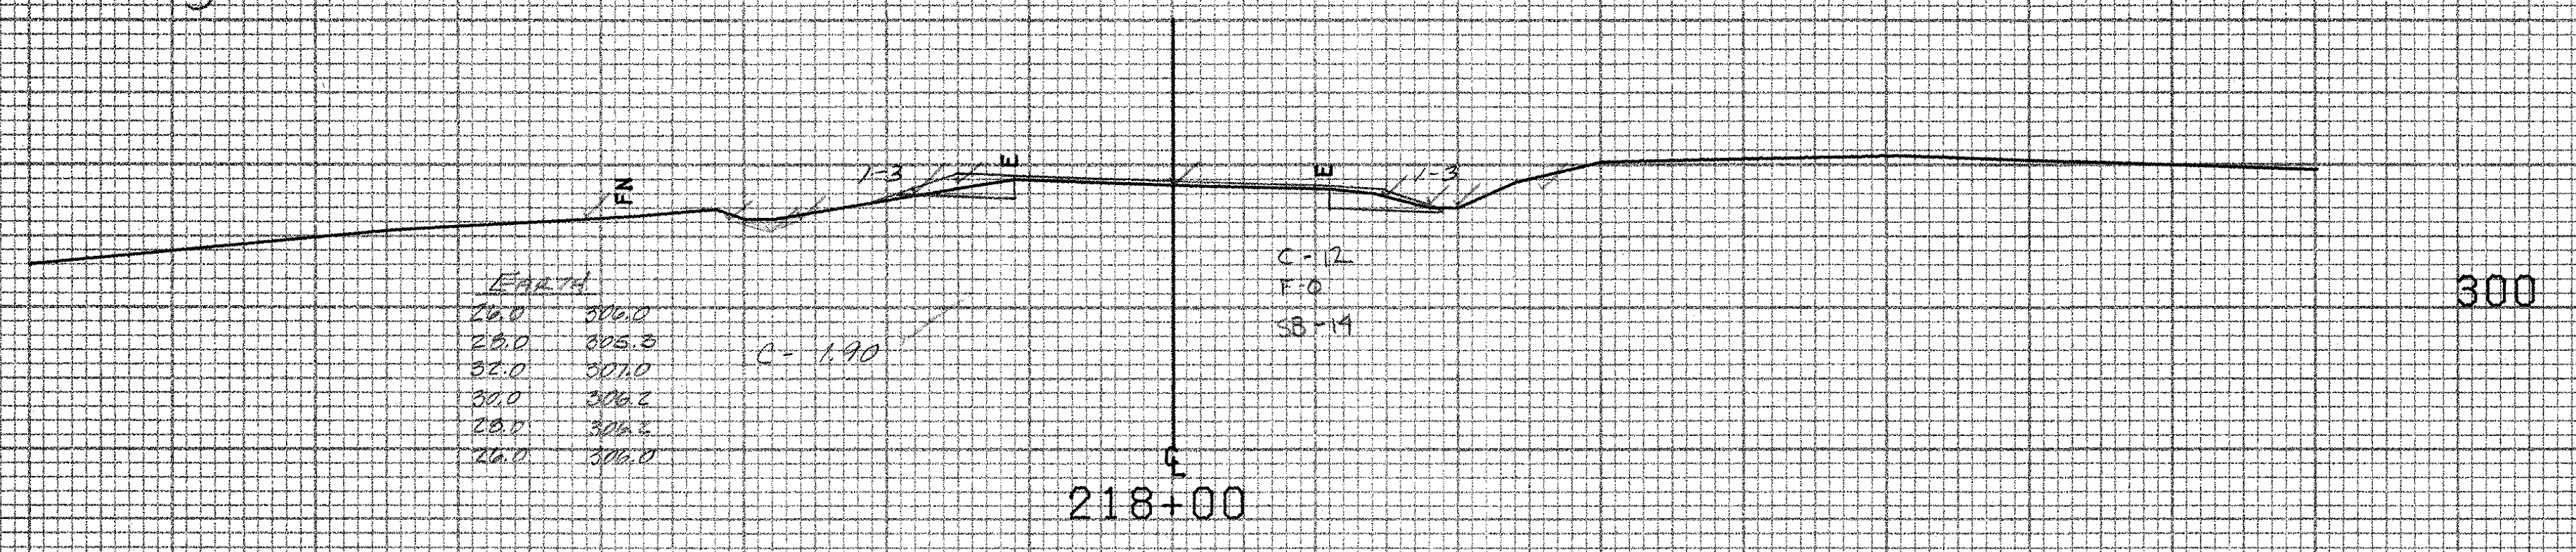

Bridport MM 4.06 ~ 4.24

FROM STA.	217+00	TO STA.	218+00
PROJECT NAME	SHOREHAM-BRIDPORT-ADDISON MAIN		
NO.	F017-1(2)	PLOTTED	04/11/85
SURVEYED BY	BUSHEY	FEB 1985	
SHEET	342 OF 424 SHEETS	SHEET	342 OF 477

SCALE 1" = 30 FEET