

EARTH	
20.0	498.6
20.0	498.0
22.0	498.4
24.0	498.9
28.0	499.0
28.0	499.6

PC 21+96.58  
 D 11'-00" LT  
 Bank proposed 0.080 F/ft  
 V-40 M.P.H.  
 C 1.10 ✓

+02  
 18" Loc  
 Remove

6'-0"  
 497.5  
 7.5% 20.00  
 Water Line

Approx. Loc.  
 of Tel. Cables

C-# 23  
 F-# 0  
 SB - 17

490

21+75 LT  
 Begin Sprial Ditch  
 w/ Erosion Matting


22+00

+50  
 30' M  
 Stamp

EQ. 223+50 =  
 21+52.5  
 -20,197.5 ft.

+53  
 48' M  
 Save

490

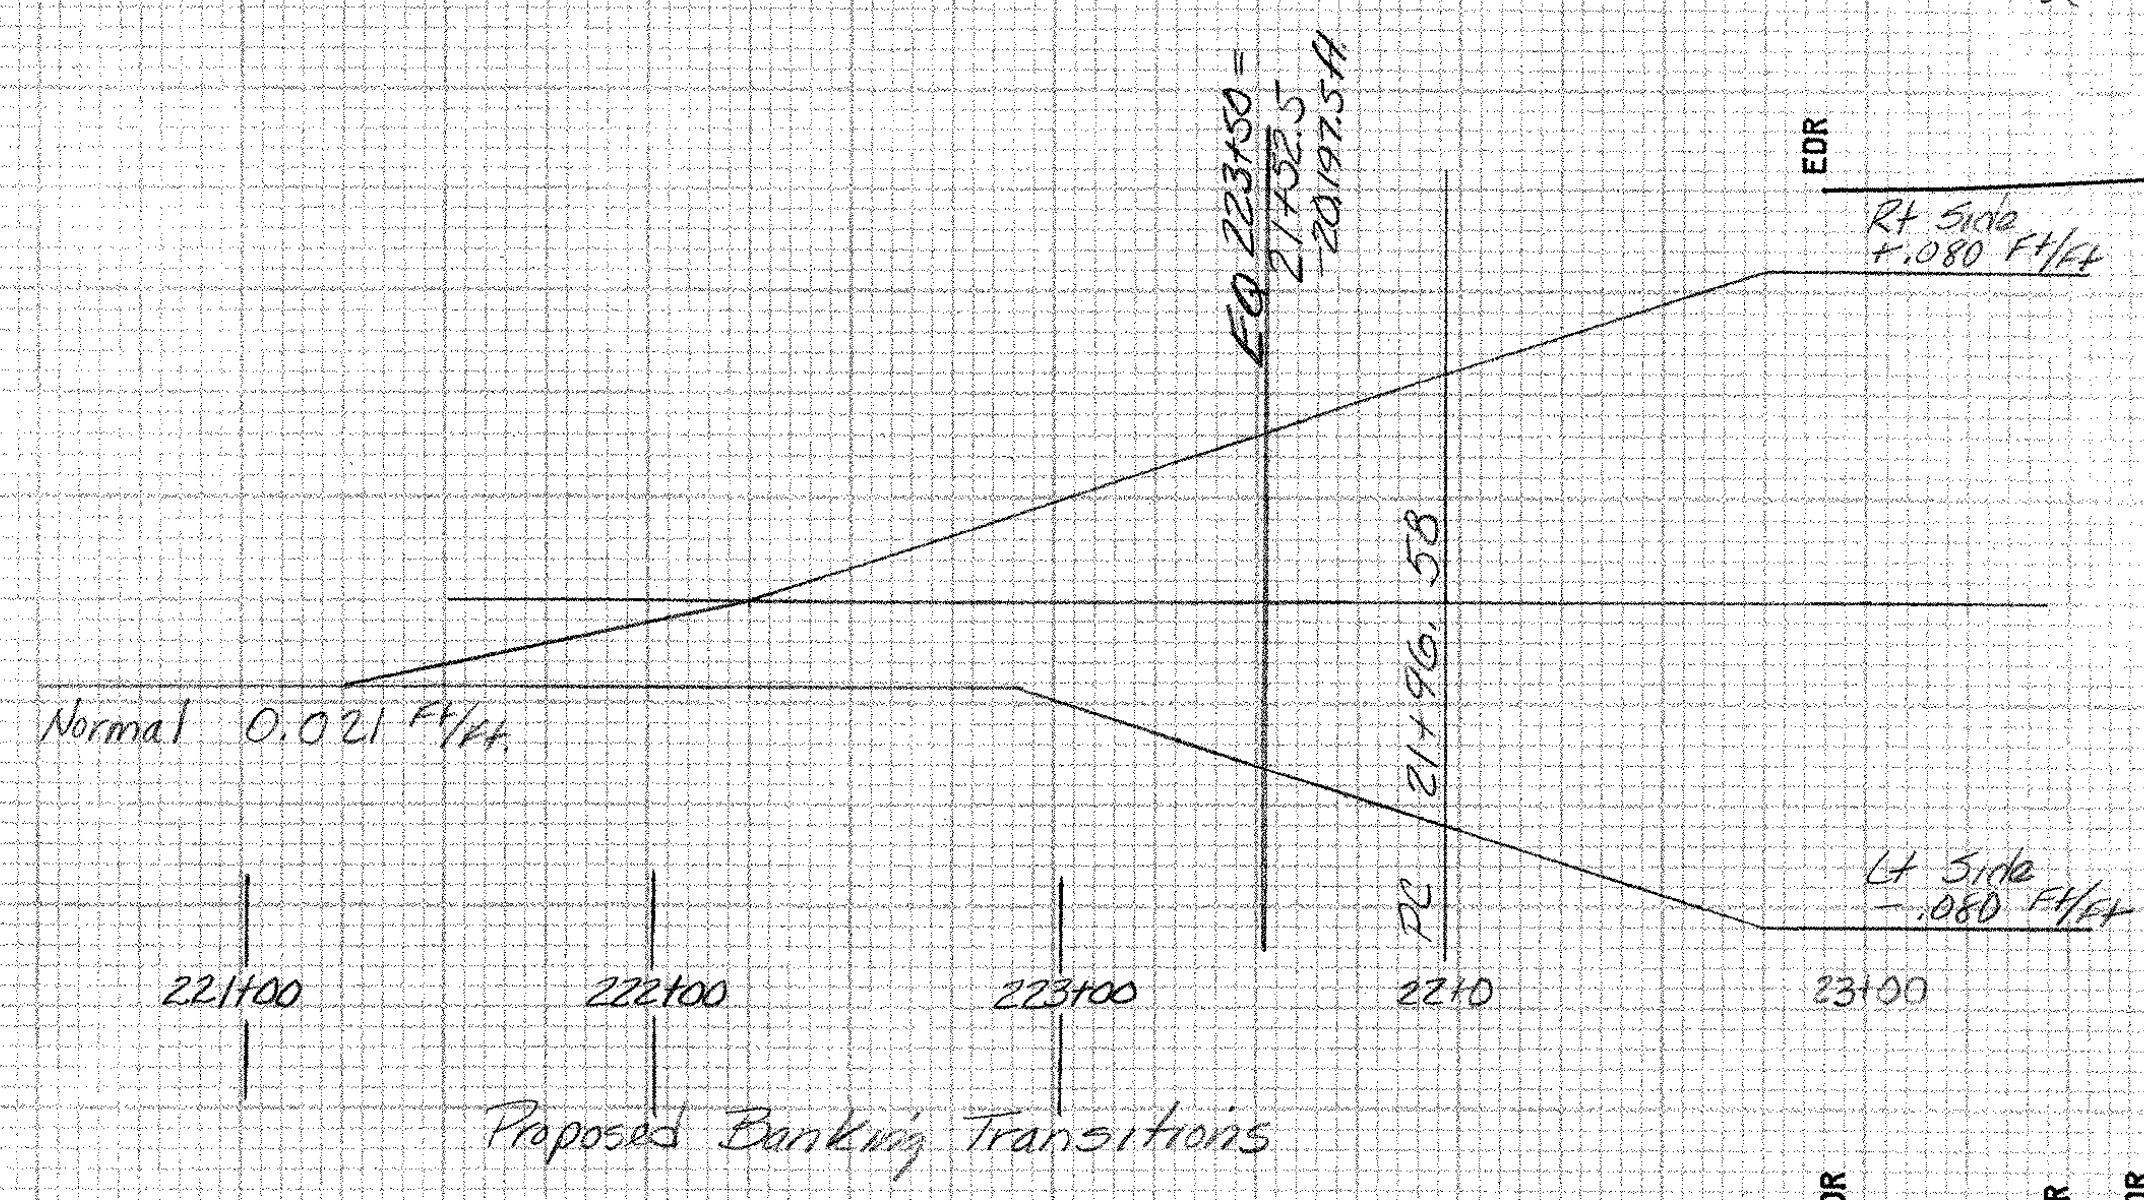

EDR  
 Rt Side  
 0.080 F/ft

EDR  
 Lt Side  
 0.080 F/ft

21+50

21+00

Proposed Banking Transitions

BRIDPORT MM 4.24 ~ MM 4.34

FROM STA.	20+70	TO STA.	22+00
PROJECT NAME	SHOREHAM-BRIDPORT-ADDISON		
NO.	F017-1(2)	PLOTTED	02/14/84
SURVEYED BY	FANTONI	JAN	1984
SHEET	348 OF 420 SHEETS	SHEET	348 OF 477

SCALE 1" = 10 FEET