

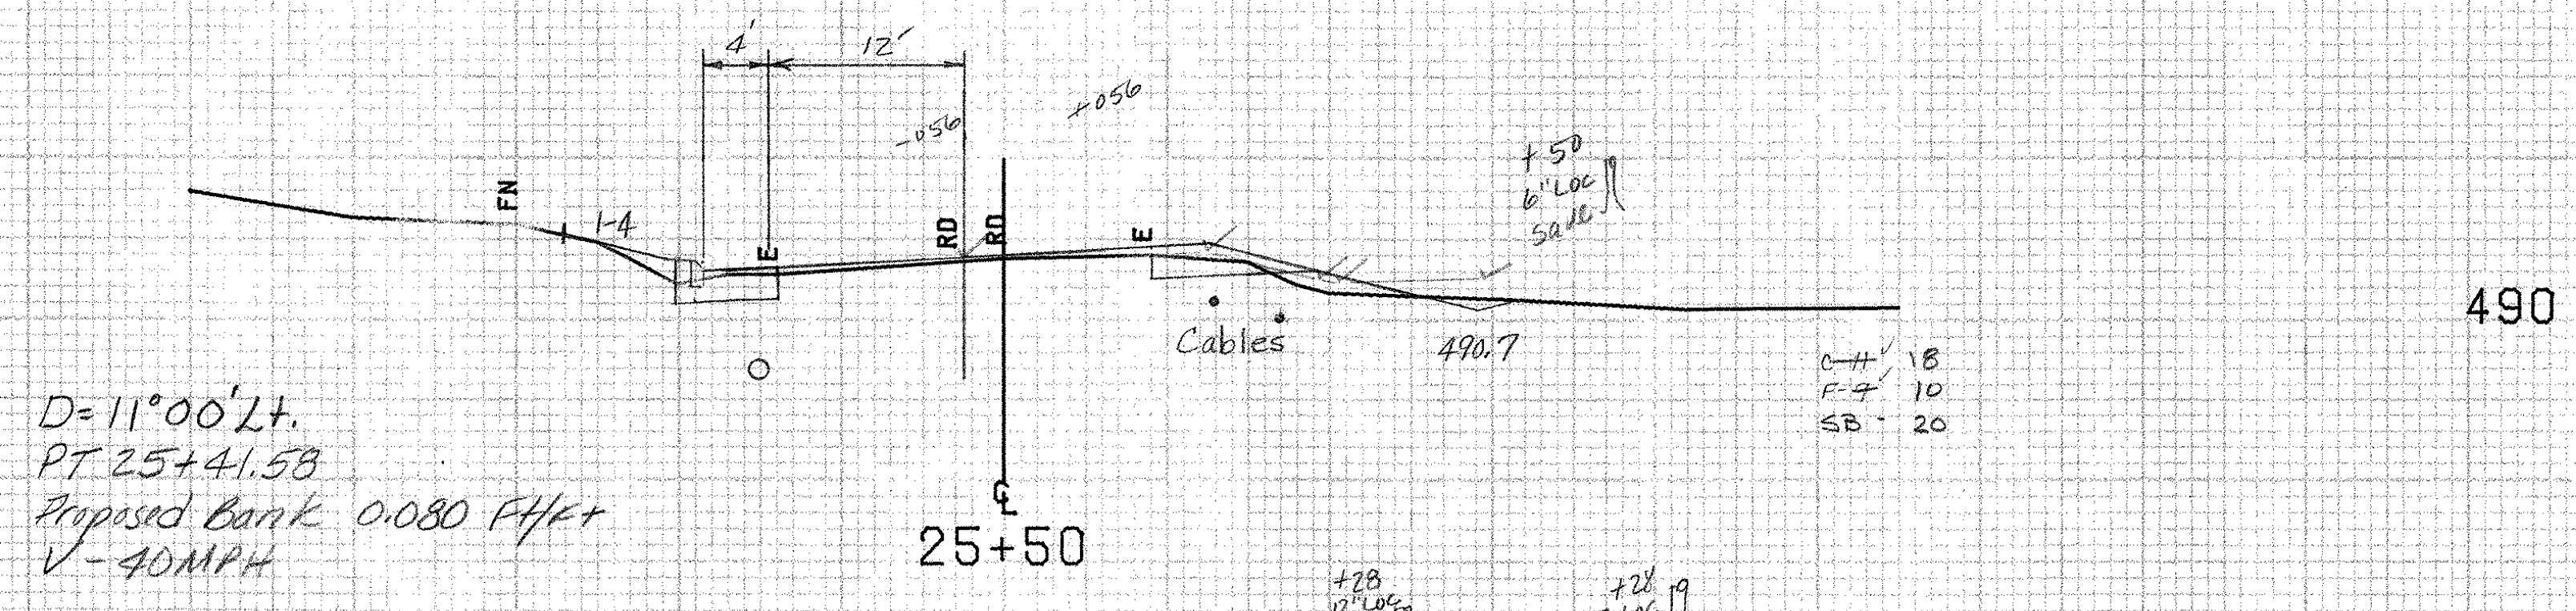


25+75 LT
 End Cast In Place Concrete
 Curb, Type A
 Begin Special Ditch w/ Erosion Matting

25+80 RT
 End Special Ditch w/ Erosion Matting

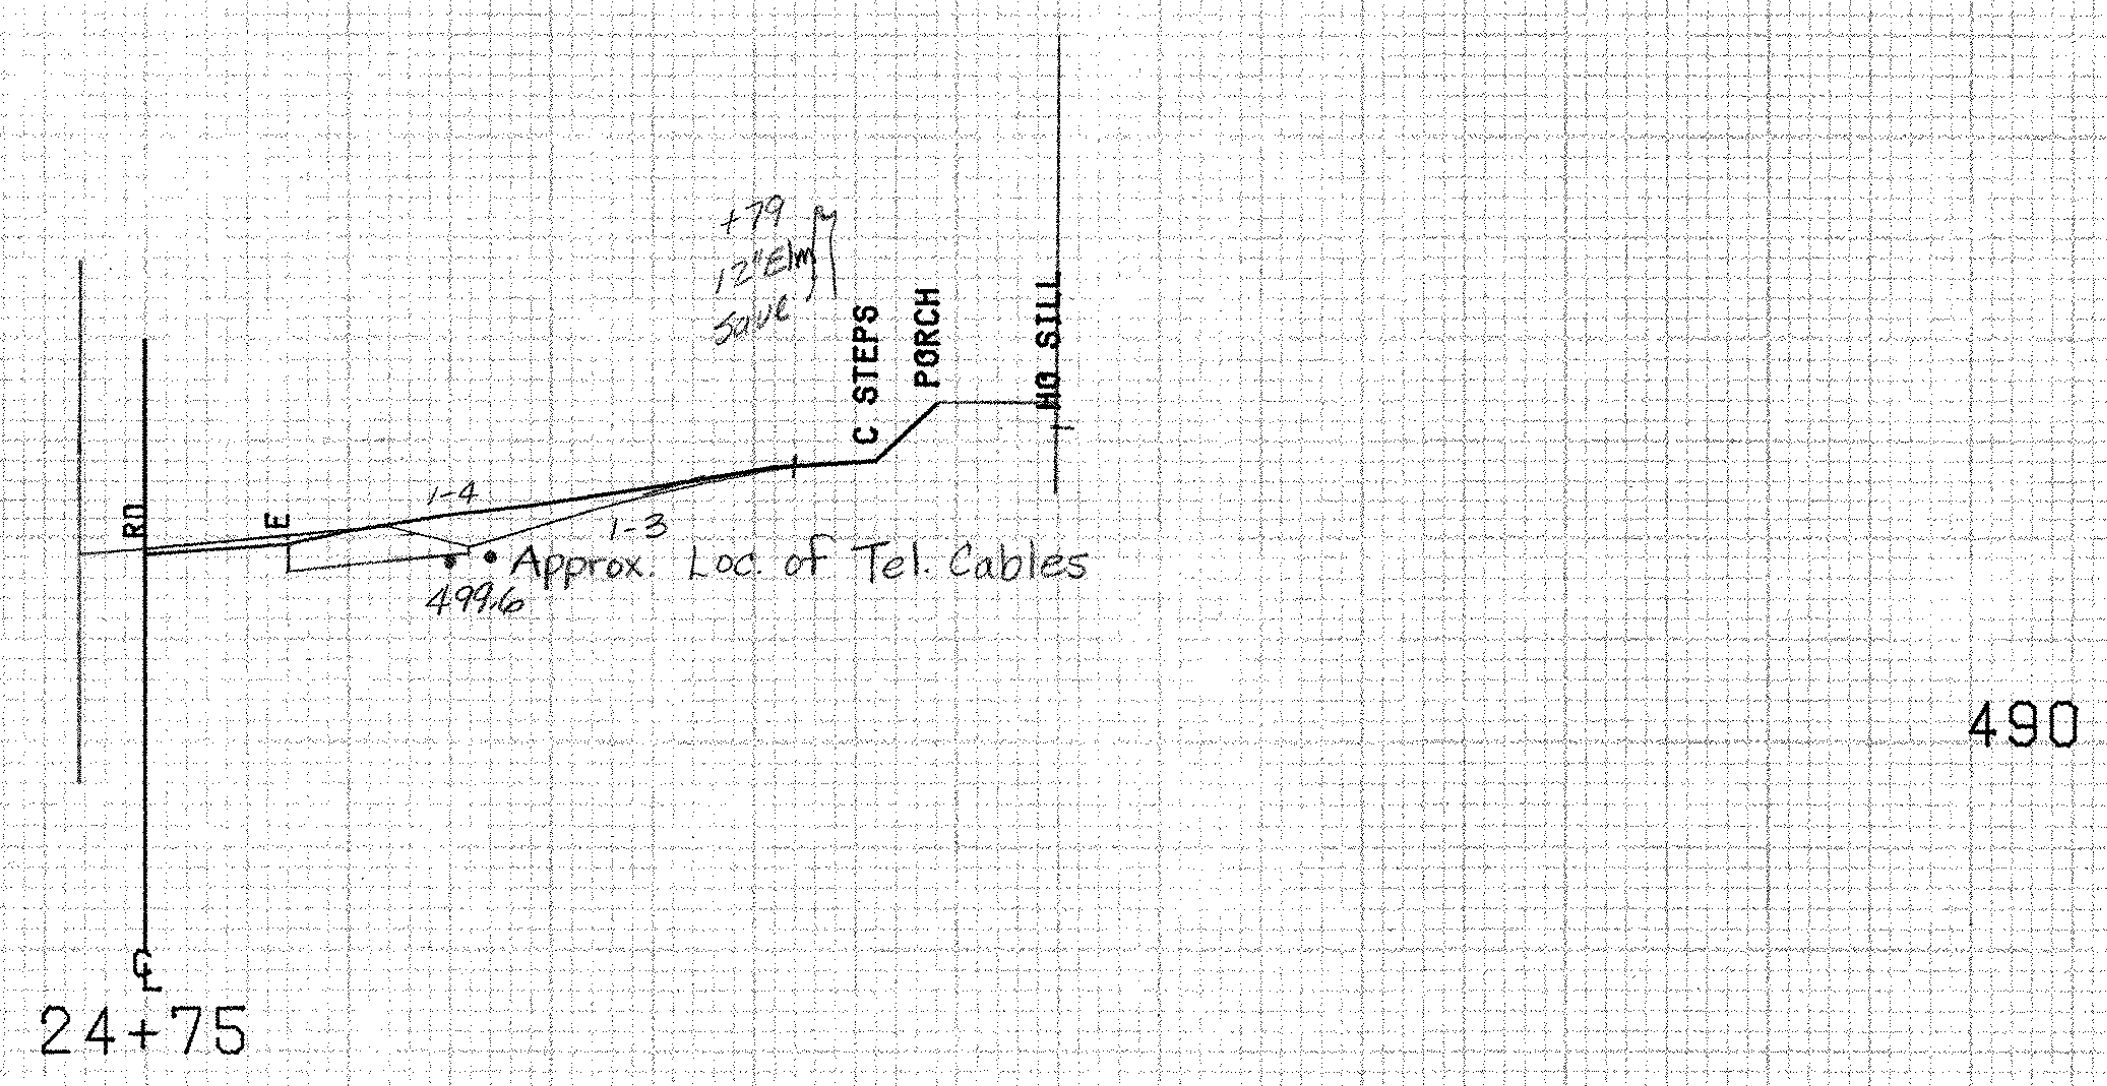

25+00 LT
 Begin Removing & Resetting Fence
 Begin Temporary Barbed Wire fence (4-strand)
 BEGIN REMOVAL OF EXISTING FENCE

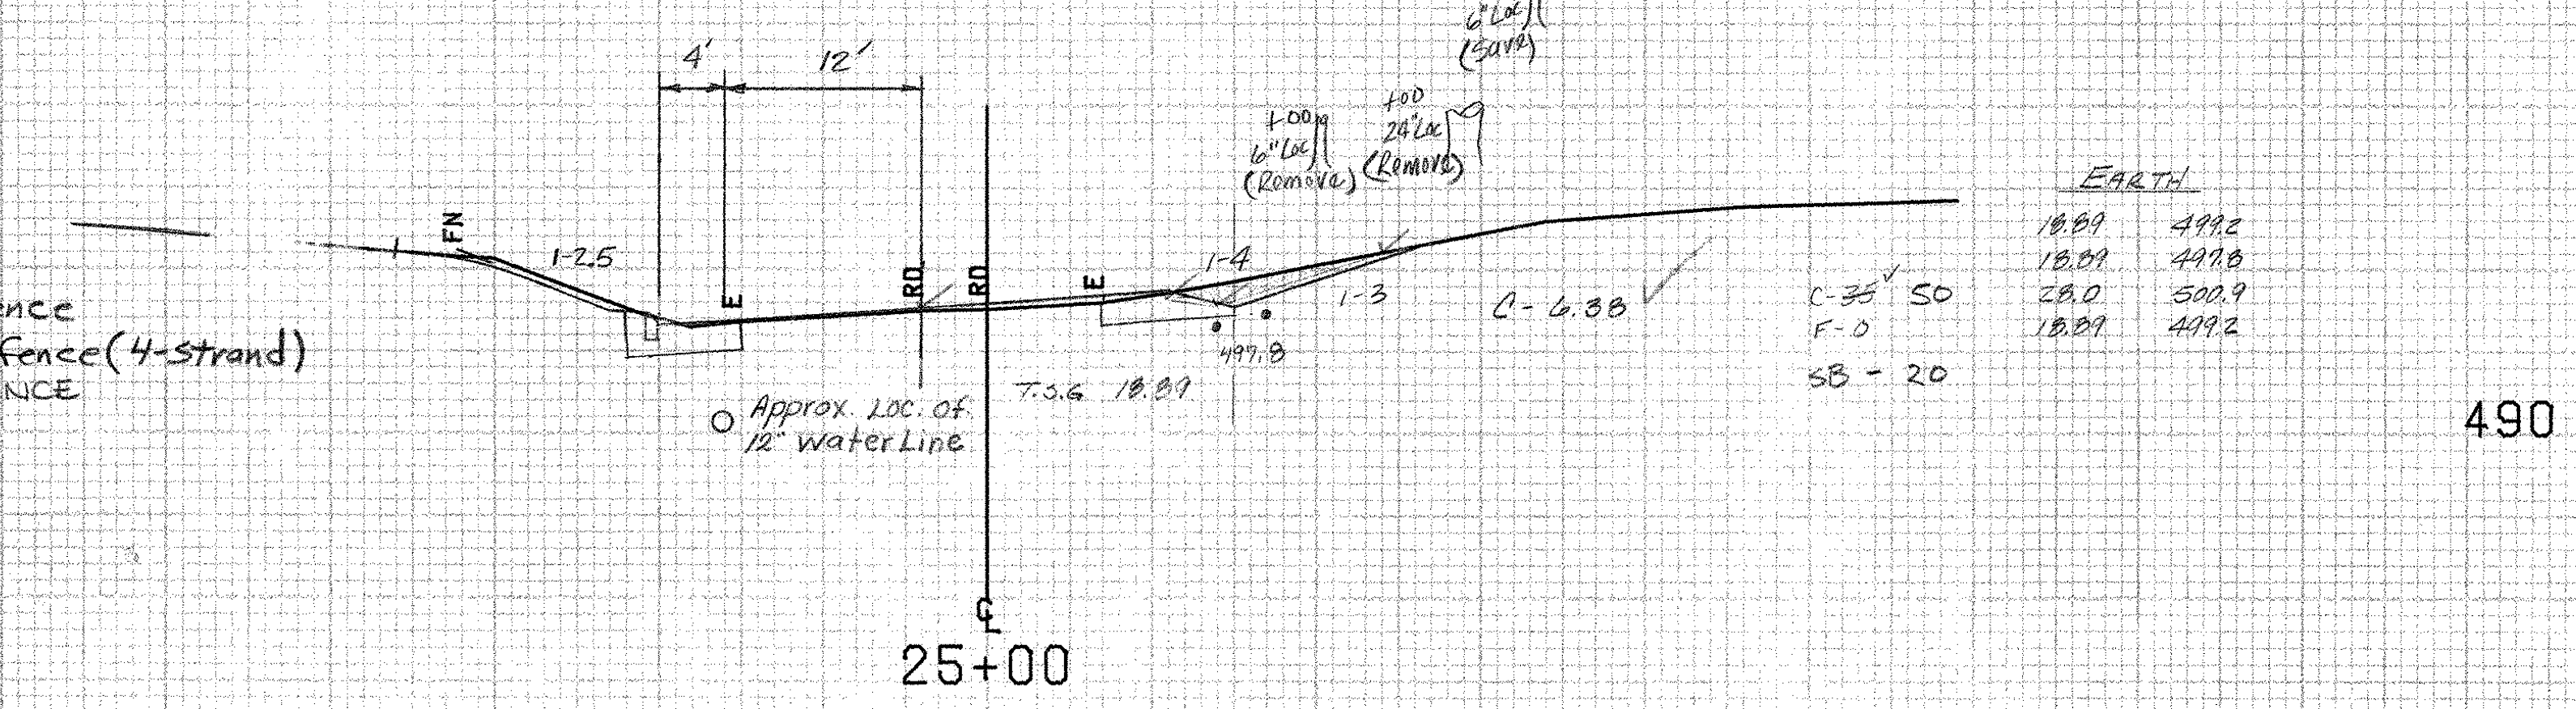

EARTH

16.89	4992
18.09	4978
28.0	5009
18.89	4992

BRIDPORT MM 4.24 ~ MM 4.34

FROM STA.	24+75	TO STA.	25+50
PROJECT NAME	SHOREHAM-BRIDPORT-ADDISON		
NO.	F017-1(2)	PLOTTED	02/14/84
SURVEYED BY	FANTONI	JAN	1984
SHEET	357 OF 420 SHEETS	SHEET	351 OF 477

SCALE 1" = 10 FEET