


242+00 Lt.
Begin Steel Beam Guard Rail


EARTH	
24.0	503.3
25.0	501.9
29.0	501.9
37.0	503.6
40.0	504.0
33.0	505.0
24.0	503.3

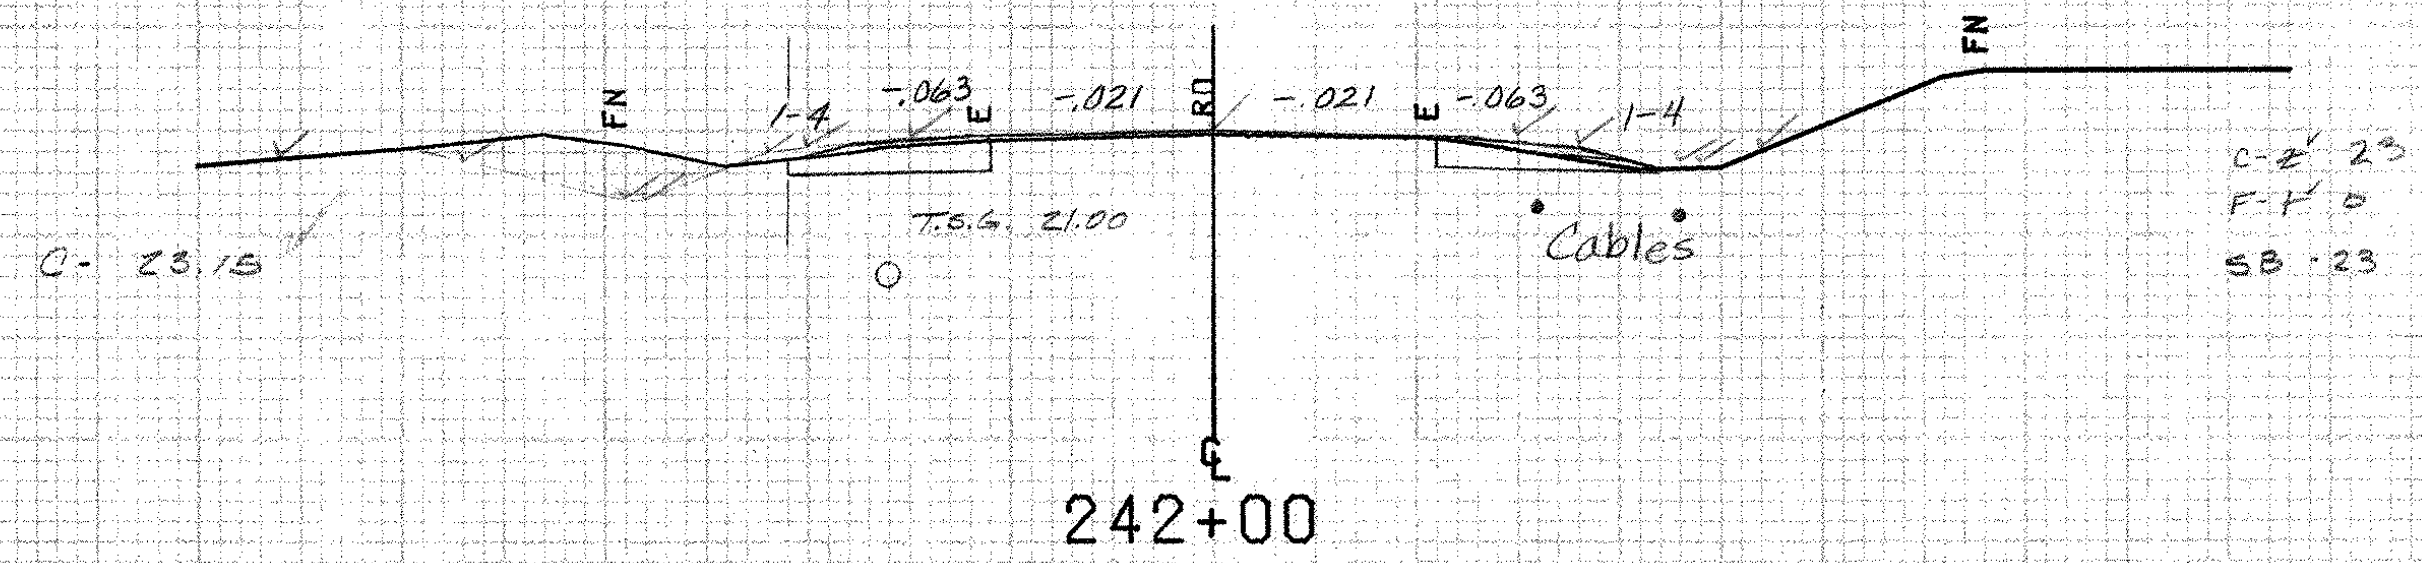

500


241+75 ~ 242+00 Lt.
Breakaway Cable Terminal

EARTH	
19.0	505.2
19.0	504.1
21.0	504.4
24.0	503.4
26.0	503.6
23.0	505.0
27.0	506.0
19.0	505.2

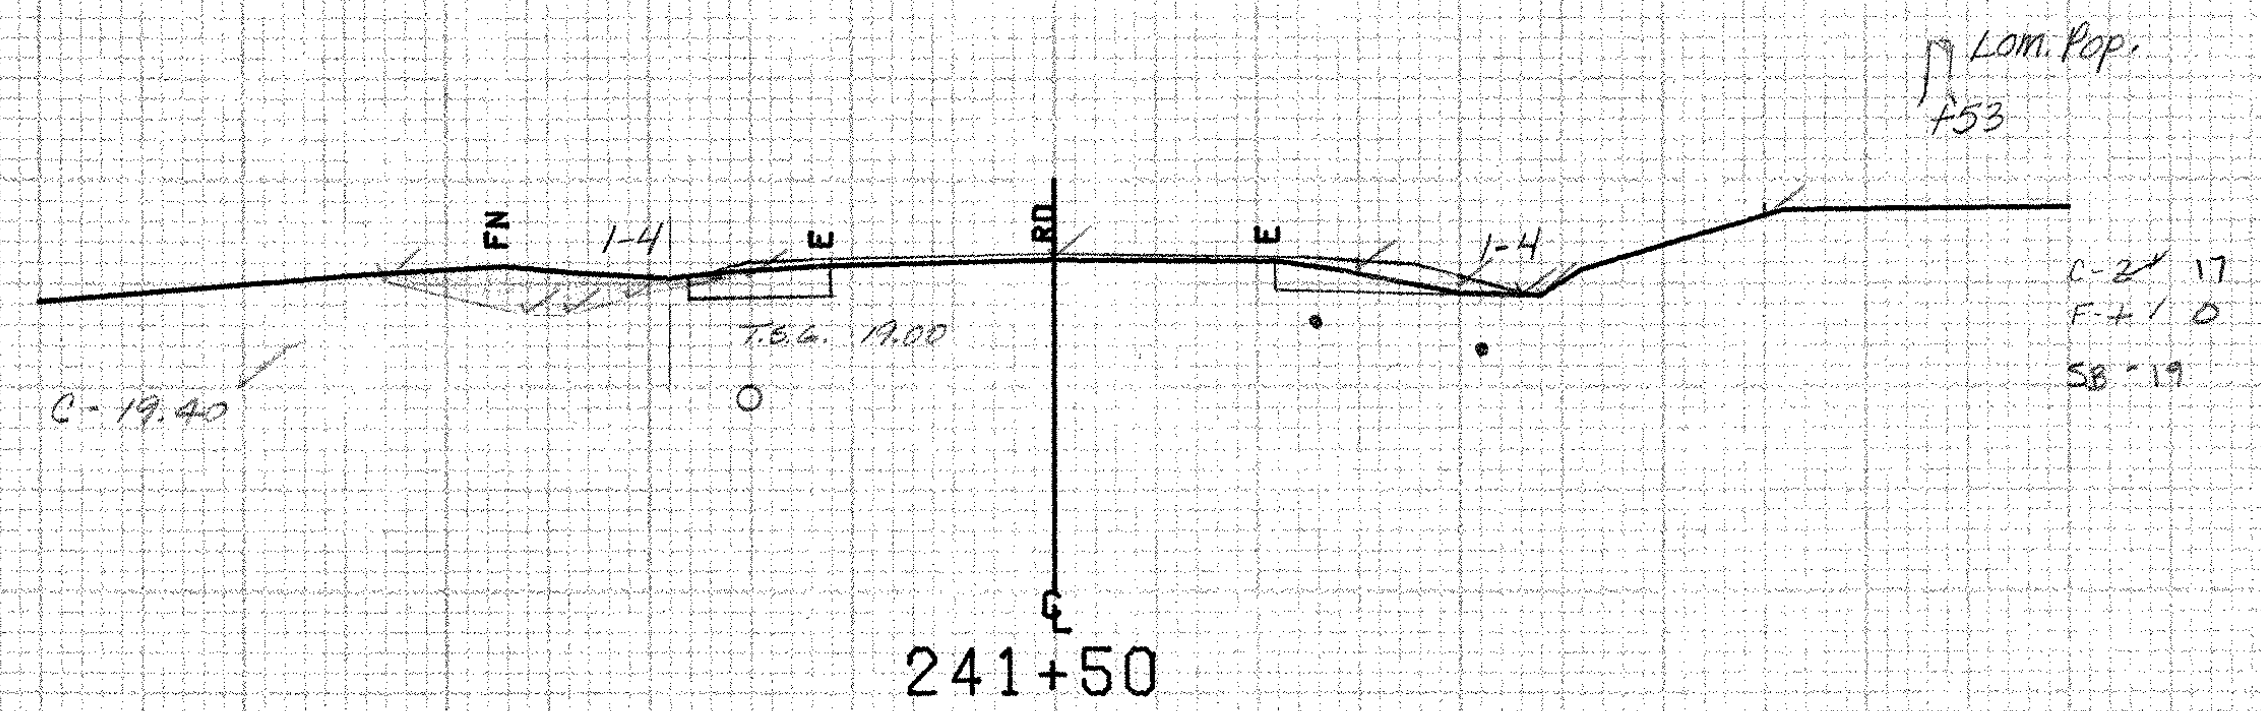

500

EARTH	
19.0	506.4
19.0	505.9
22.0	505.4
24.0	504.8
27.0	505.4
34.0	505.0
26.0	506.1
21.0	506.4
19.0	506.4

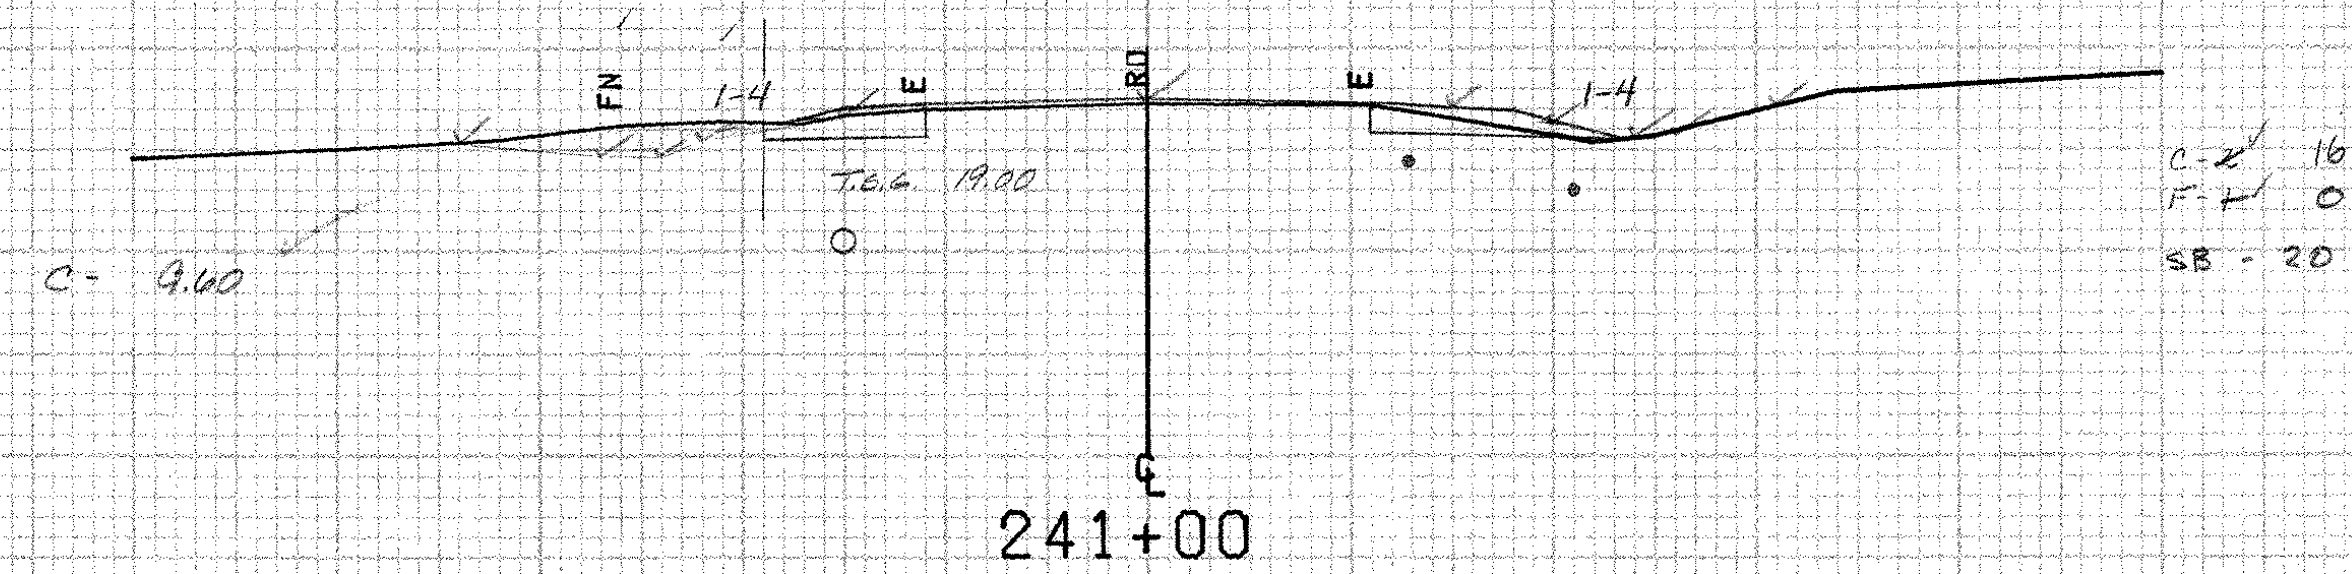


500


241+00 Rt.
Begin Steel Beam Guard Rail

240+75 ~ 241+00 Rt.
Breakaway Cable Terminal

EARTH	
20.0	507.0
23.0	506.5
24.0	506.3
29.0	507.2
20.0	507.0

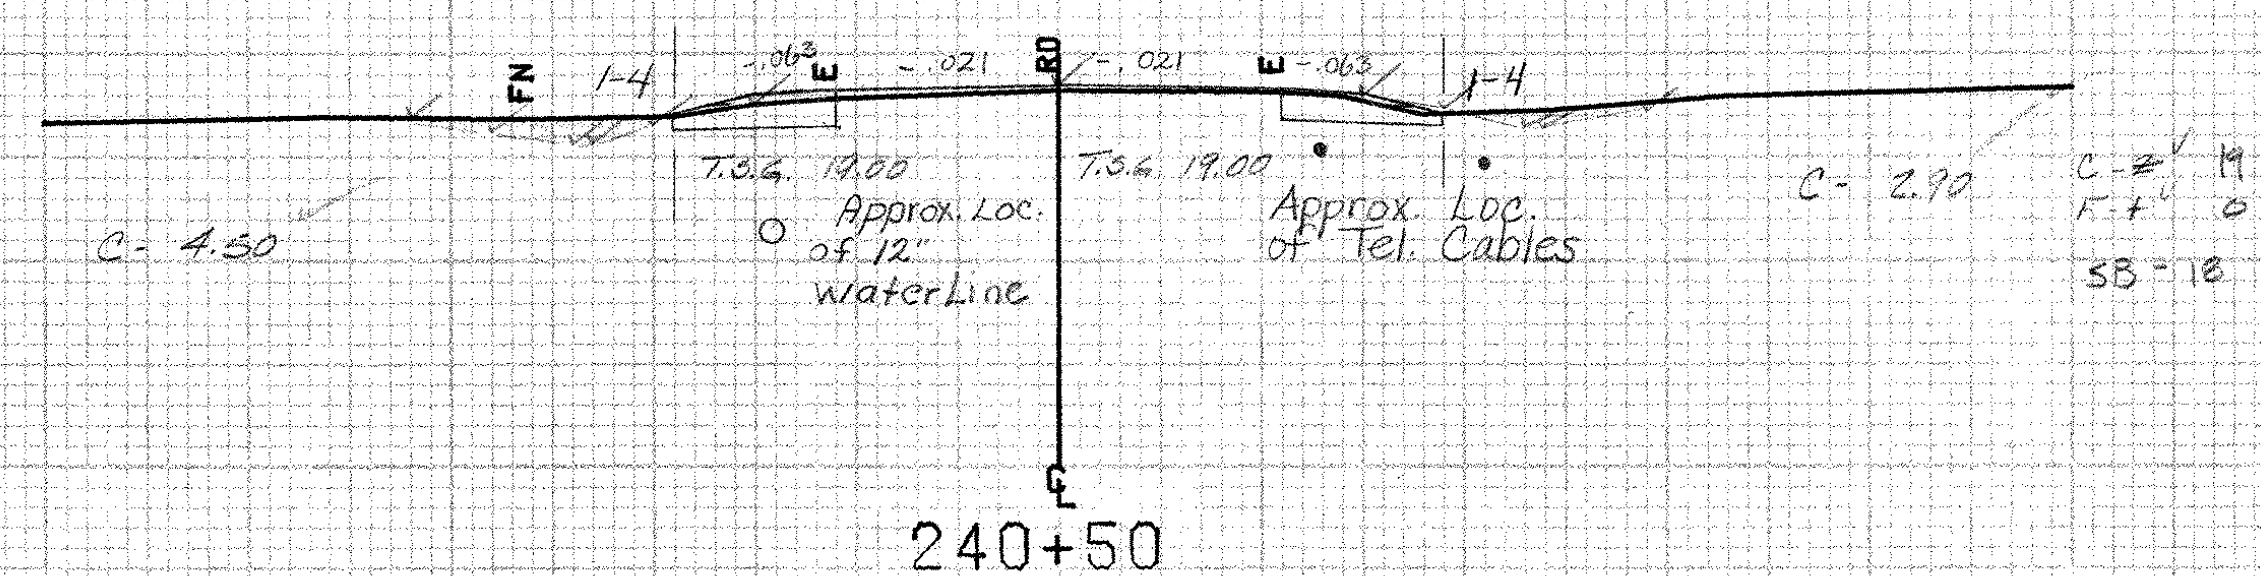


500

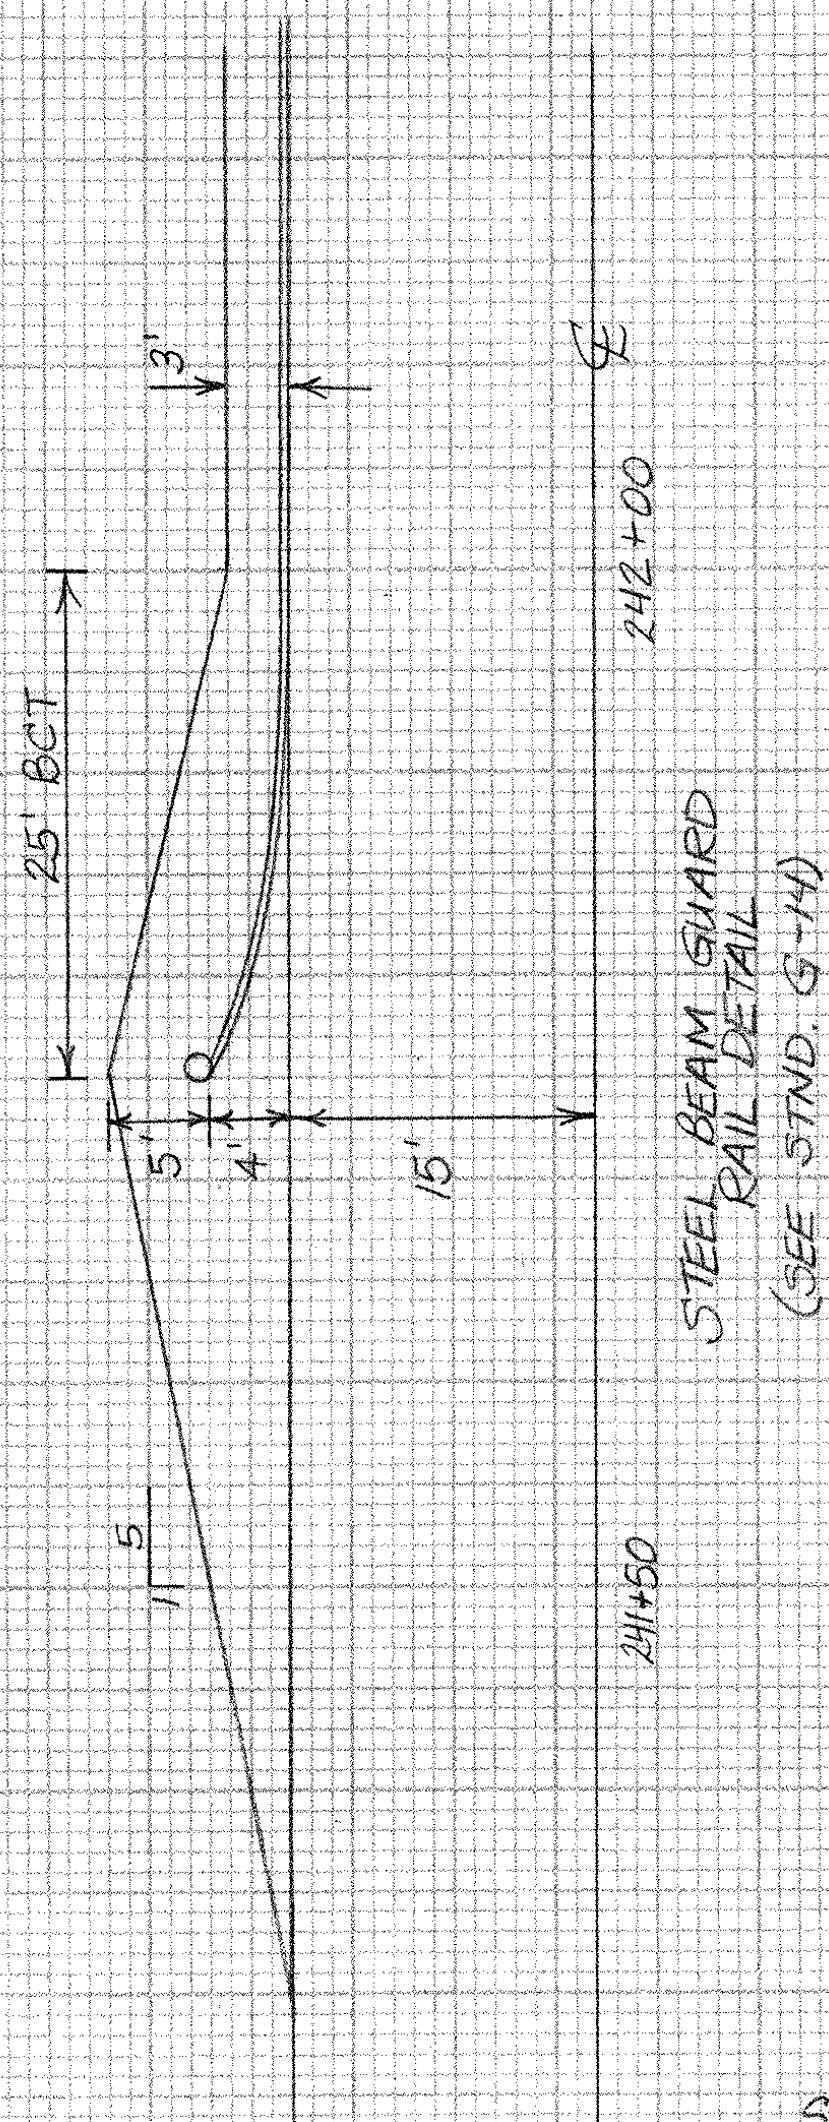

STEEL BEAM GUARD RAIL DETAIL
(SEE STND. G-14)

Scale:
10'

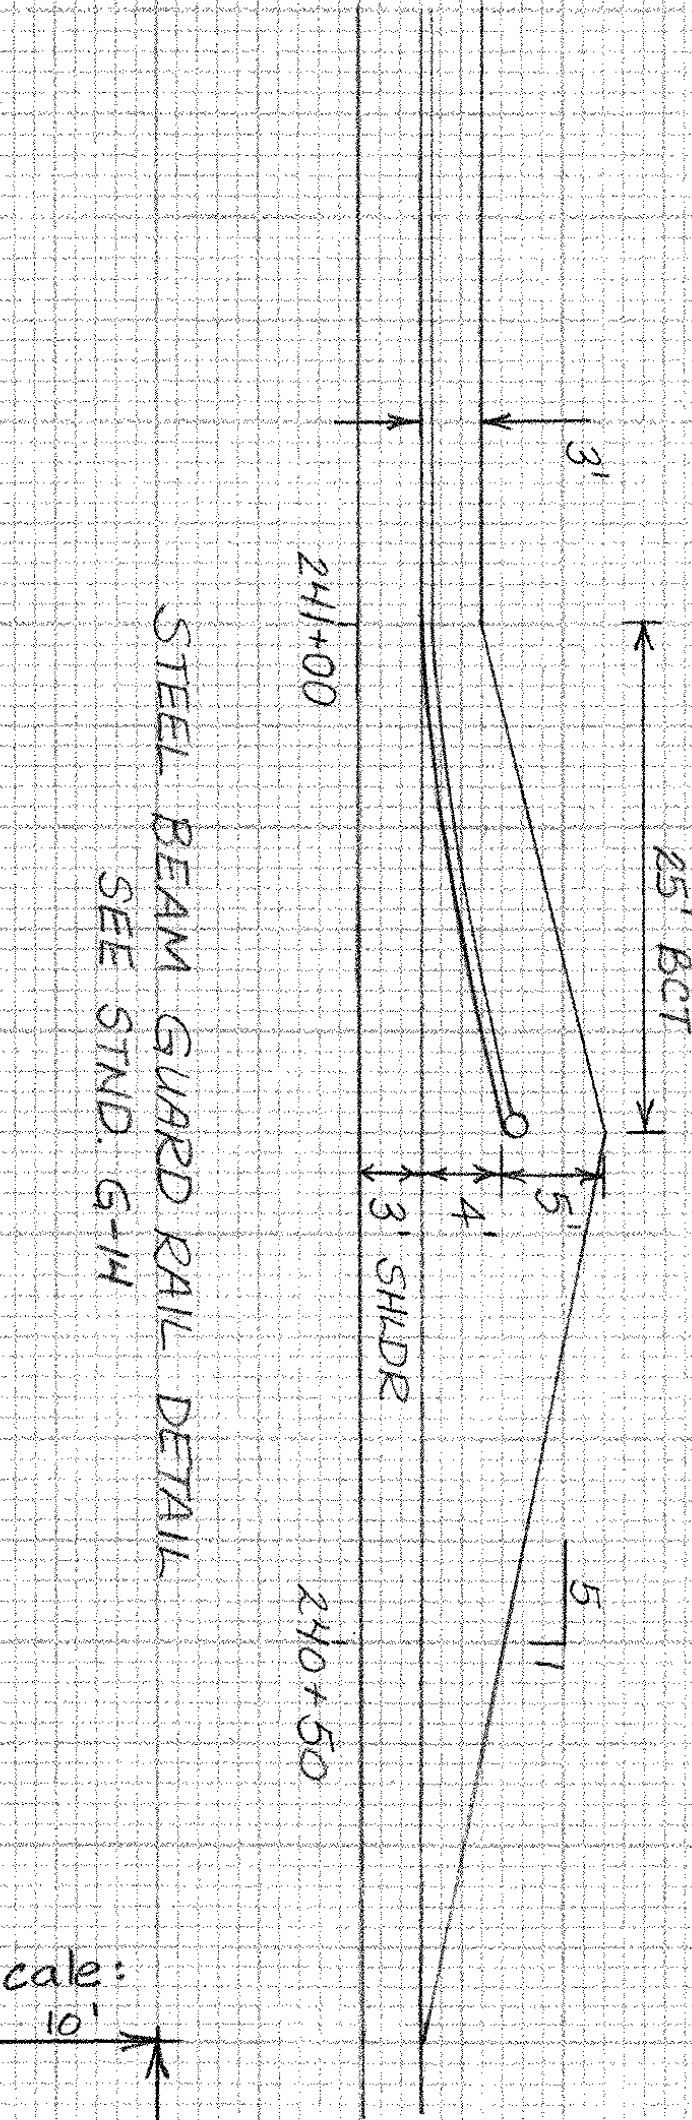

STEEL BEAM GUARD RAIL DETAIL
SEE STND. G-14

Scale:
10'

BRIDPORT MM 4.55 ~ MM 4.73

FROM STA.	240+50	TO STA.	242+00
PROJECT NAME	SHOREHAM-BRIDPORT-ADDISON		
NO.	F017-1(2)	PLOTTED	02/10/84
SURVEYED BY	FANTONI	JAN	1984
SHEET	353 OF 420 SHEETS	SHEET	353 OF 477

SCALE 10 FEET