
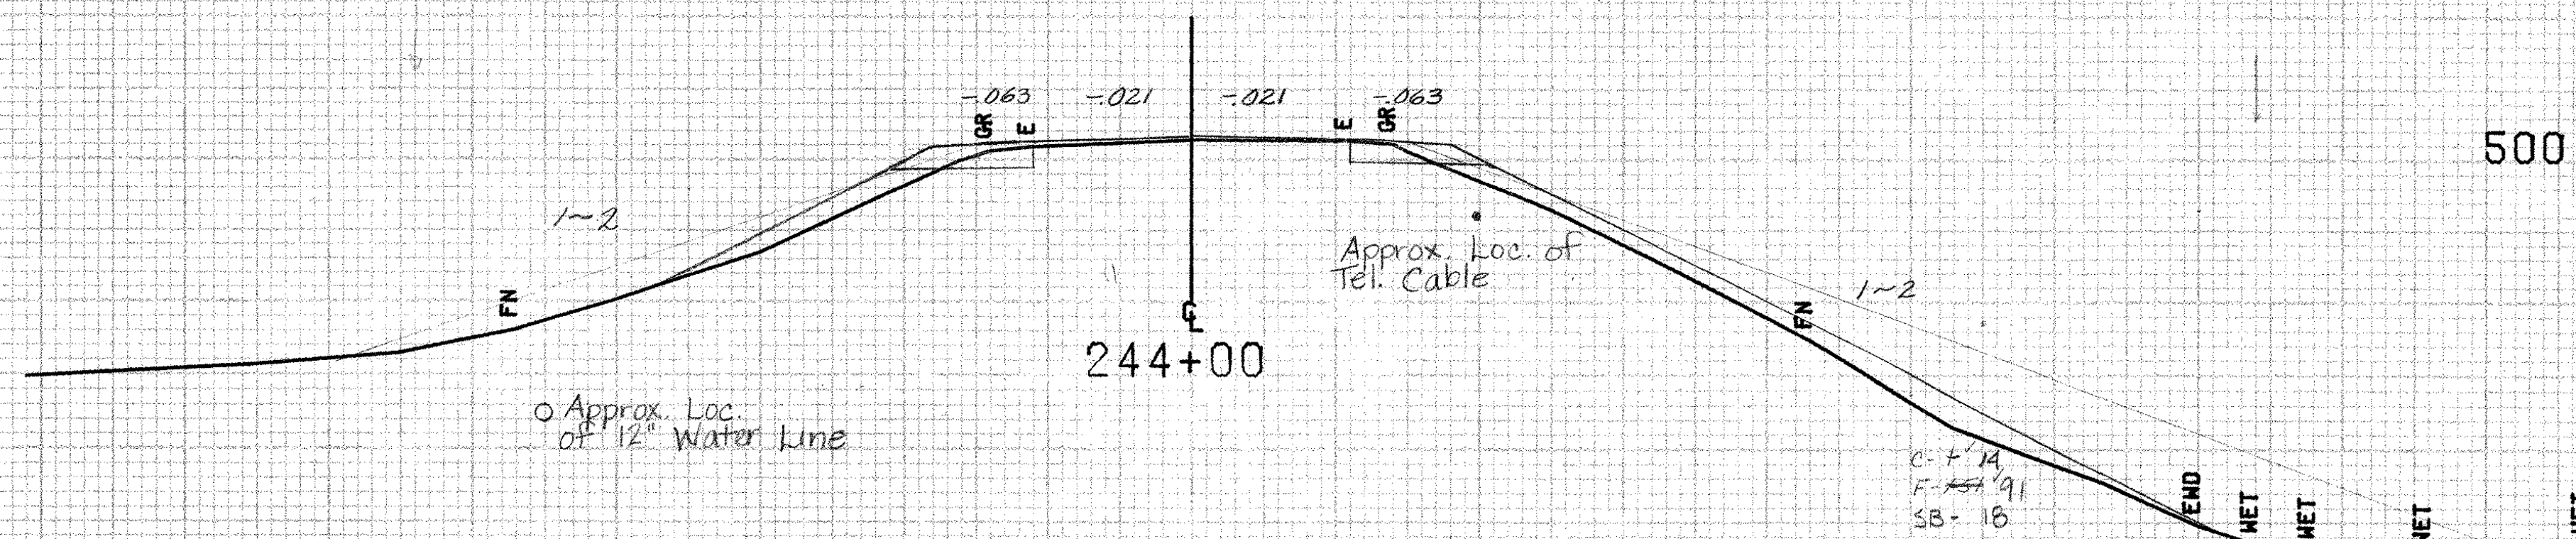
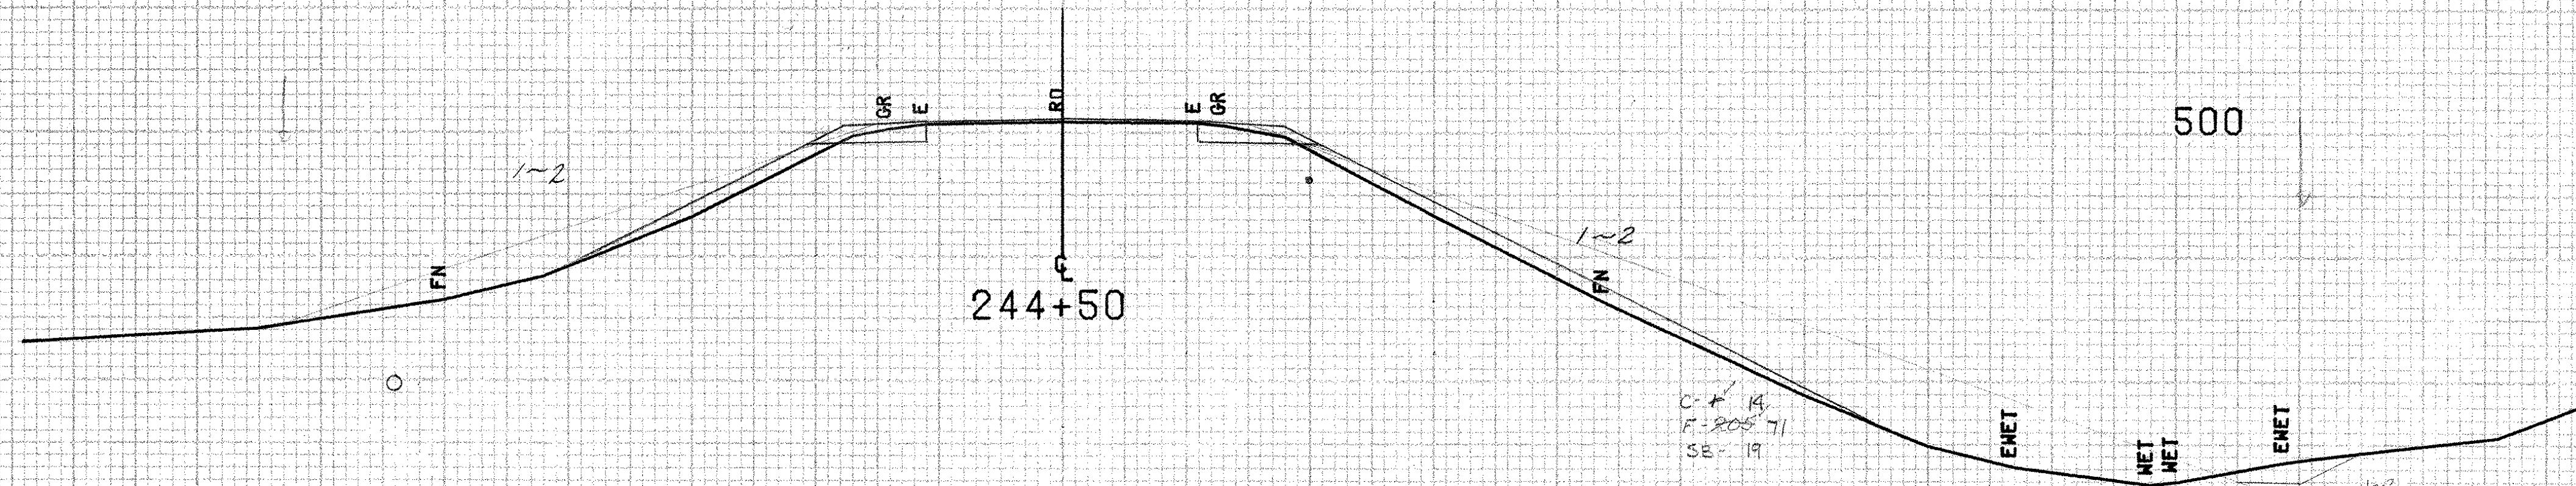


SEE STD. B-5 FOR
CONSTRUCTION TECHNIQUE

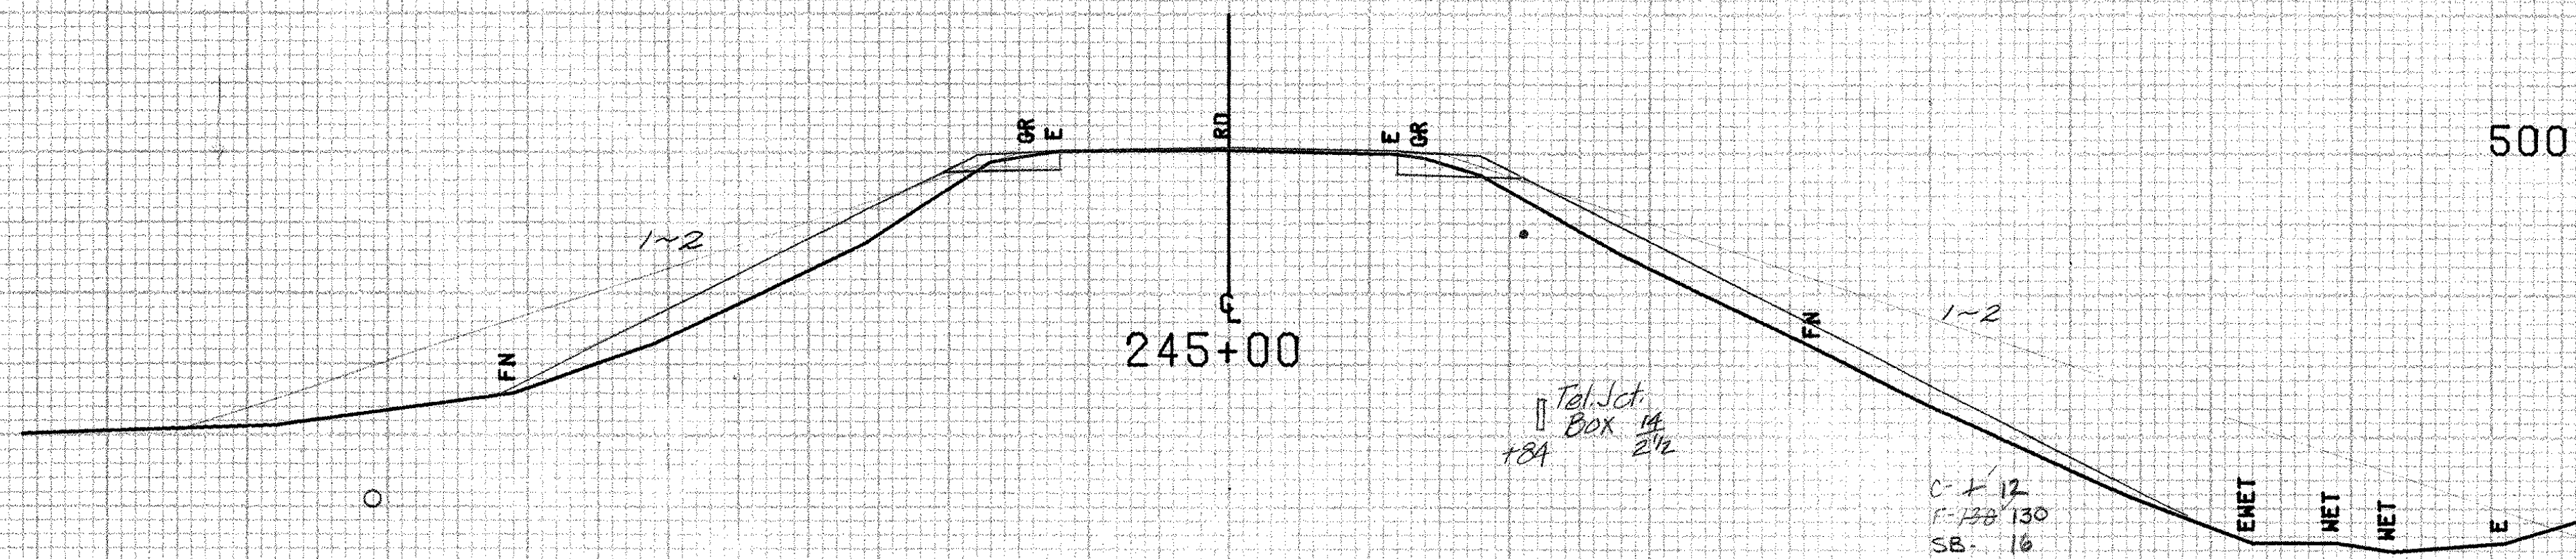

BRIDPORT MM 4.55 ~ MM 4.73

FROM STA.	244+00	TO STA.	245+50
PROJECT NAME	SHOREHAM-BRIDPORT-ADDISON		
NO.	F017-1(2)	PLOTTED	02/10/84
SURVEYED BY	FANTONI	JAN	1984
SHEET	355 OF 420 SHEETS	SHEET	355 OF 477

SCALE 10 FEET