


NO.	DATE
AREA CHECKED	
AREA	
SCALE BOOK	
DATE	
BY	
DATE	


NO.	DATE
AREA CHECKED	
AREA	
SCALE BOOK	
DATE	
BY	
DATE	




270+00  
Drive Lt.

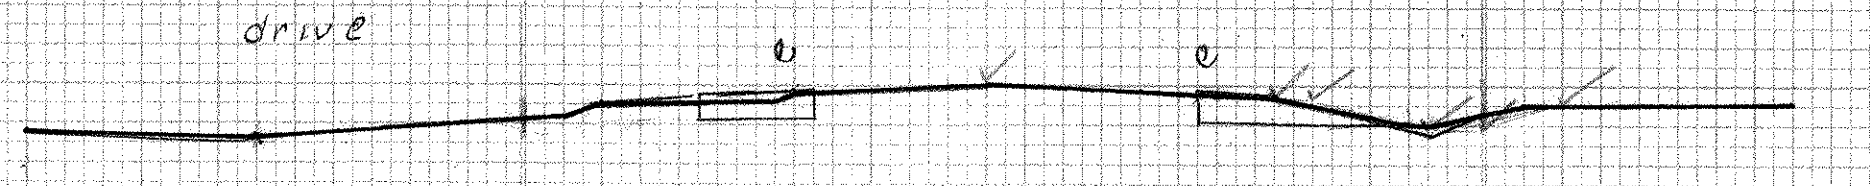


269+50

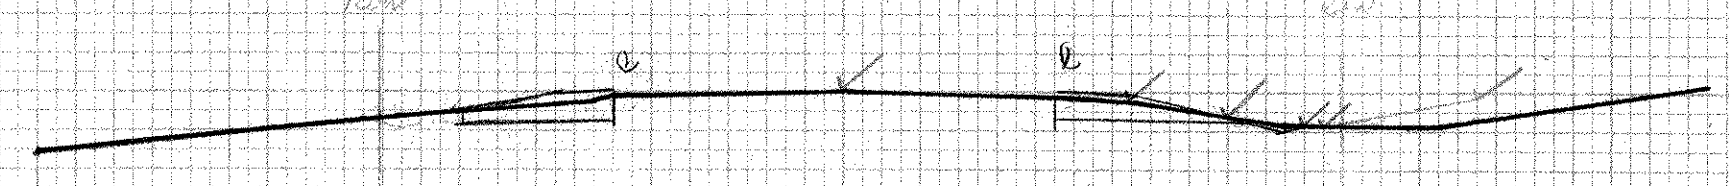


269+00

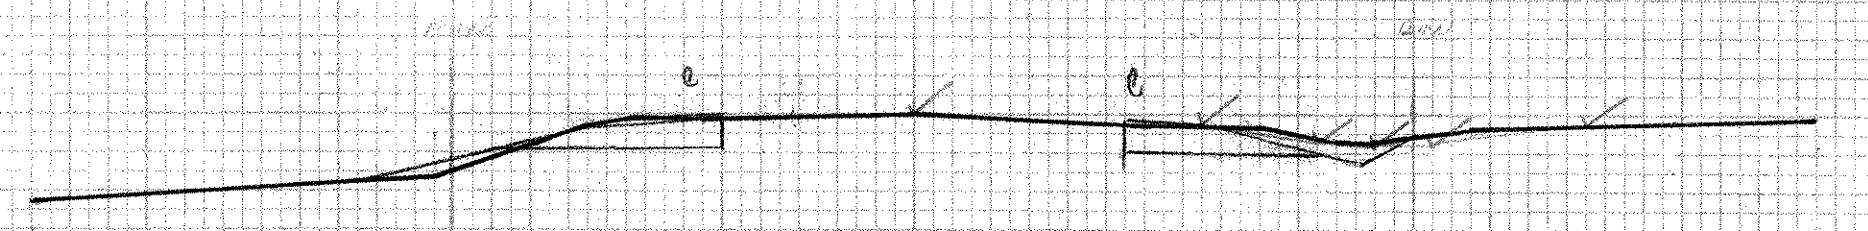

268+50

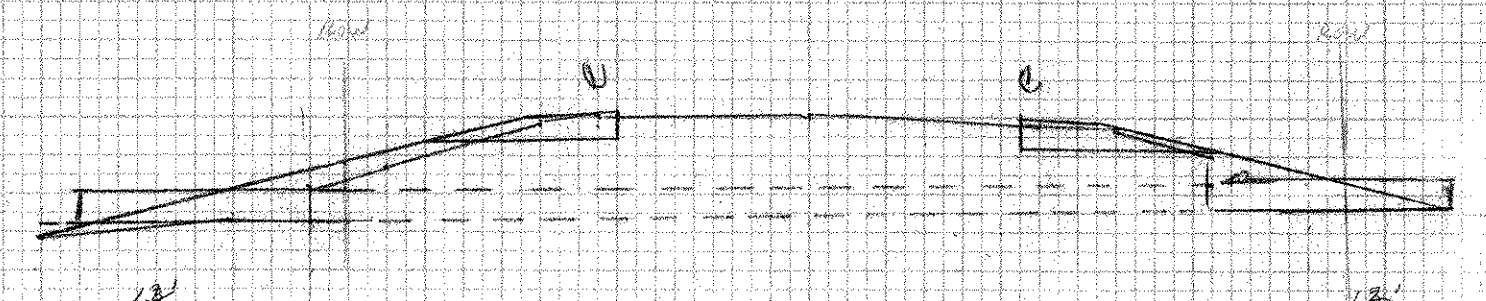


267+82 @ 90°  
PIPE  
18" RCP w/ SHQ Inlet  
Extend 13' Inlet 13' Outlet

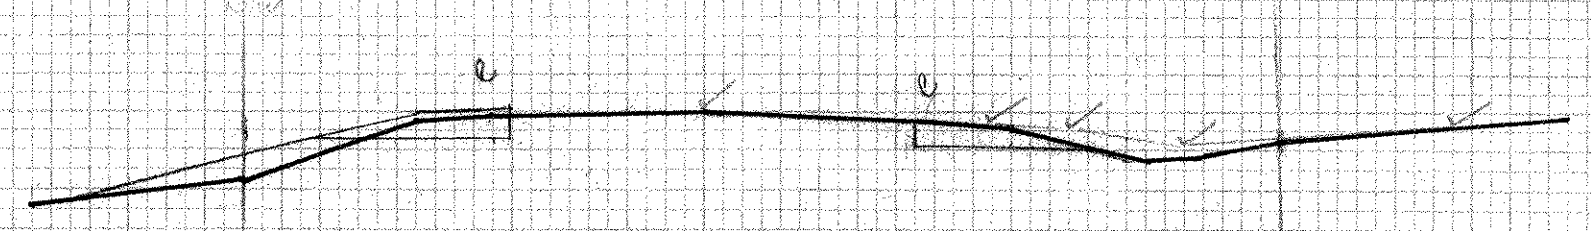

268+00




273+00

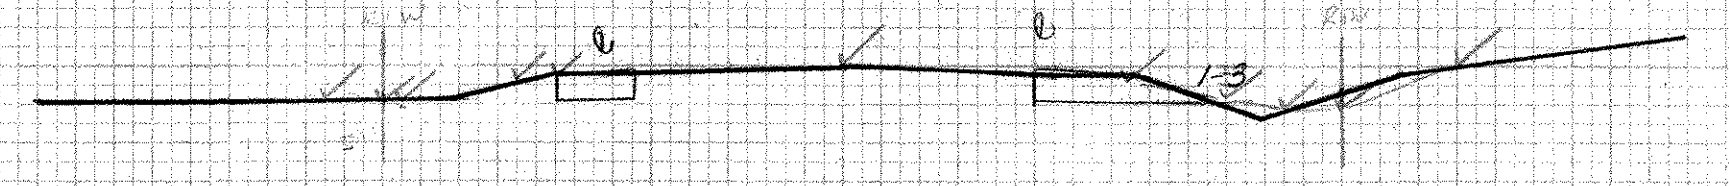


272+50




272+00

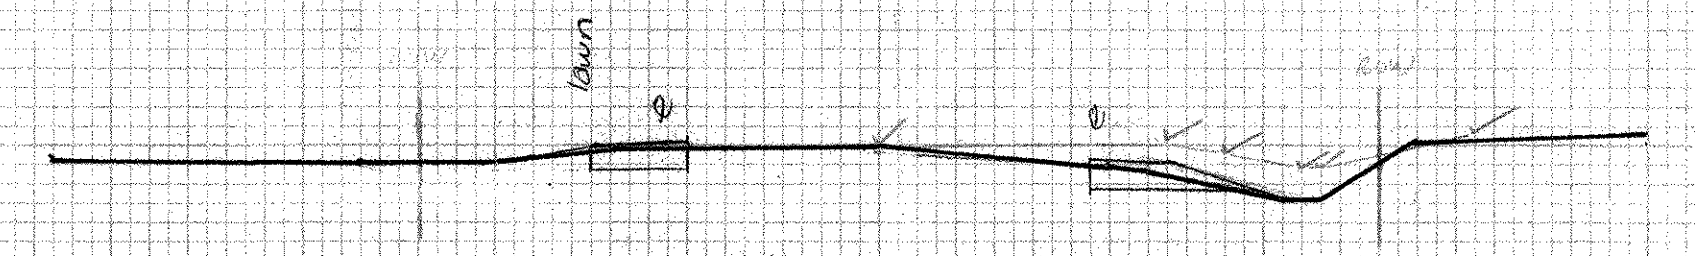

271+50

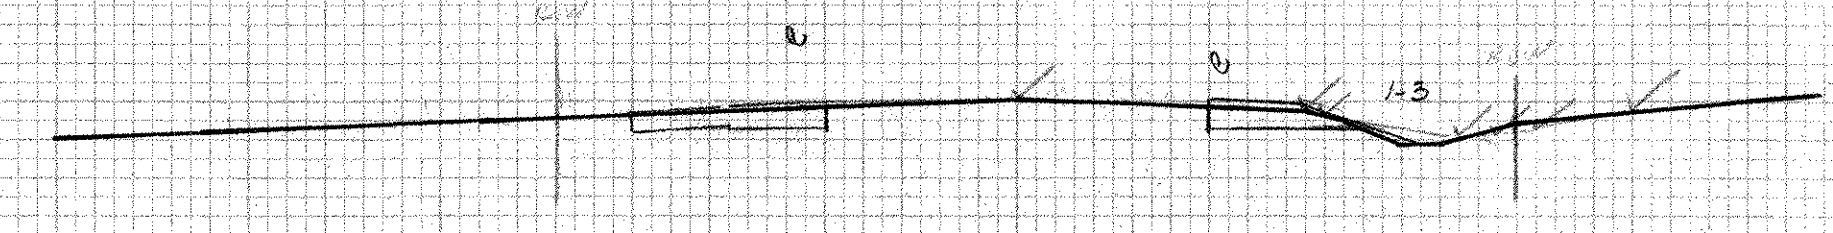

271+00  
DRIVE Lt.

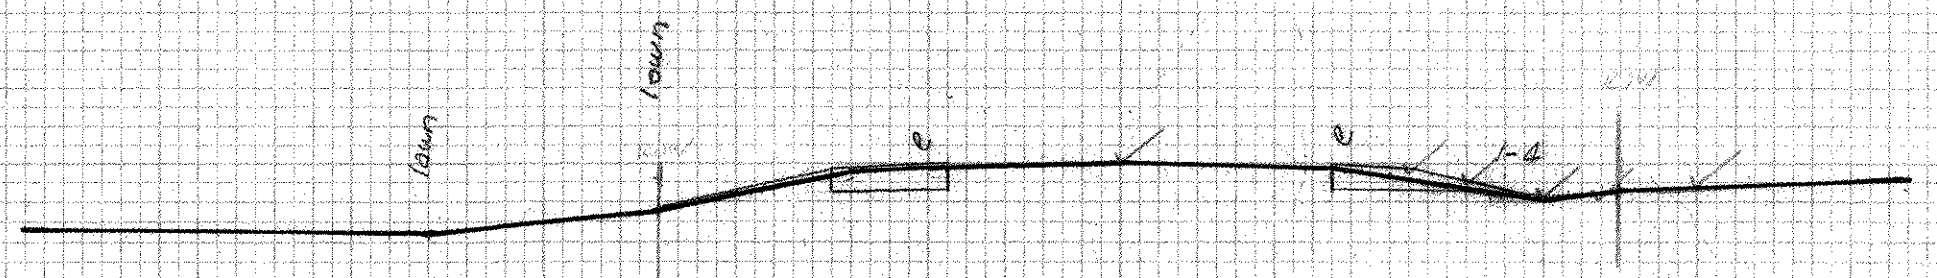

270+50

SHOREHAM BEID POST ADDIS ON  
F 017-1(2)  
ORIGINAL SECTIONS  
268+00 to 273+00