
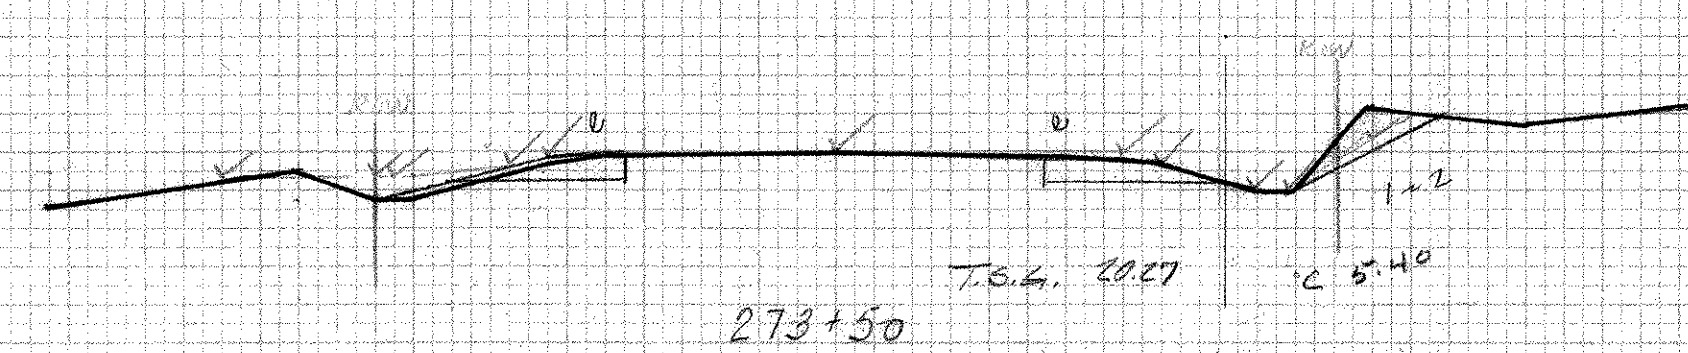
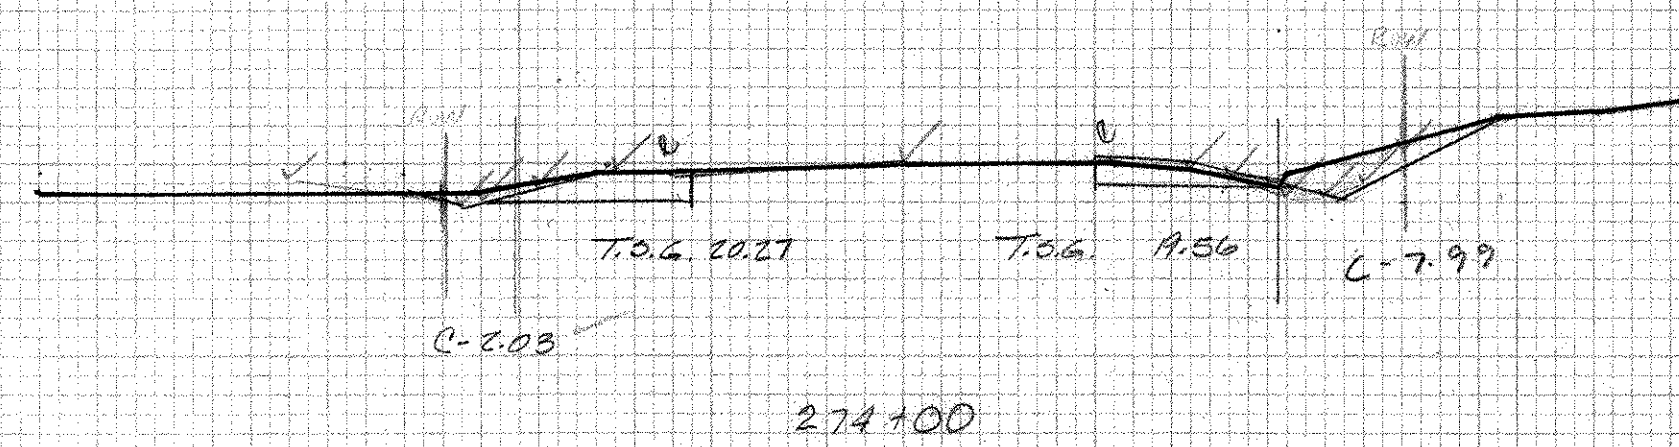
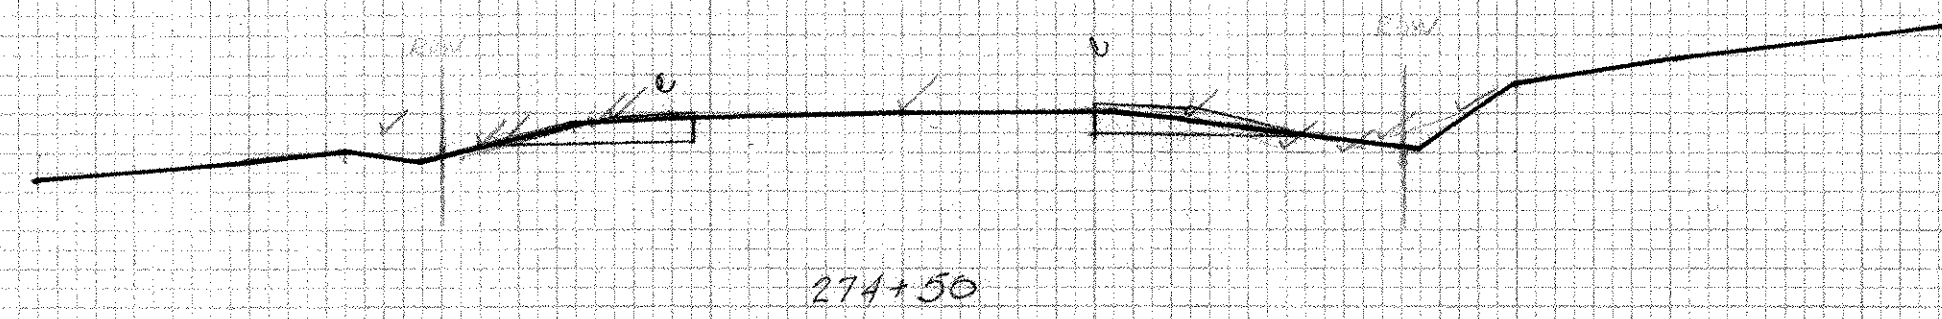
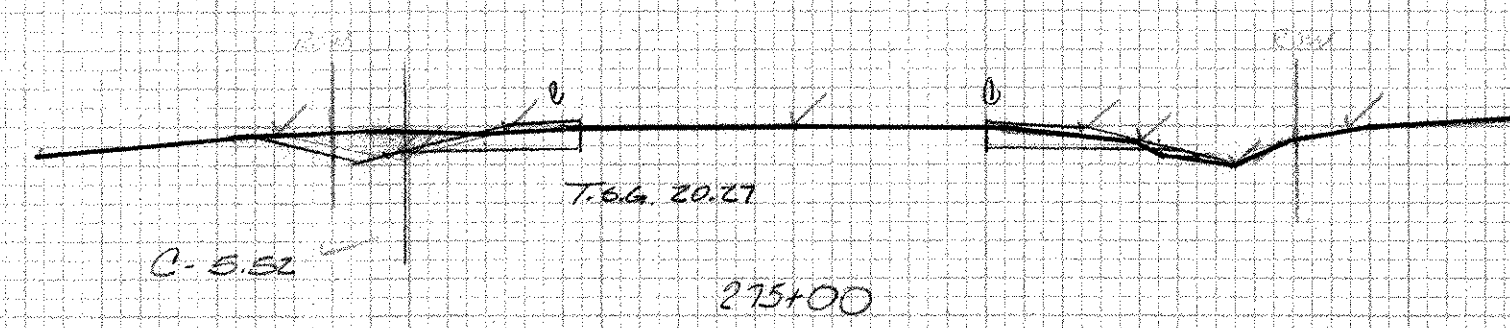
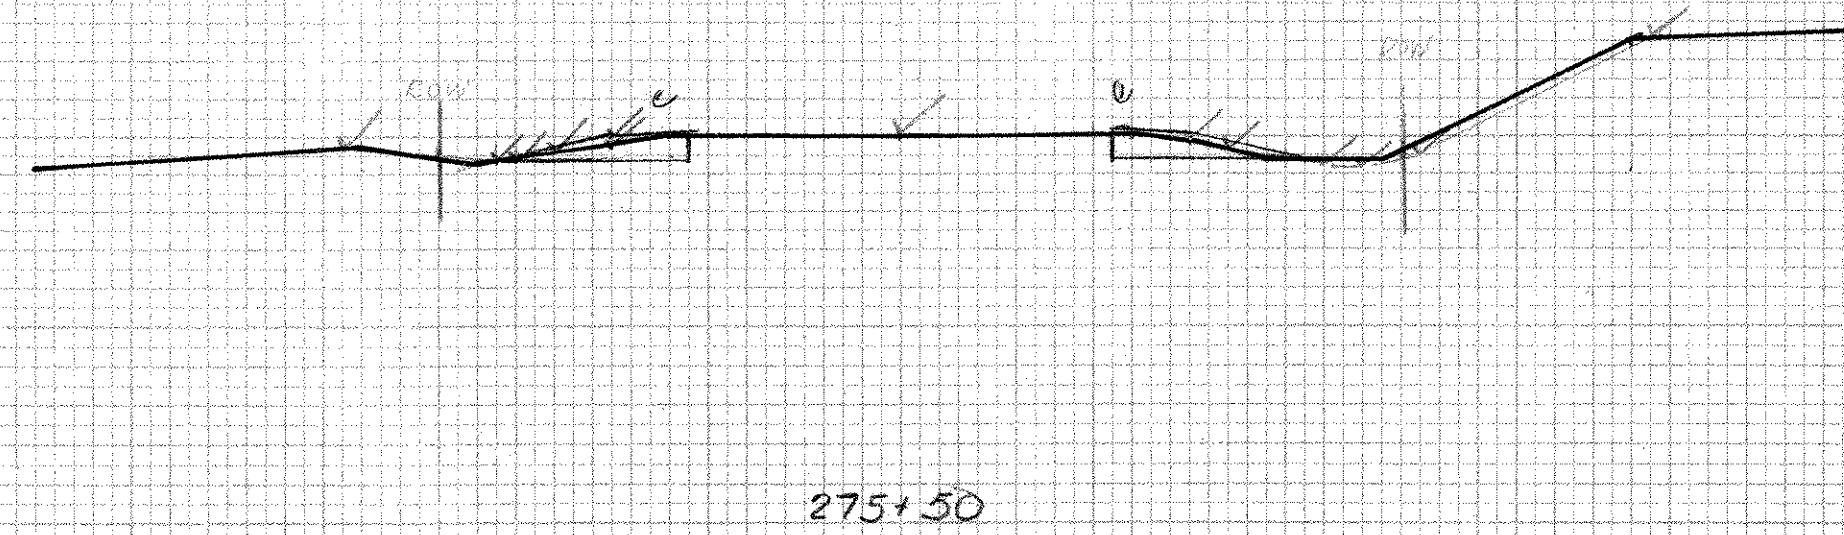


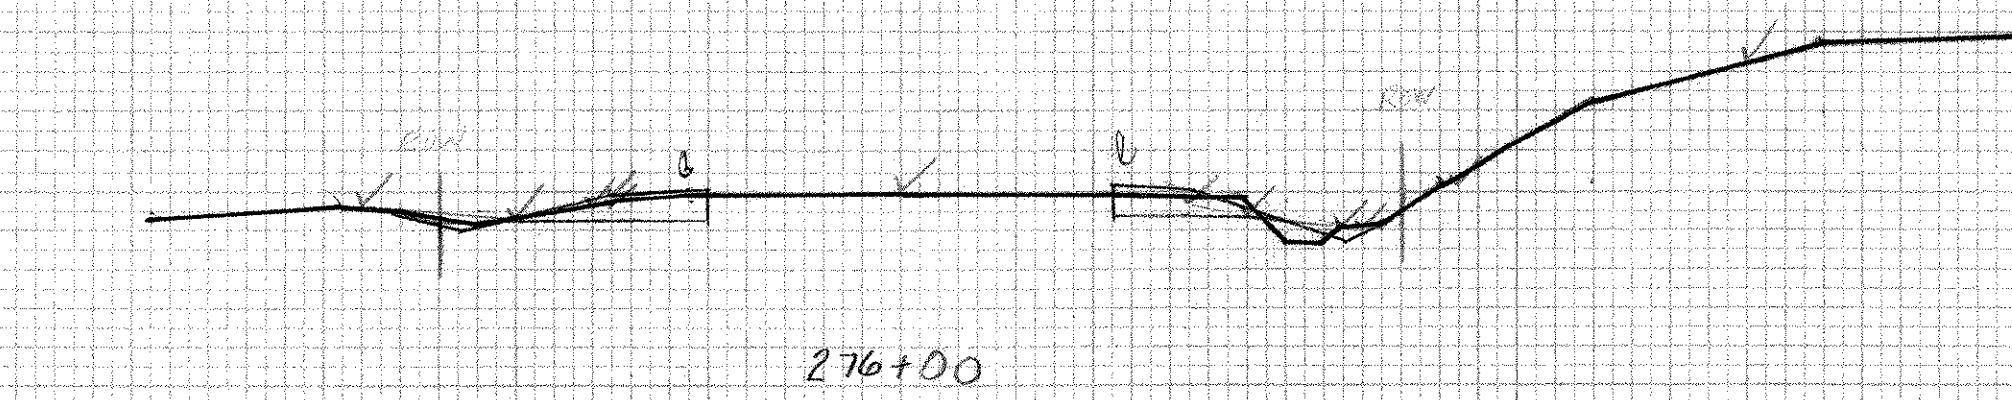

<u>EARTH</u>	
20.27	499.8
20.27	498.5
21.0	498.3
27.0	499.2
21.0	499.3
20.27	499.8
5.52	

EARTH







19.56	499.2
22.0	498.2
24.0	499.0
26.0	500.9
20.0	499.5
19.56	499.2

6 7.99

EARTH

24.0	496.0
26.0	500.6
32.0	502.0
29.0	502.4
24.0	496.0

C 5.40

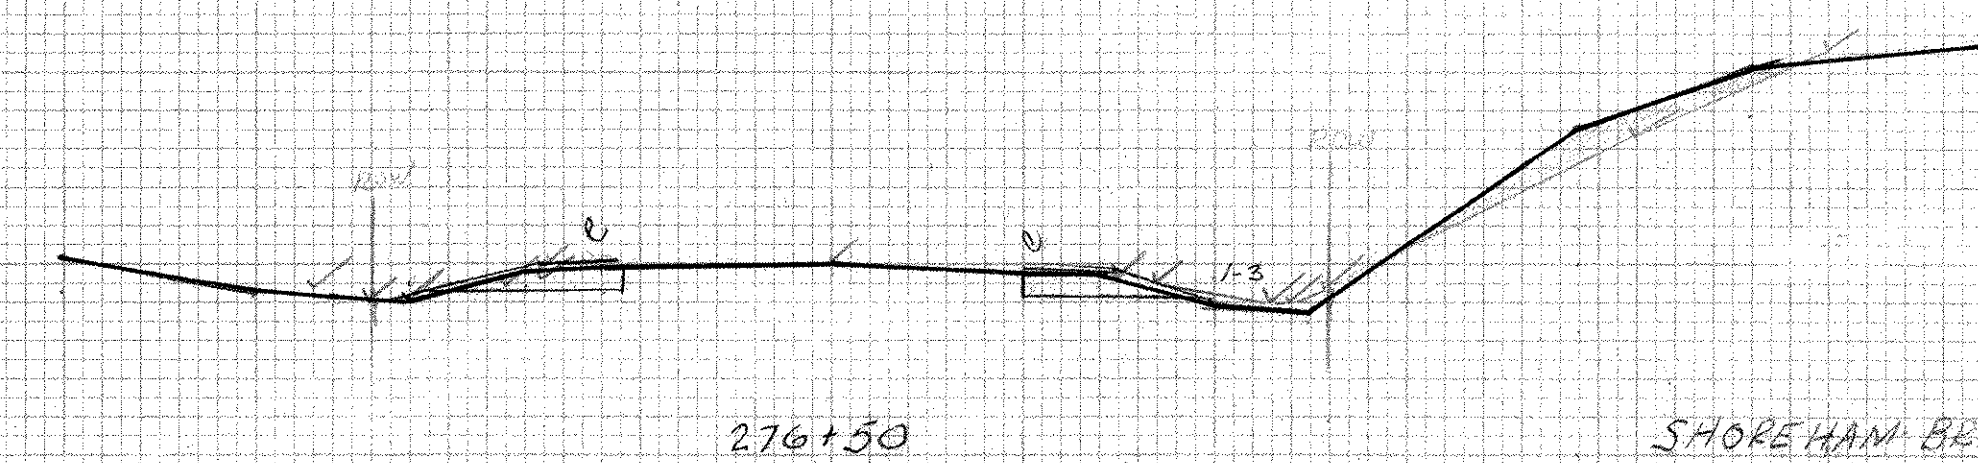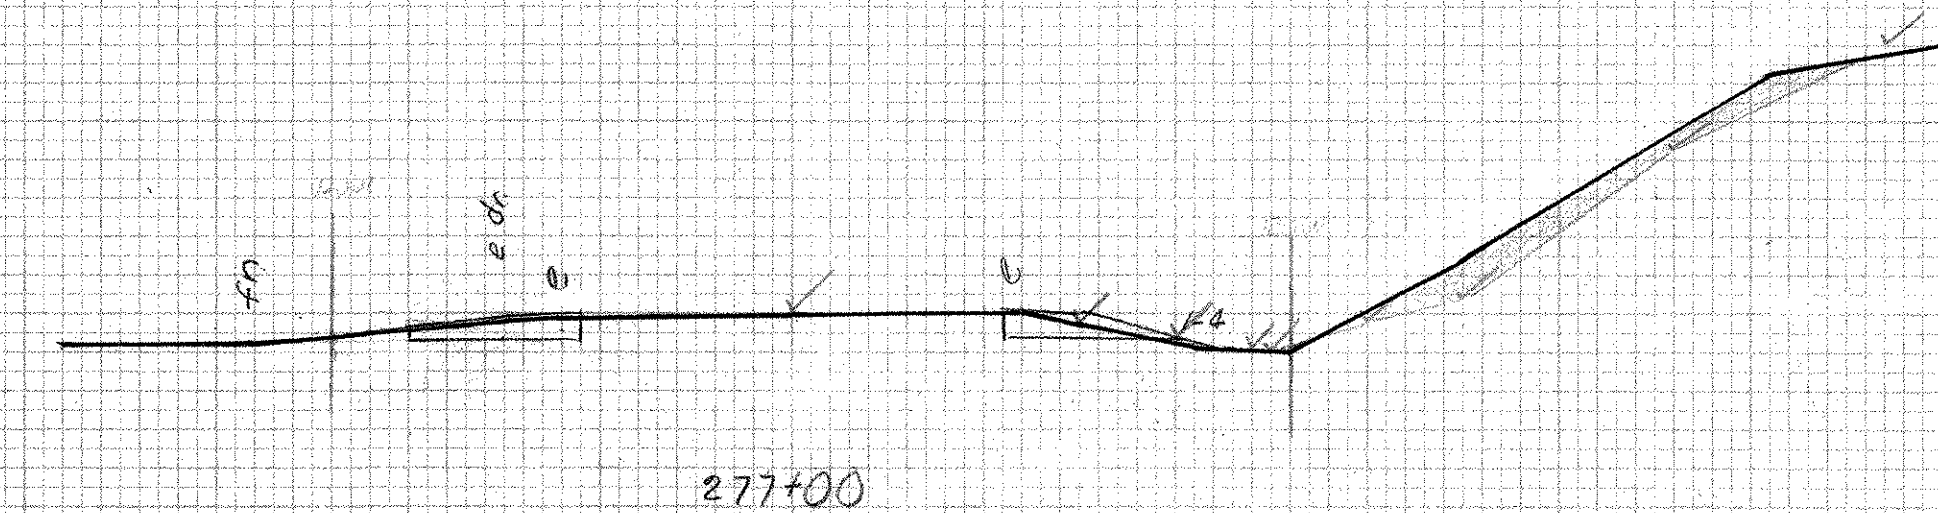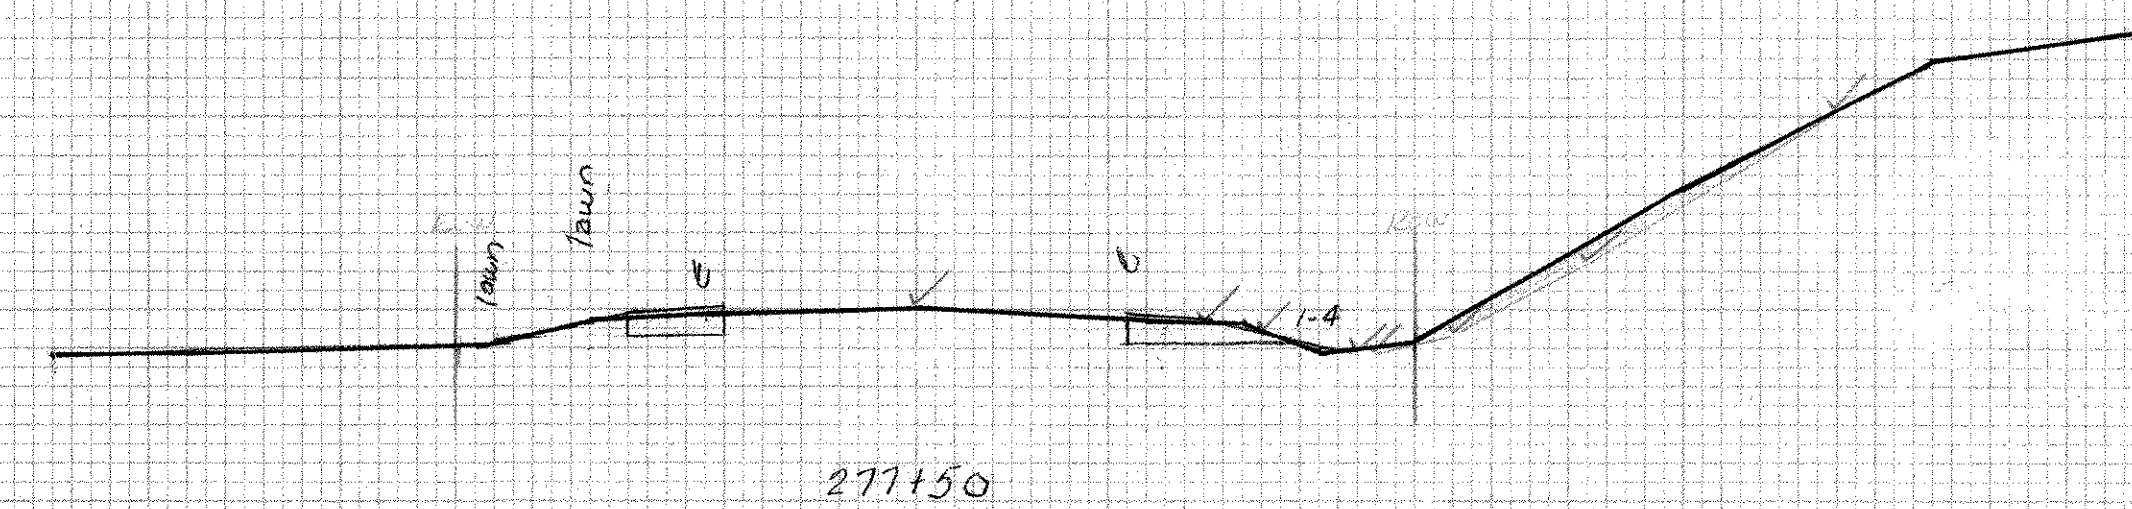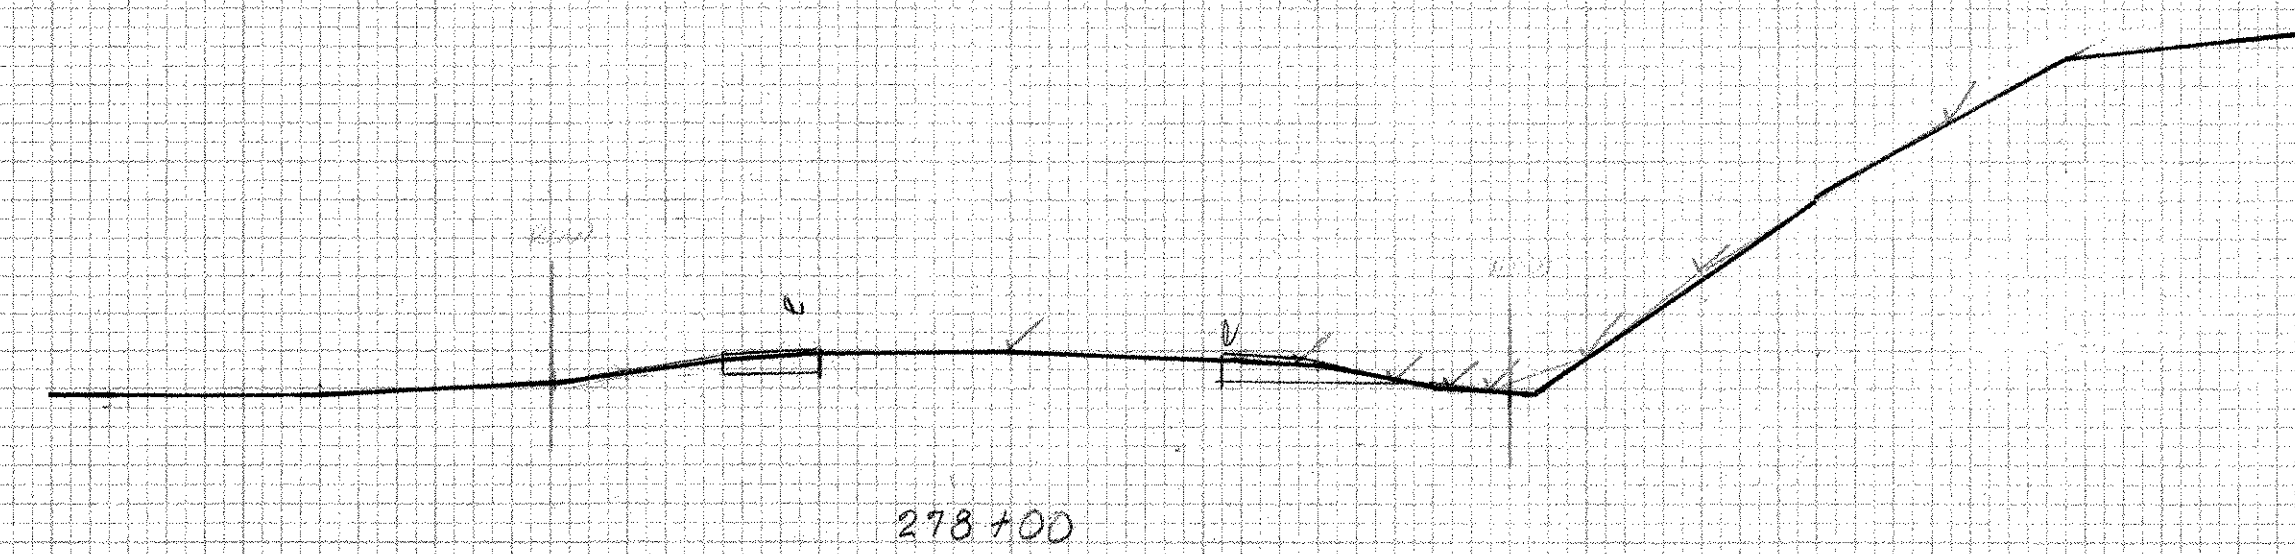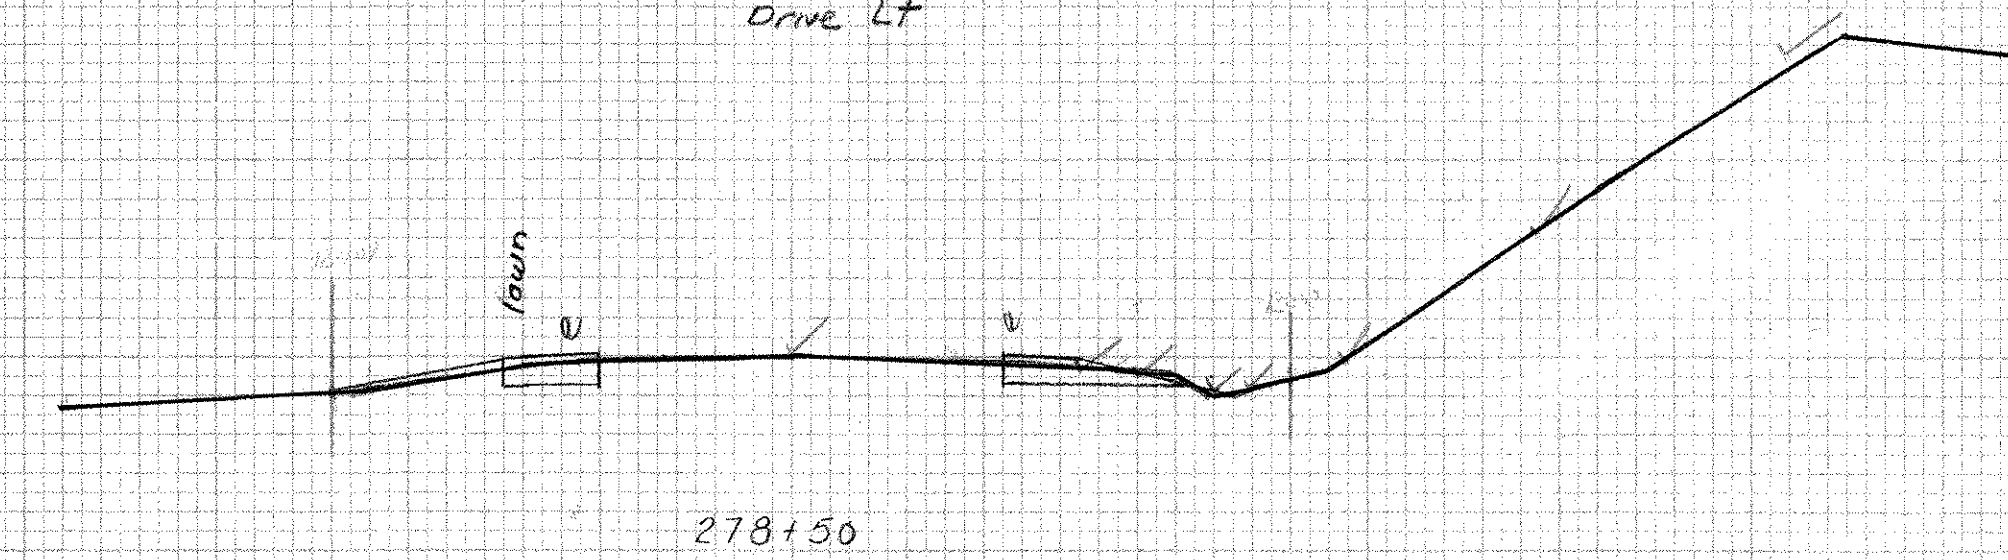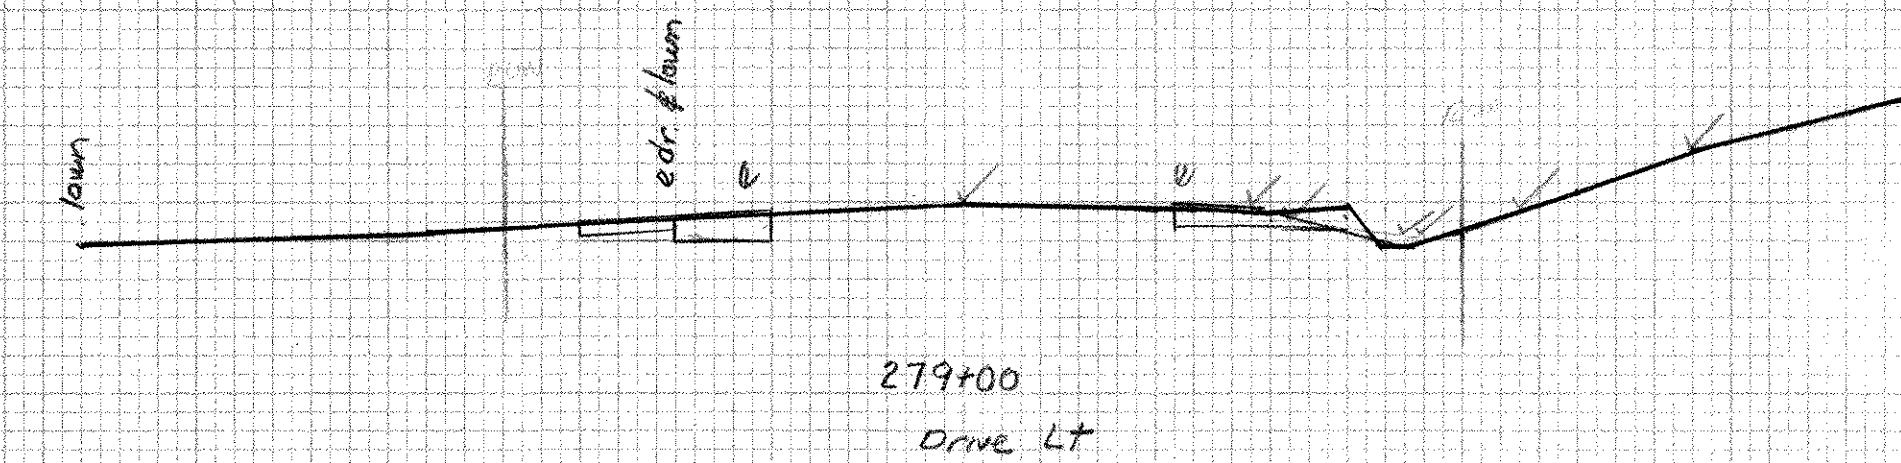

SHOREHAM BRIDPORT - ADDIS ON

017-1(2)

273+50- 279+00