




282+00

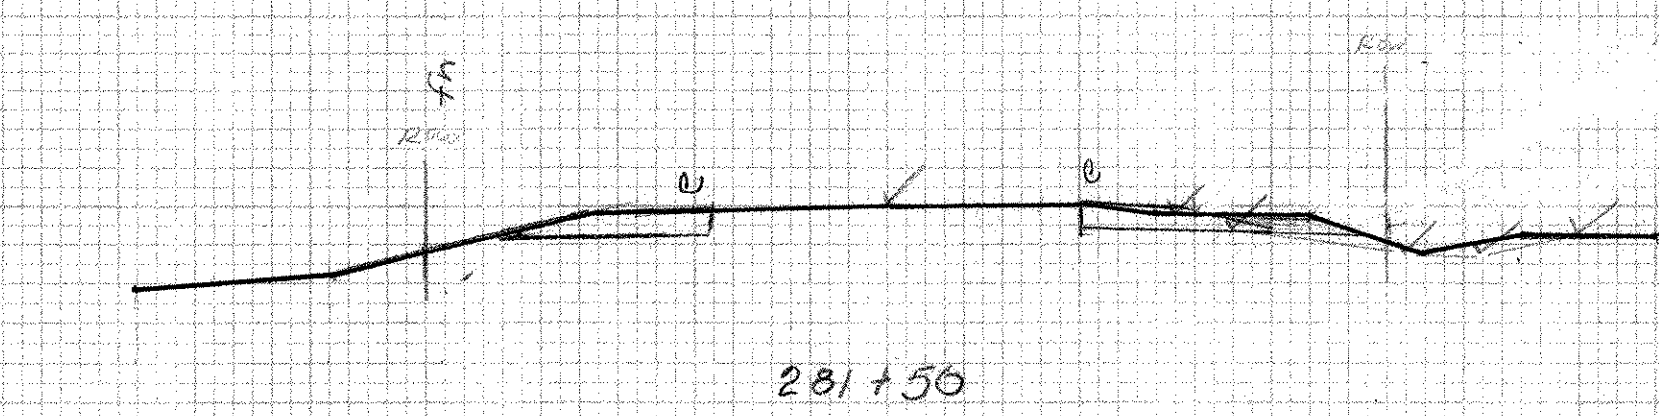


281+50

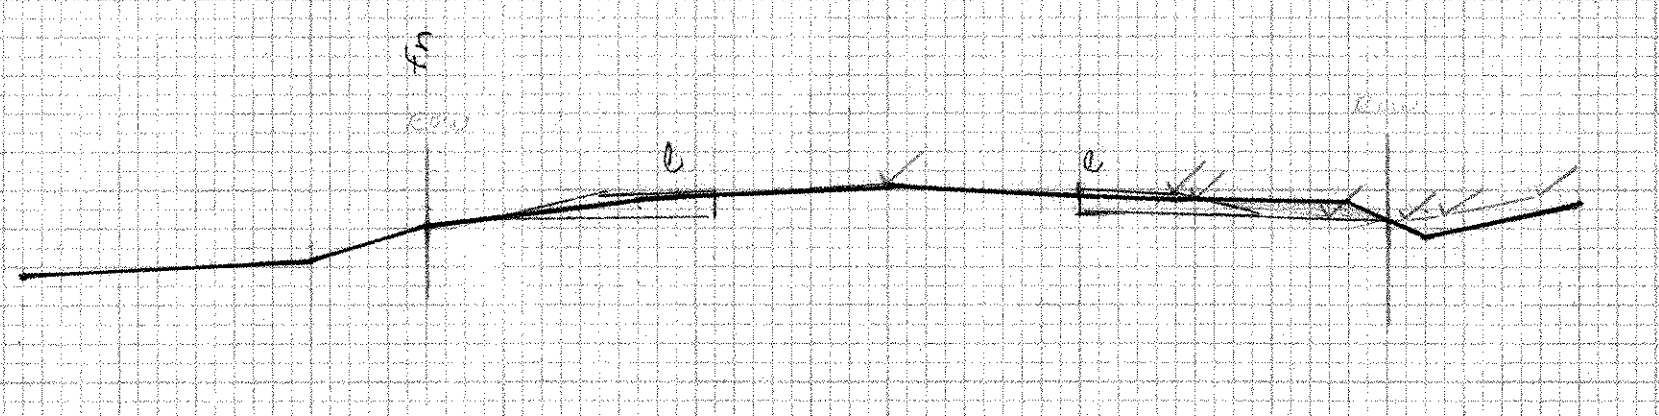


281+00

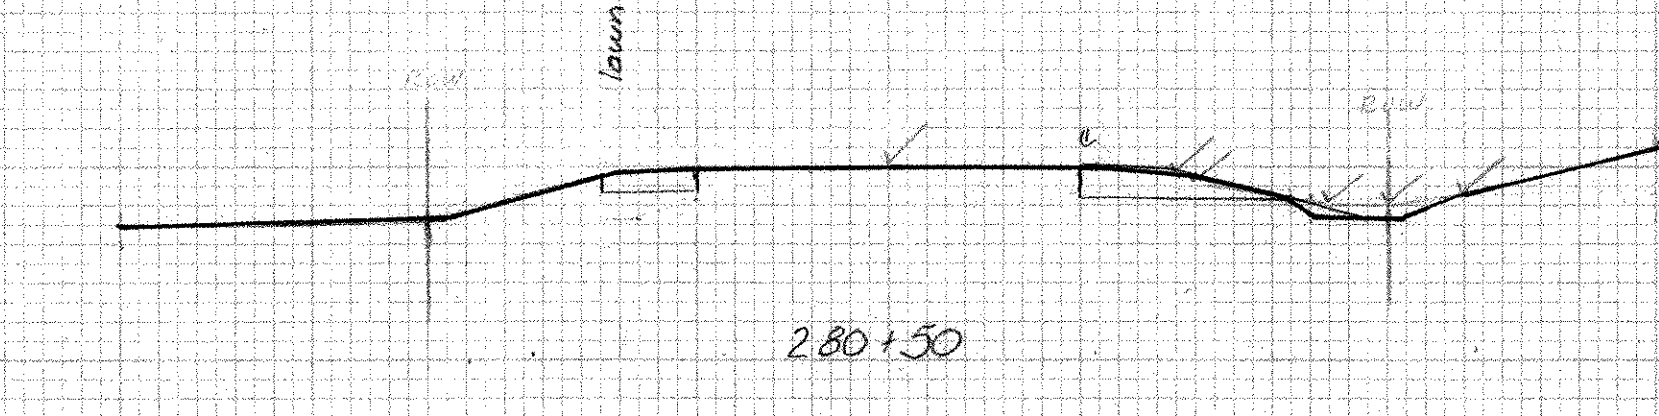


280+50

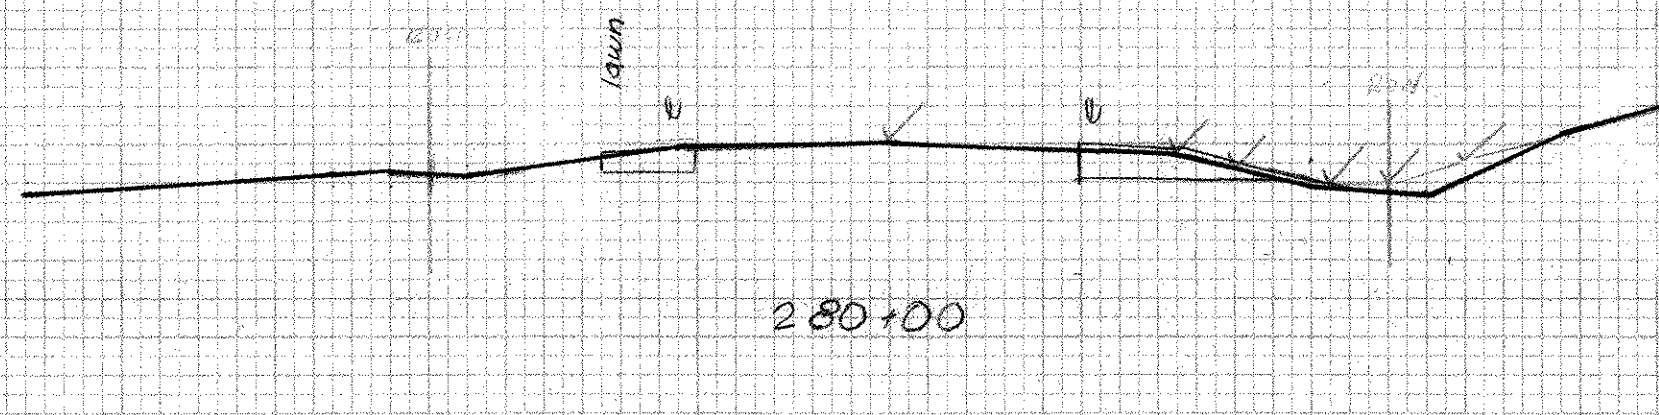


280+00

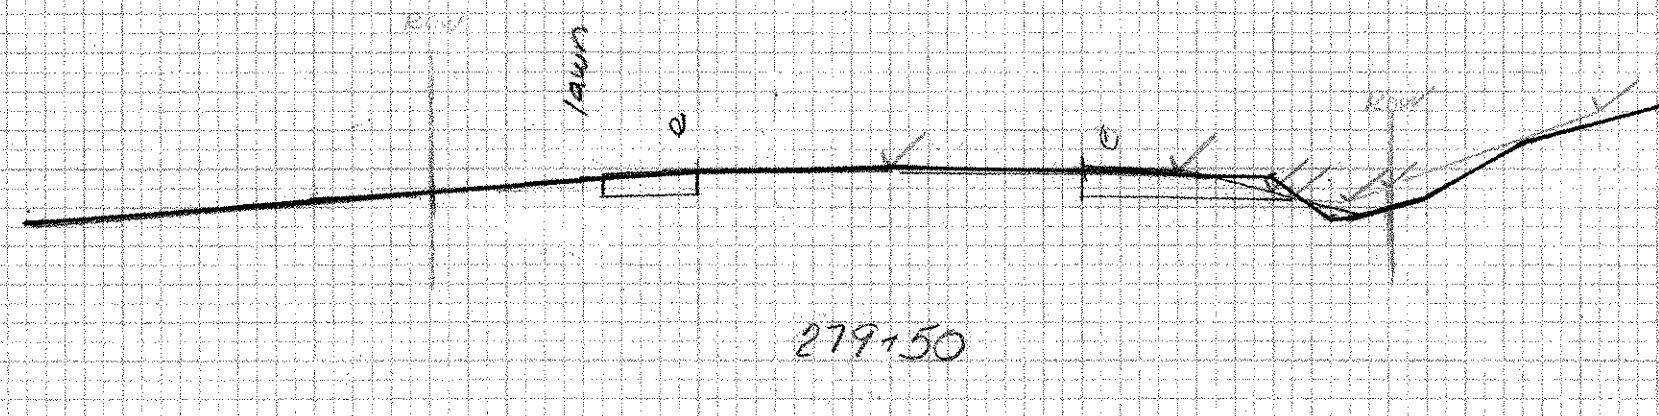


279+50

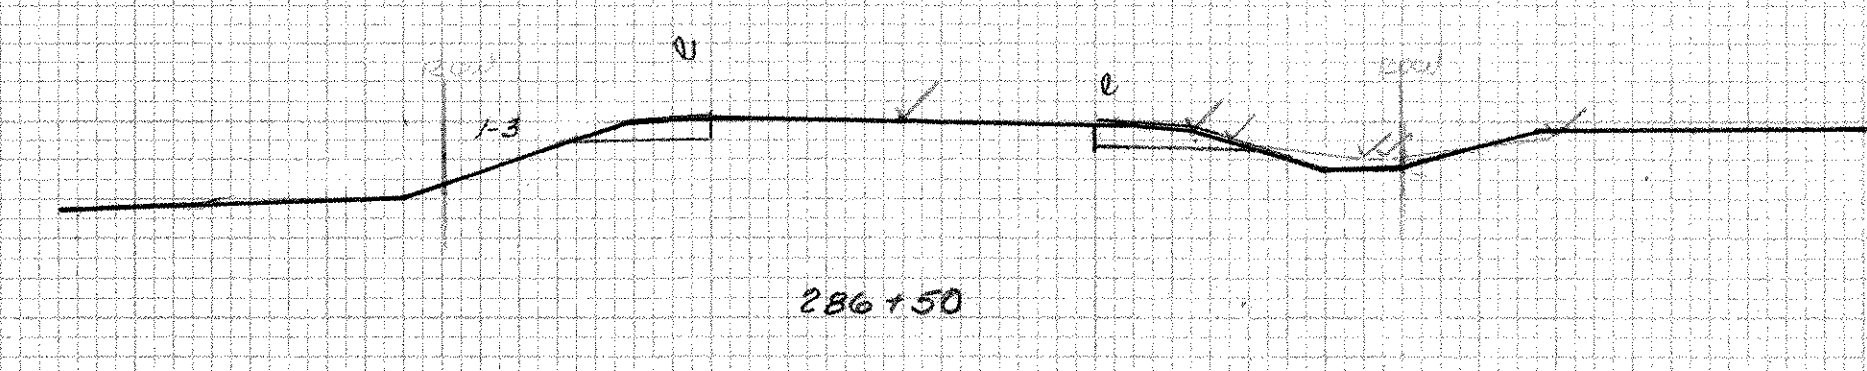


286+50

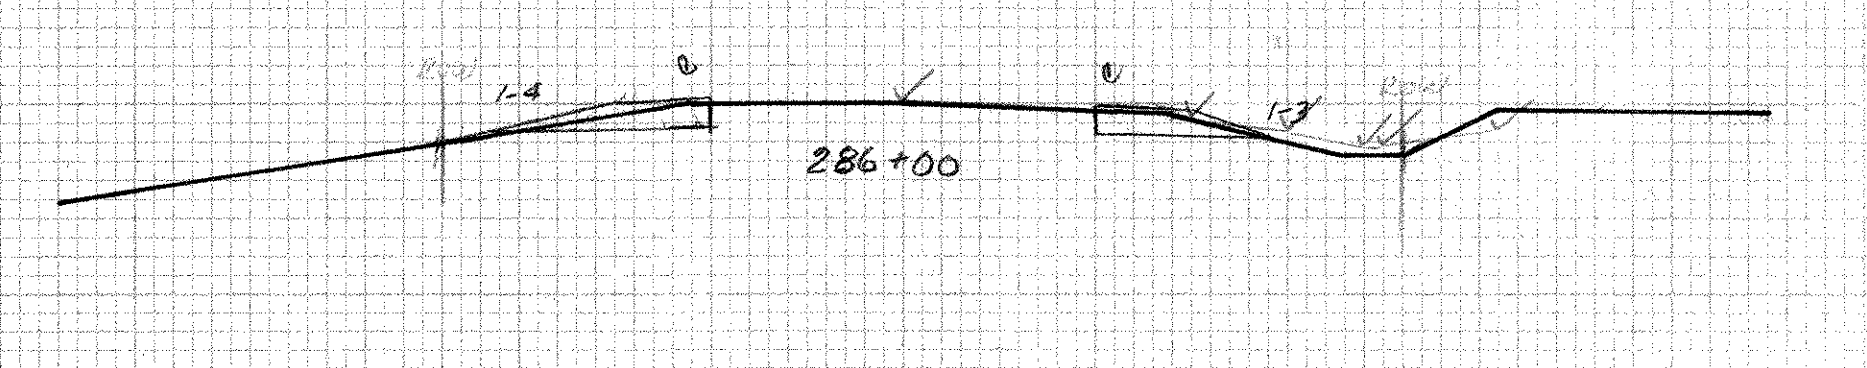

286+00

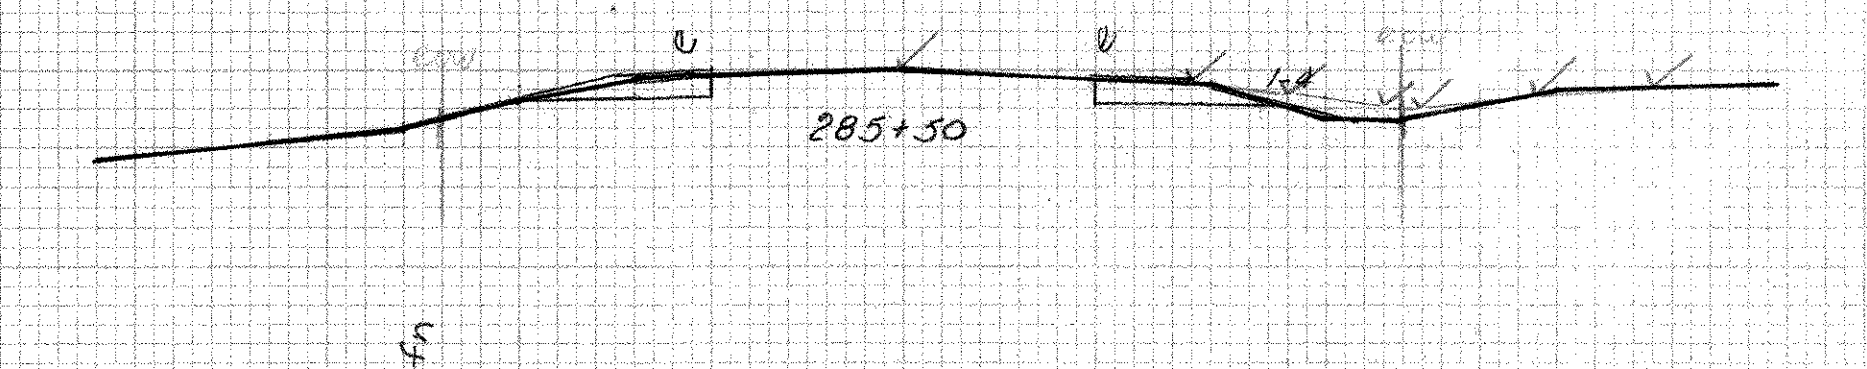


285+50

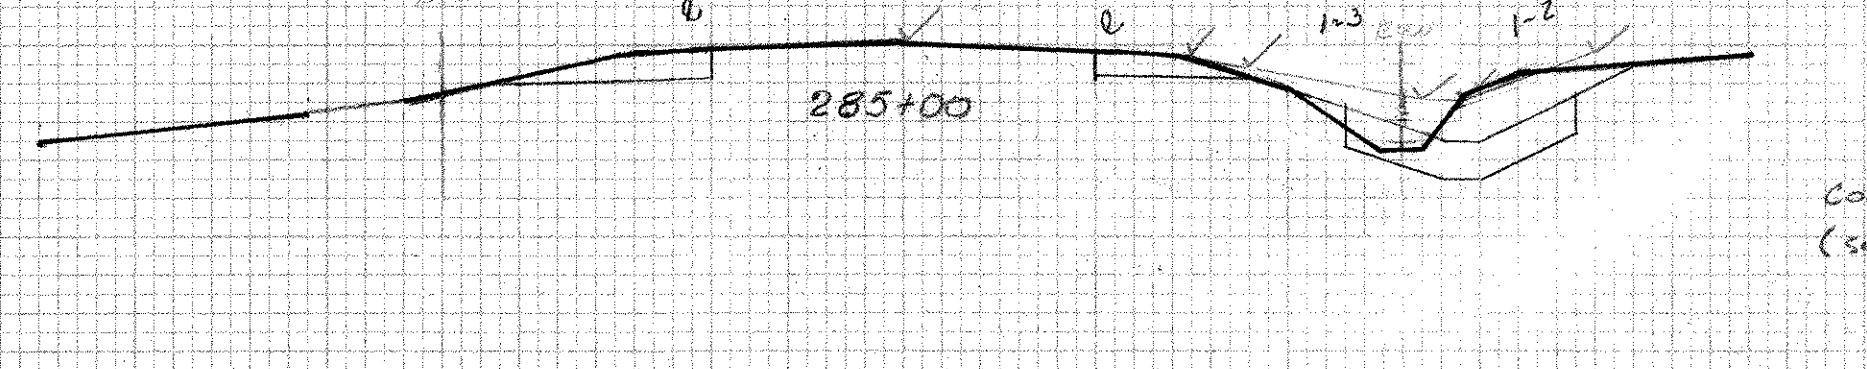


285+00


284+85 to 285+00
CONSTRUCT SPECIAL DITCH
(SEE LAYOUTS FOR TYPICAL SECTION)

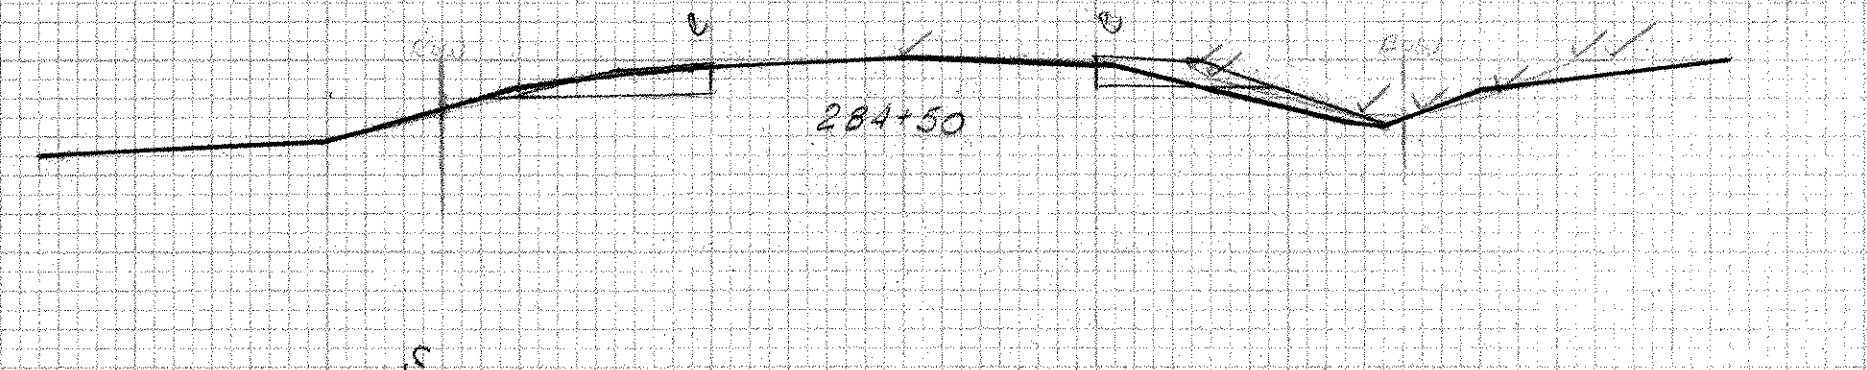


284+50

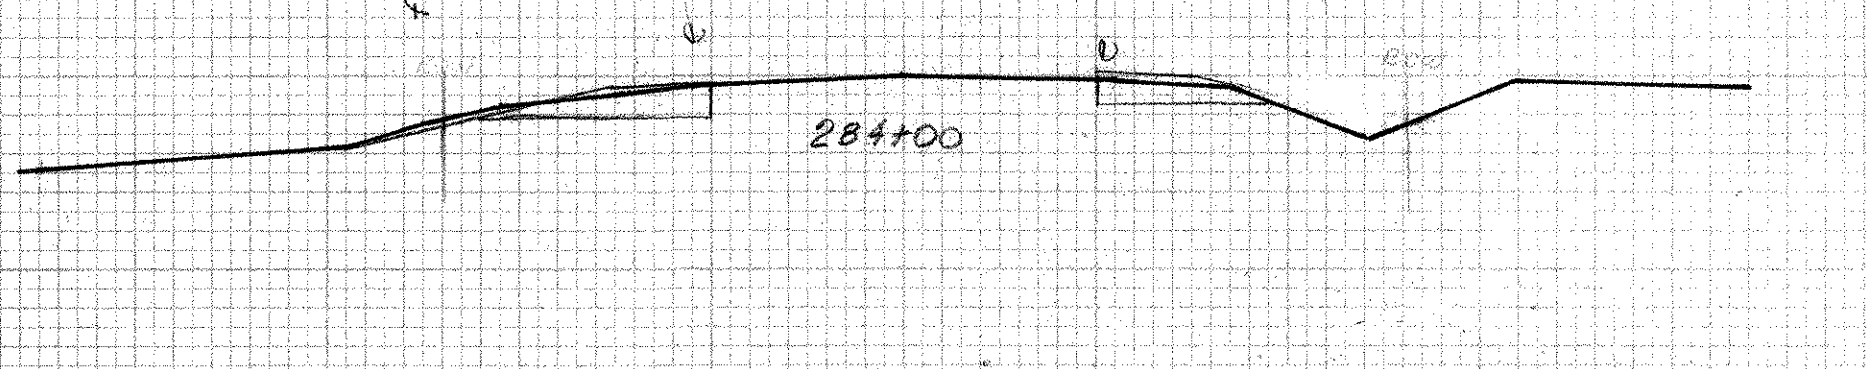


284+00

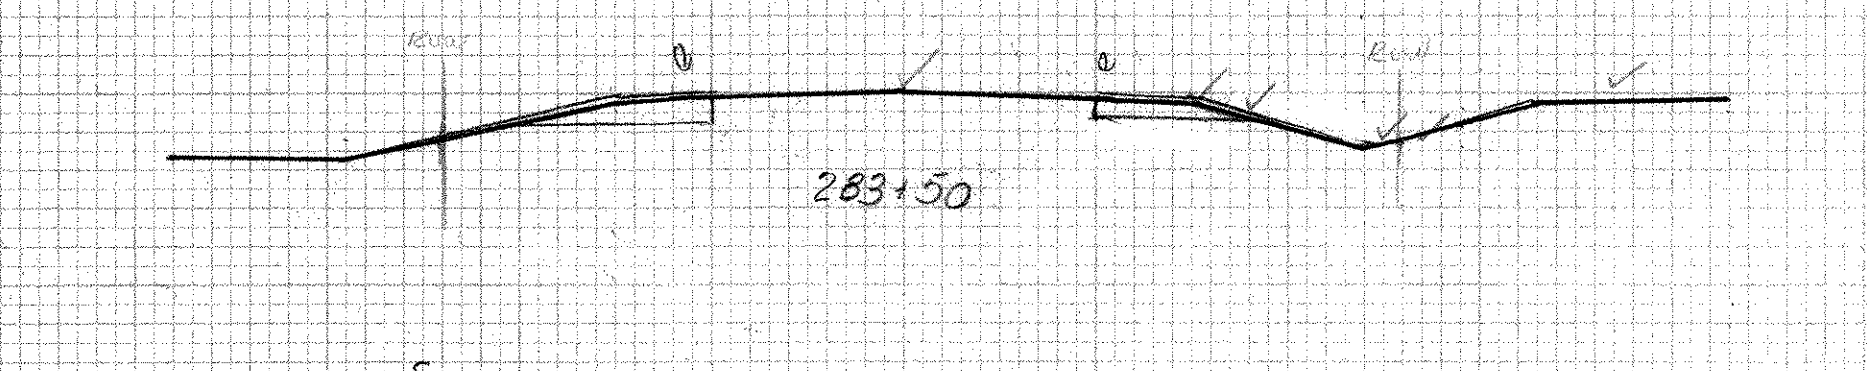

283+50

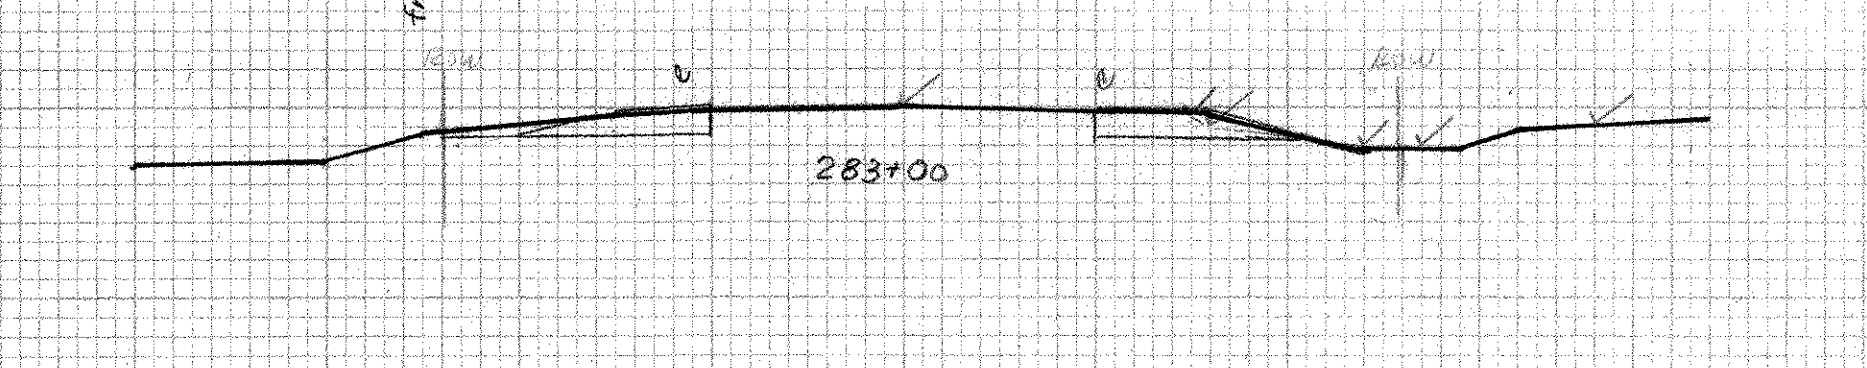

283+00

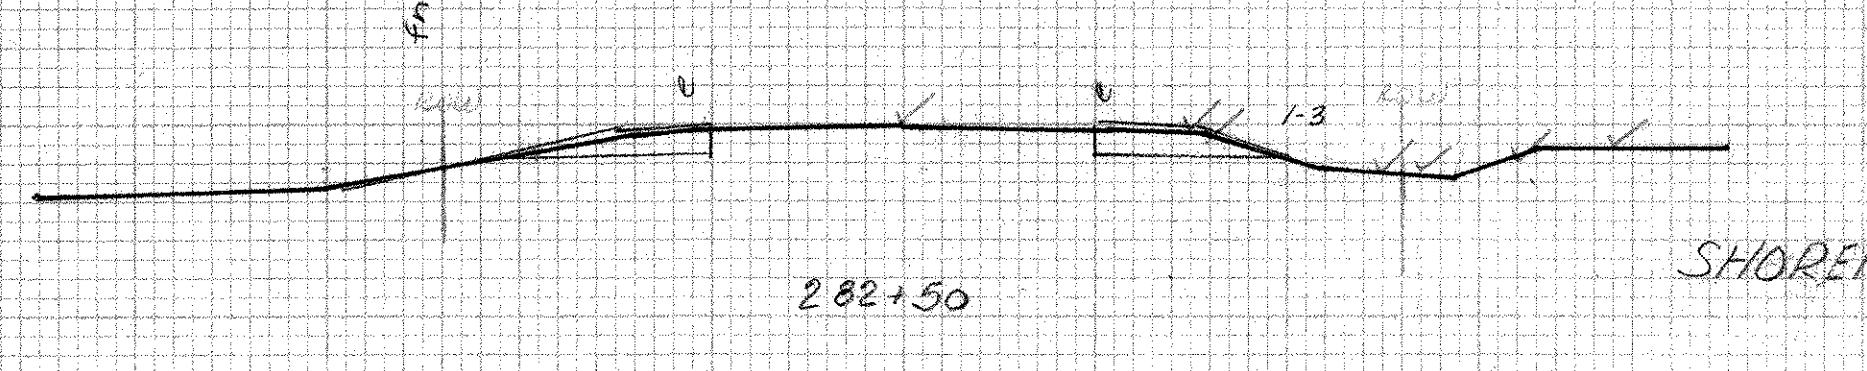

282+50

SHOREHAM-BRIDPORT ADDIS ON
F 017-1(2)

279+50 - 286+50
Sheet 301-D of 477

NO.	DATE	BY	CHKD.

NO.	DATE	BY	CHKD.