
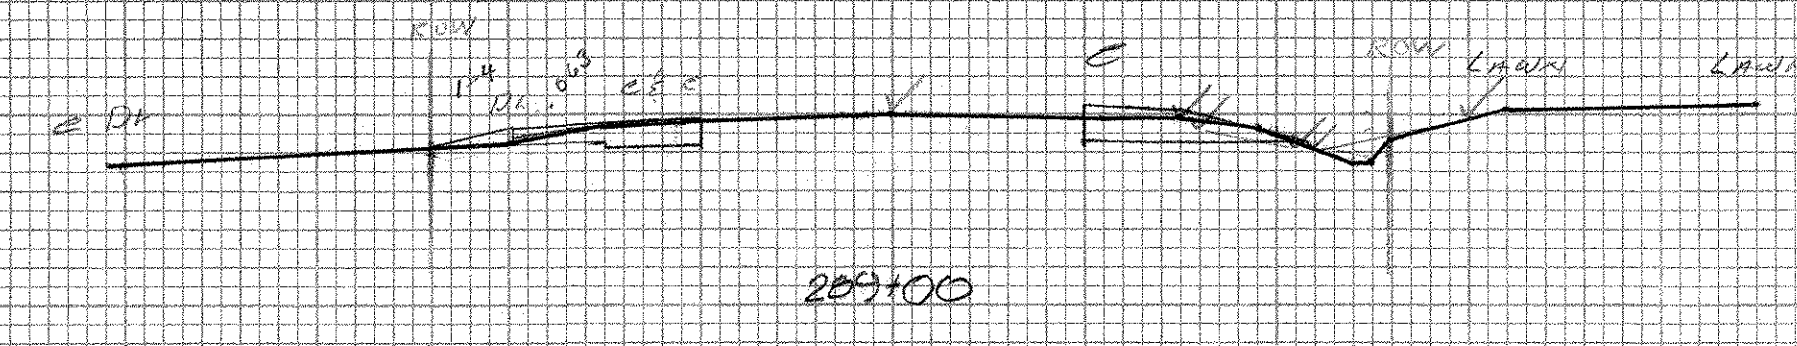
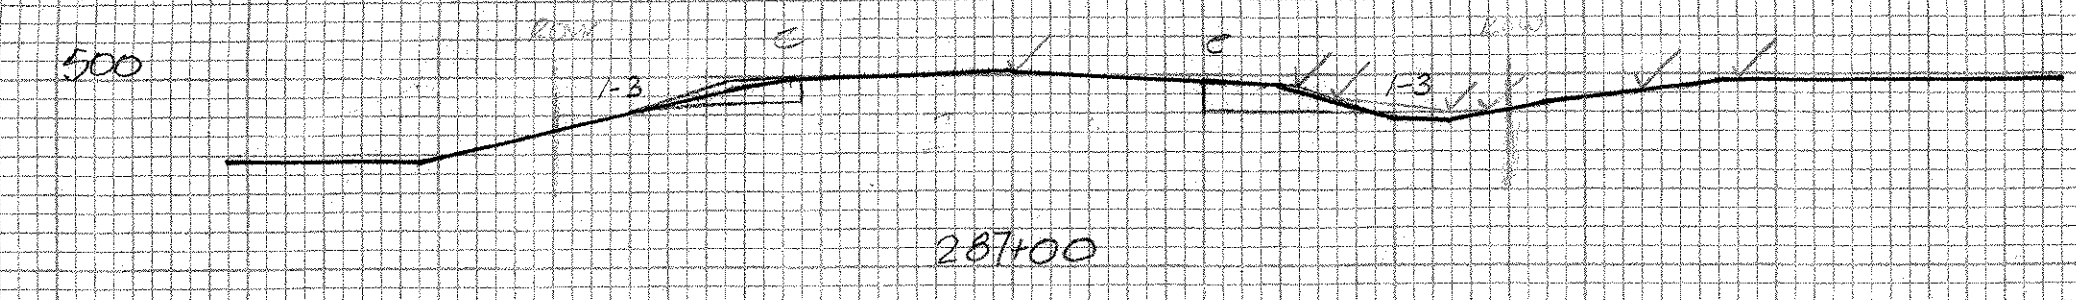
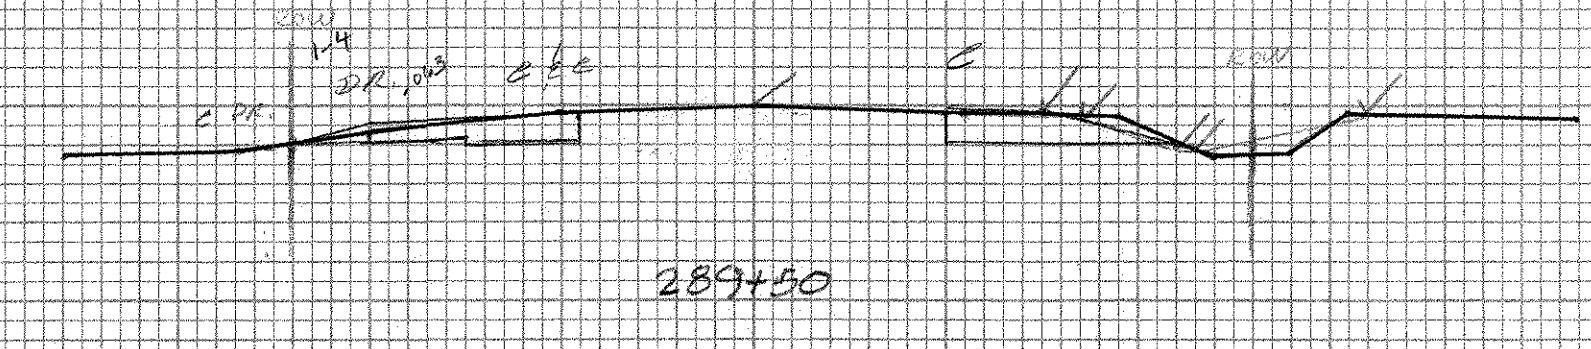
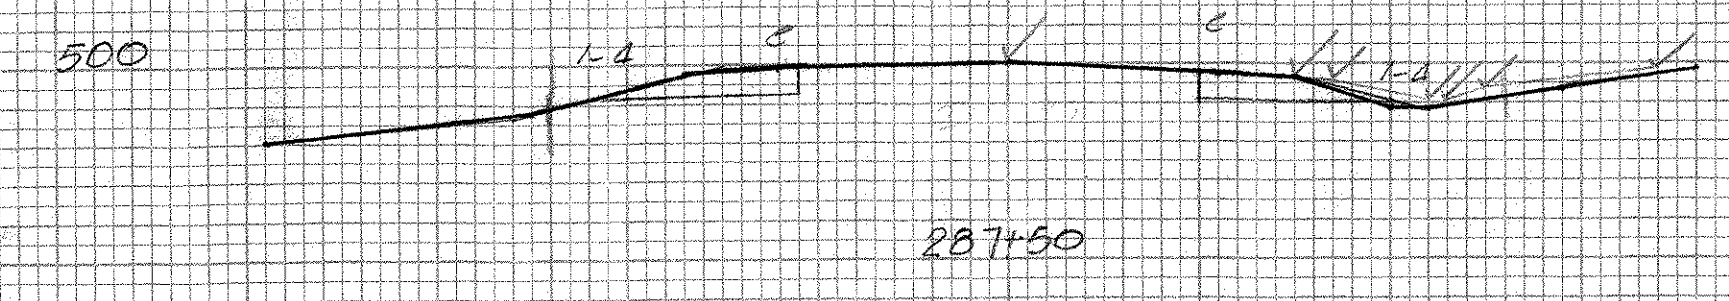
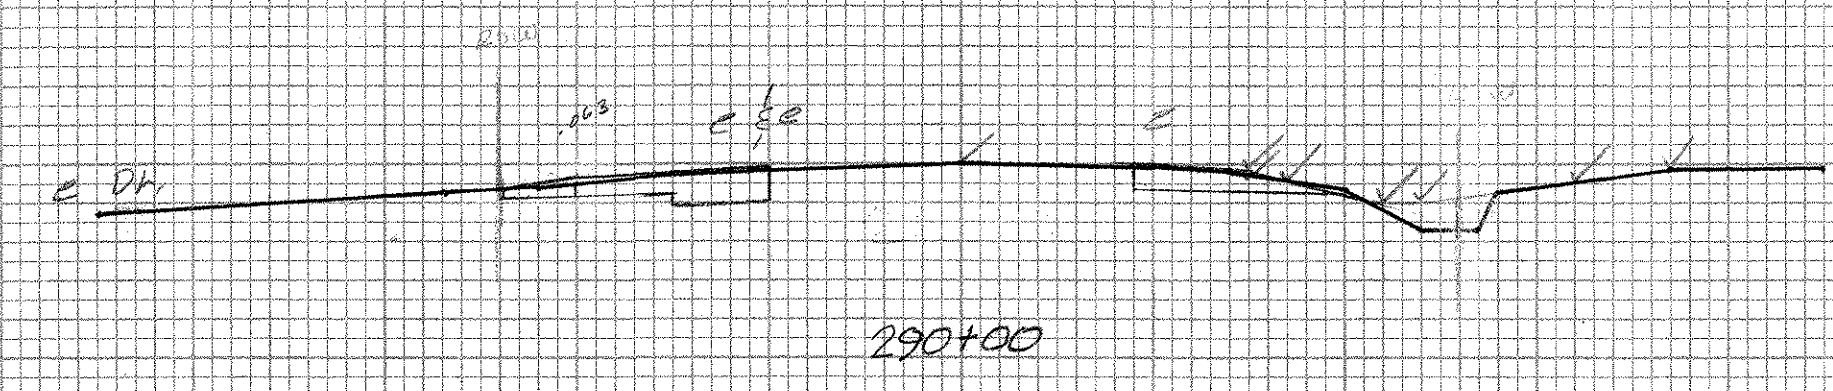
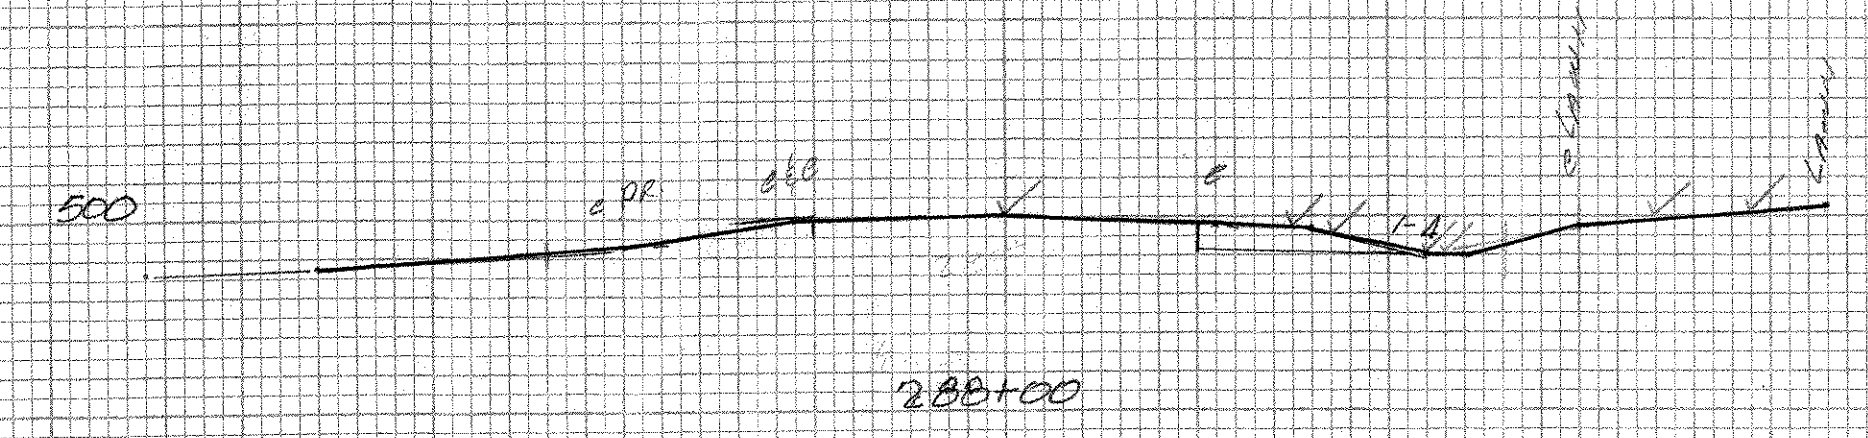


DATE _____
 BY _____
 SURVEYED _____
 PLOTTED _____
 ORIGINAL SURVEY NOTE BOOK NO. _____
 AREAS CHECKED _____

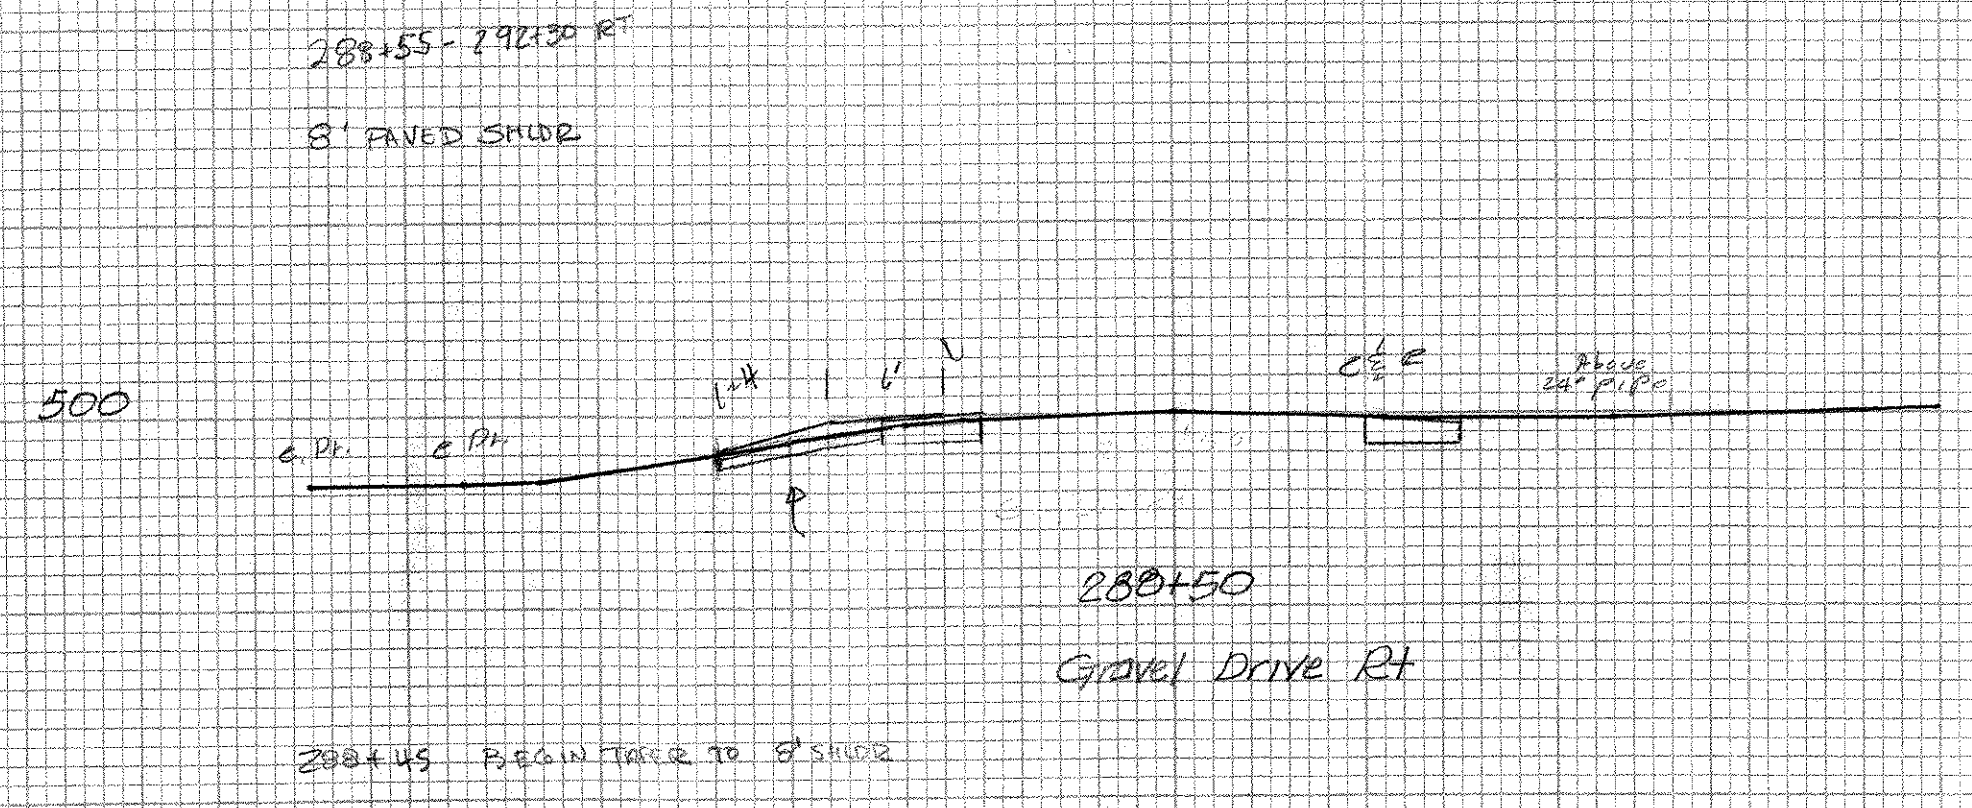

DATE _____
 BY _____
 SURVEYED _____
 PLOTTED _____
 ORIGINAL SURVEY NOTE BOOK NO. _____
 AREAS CHECKED _____

SHOREHAM-BRIDGPORT-ADDISON
 F 017-1(2)
 ORIGINAL SECTIONS
 287+00 - 290+00