



288+55L ~ 292+30L
 Grade Shim & Pav Existing 8' Foot Shoulder
 Pav w/ 2" Bit Core Pavement.

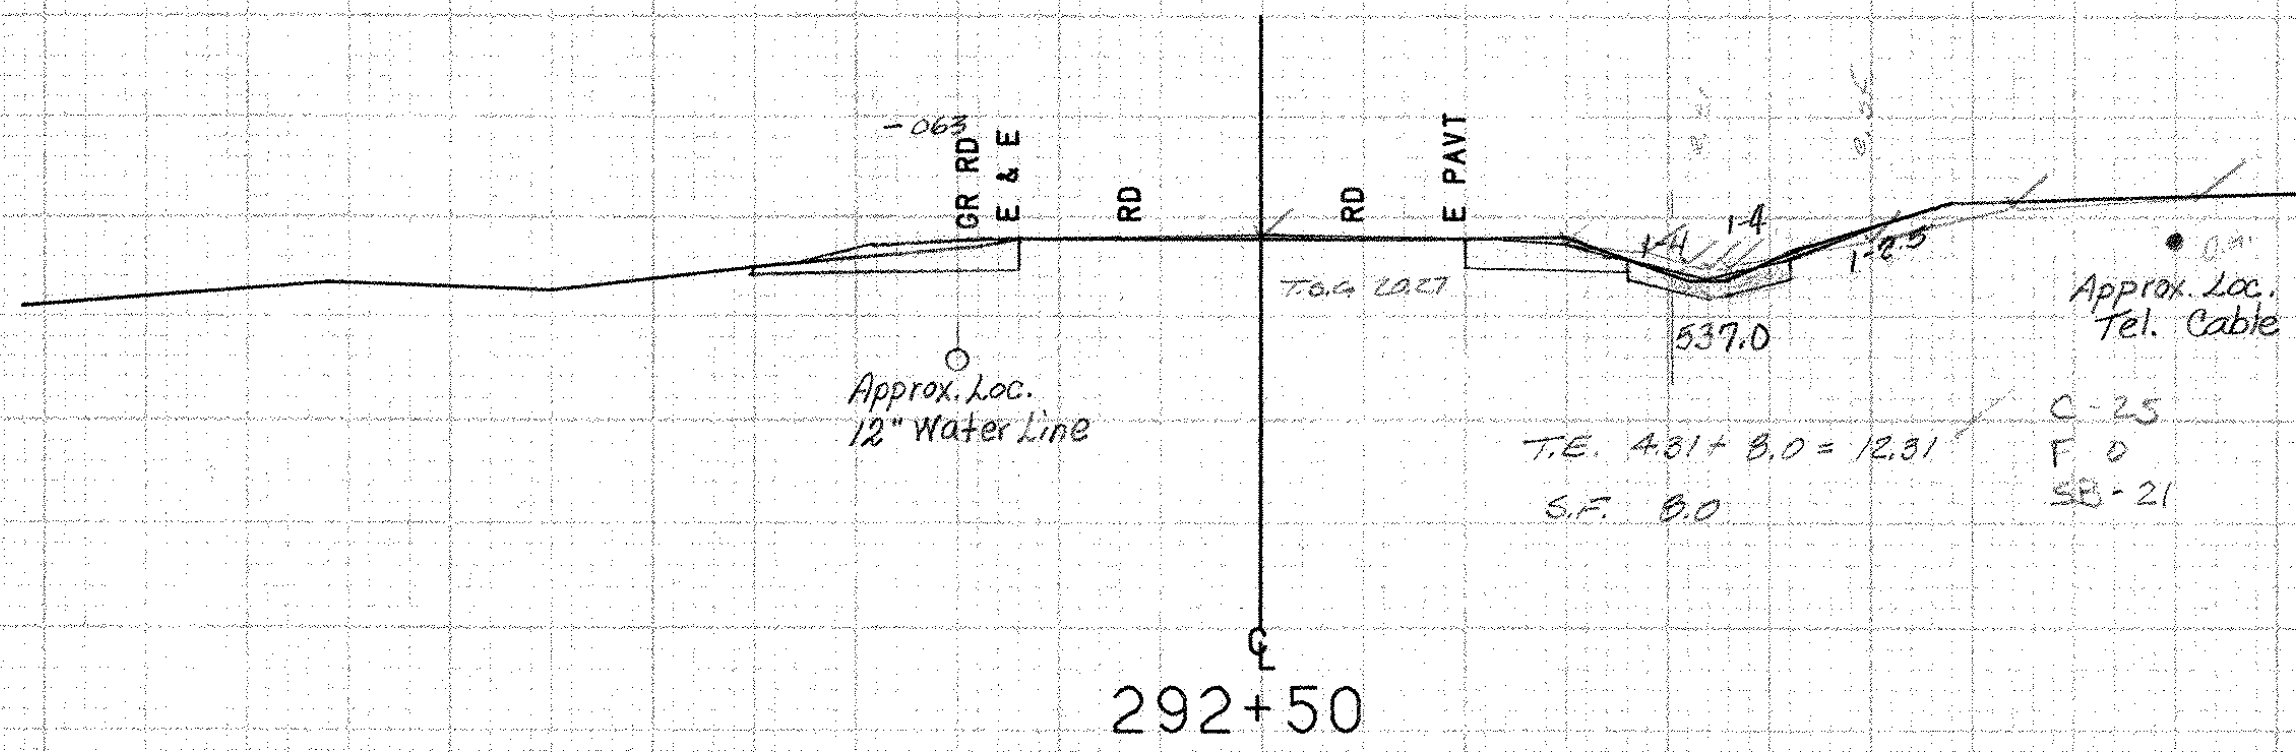


T.E.	
20.27	536.3
22.0	536.0
24.0	537.0
26.0	538.0
28.0	536.5
21.0	536.5
20.27	537.3
20.27	536.3

530

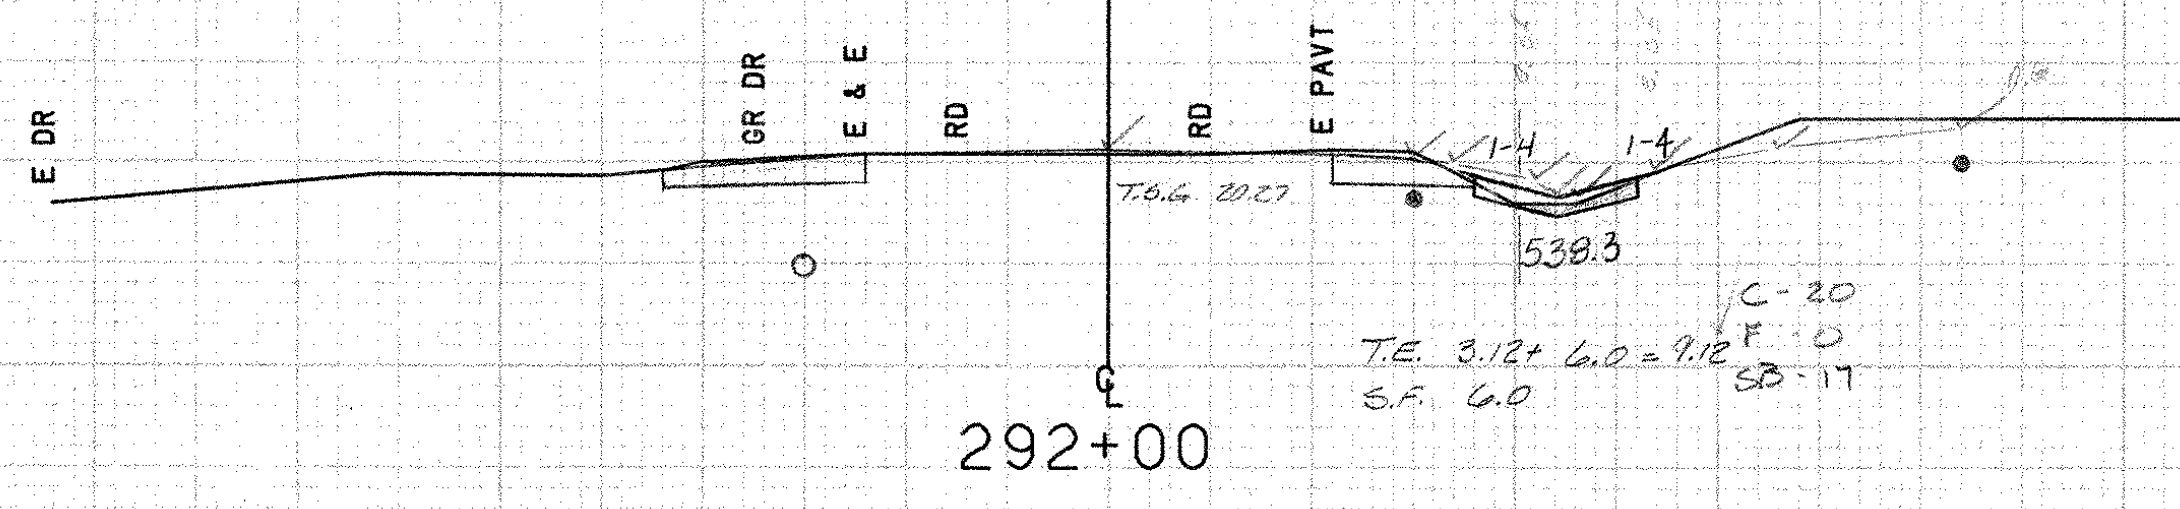


T.E.	
20.27	538.0
22.0	537.4
24.0	538.2
26.0	539.2
28.0	538.0
20.27	538.0

540

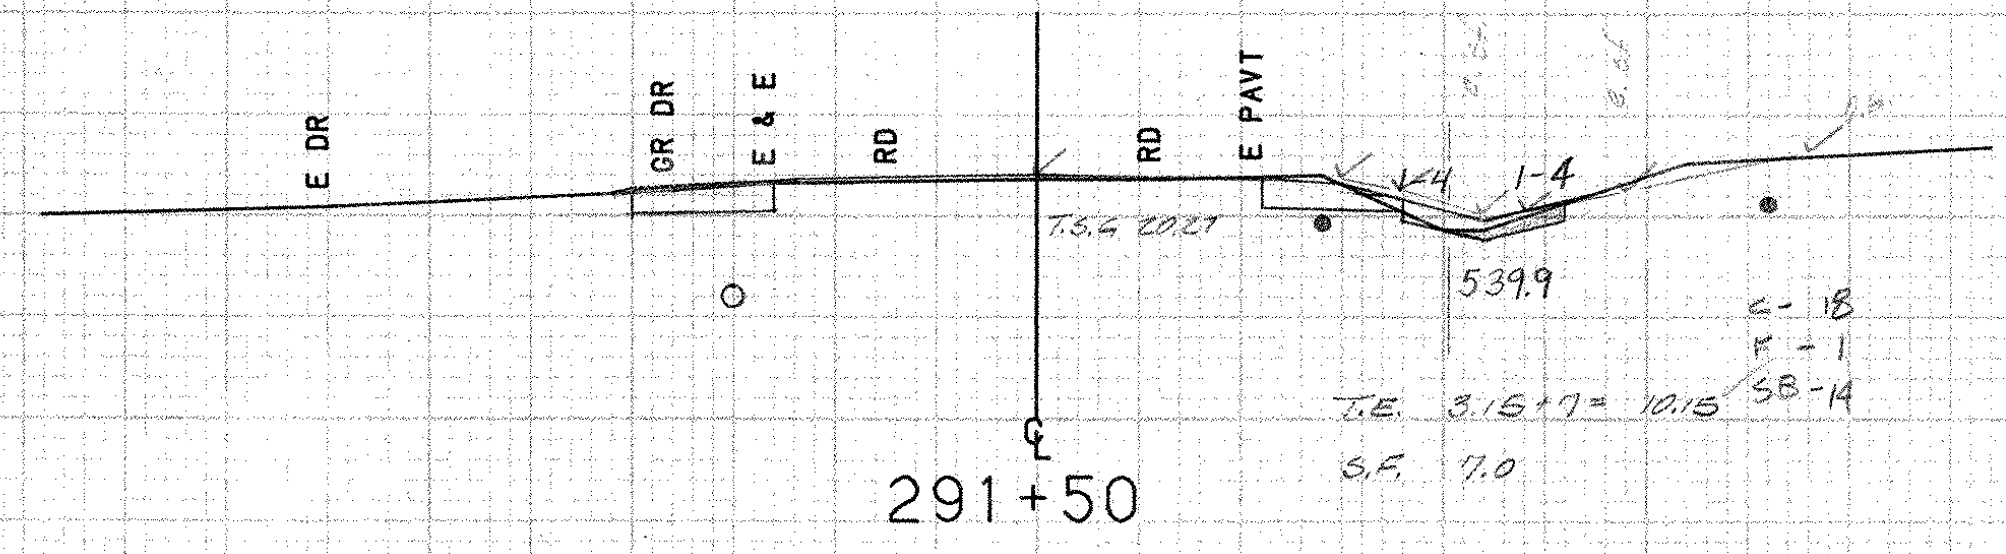

T.E.	
20.27	539.8
22.0	539.0
24.0	539.8
26.0	540.5
28.0	539.4
20.27	539.3

540

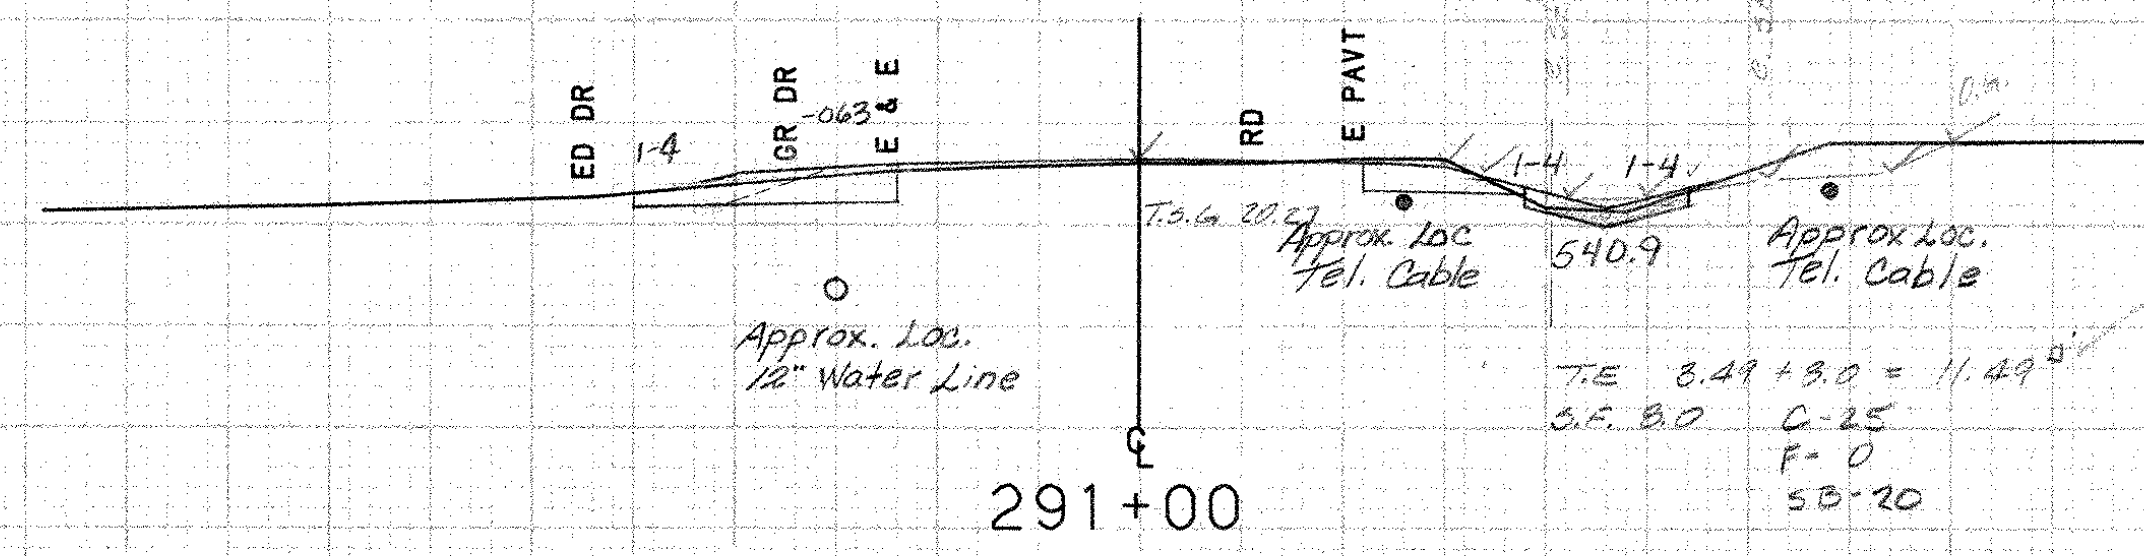

T.E.	
20.27	541.0
20.27	540.6
25.0	540.0
27.0	541.0
27.0	541.8
24.0	540.6
20.27	541.0

540

288+60 RT
 Begin Special Ditch w/ Stone Fill Type I

Bridport MM 5.38 ~ MM 5.68

FROM STA.	291+00	TO STA.	292+50
PROJECT NAME	SHOREHAM-BRIDPORT-ADDISON		
NO.	F017-1 (2)	PLOTTED	05/27/88
SURVEYED BY	MOREAU	05/88	0130
SHEET	362 OF 422 SHEETS	SHEET	362 OF 477

SCALE 1" = 10 FEET