

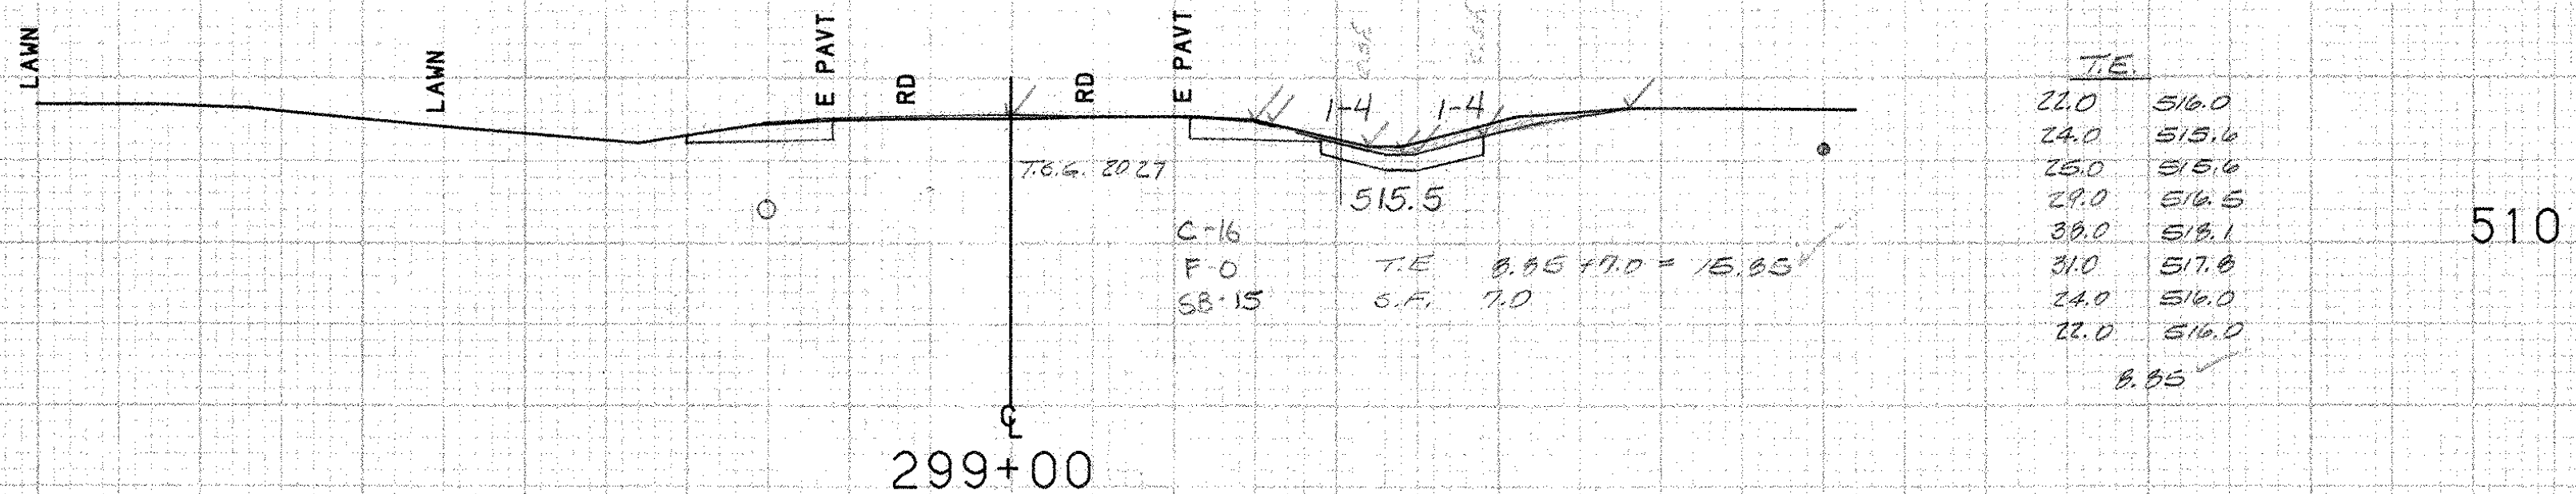
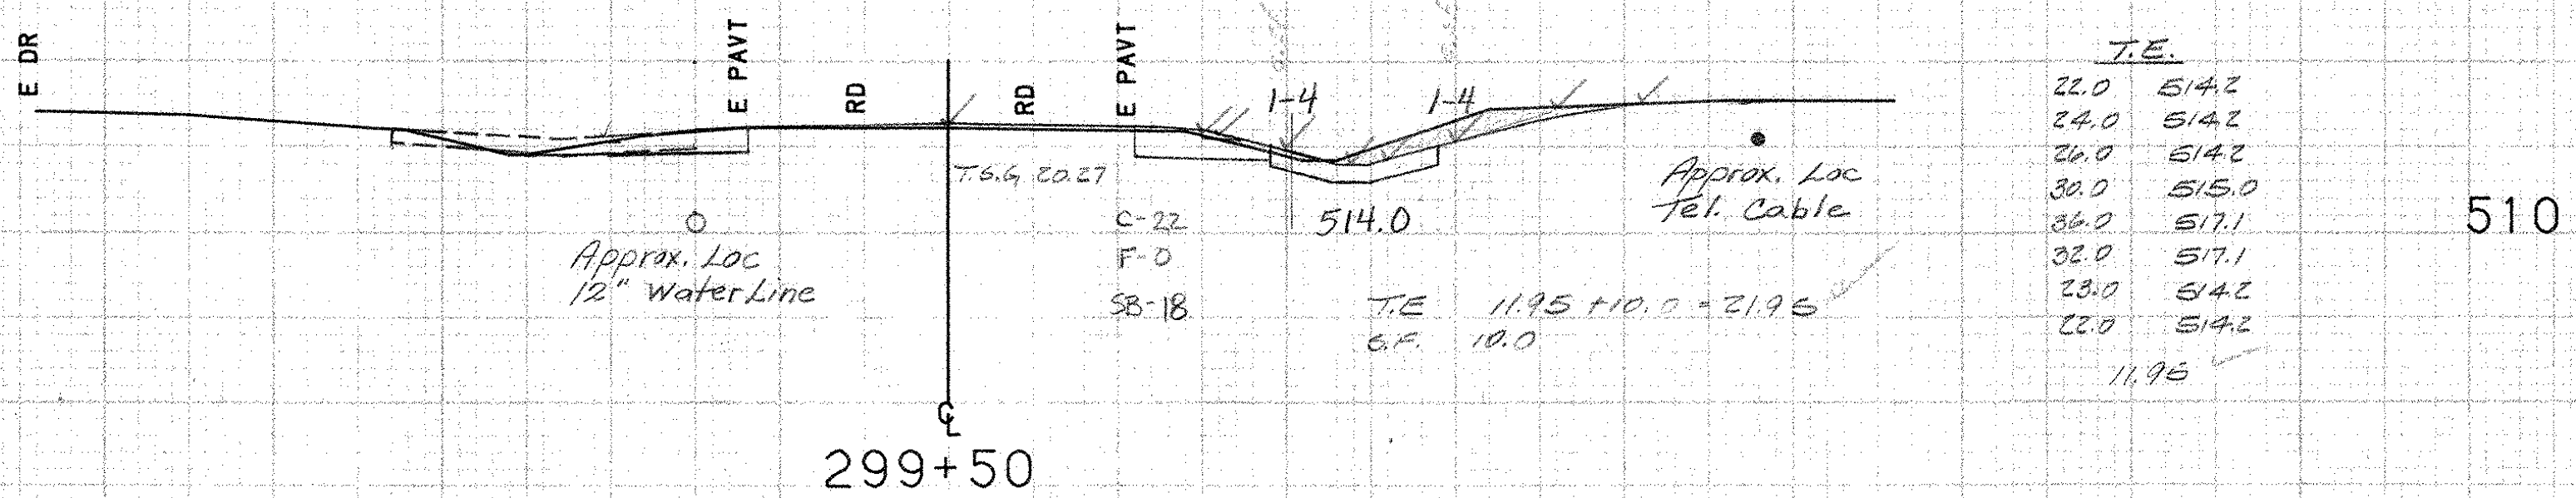
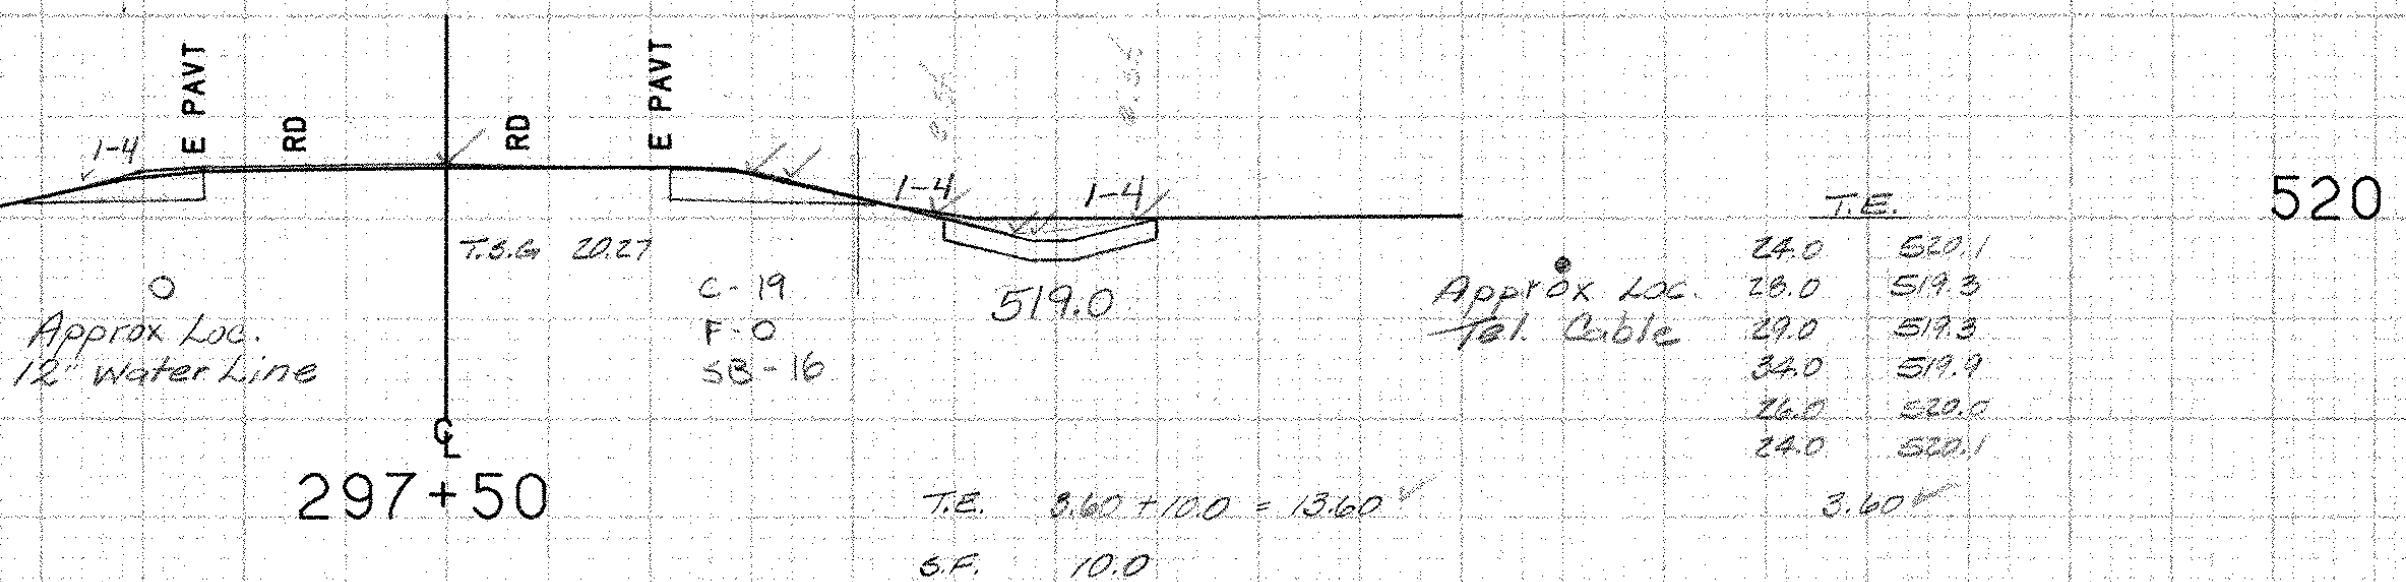


299+60 Lt.
Existing 15" ACCGMP ~ Retain
Construct Drive (Gravel, 12ft. wide)

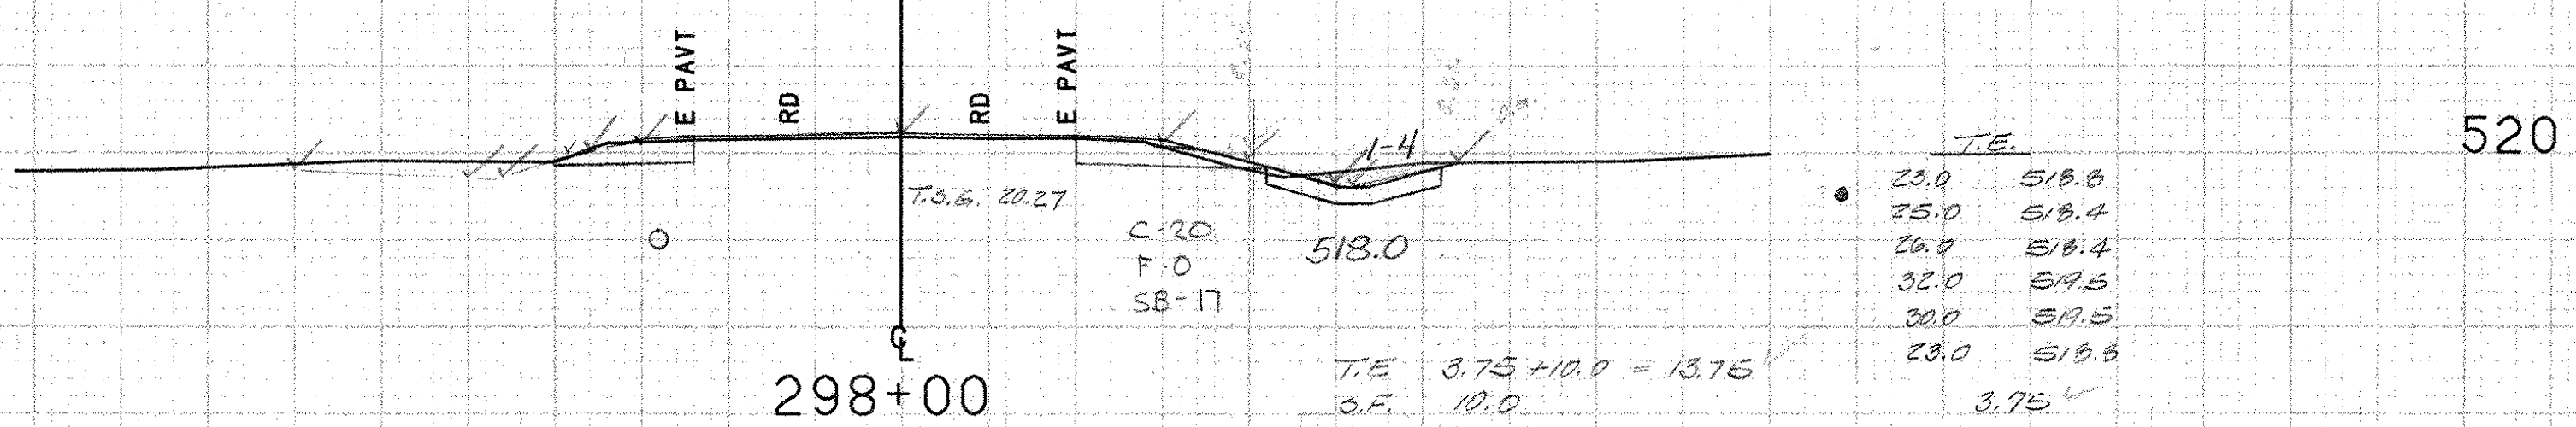

298+50 Lt.
Existing 15" ACCGMP ~ Retain
Construct Drive (Gravel, 12ft. wide)

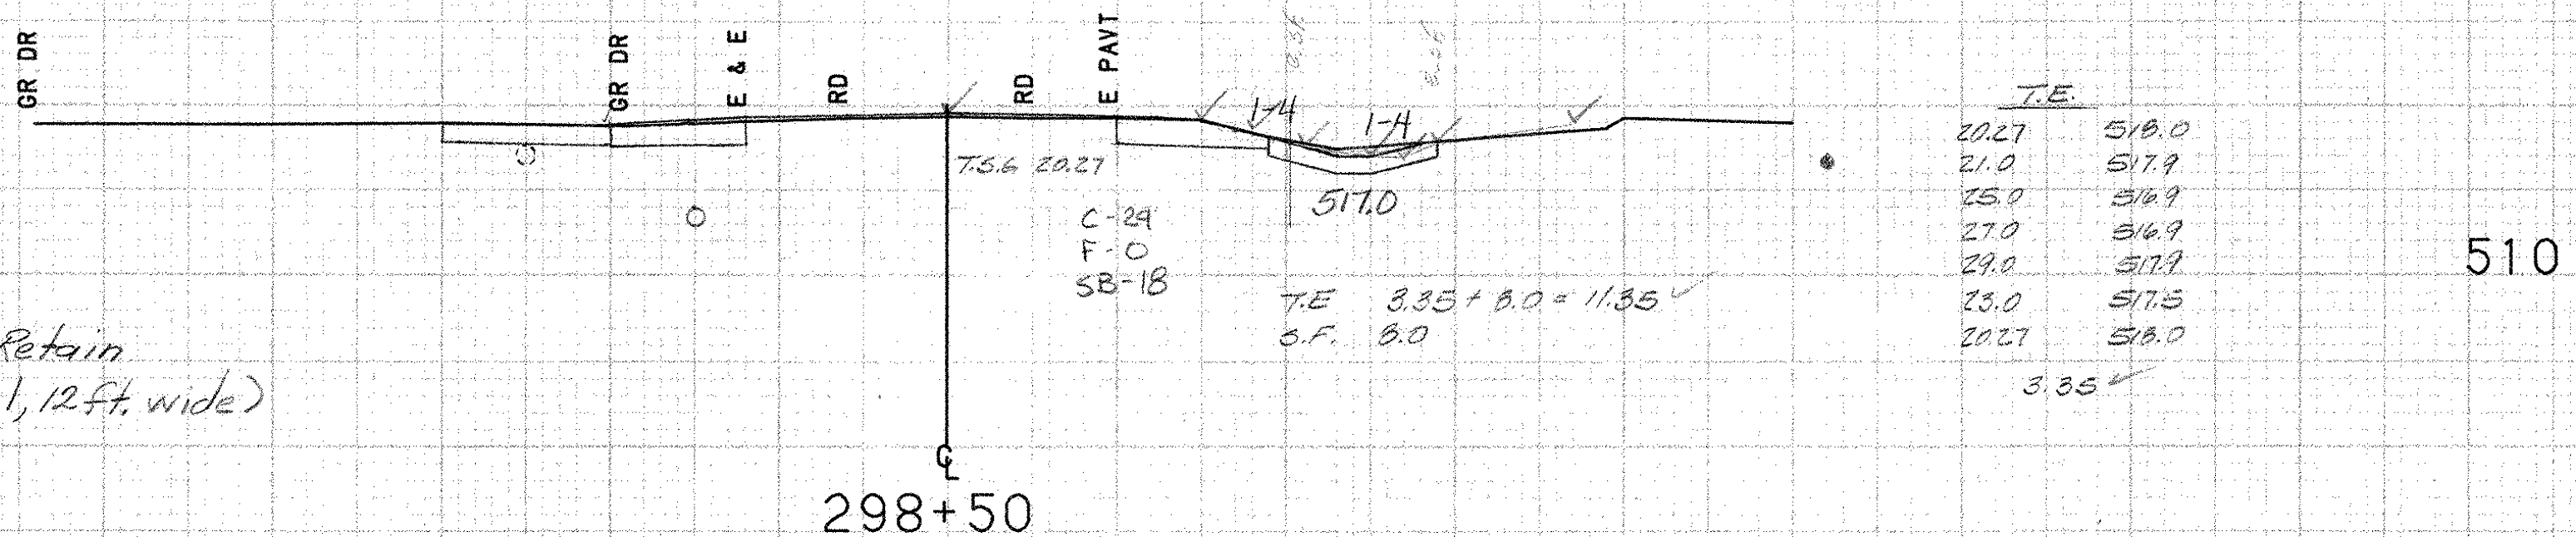

Bridport MM 5.63 ~ MM 6.10

FROM STA.	297+50	TO STA.	299+50
PROJECT NAME	SHOREHAM-BRIDPORT-ADDISON		
NO.	F017-1 (2)	PLOTTED	05/27/88
SURVEYED BY	MOREAU	05/88	0130
SHEET	365	OF	420 SHEETS

SCALE 1" = 10 FEET