



T.E.	
37.0	498.0
43.0	495.2
45.0	493.8
49.0	490.5
49.0	491.6
42.0	496.6
37.0	495.0
13.20	

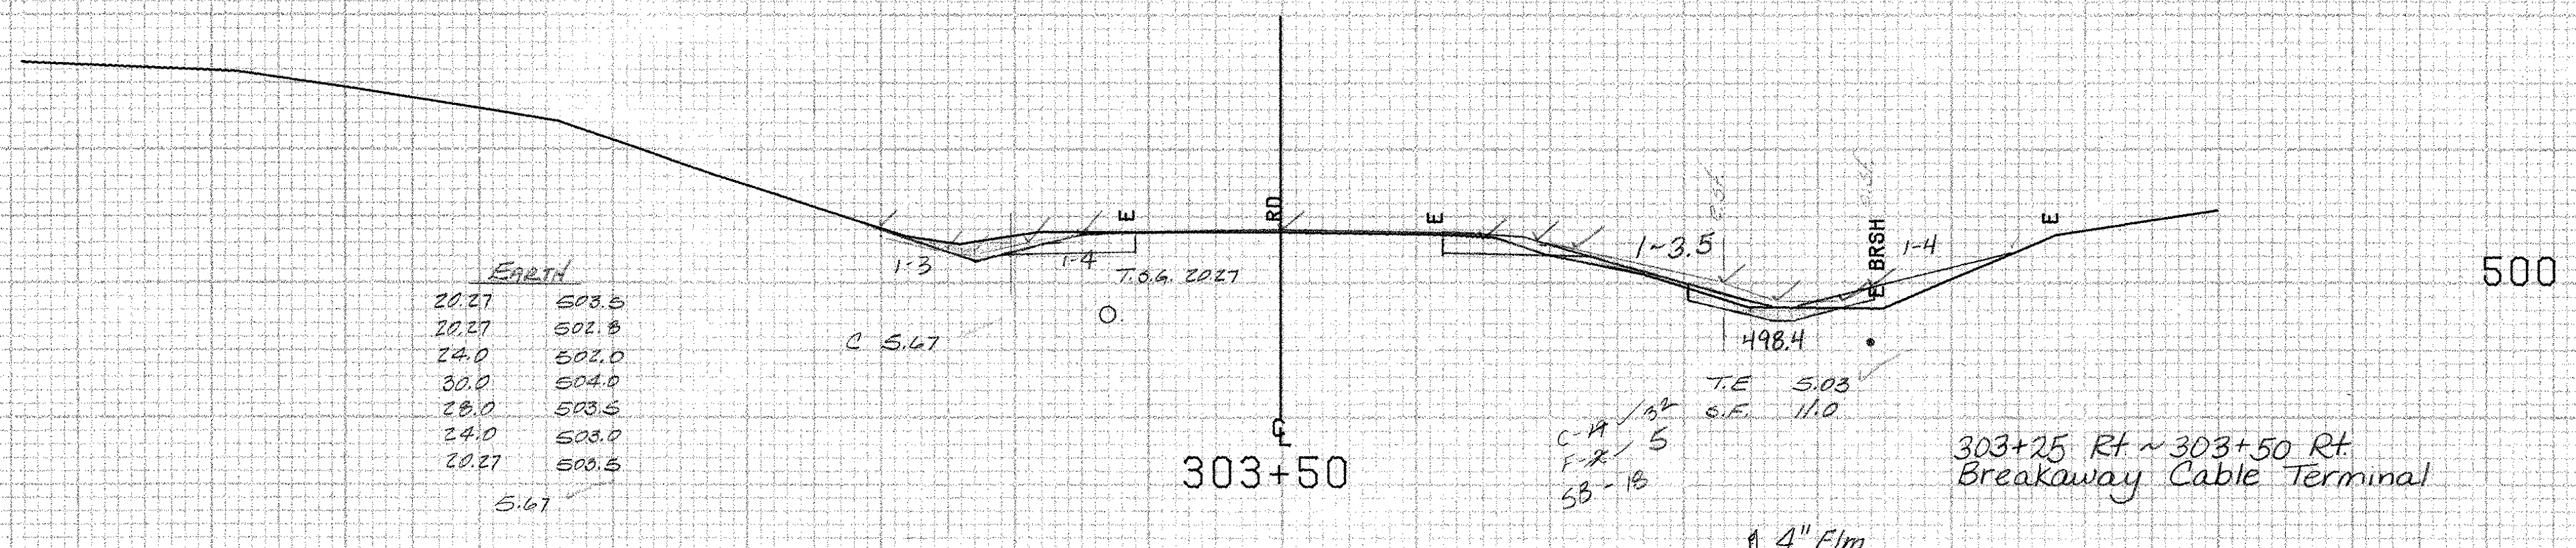

T.E.	
33.0	498.8
33.0	498.7
36.5	497.2
38.5	497.2
47.0	498.0
35.0	498.0
33.0	498.8
5.03	

EARTH	
20.27	500.5
20.27	502.5
24.0	502.0
30.0	504.0
28.0	503.5
24.0	503.0
20.27	500.5
5.67	

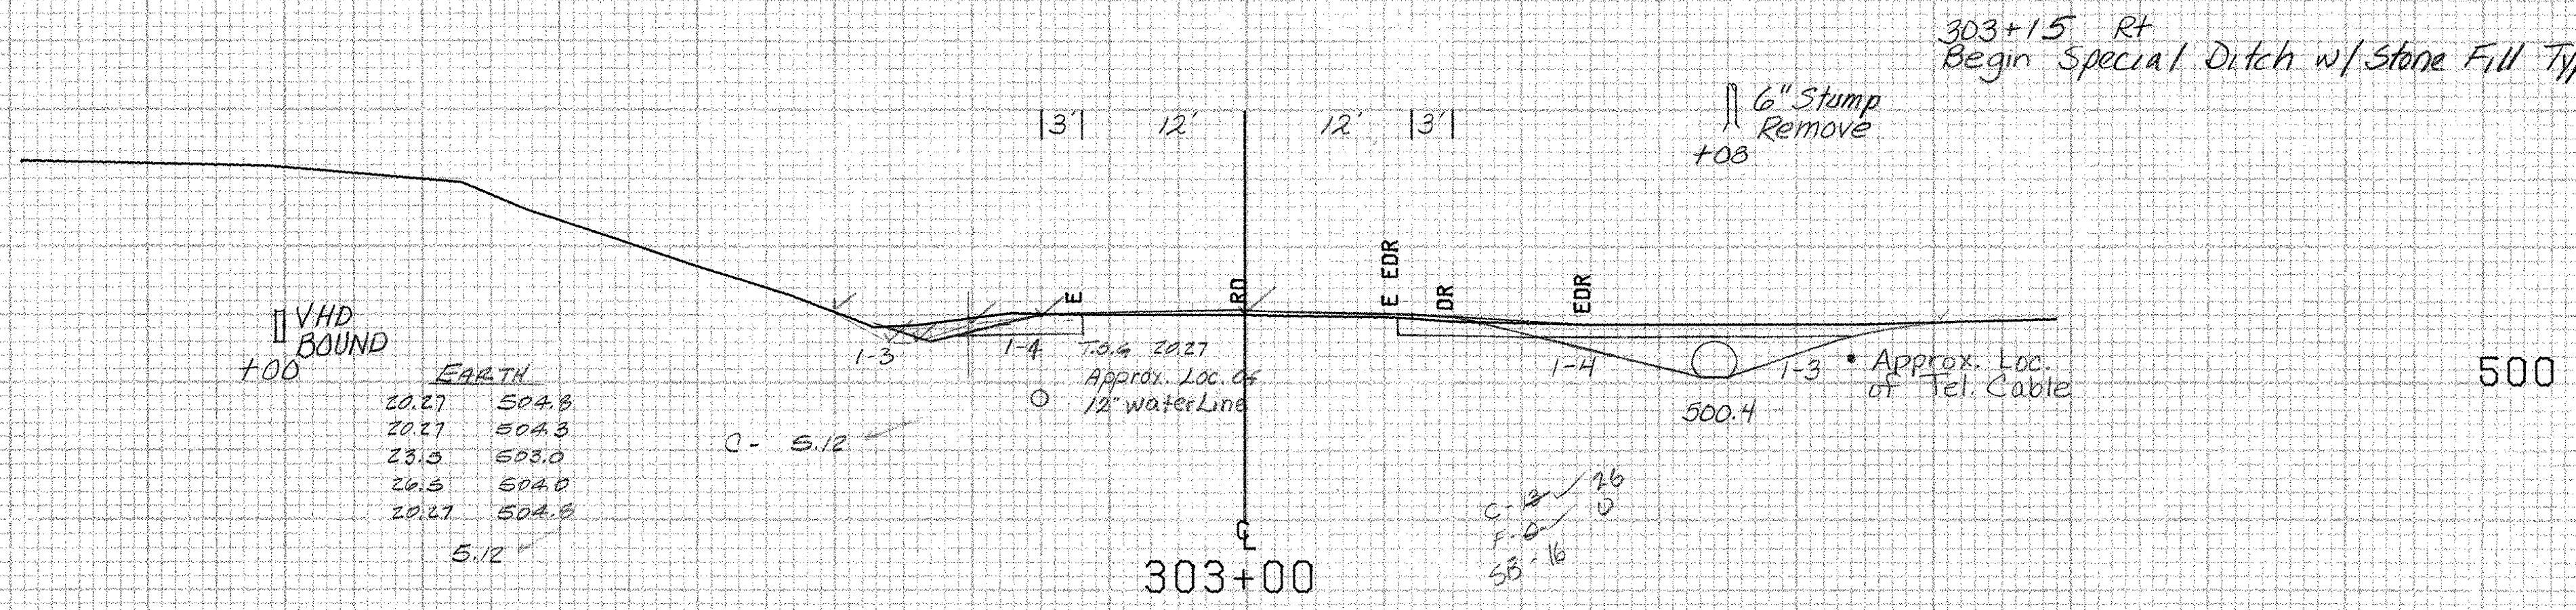

EARTH	
20.27	504.8
20.27	504.3
23.5	503.0
20.5	504.0
20.27	504.8
5.12	

BRIDPORT MM 5.68 ~ MM 6.10

FROM STA.	303+00	TO STA.	304+00
PROJECT NAME	SHOREHAM-BRIDPORT-ADDISON		
NO.	F017-1(2)	PLOTTED	02/28/84
SURVEYED BY	FANTONI	FEBRUARY	84
SHEET	368	OF	420 SHEETS
		SHEET	300

SCALE 1" = 10 FEET

CATS W/C 5-572