

310+40
Begin Geotextile Fabric for Filters (Subgrade)


310+37
Begin Sand Borrow

310+00
Begin 50' Transition to Full Depth Subbase Repair
See Sheet 420 of 420 for Details

COMMON	LOWWAY
0	507.4
13	506.6
14	504.8
11	505.1
11	506.0
-11	507.0
-11	506.2
-20	507.0
-19	507.8
-11	507.9
0	507.4

35.80' TOTAL
17.65' 1/2


CE UC	SF
72	494
62	489.8
61	488.7
49	491.8
49	491.8
48	490.8
53	495.4
68	490.2
72	488.0
73	488.2
72	484
60	490.6
73	488.2
72	484

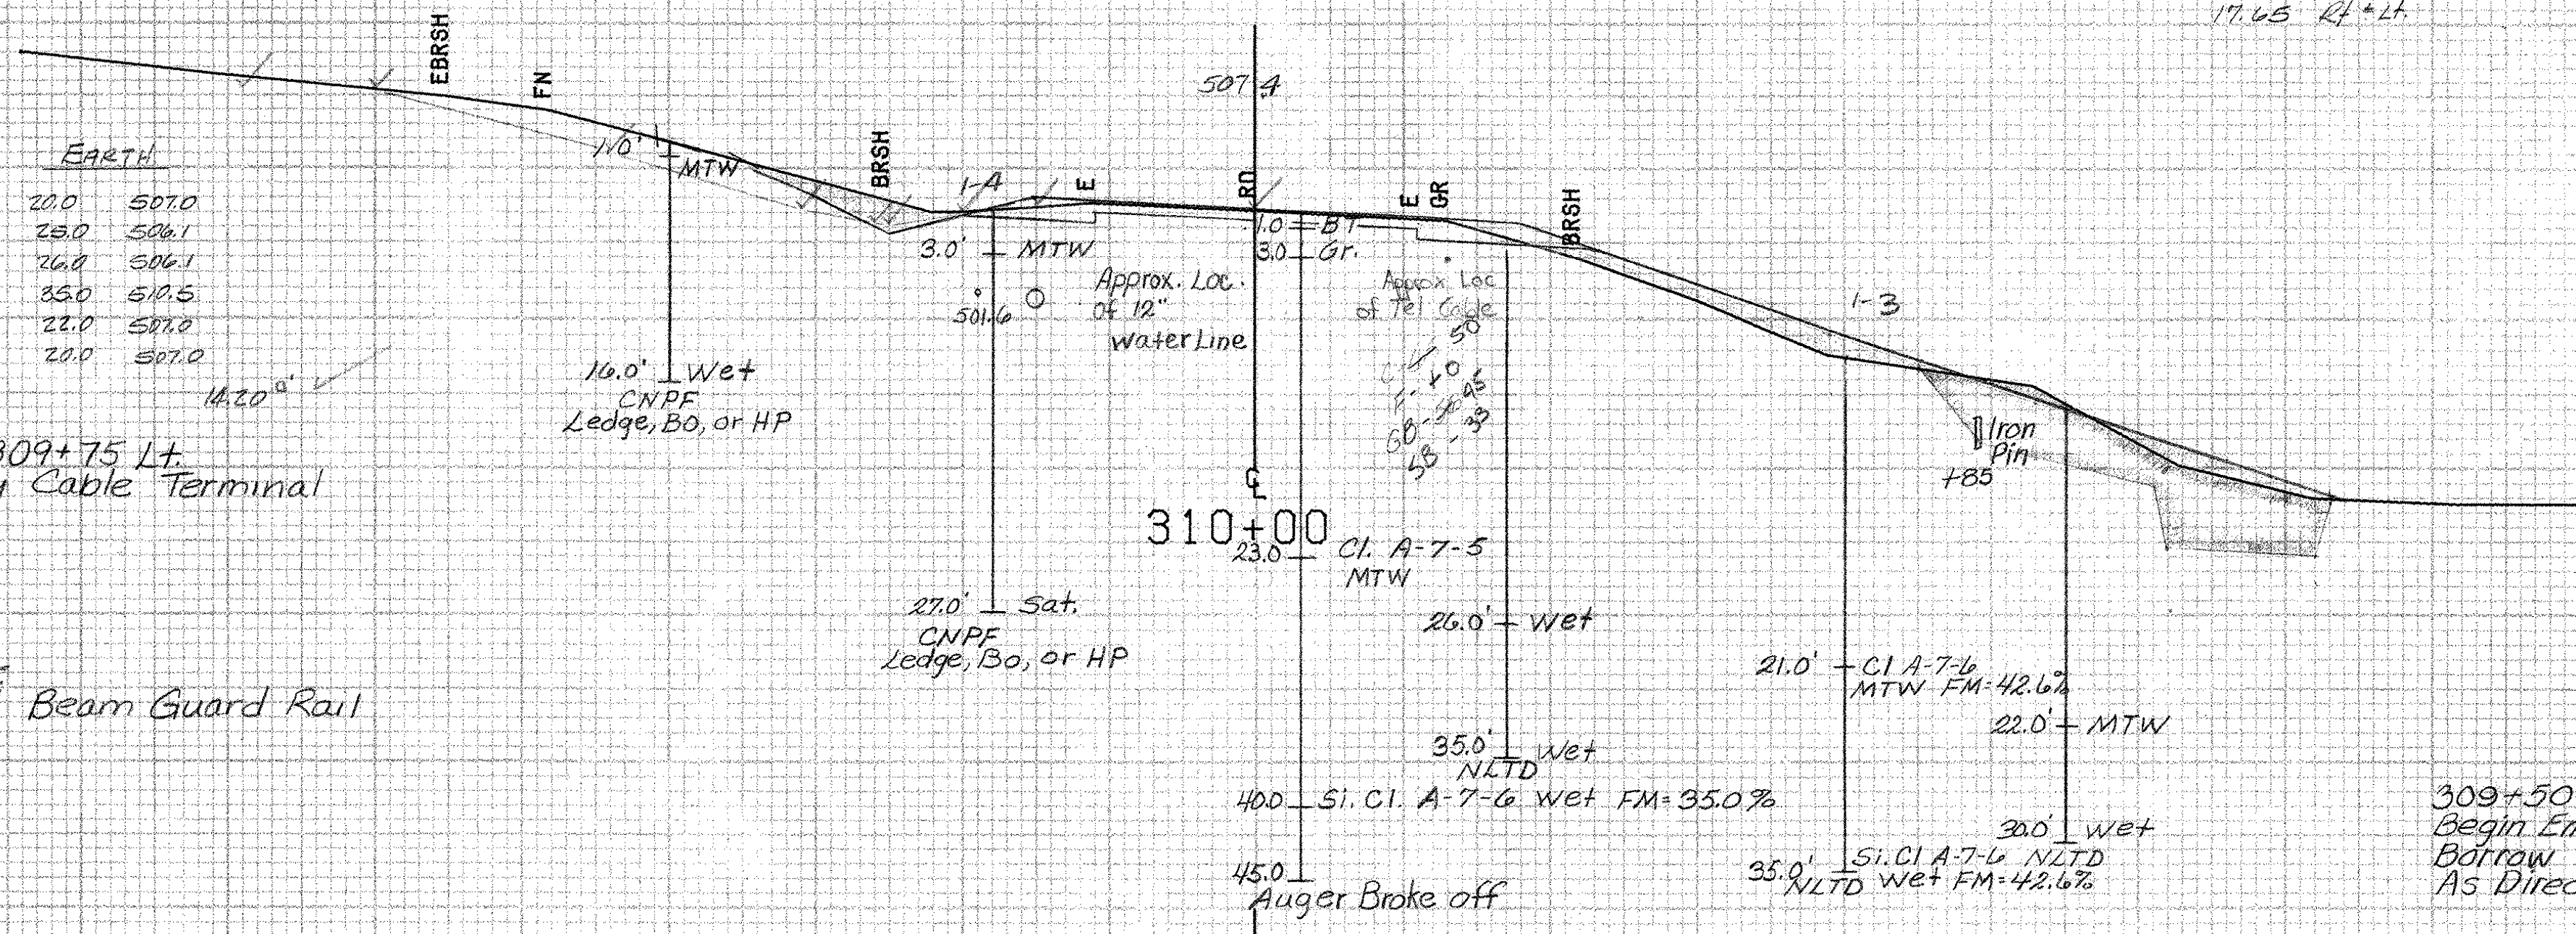

309+50 ~ 309+75 Lt.
Breakaway Cable Terminal


309+50 Lt.
End Steel Beam Guard Rail

309+50 Rt.
Begin Embankment Material of Granular
Borrow or Other Select Granular Material
As Directed by the Engineer

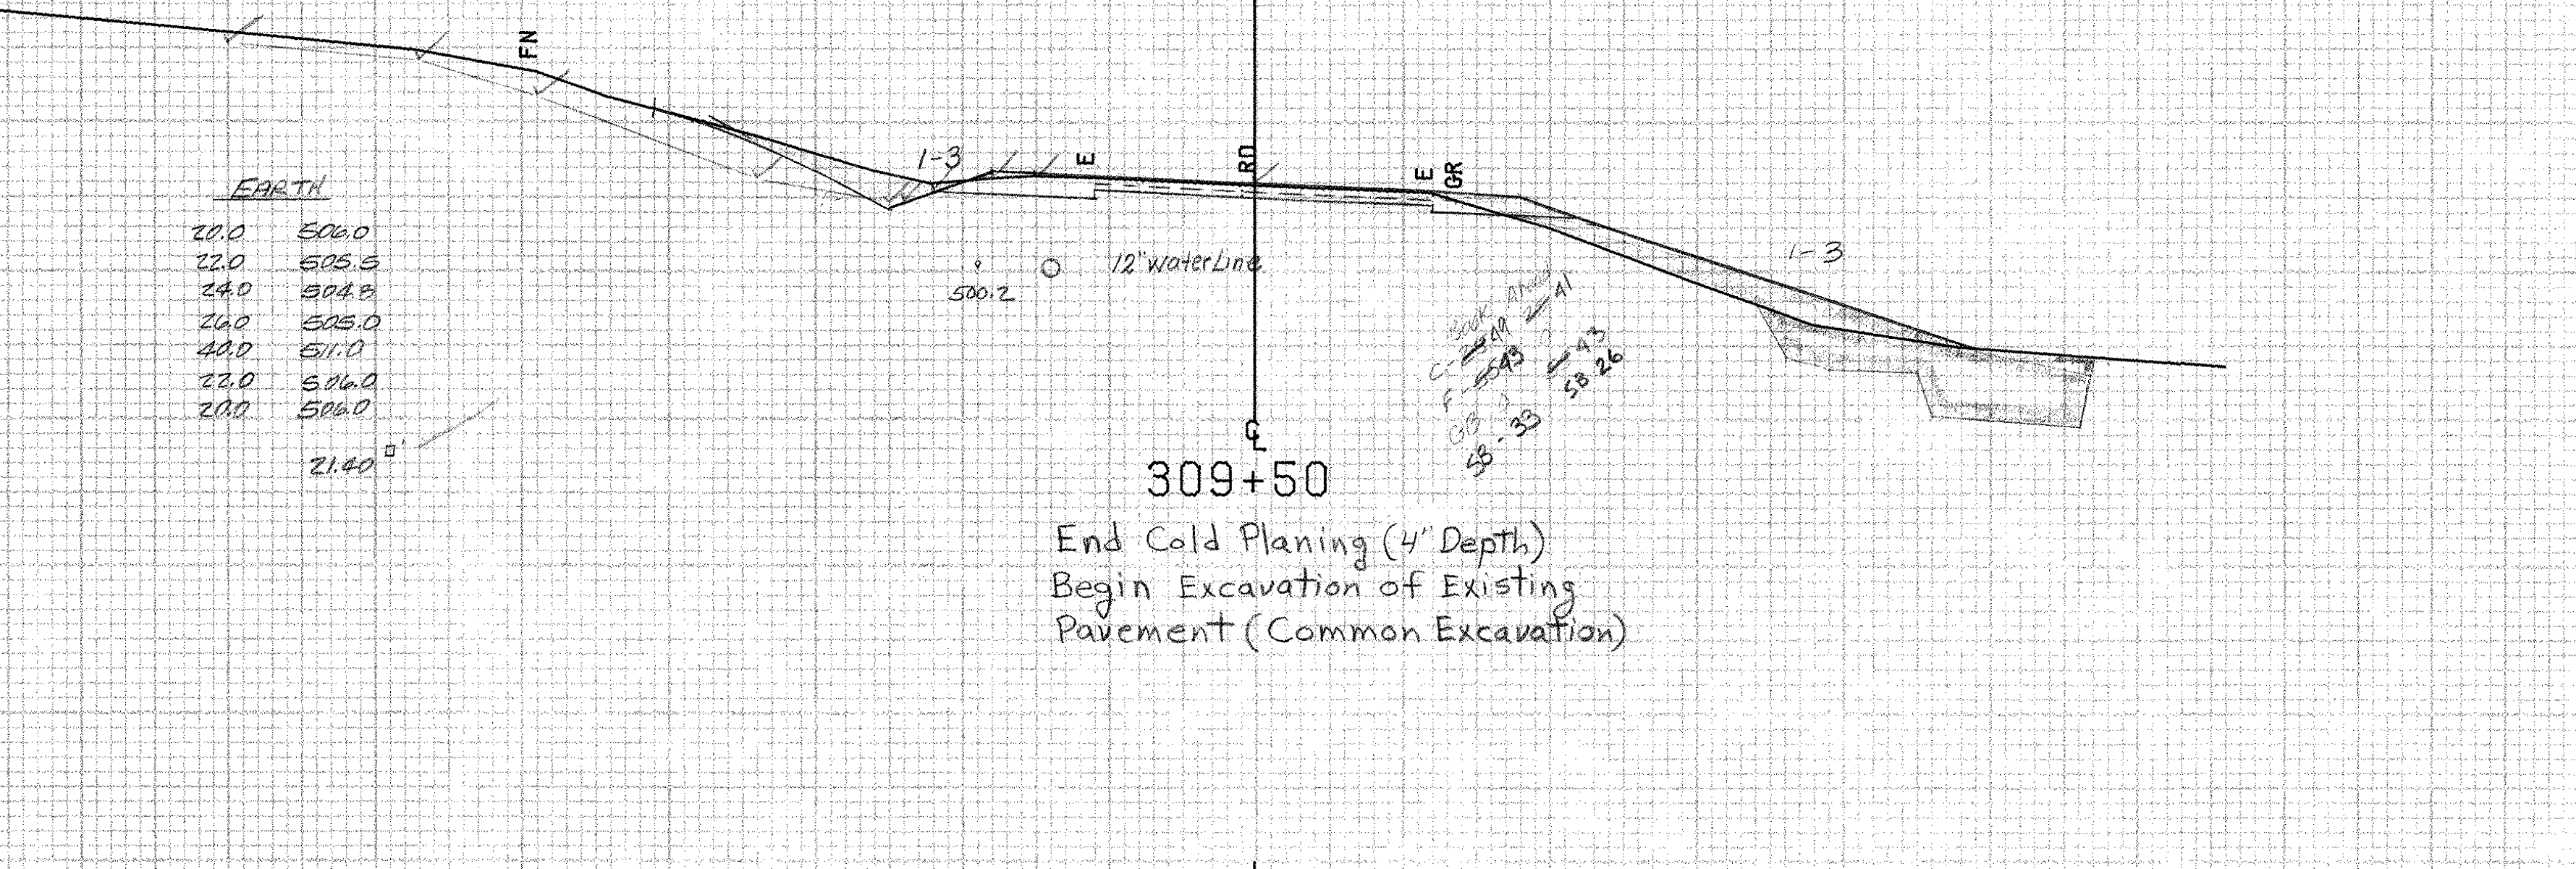

309+50
End Cold Planing (4" Depth)
Begin Excavation of Existing
Pavement (Common Excavation)


CE UC	SF
56	494.4
46	490.1
15	493.1
37	493.3
45	490.1
34	492.9
36	494.1
34	491.9
38	490.5
48	495
57	494.2
56	489.4
57	493
59	487.4

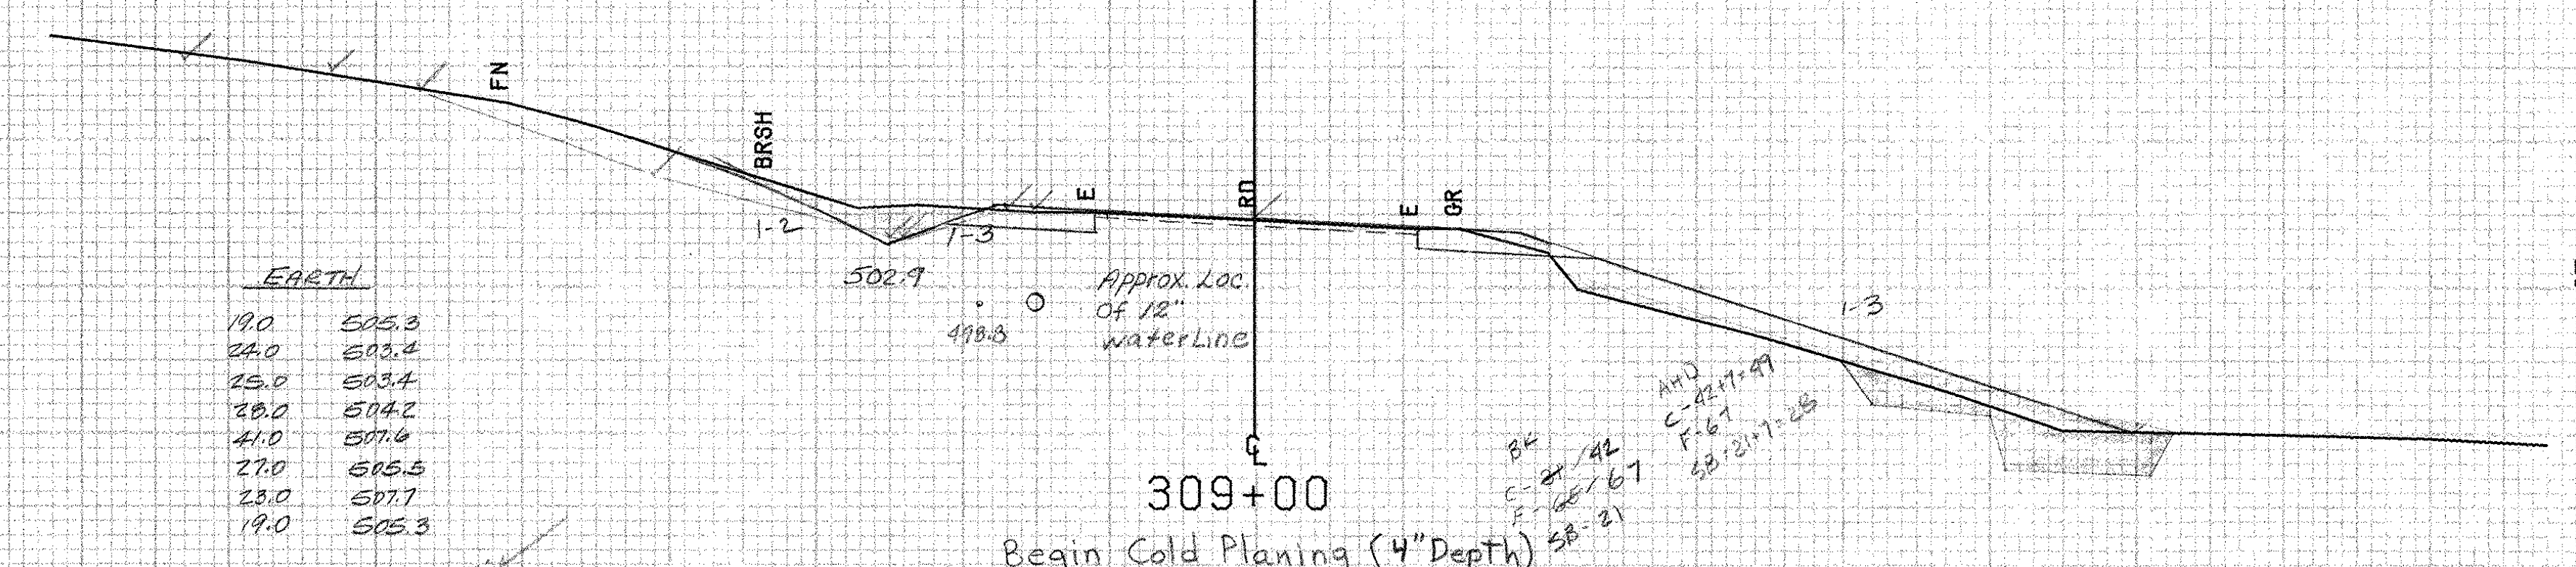

309+00
Begin Cold Planing (4" Depth)

CE UC	SF
61	481.3
51	487.7
50	491.2
42	492
40	495
47	490.1
55	490.4
62	490.1
61	487.3
61	487.3
51	487.7
50	491.2
42	492
40	495
34	494.9
22	500
21	501
25	499.9
26	490.3
58	493
60	490.3
60	491.1
61	487.3

BRIDPORT MM 5.68 ~ MM 6.10

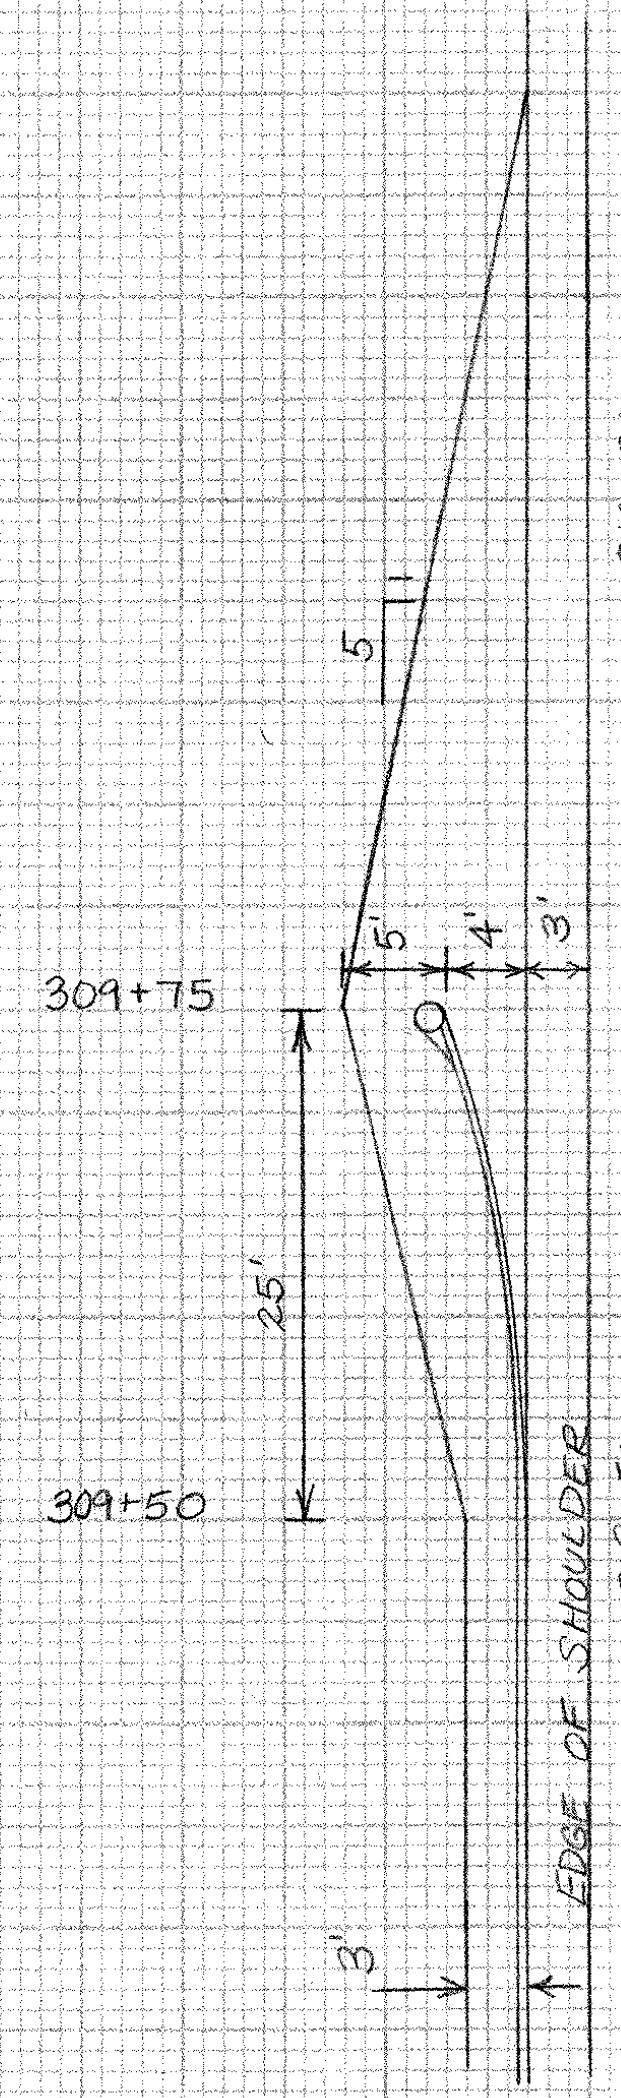

STEEL BEAM GUARD RAIL DETAIL

Scale:
10'
10'

SCALE 10 FEET