

COMMON - ROADWAY

0	512.2
12	511.8
18	511.0
20	509.0
25	507.6
-22	511.3
-22	511.0
-15	512.3
0	512.2

107.50' / 2 = 53.75' L+R

EARTH

23.0	511.3
25.0	511.2
26.5	511.1
36.0	512.9
26.0	512.3
23.0	511.3

COMMON - ROADWAY


0	511.5
14	509.8
17	509.3
19	507.3
23	506.5
22.5	509.0
-22.5	509.6
-20	509.6
-17	510.7
-9	511.0
0	511.5

118.20' / 2 = 59.10' L+R


COMMON - ROADWAY

0	509.0
14	508
16	507.1
17	505.5
19	505.0
22	507.0
-22	507.6
-20	508.1
-19	508.1
-11	509.3
0	509.0


98.85' / 2 = 49.42' L+R

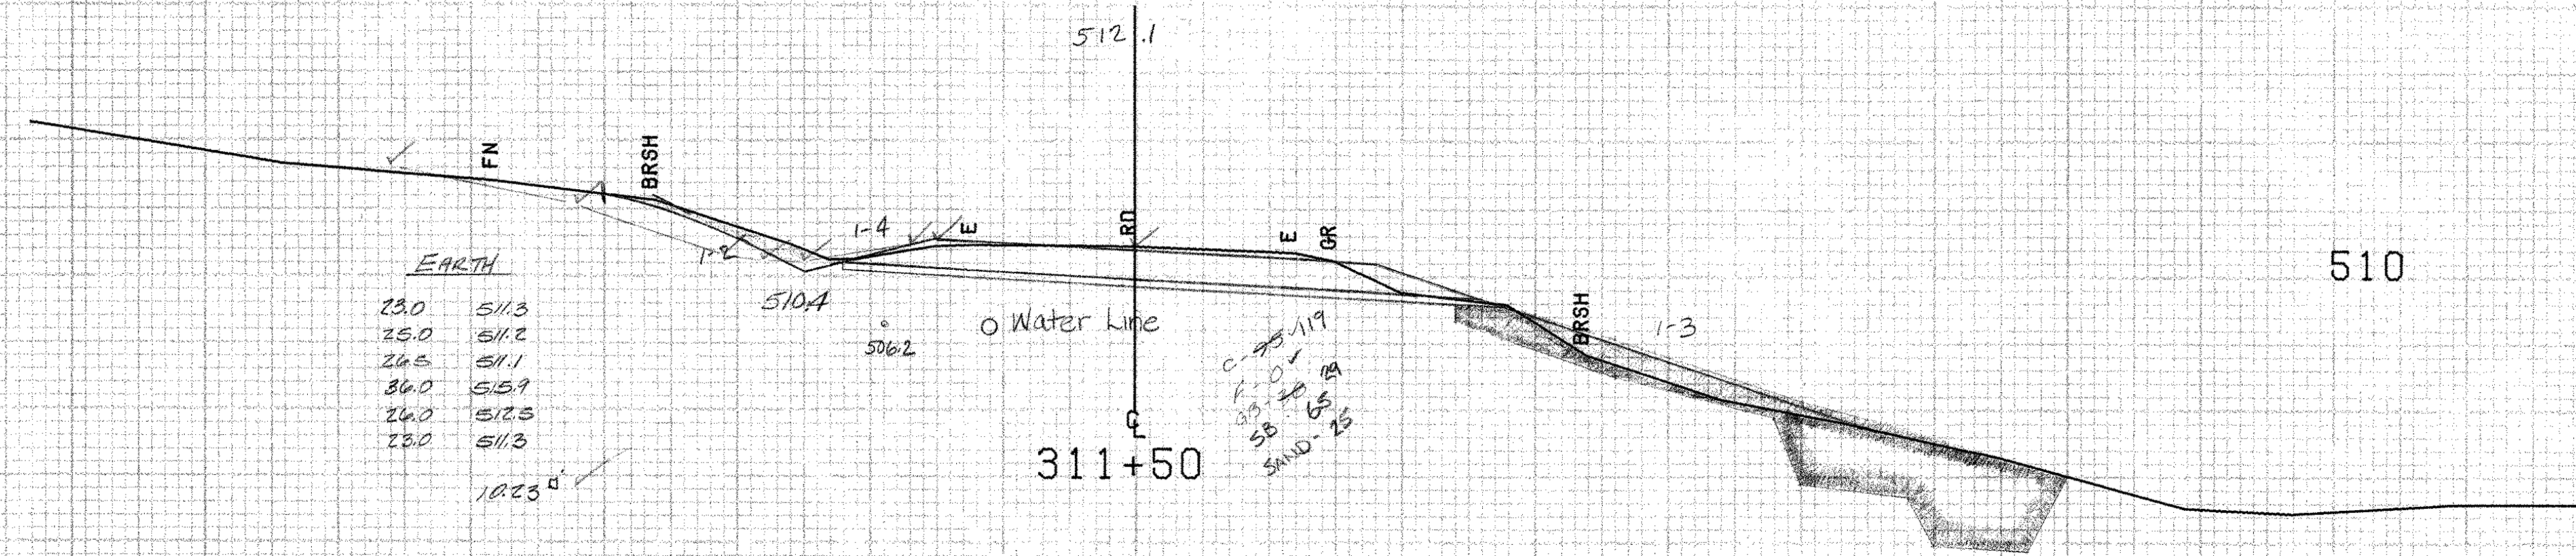

CE UC	SF
67	489.4
60	489.7
58	493.4
50	494.5
48	499.4
36	502.3
24	506.7
24	507.8
28	508
34	504.2
44	500.9
53	499.2
65	490.5
70	495
67	489.4

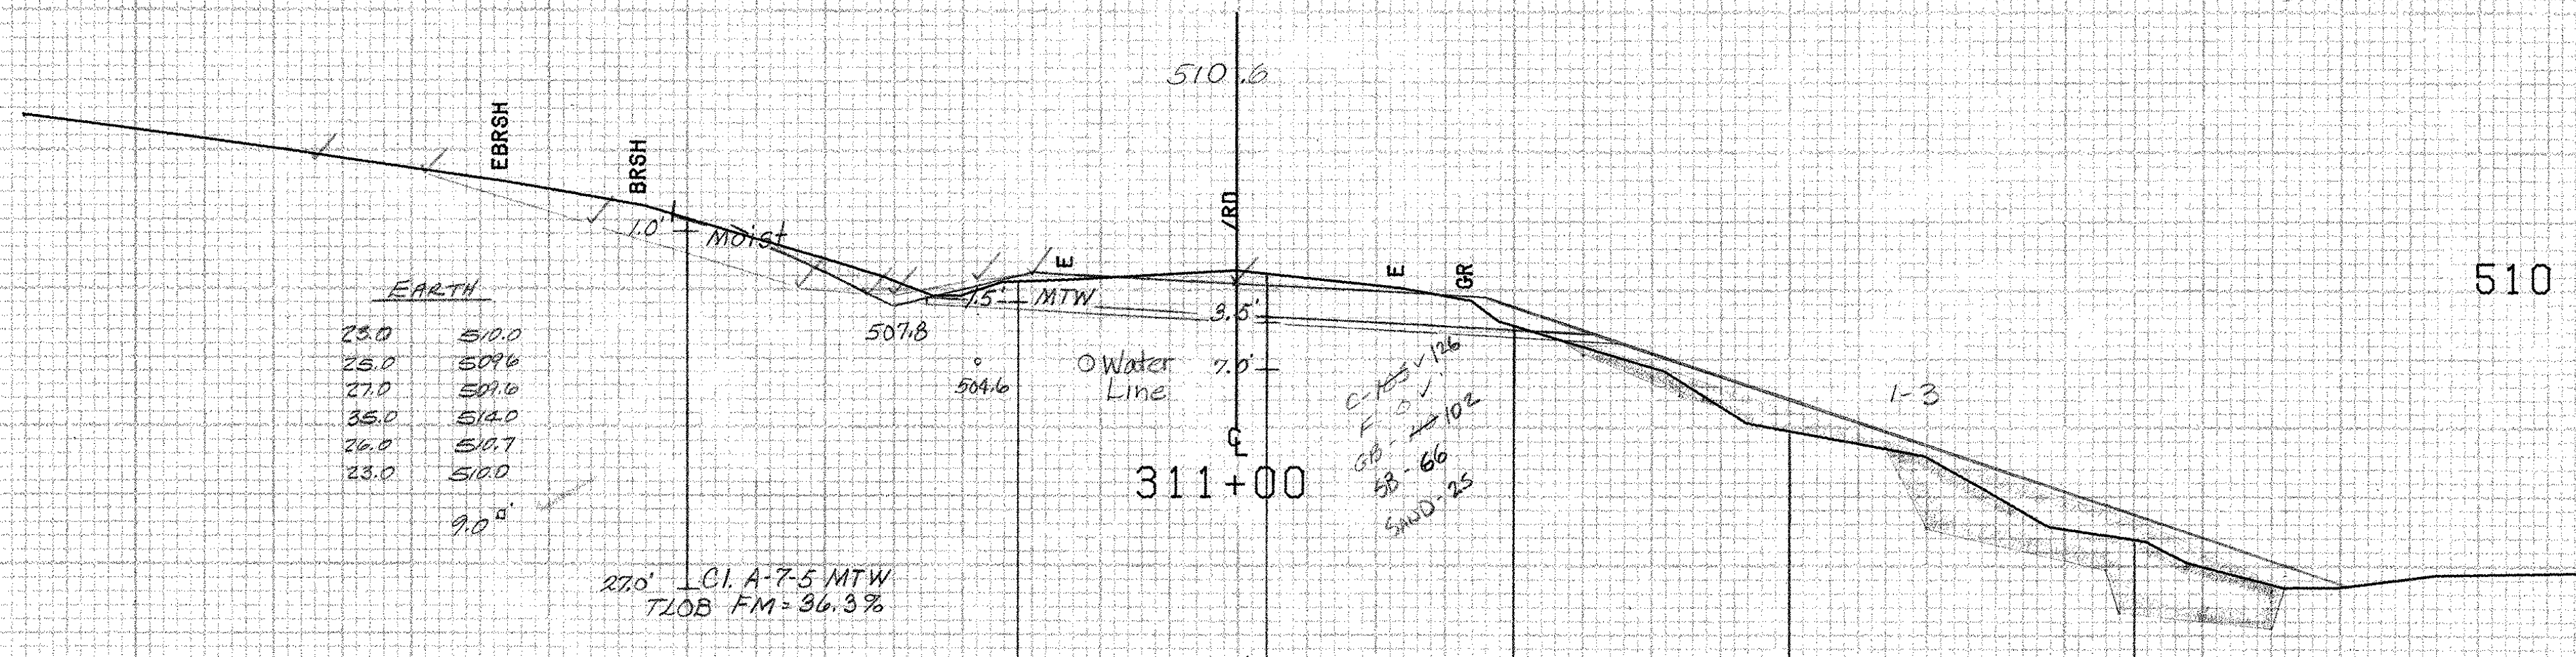

CE UC	SF
75	485.4
64	486.4
63	484.8
50	482.7
47	485.5
50	498
59	492.9
60	491.6
61	490.5
70	488.5
75	485.4
35	501.6
30	503.0
39	501.5
25	505.2
24	500.2
31	504.2
35	501.6

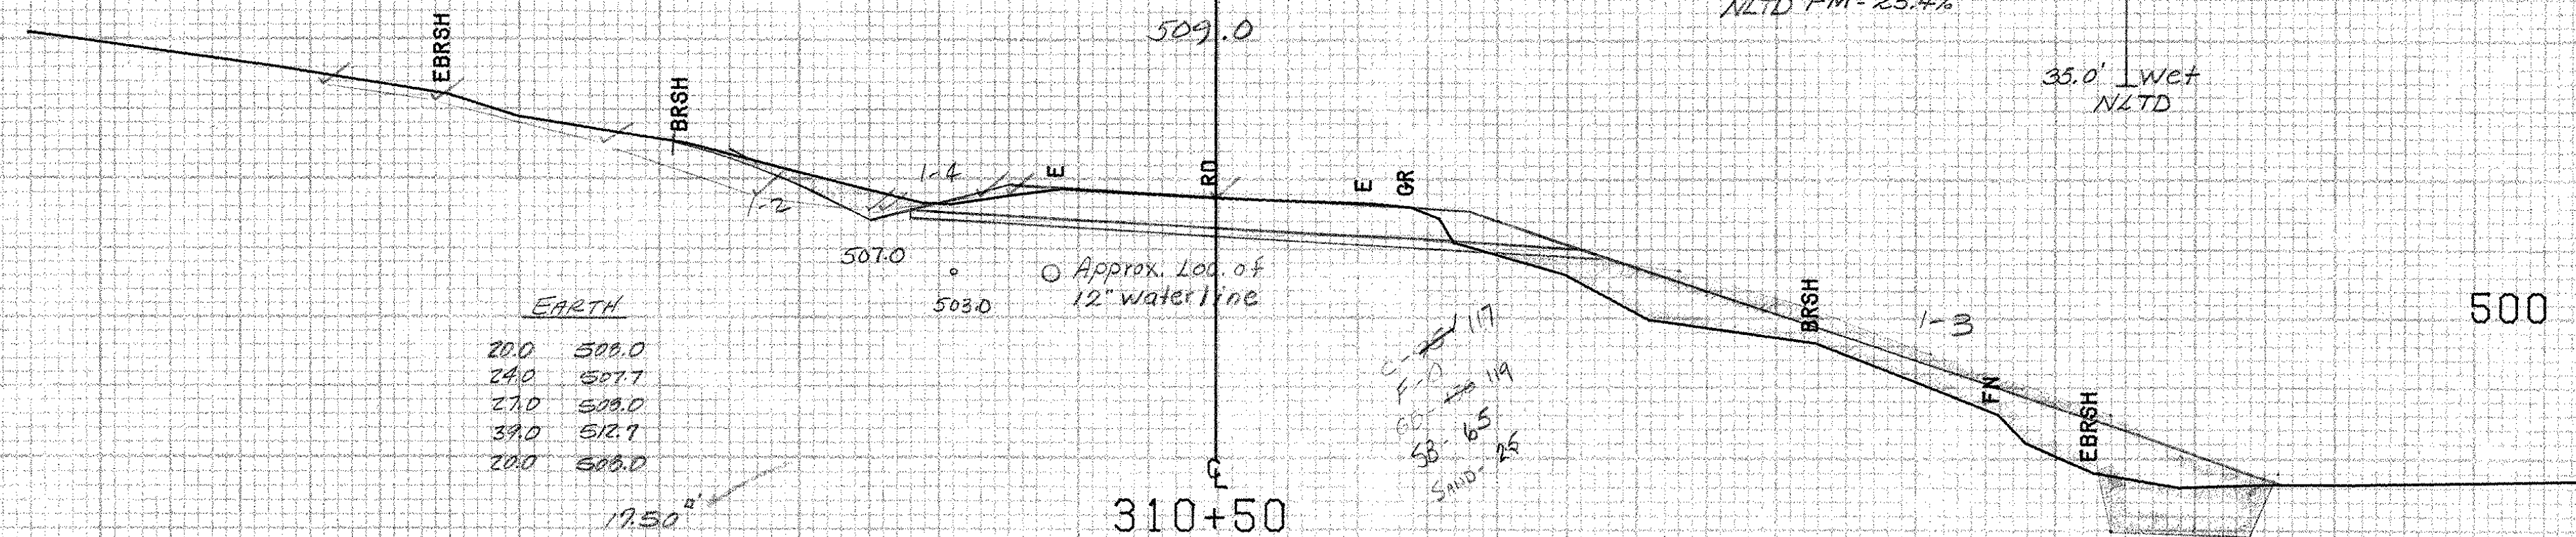

CE UC	SF
74	484.6
64	485.2
63	484.0
67	485.1
70	488.5
74	484.6
74	484.6
64	485.2
63	484
56	492.2
45	493.3
31	500
25	508.5
20	504.6
28	504.4
33	505.5
42	501
51	498.5
64	495

BRIDPORT MM 5.68 ~ MM 6.10 SF 152.35

Begin Full Depth Subbase Repair Area
End 50' Transition

SCALE 1" = 10 FEET