



DETOUR

-22	527.0
-24	527.4
-40	527.0
-51	526.9
-52	529.3
-75	529.1
-77	527.0

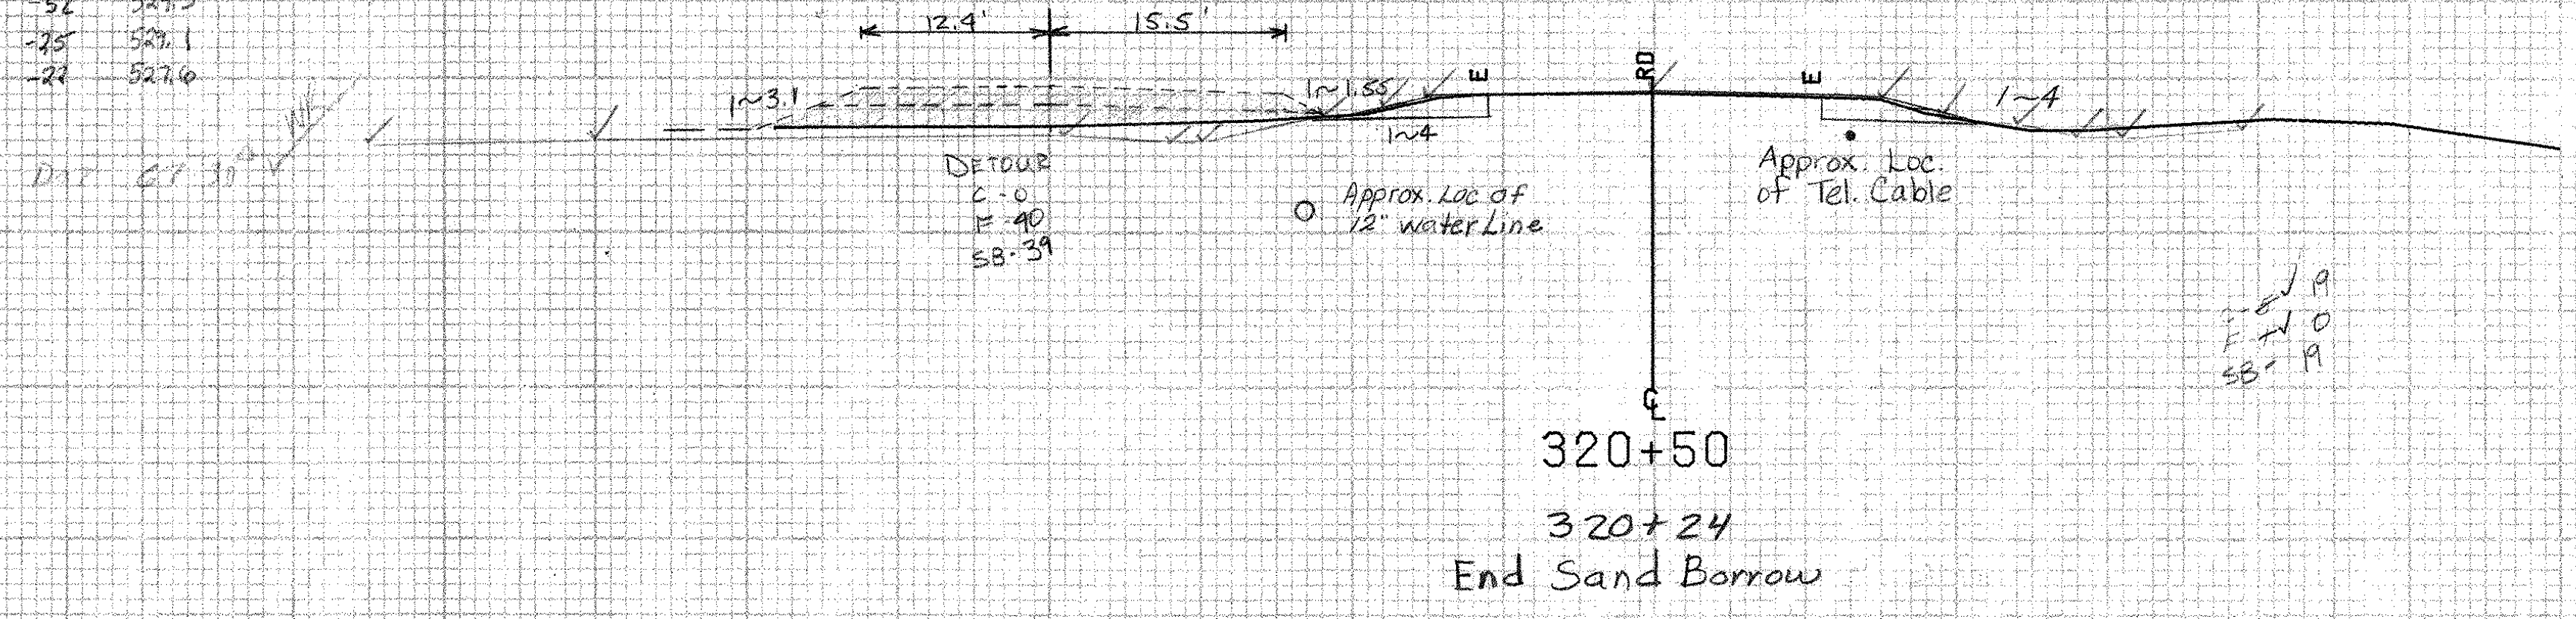


520

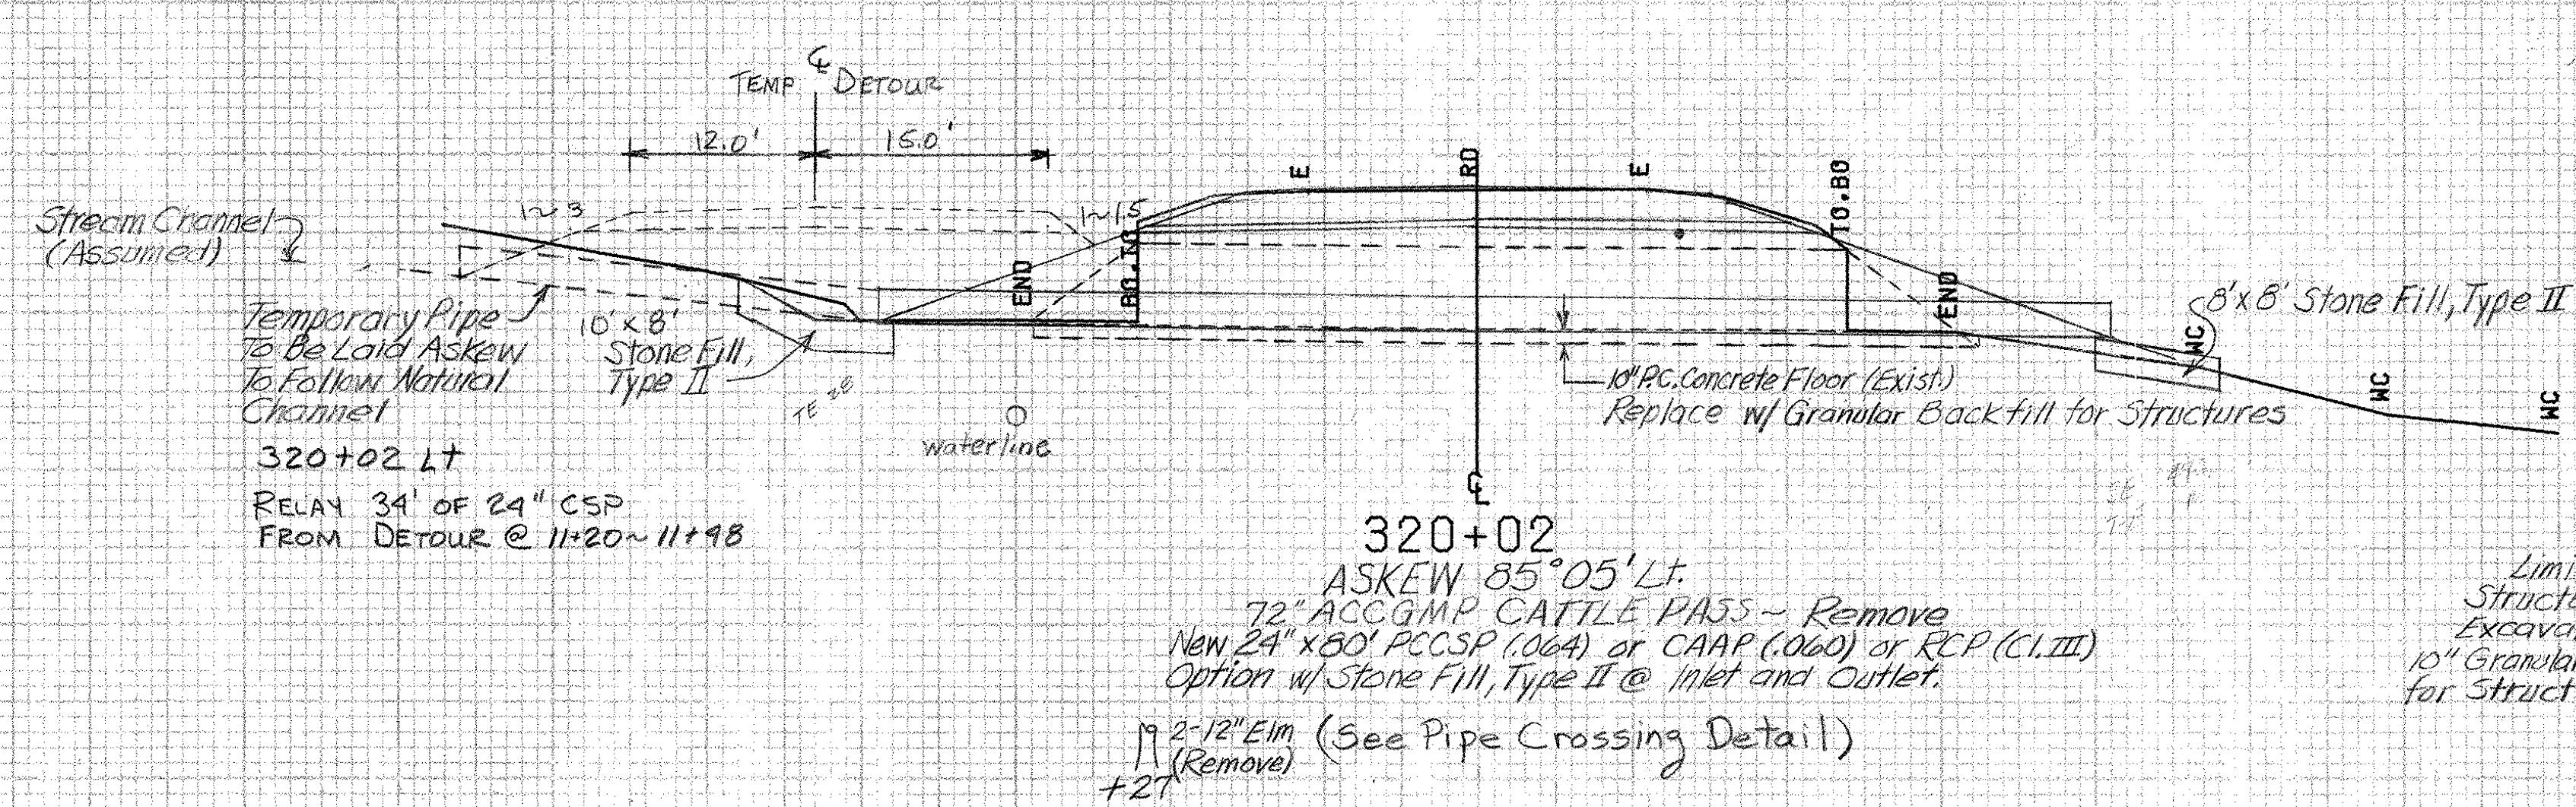


520

DETOUR

-26	525
-36	523
-40	521.1
-46	527.2
-50	524.0
-58	525.1
-28	525

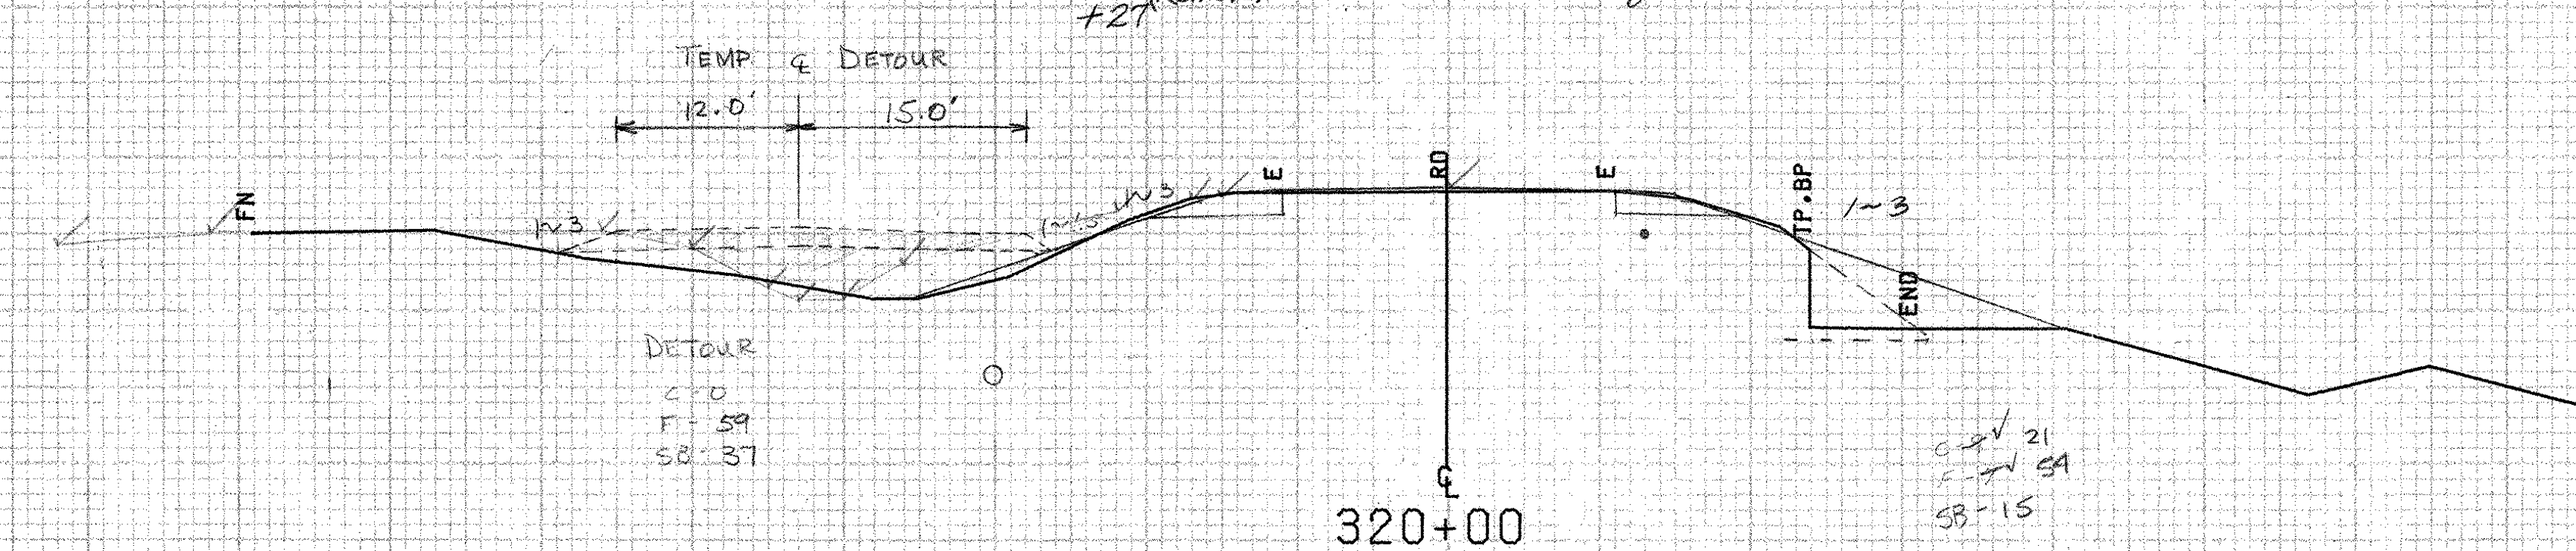


520

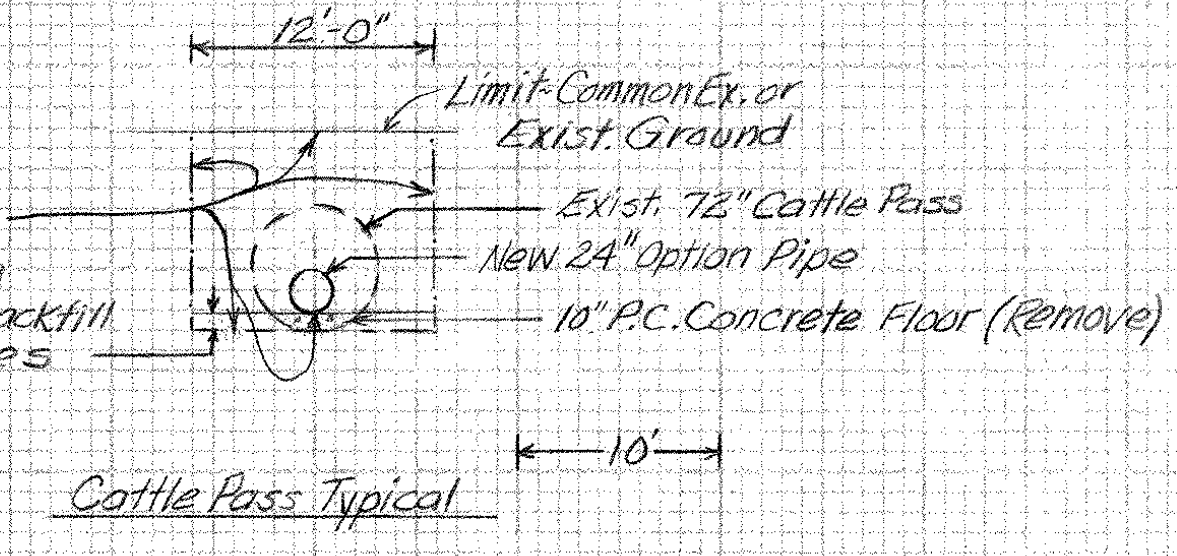


DETOUR

-23	526.8
-26	525.1
-35	525.3
-50	529.9
-59	524.5
-52	527
-25	526.9
-23	526.8

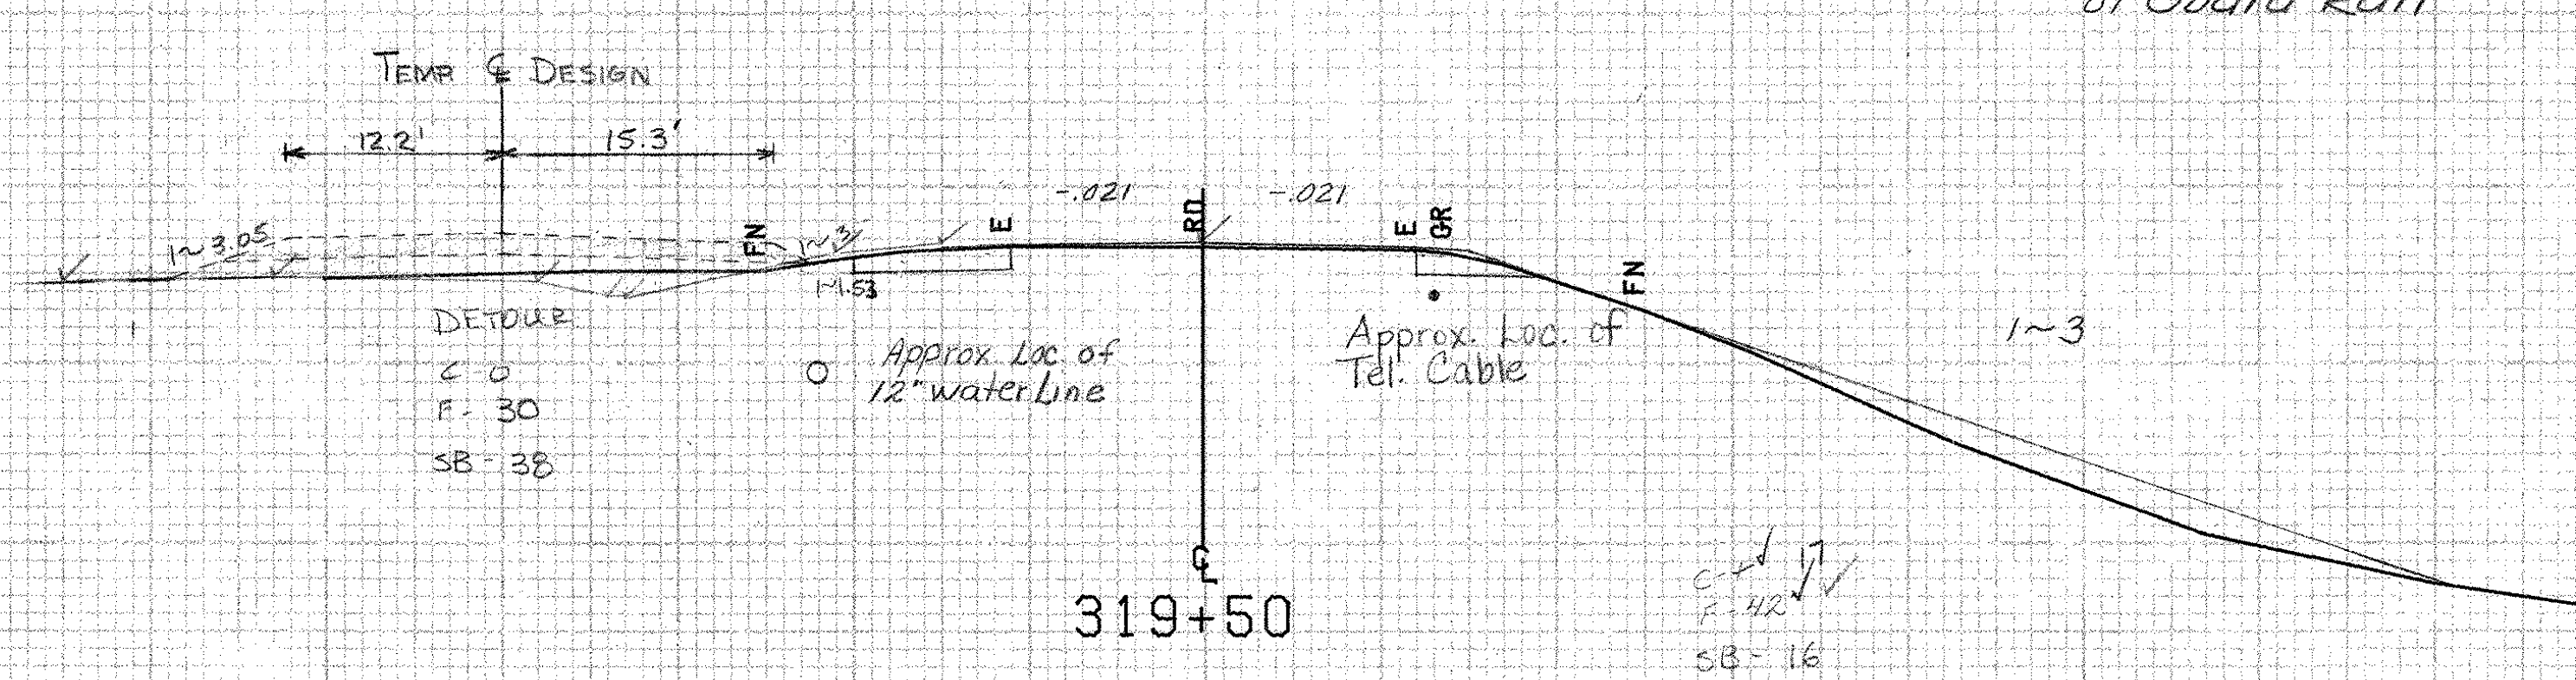

520

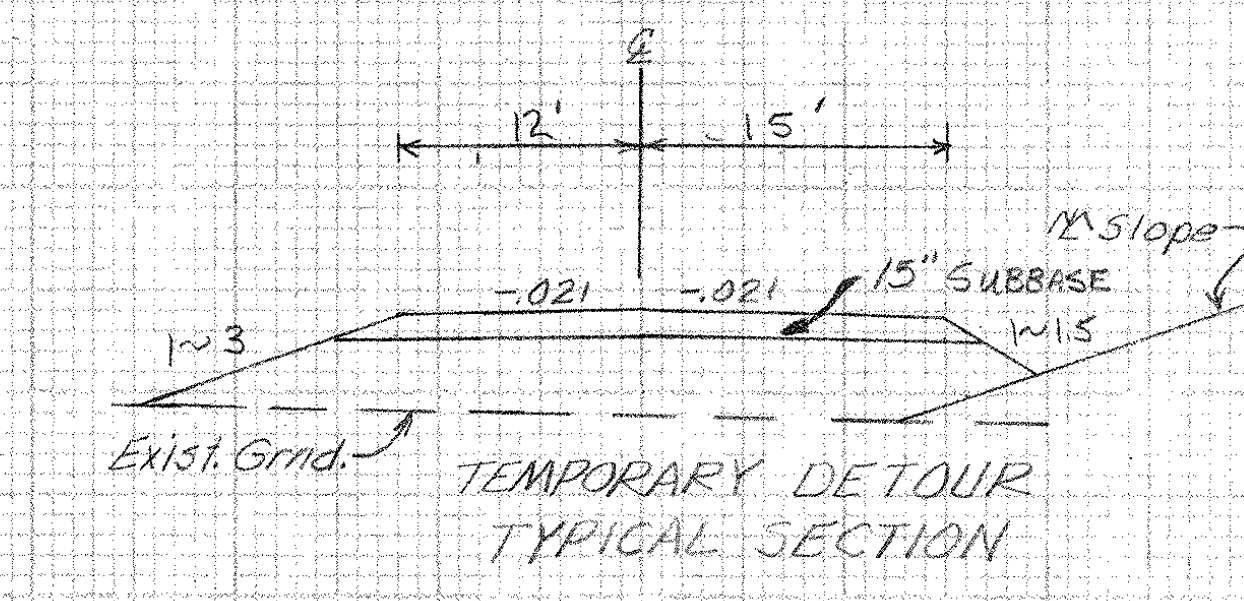

BRIDPORT MM 5.68 ~ MM 6.10

FROM STA. 319+50	TO STA. 320+50
PROJECT NAME SHOREHAM-BRIDPORT-ADDISON	
NO. F017-1(2)	PLOTTED 02/28/84
SURVEYED BY FANTONI	FEBRUARY 84
SHEET 378 OF 400 SHEETS	SHEET 378 OF 477

SCALE 10 FEET