



EARTH	
17.0	501.5
17.0	498.0
34.0	502.5
23.0	501.7
17.0	502.5
20.55	

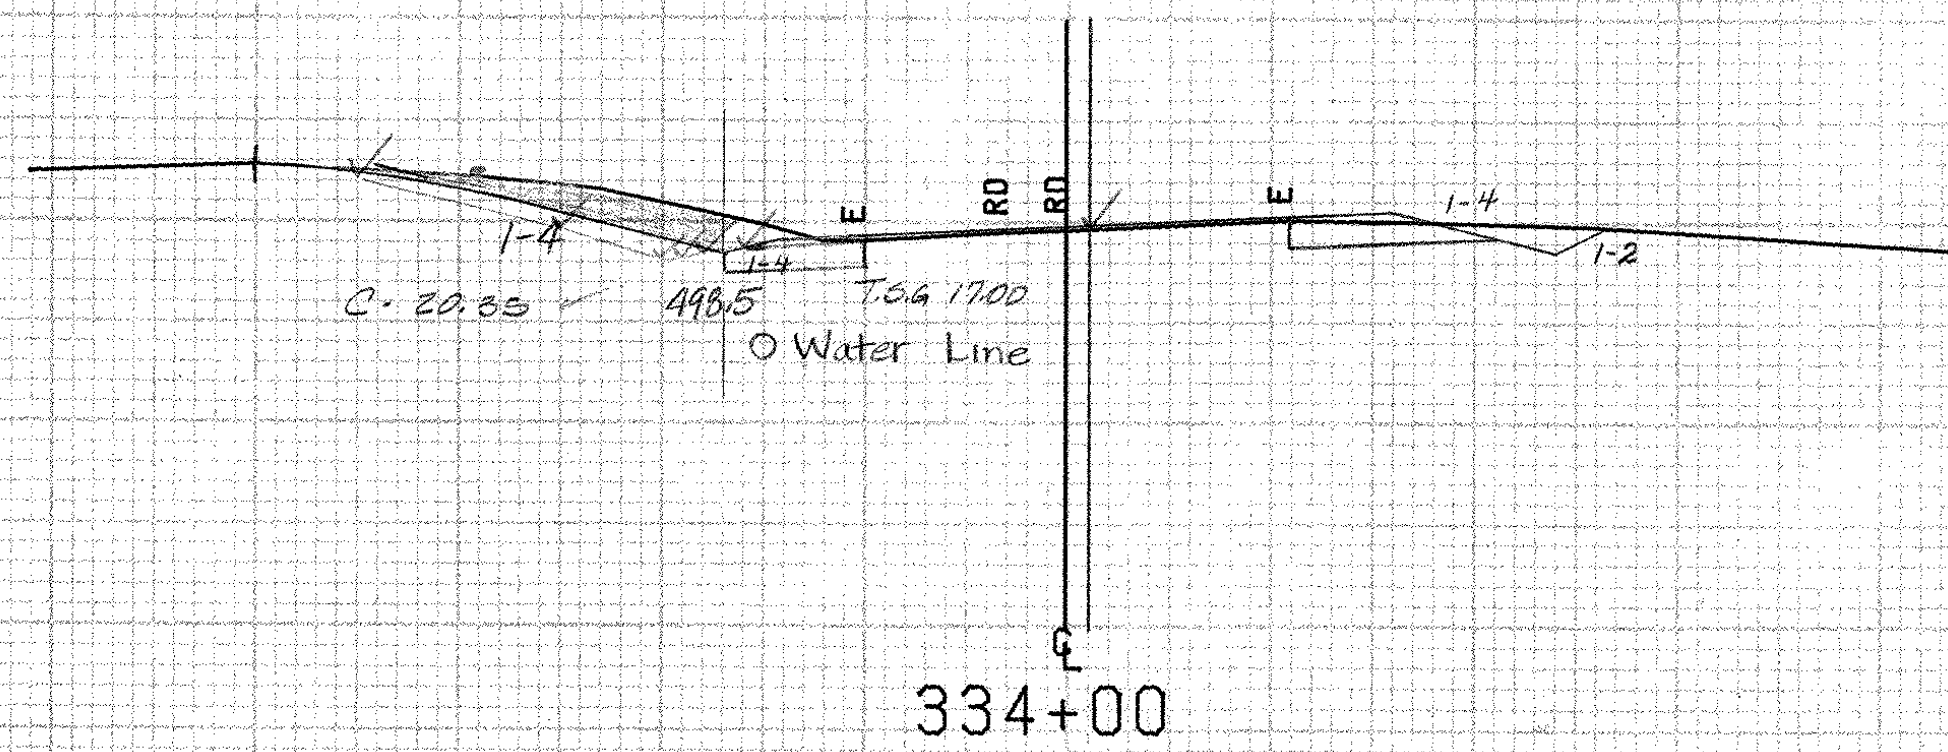


C-21 48.52
F-01
SB-17

333+70 Lt.
Begin Special Ditch w/
Erosion Matting
(Common Excavation)

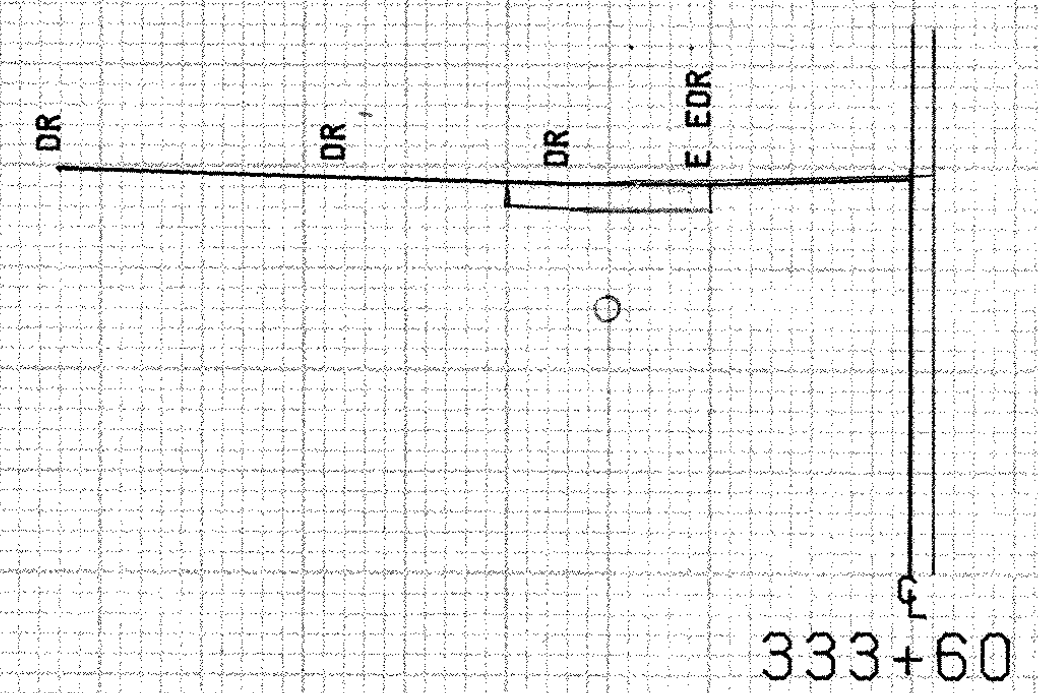

Note: 333+60± Lt.
Gravel Drive will be
graded over w/ topsoil
seeded and mulched
as directed by the Engineer.

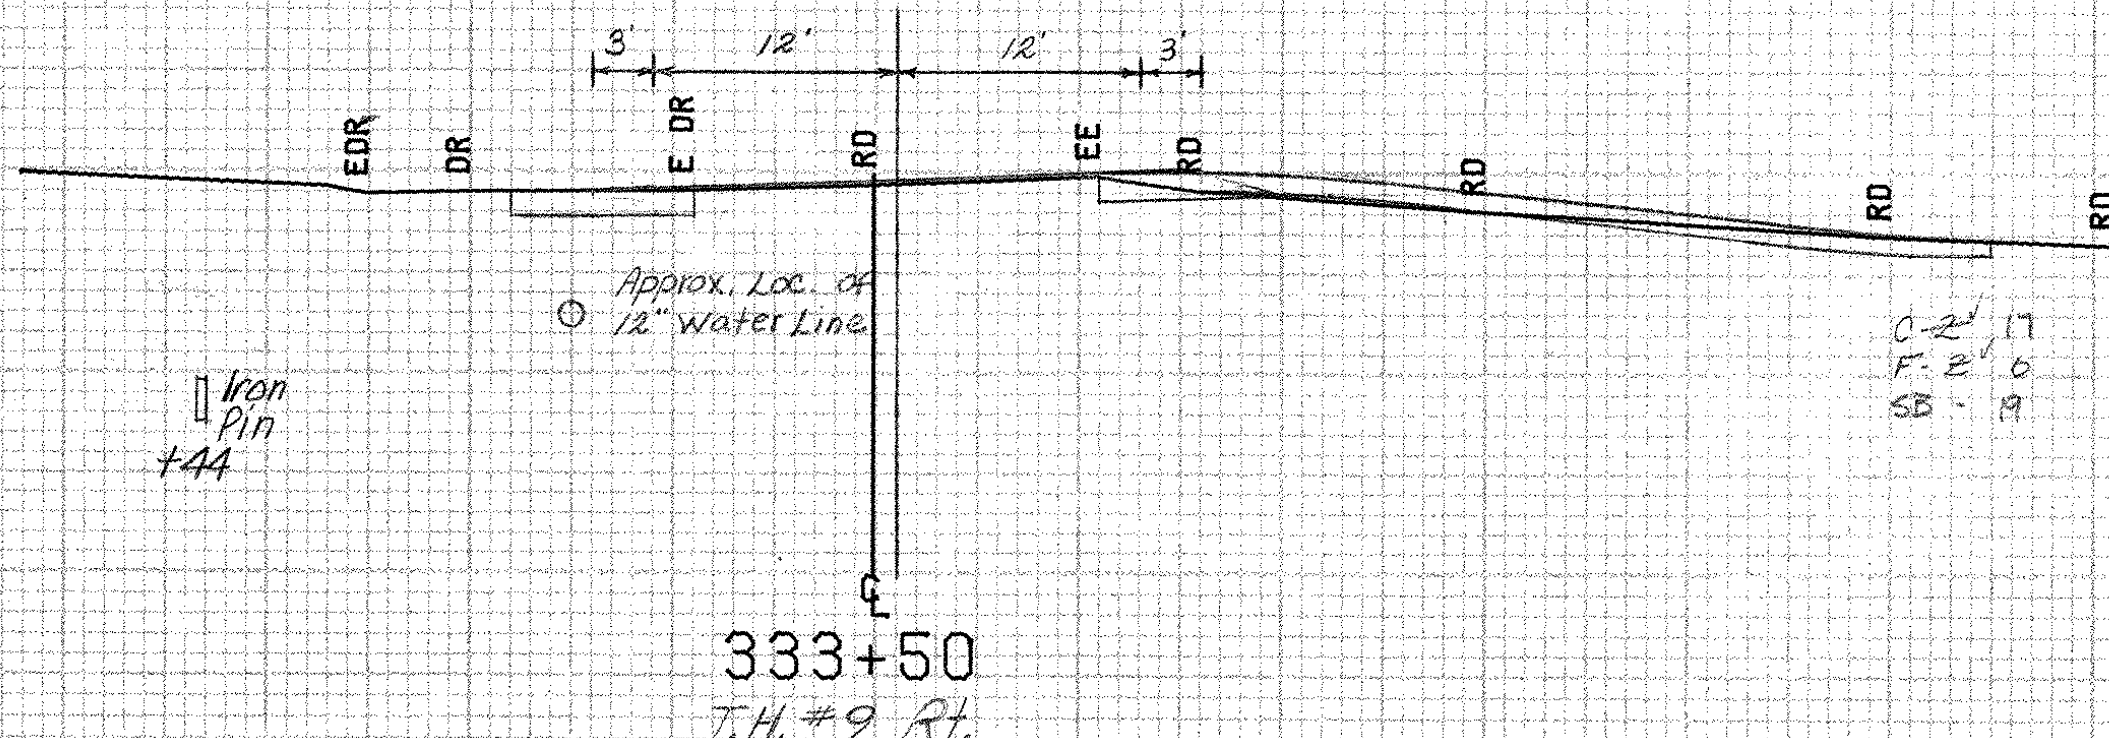

C-21 17
F-21 0
SB-19

Iron Pin
+44

BRIDPORT ~ ADDISON MM 6.30 ~ MM 0.32

FROM STA.	333+50	TO STA.	334+00
PROJECT NAME	SHOREHAM-BRIDPORT-ADDISON		
NO.	F017-1(2)	PLOTTED	02/28/84
SURVEYED BY	FANTONI	FEBRUARY	84
SHEET	380 OF 430 SHEETS	SHEET	380 OF 477

SCALE 1" = 10 FEET

Cut - 1/2" 55.92