

335+00

Section A-A
335+50

335+76 Lt.
Begin Special Ditch (Common Exc.)
w/ Erosion Matting

335+50 Lt.
Construct Drive (14' wide - Gravel)
New 17" x 13" x 50' CSP (.064)

335+16 Lt.
End Special ditch (Common Exc.)
w/ Erosion Matting

490


336+00

335+50

C-13' 40
F-0'
SB-17

490

EARTH	
19.0	500.2
18.0	497.8
41.0	503.0
31.0	502.5
18.0	502.2
34.90 ✓	

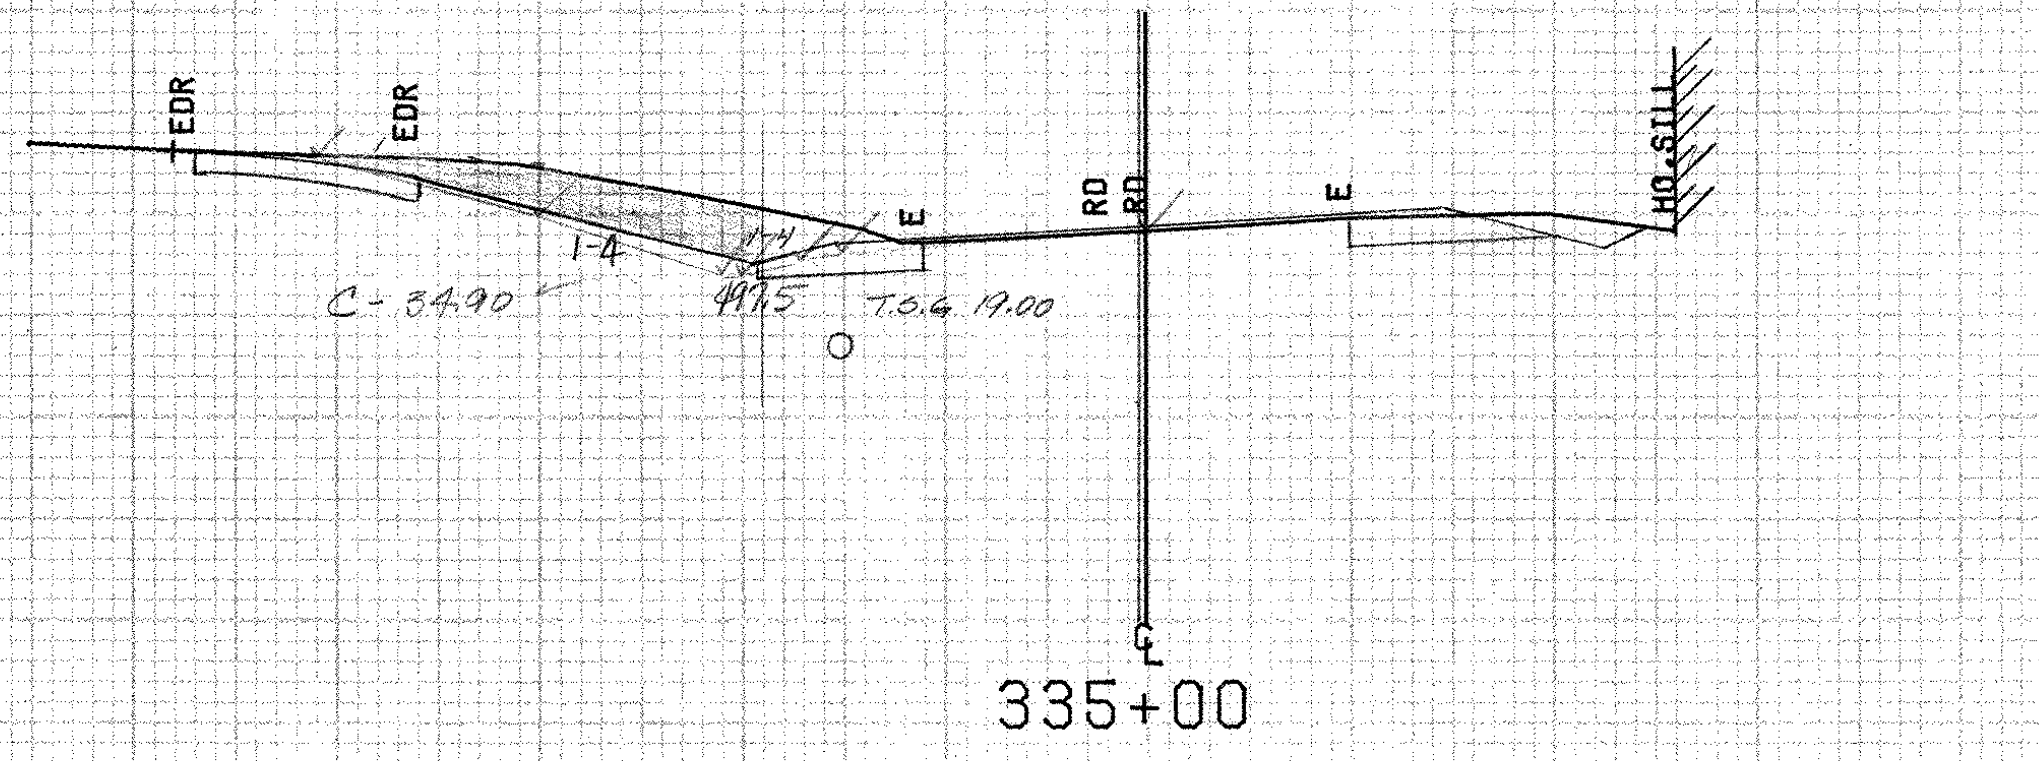


335+00

C-24' 75 SB
F-0'
SB-17

490

EARTH	
18.0	501.0
18.0	498.8
19.0	503.2
28.0	501.4
41.0	503.6
48.0	504.3
34.0	504.1
28.0	503.5
18.0	501.0
58.50 ✓	

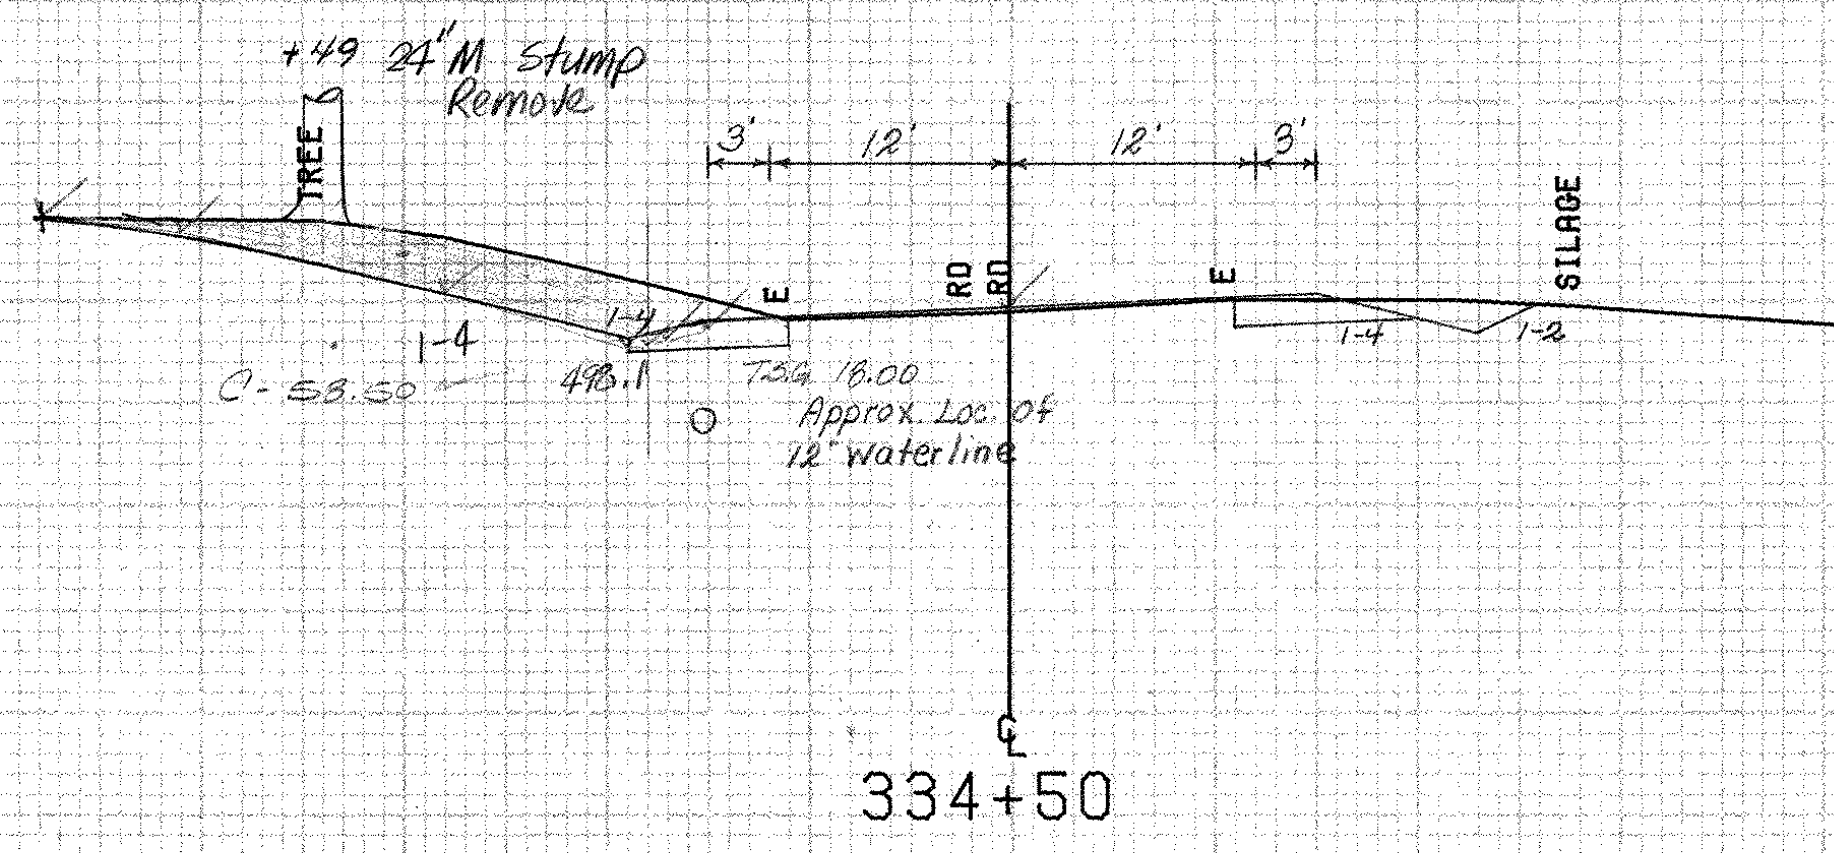

334+50

C-22' 94 93
F-0'
SB-16

490

BRIDPORT ~ ADDISON MM 6.30 ~ MM 0.32

FROM STA.	334+50	TO STA.	335+50
PROJECT NAME	SHOREHAM-BRIDPORT-ADDISON		
NO.	F017-1(2)	PLOTTED	02/28/84
SURVEYED BY	FANTONI	FEBRUARY 84	
SHEET	381 OF 420	SHEETS	SHEET 381 OF 477

SCALE 10 FEET

scale ✓ 1/2" = 10'