
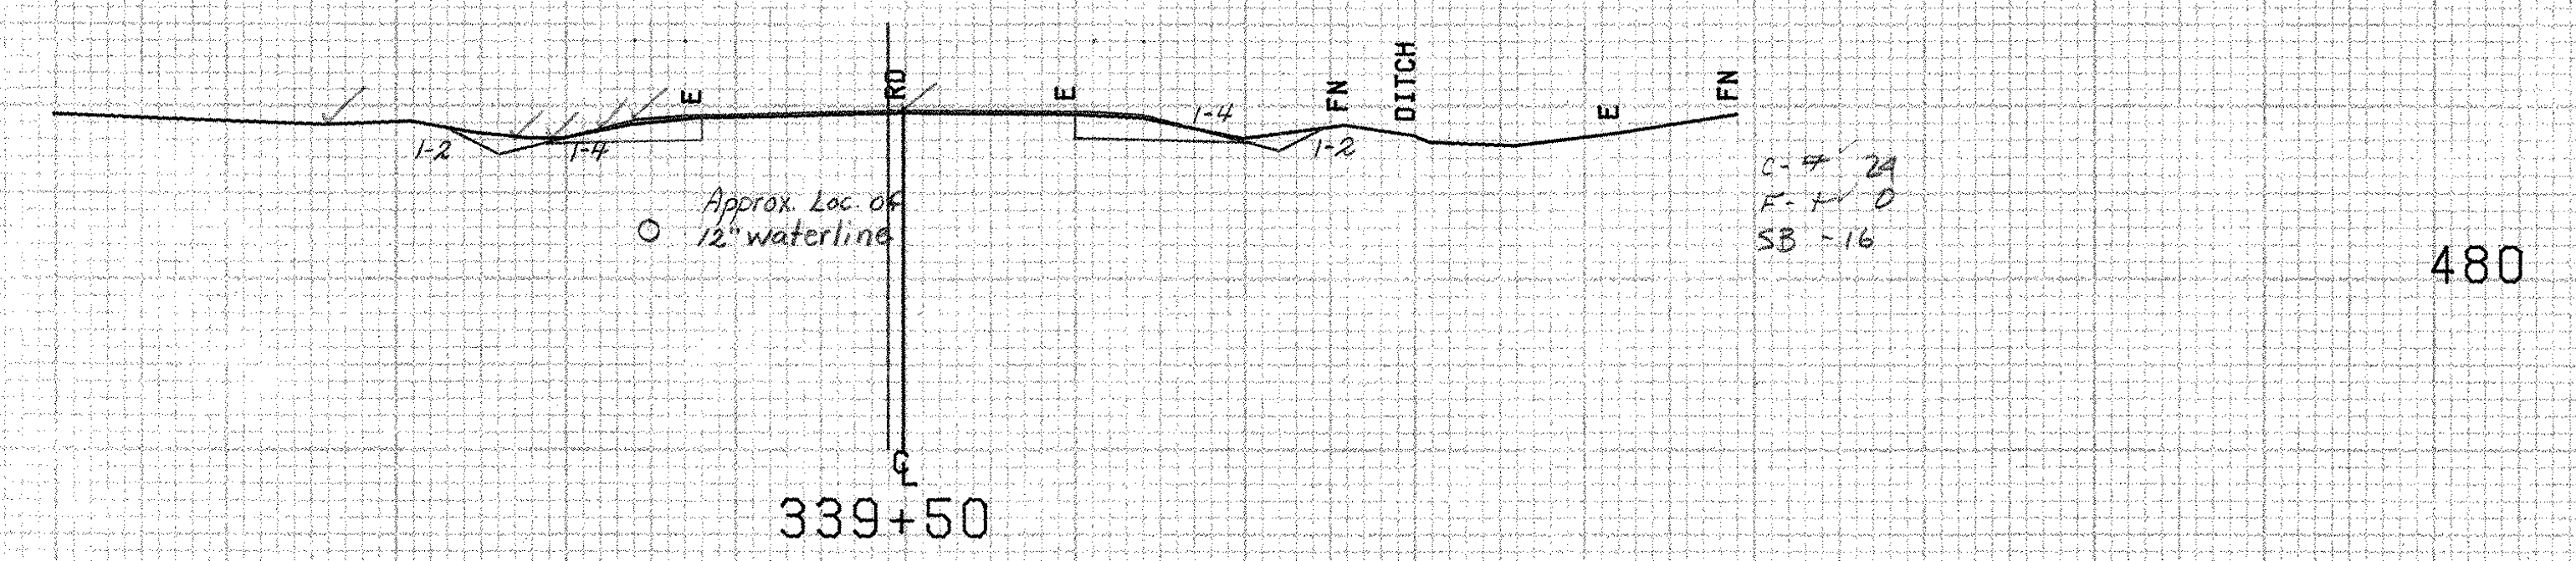
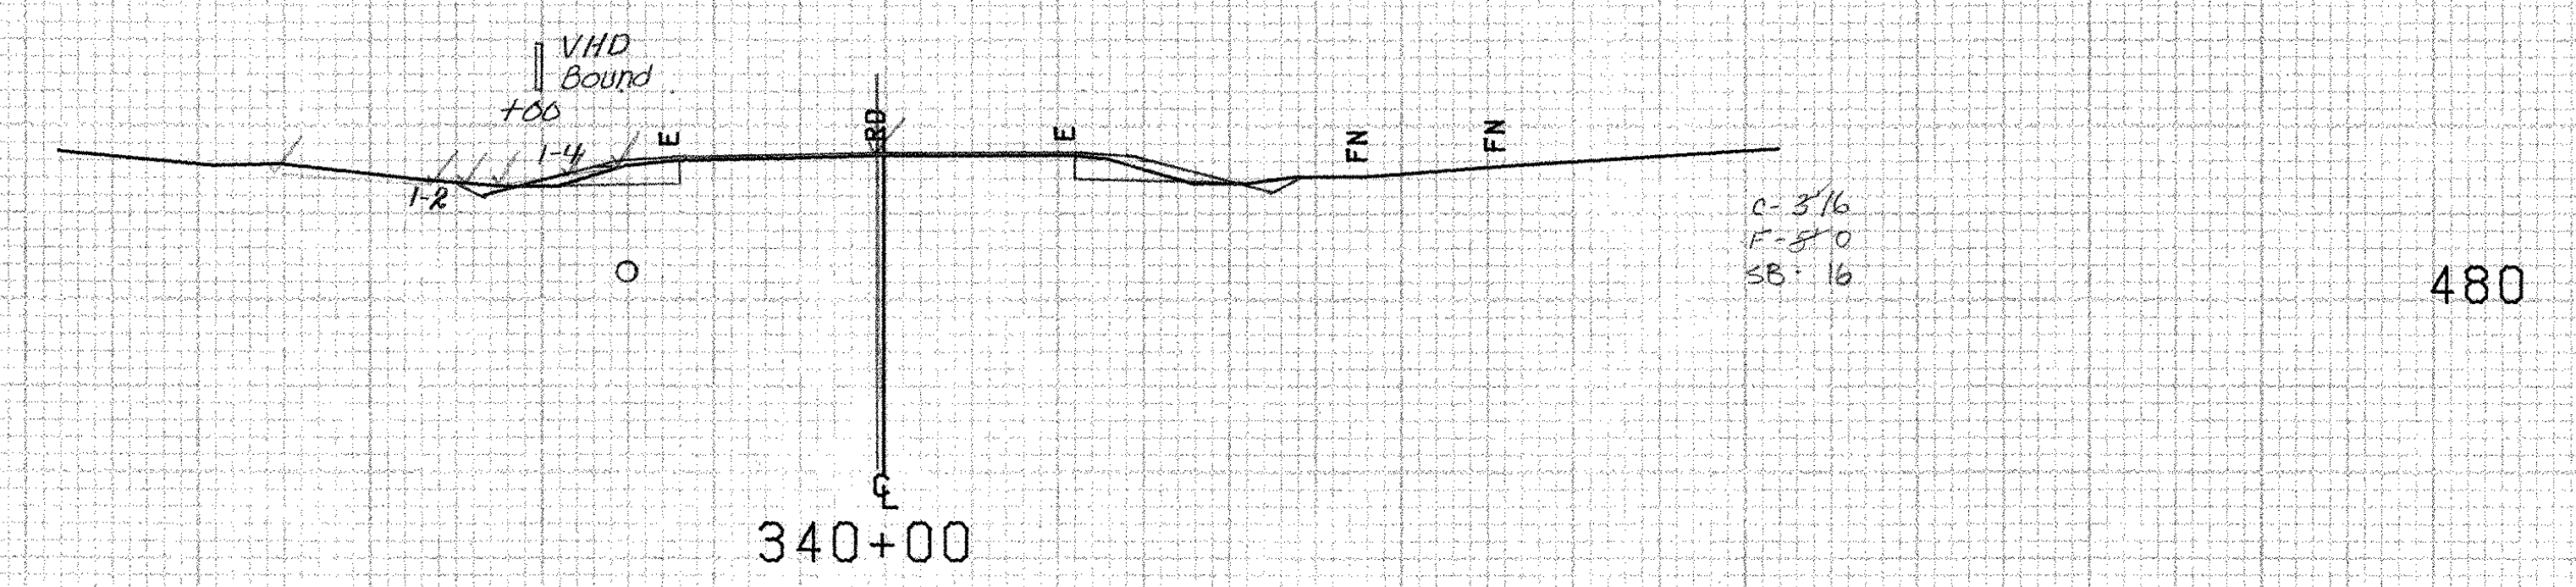
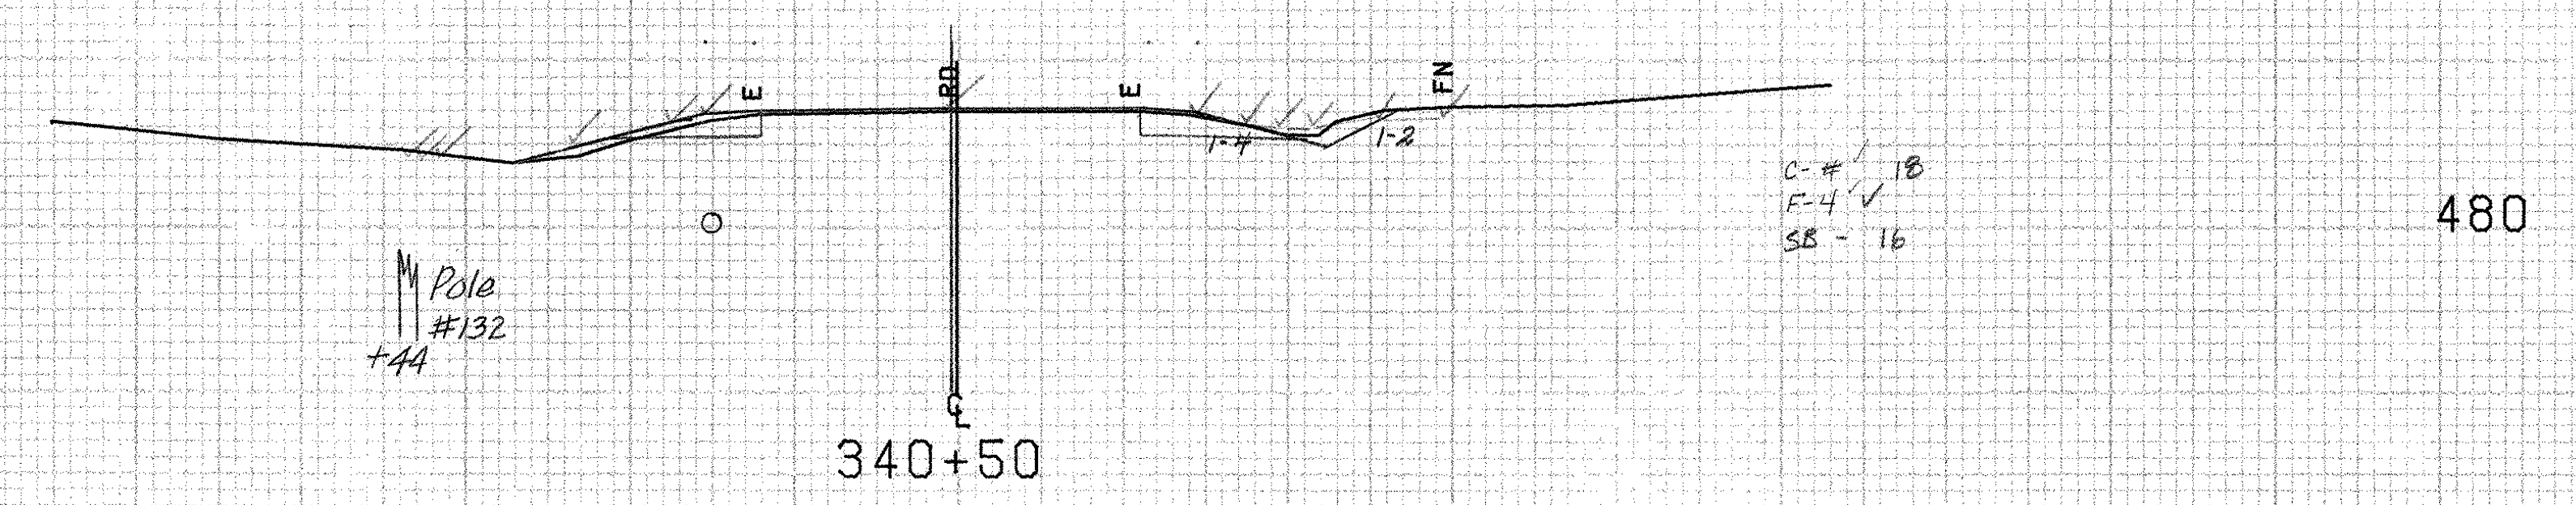


341+00 Rt
Begin Special ditch w/ Erosion Matting

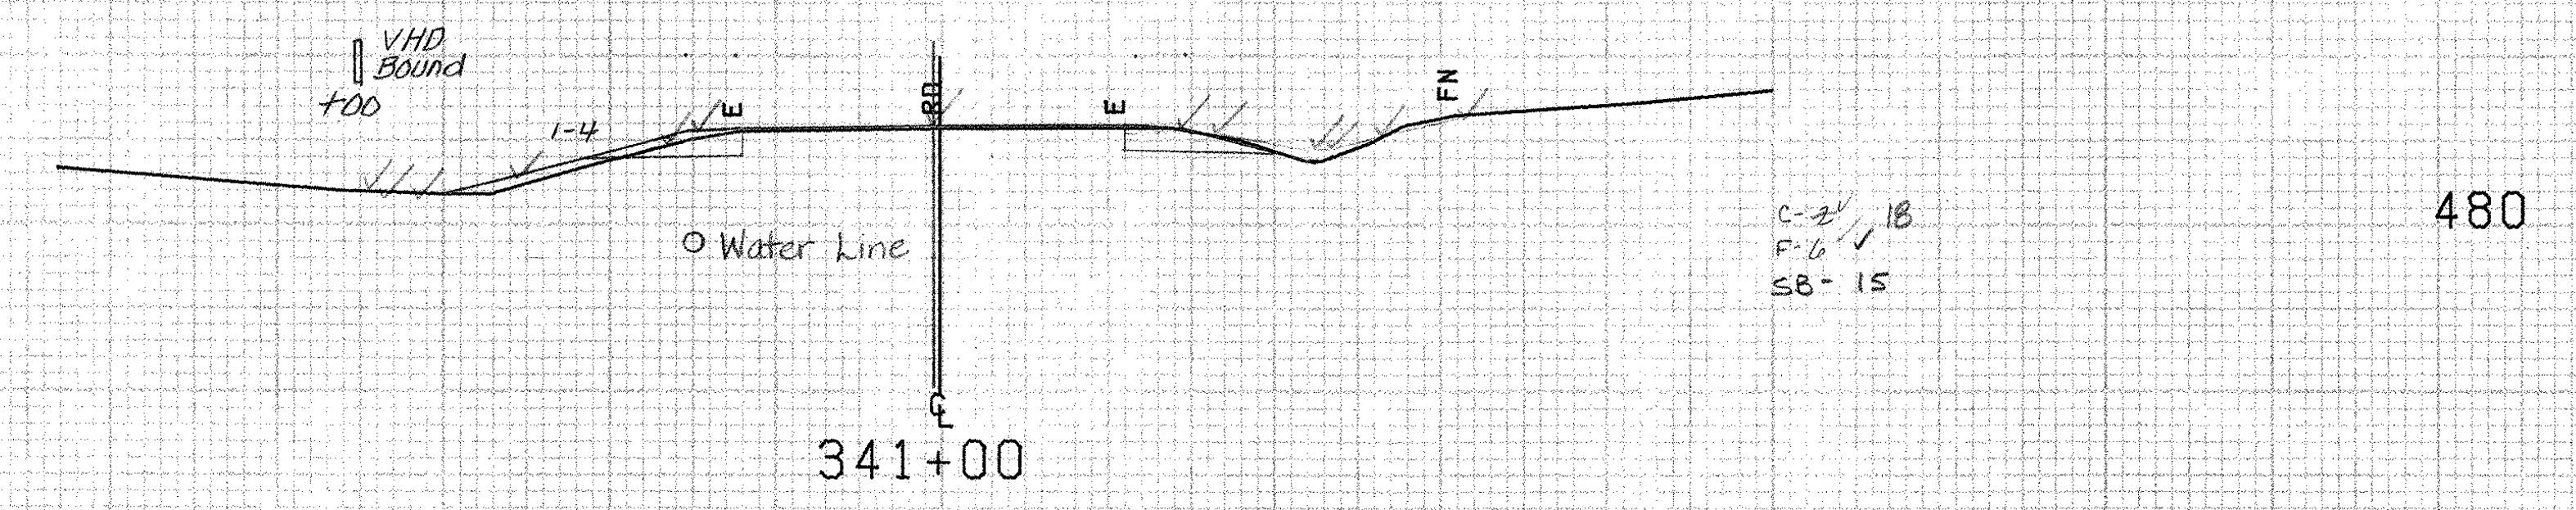

BRIDPORT ~ ADDISON MM 6.30 ~ MM 0.32

FROM STA.	339+50	TO STA.	341+00
PROJECT NAME	SHOREHAM-BRIDPORT-ADDISON		
NO.	F017-1(2)	PLOTTED	02/28/84
SURVEYED BY	FANTONI	FEBRUARY 84	
SHEET	334 OF 420 SHEETS	SHEET	384 OF 477

SCALE 1" = 10 FEET