


347+60~347+85 Rt.  
Breakaway Cable Terminal

347+60 Rt.  
End Steel Beam Guard Rail

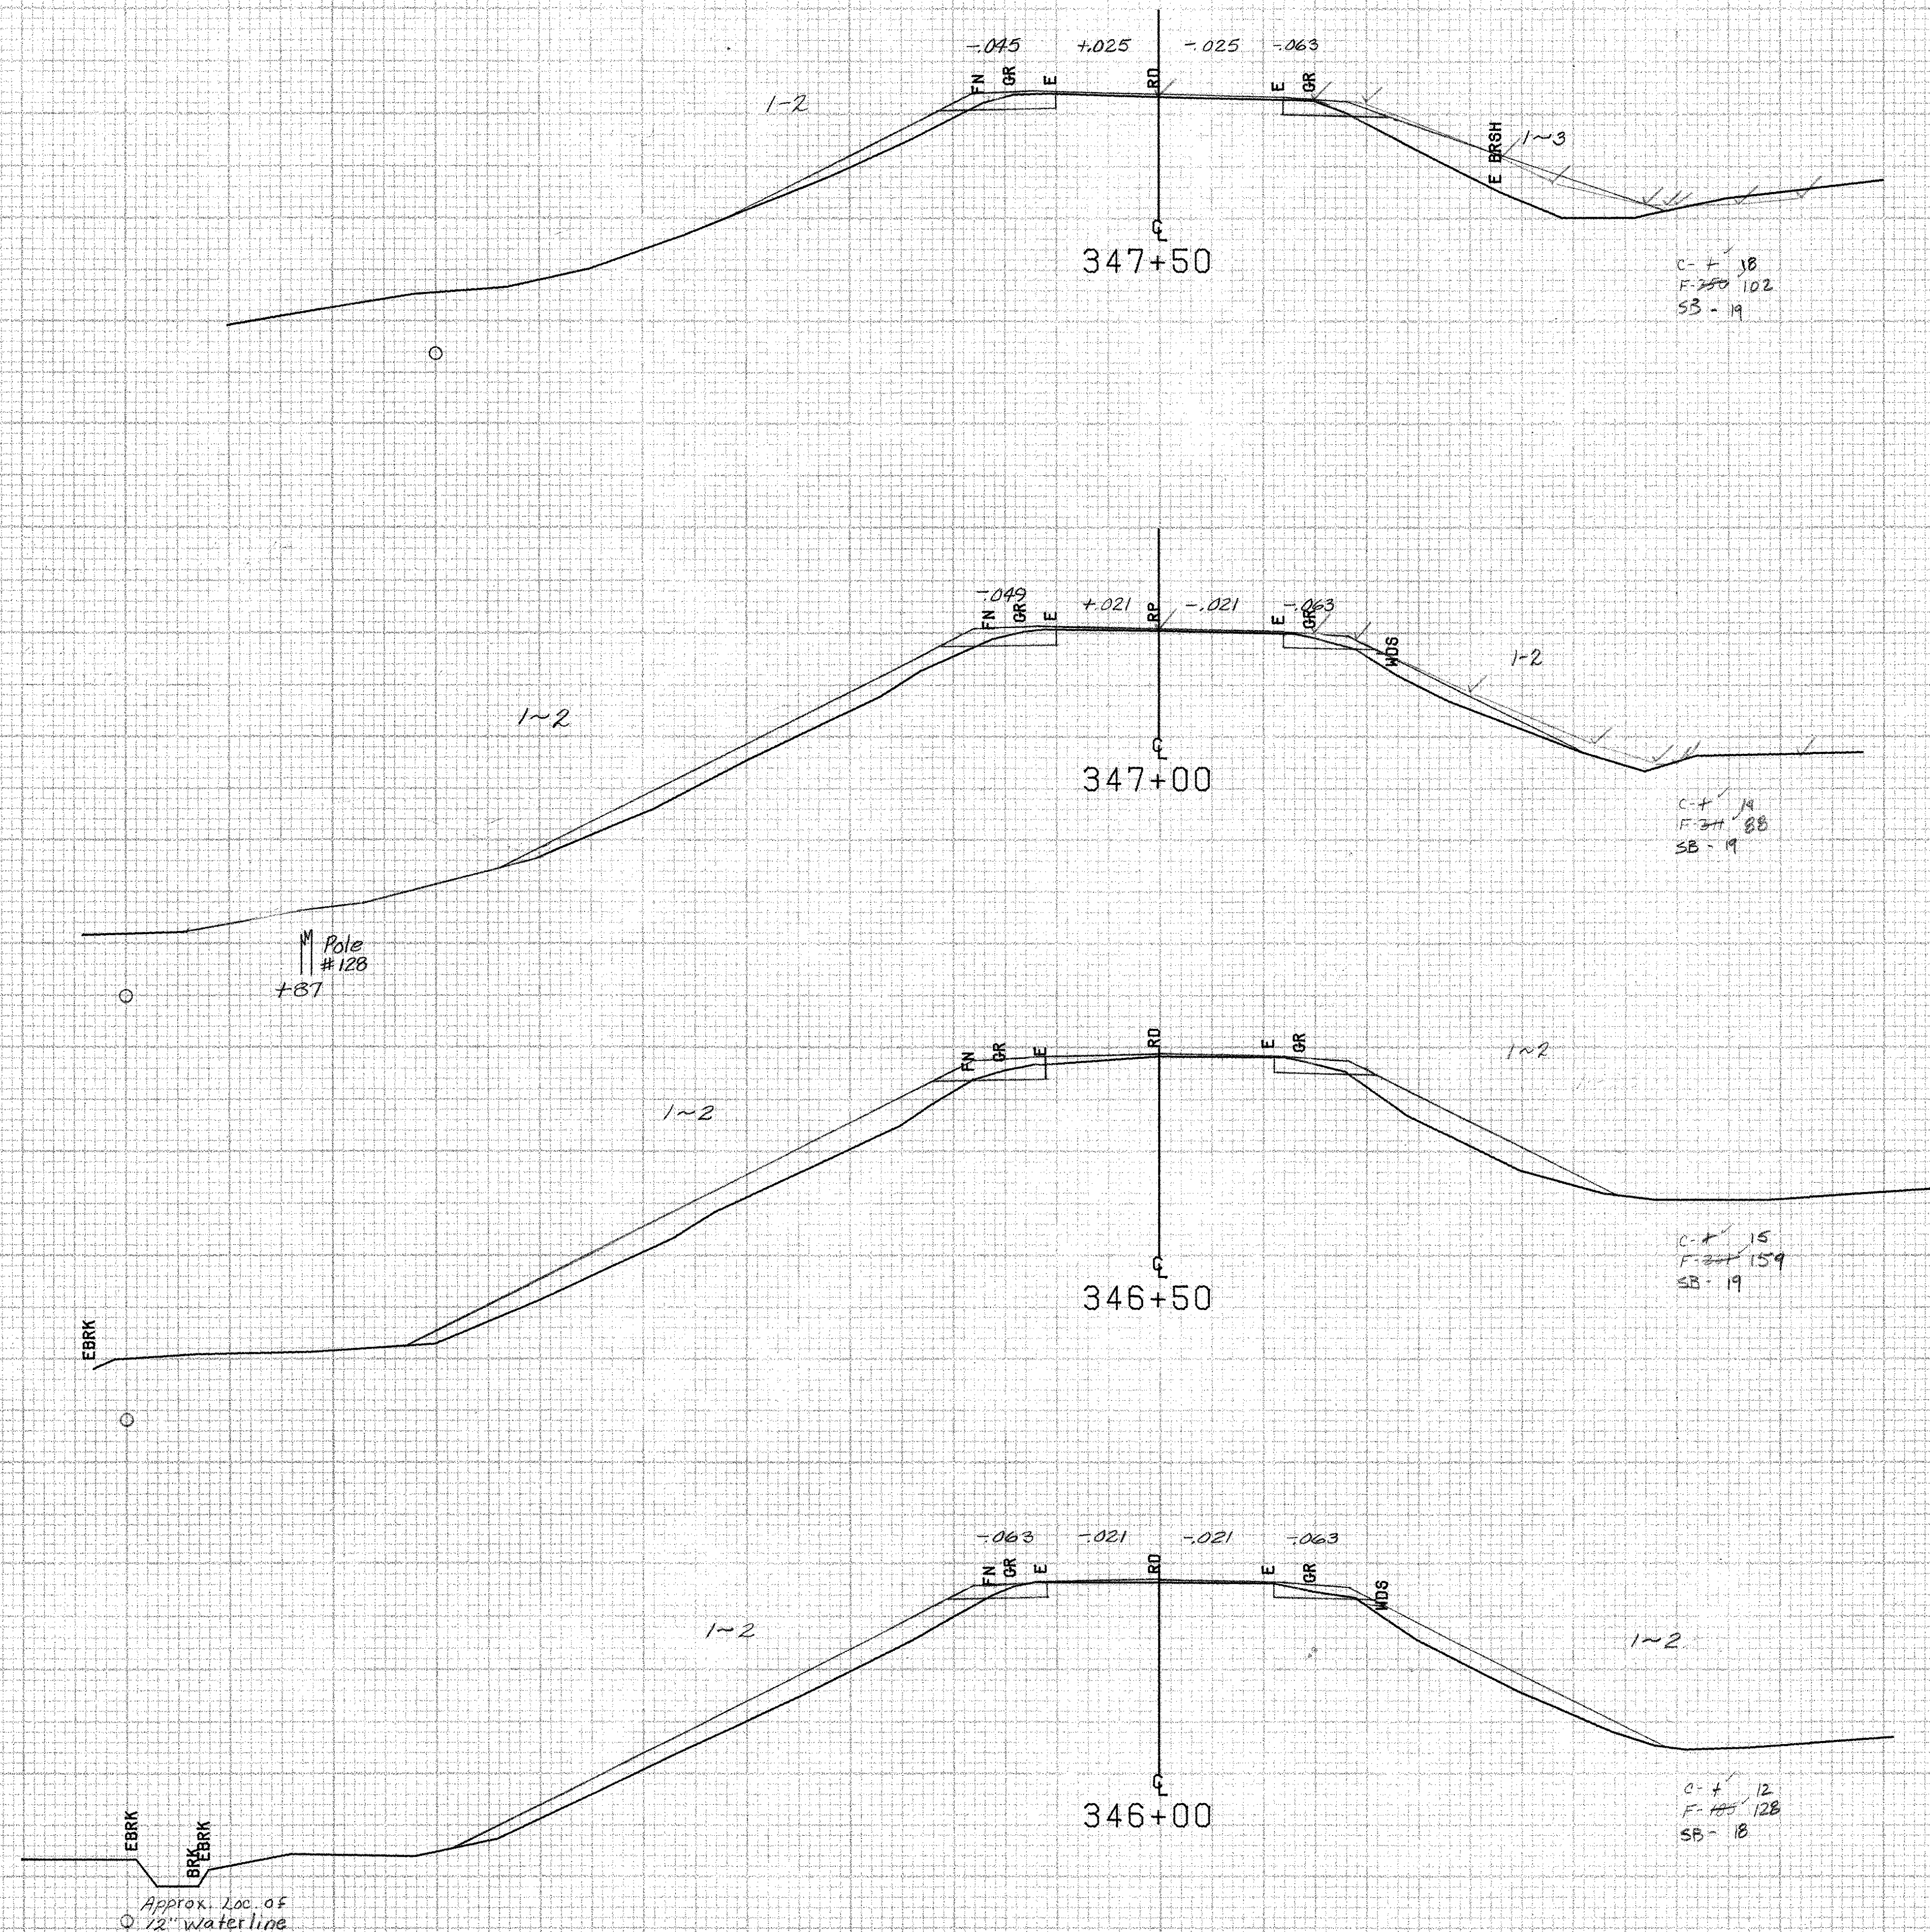


480

480

470

470

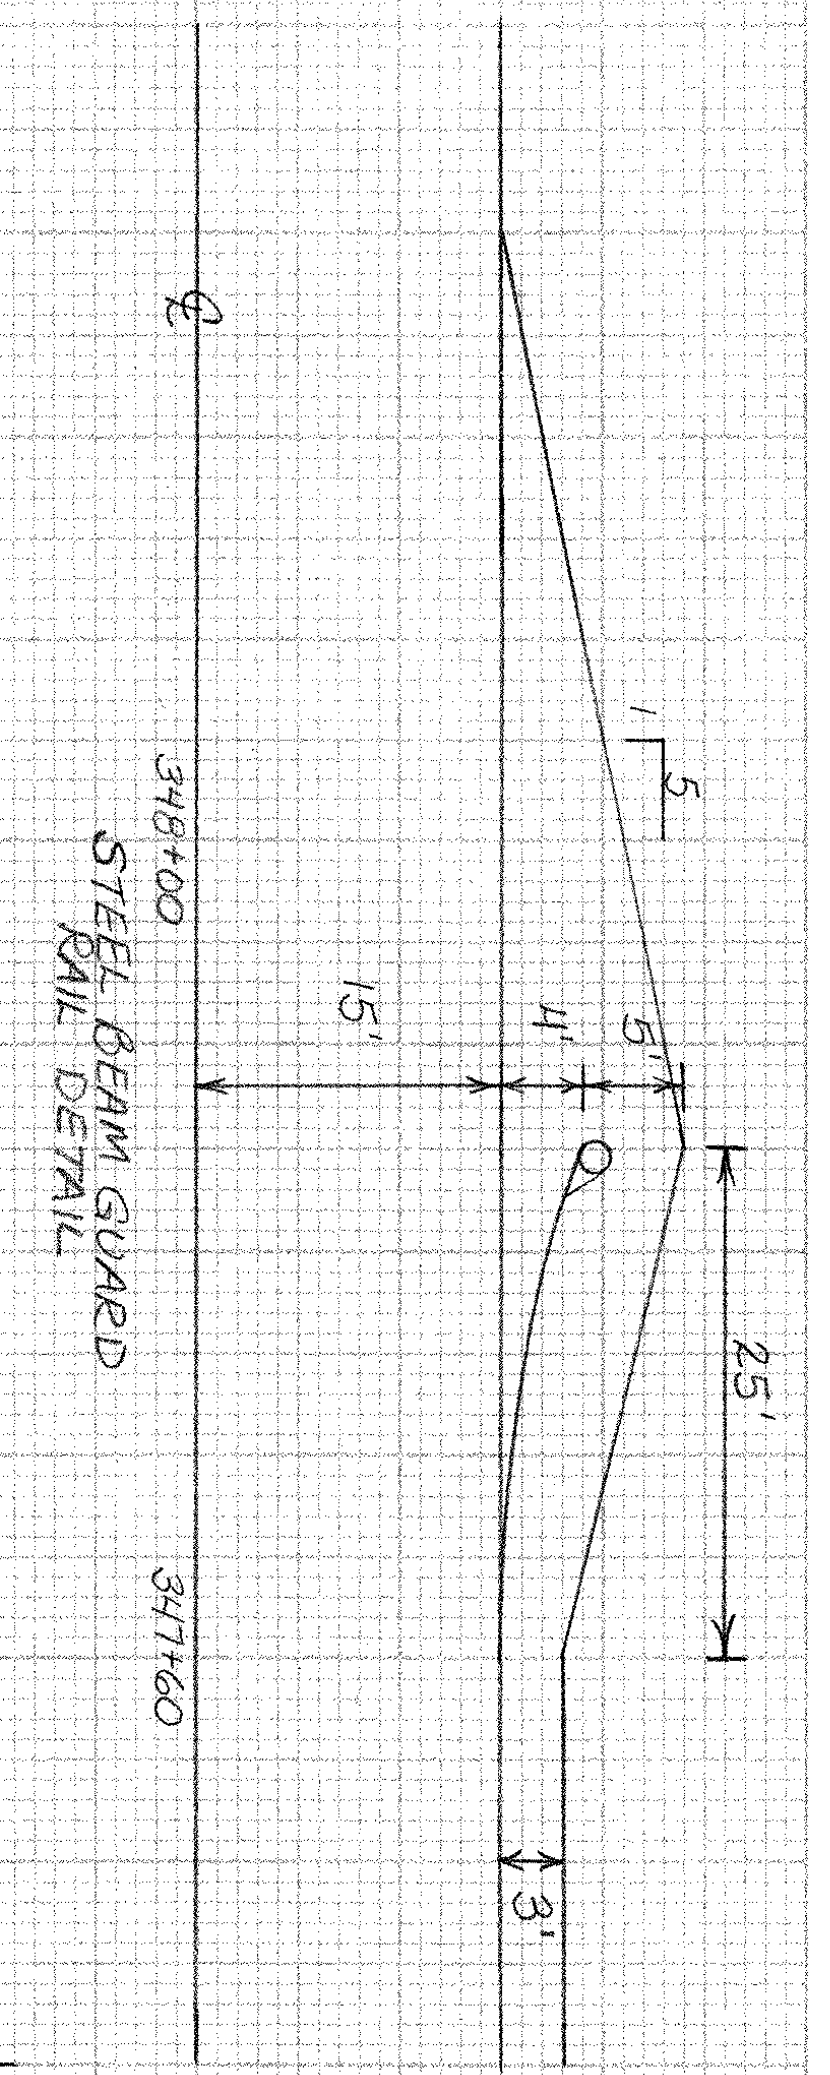

Scale:  
10'  
10'

BRIDPORT~ADDISON MM 6.30~MM 0.32

FROM STA.	346+00	TO STA.	347+50
PROJECT NAME	SHOREHAM-BRIDPORT-ADDISON		
NO.	F017-1(2)	PLOTTED	02/28/84
SURVEYED BY	FANTONI	FEBRUARY 84	
SHEET	388	OF	420 SHEETS
		SHEET	388 OF 477

SCALE 1" = 10 FEET

Approx. Loc. of  
12" Waterline