





349+00 ~ 349+25 Lt.
Breakaway Cable Terminal

349+00 Lt.
End Steel Beam Guard Rail

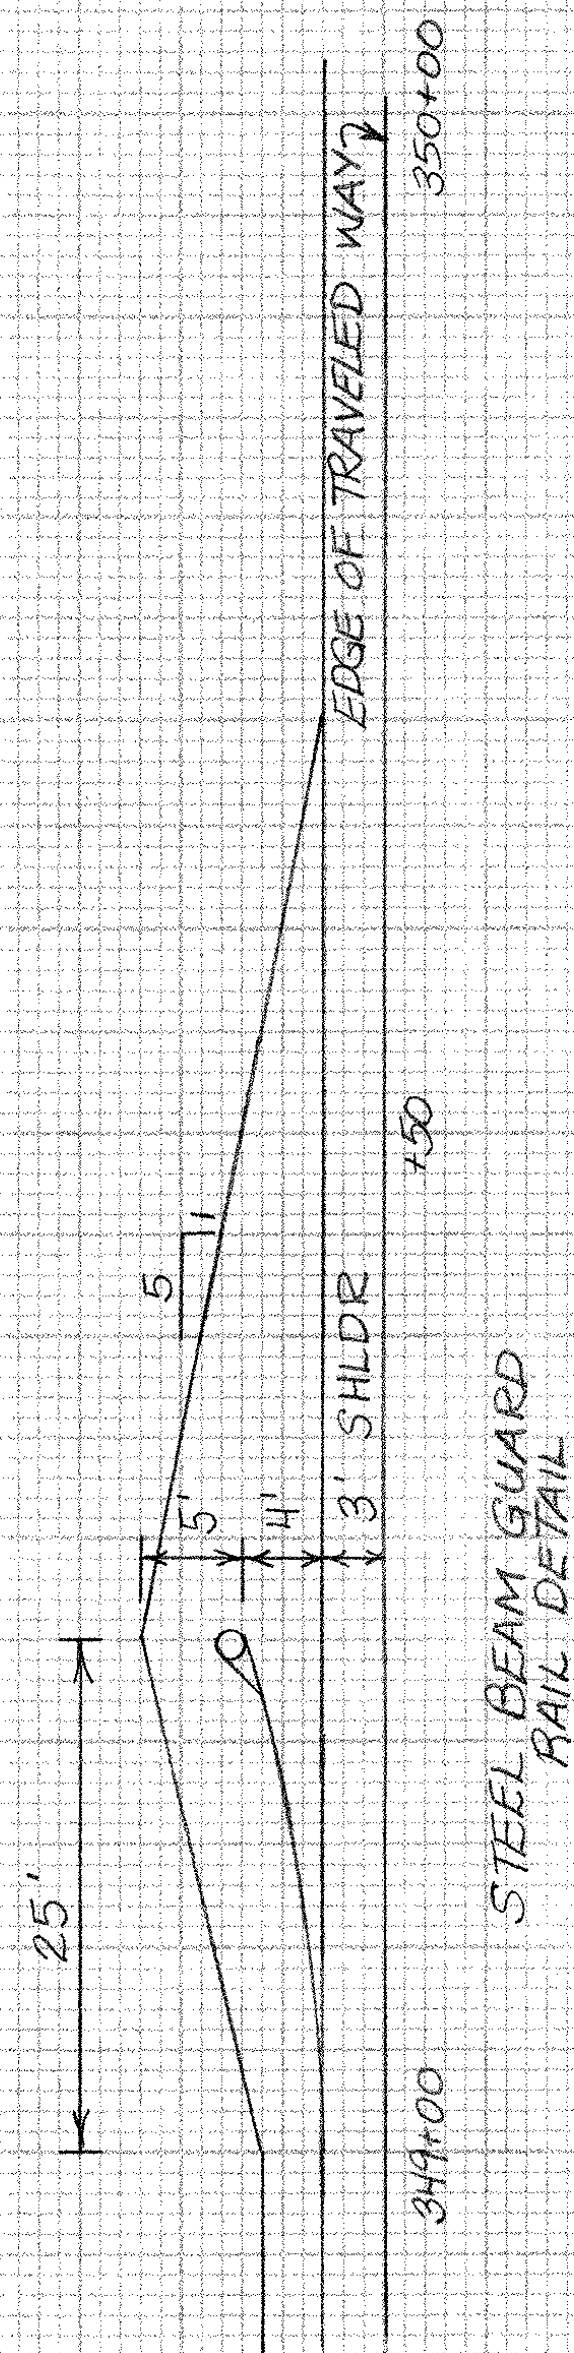


Scale:
10'
10'

348+21 Lt.
End Removal and Disposal
of Guard Rail

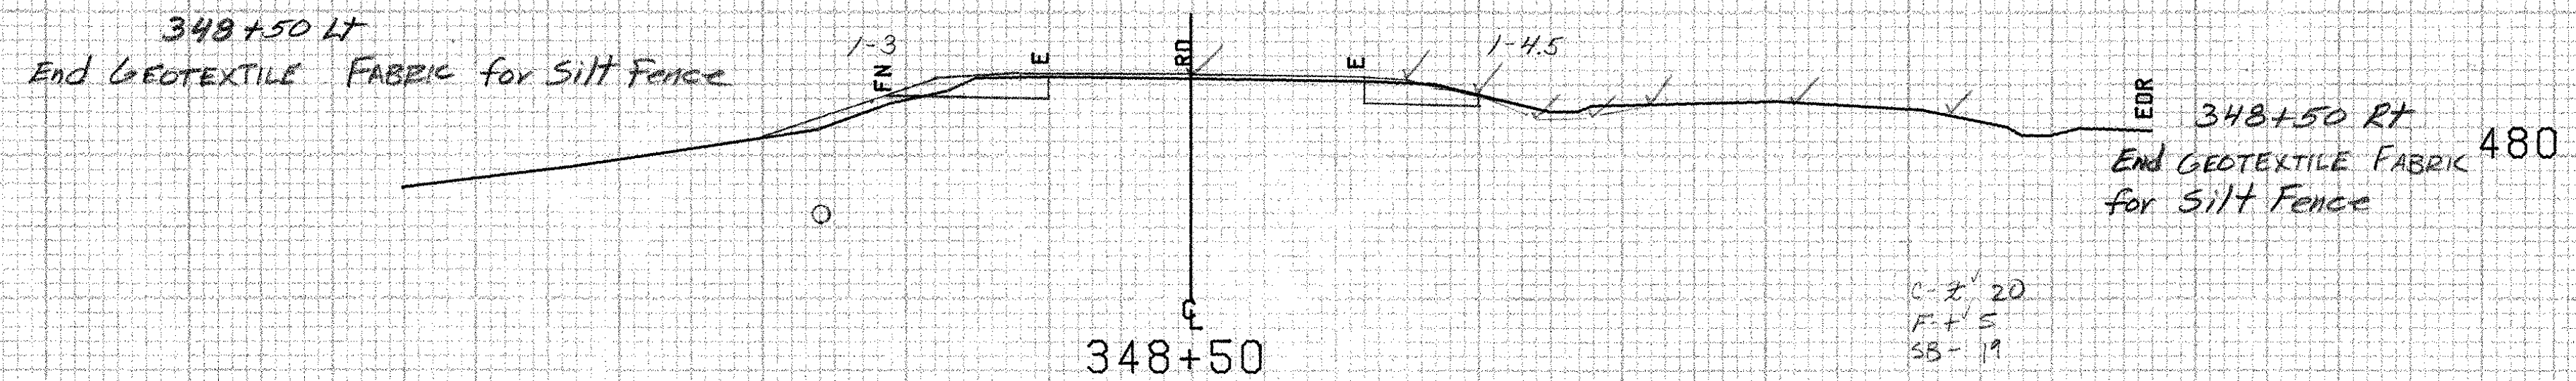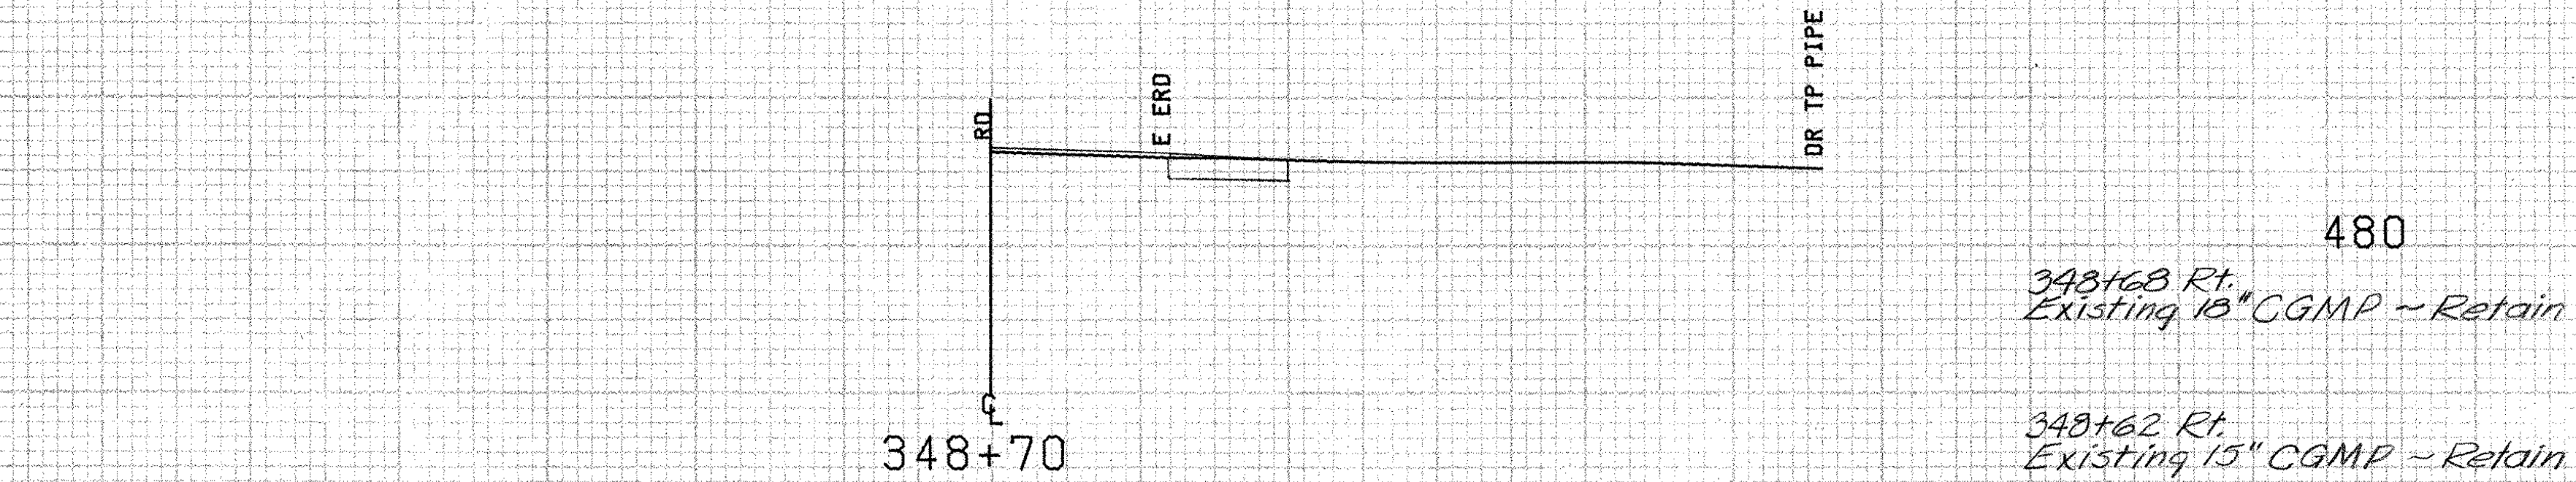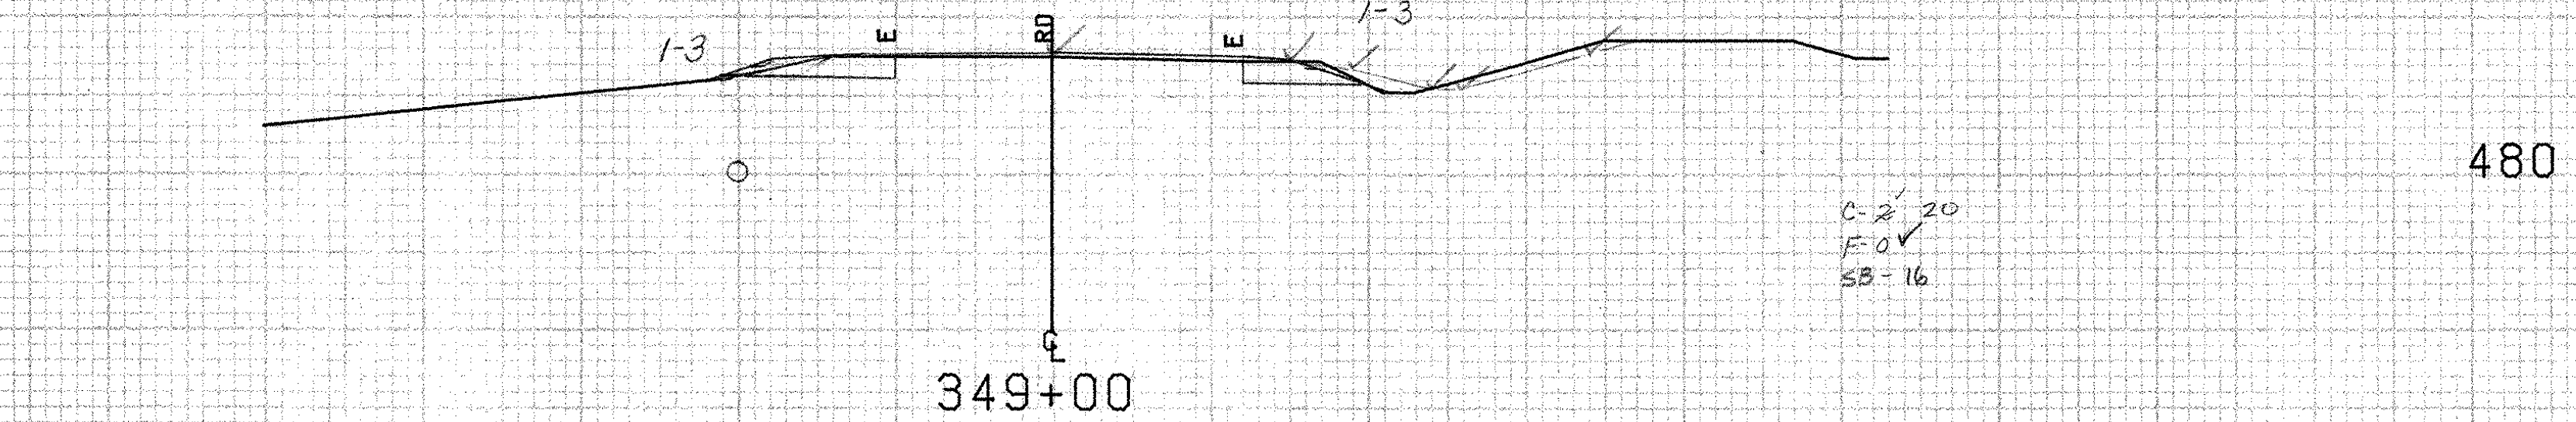

Pole
#127
+35

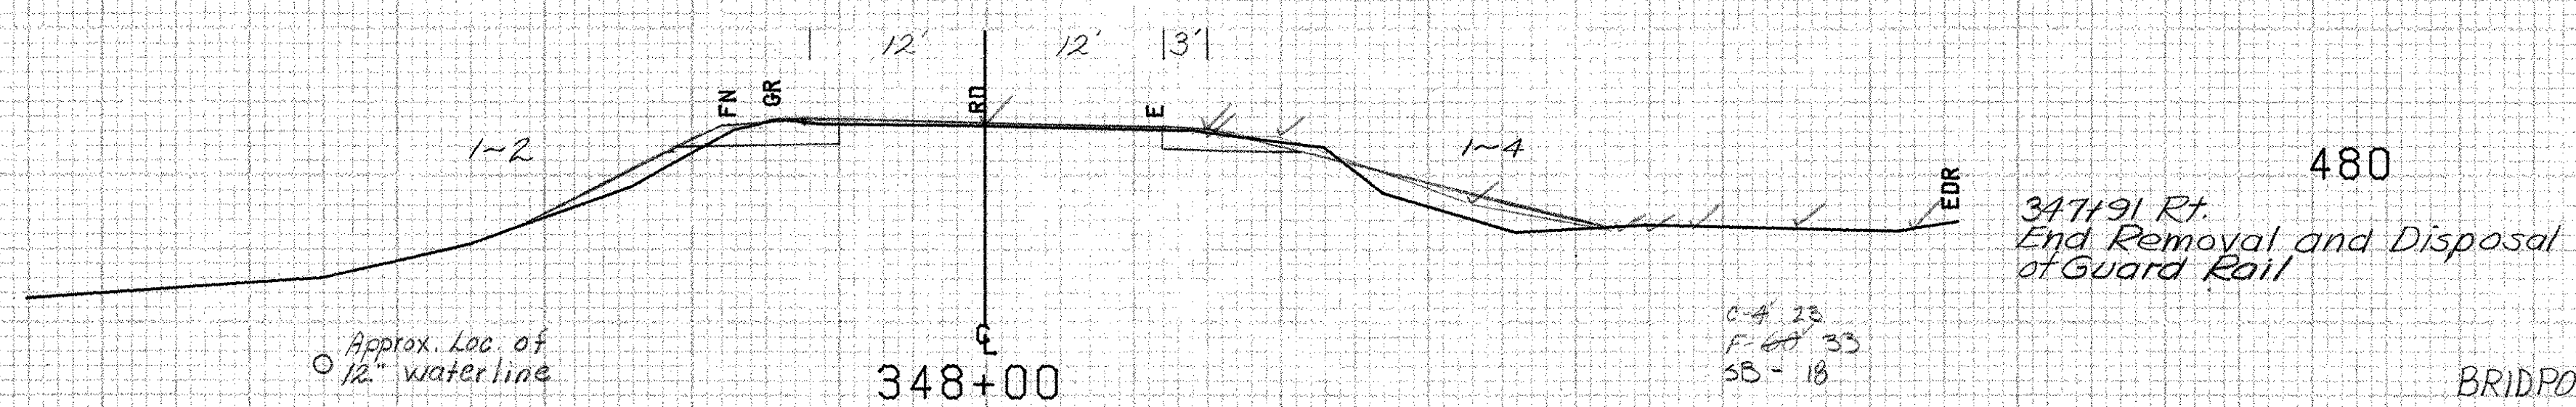

BRIDPORT-ADDISON MM 6.30 ~ MM 0.32

FROM STA.	348+00	TO STA.	349+00
PROJECT NAME	SHOREHAM-BRIDPORT-ADDISON		
NO.	F017-1(2)	PLOTTED	02/28/84
SURVEYED BY	FANTONI	FEBRUARY	84
SHEET	327	OF	420 SHEETS

SCALE 10 FEET