
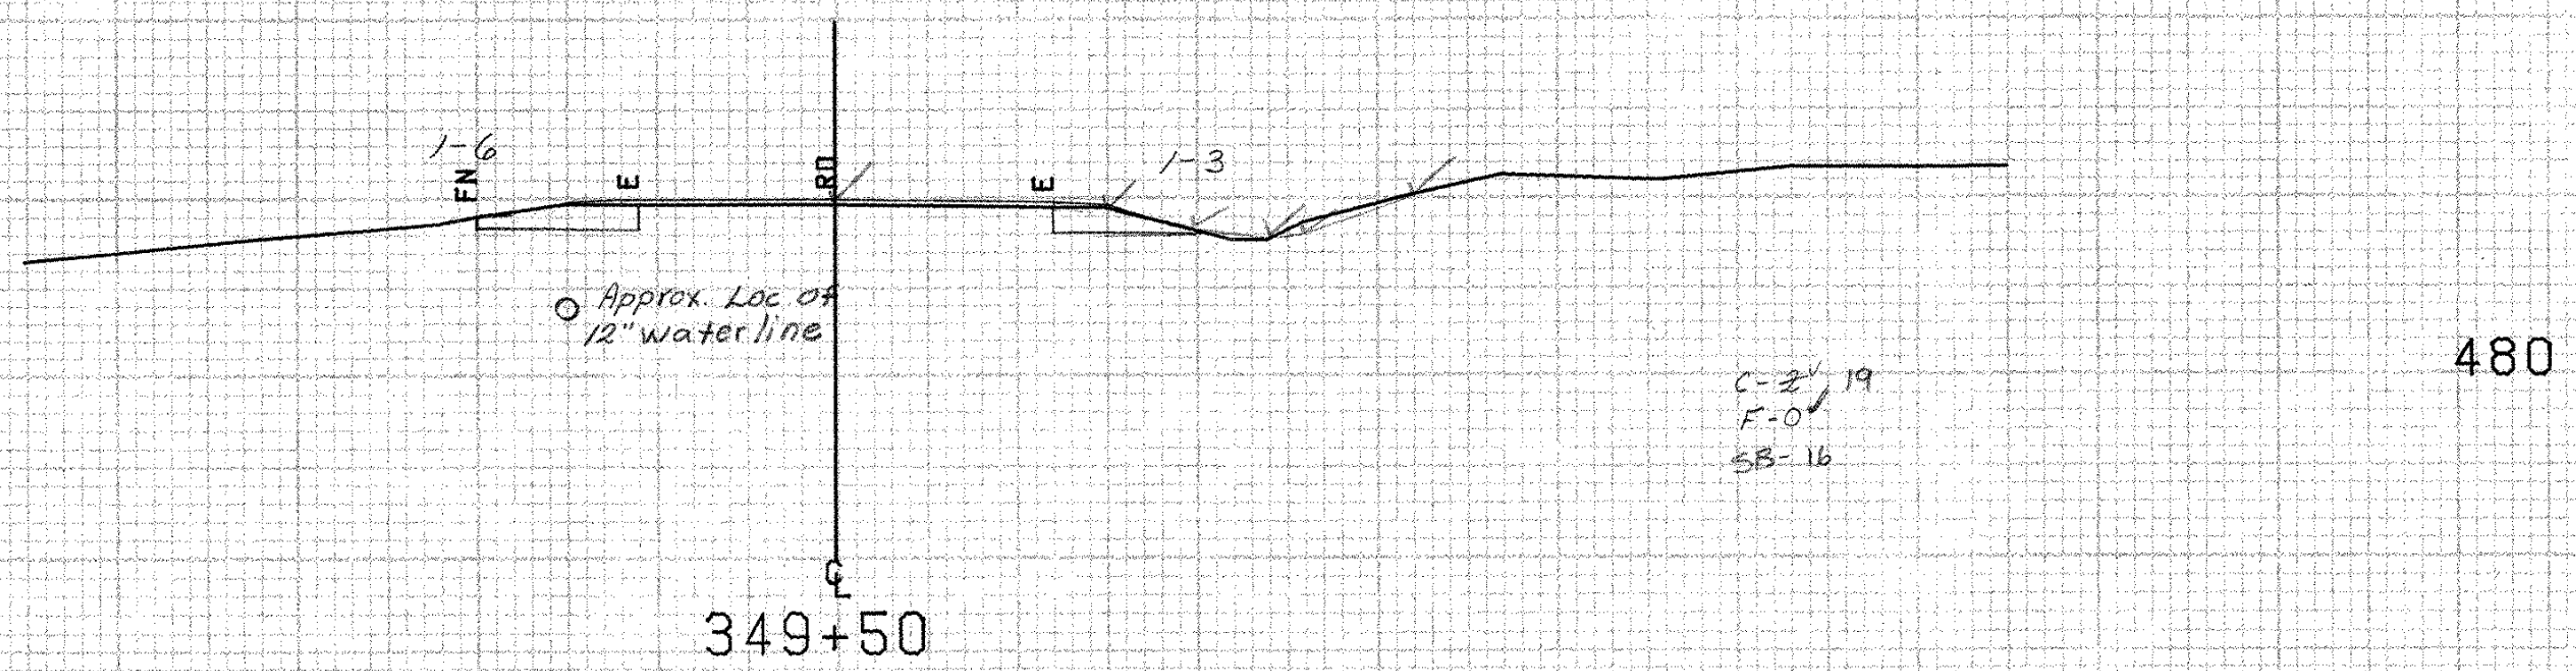


352+65 LT
 End Removing & Resetting Fence
 End Temporary Barbed Wire Fence (4-Strand)
 END REMOVAL OF EXISTING FENCE (NON-PART)

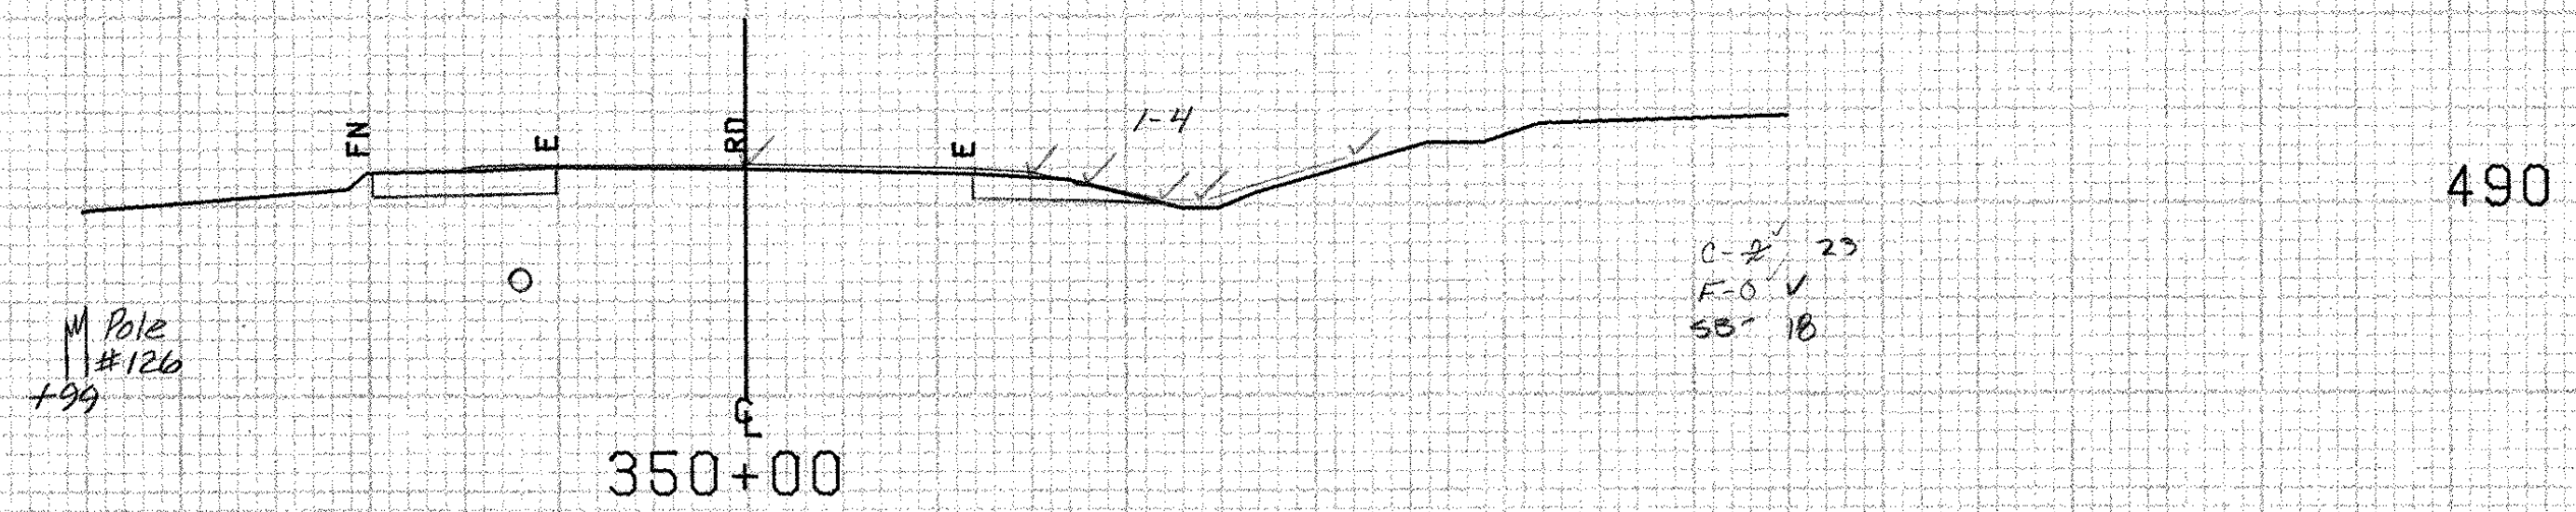

BRIDPORT-ADDISON MM 6.30 ~ MM 0.32

| | | | |
|--------------|---------------------------|----------|------------|
| FROM STA. | 349+50 | TO STA. | 350+00 |
| PROJECT NAME | SHOREHAM-BRIDPORT-ADDISON | | |
| NO. | F017-1(2) | PLOTTED | 02/28/84 |
| SURVEYED BY | FANTONI | FEBRUARY | 84 |
| SHEET | 390 | OF | 477 SHEETS |

SCALE 1" = 10 FEET