
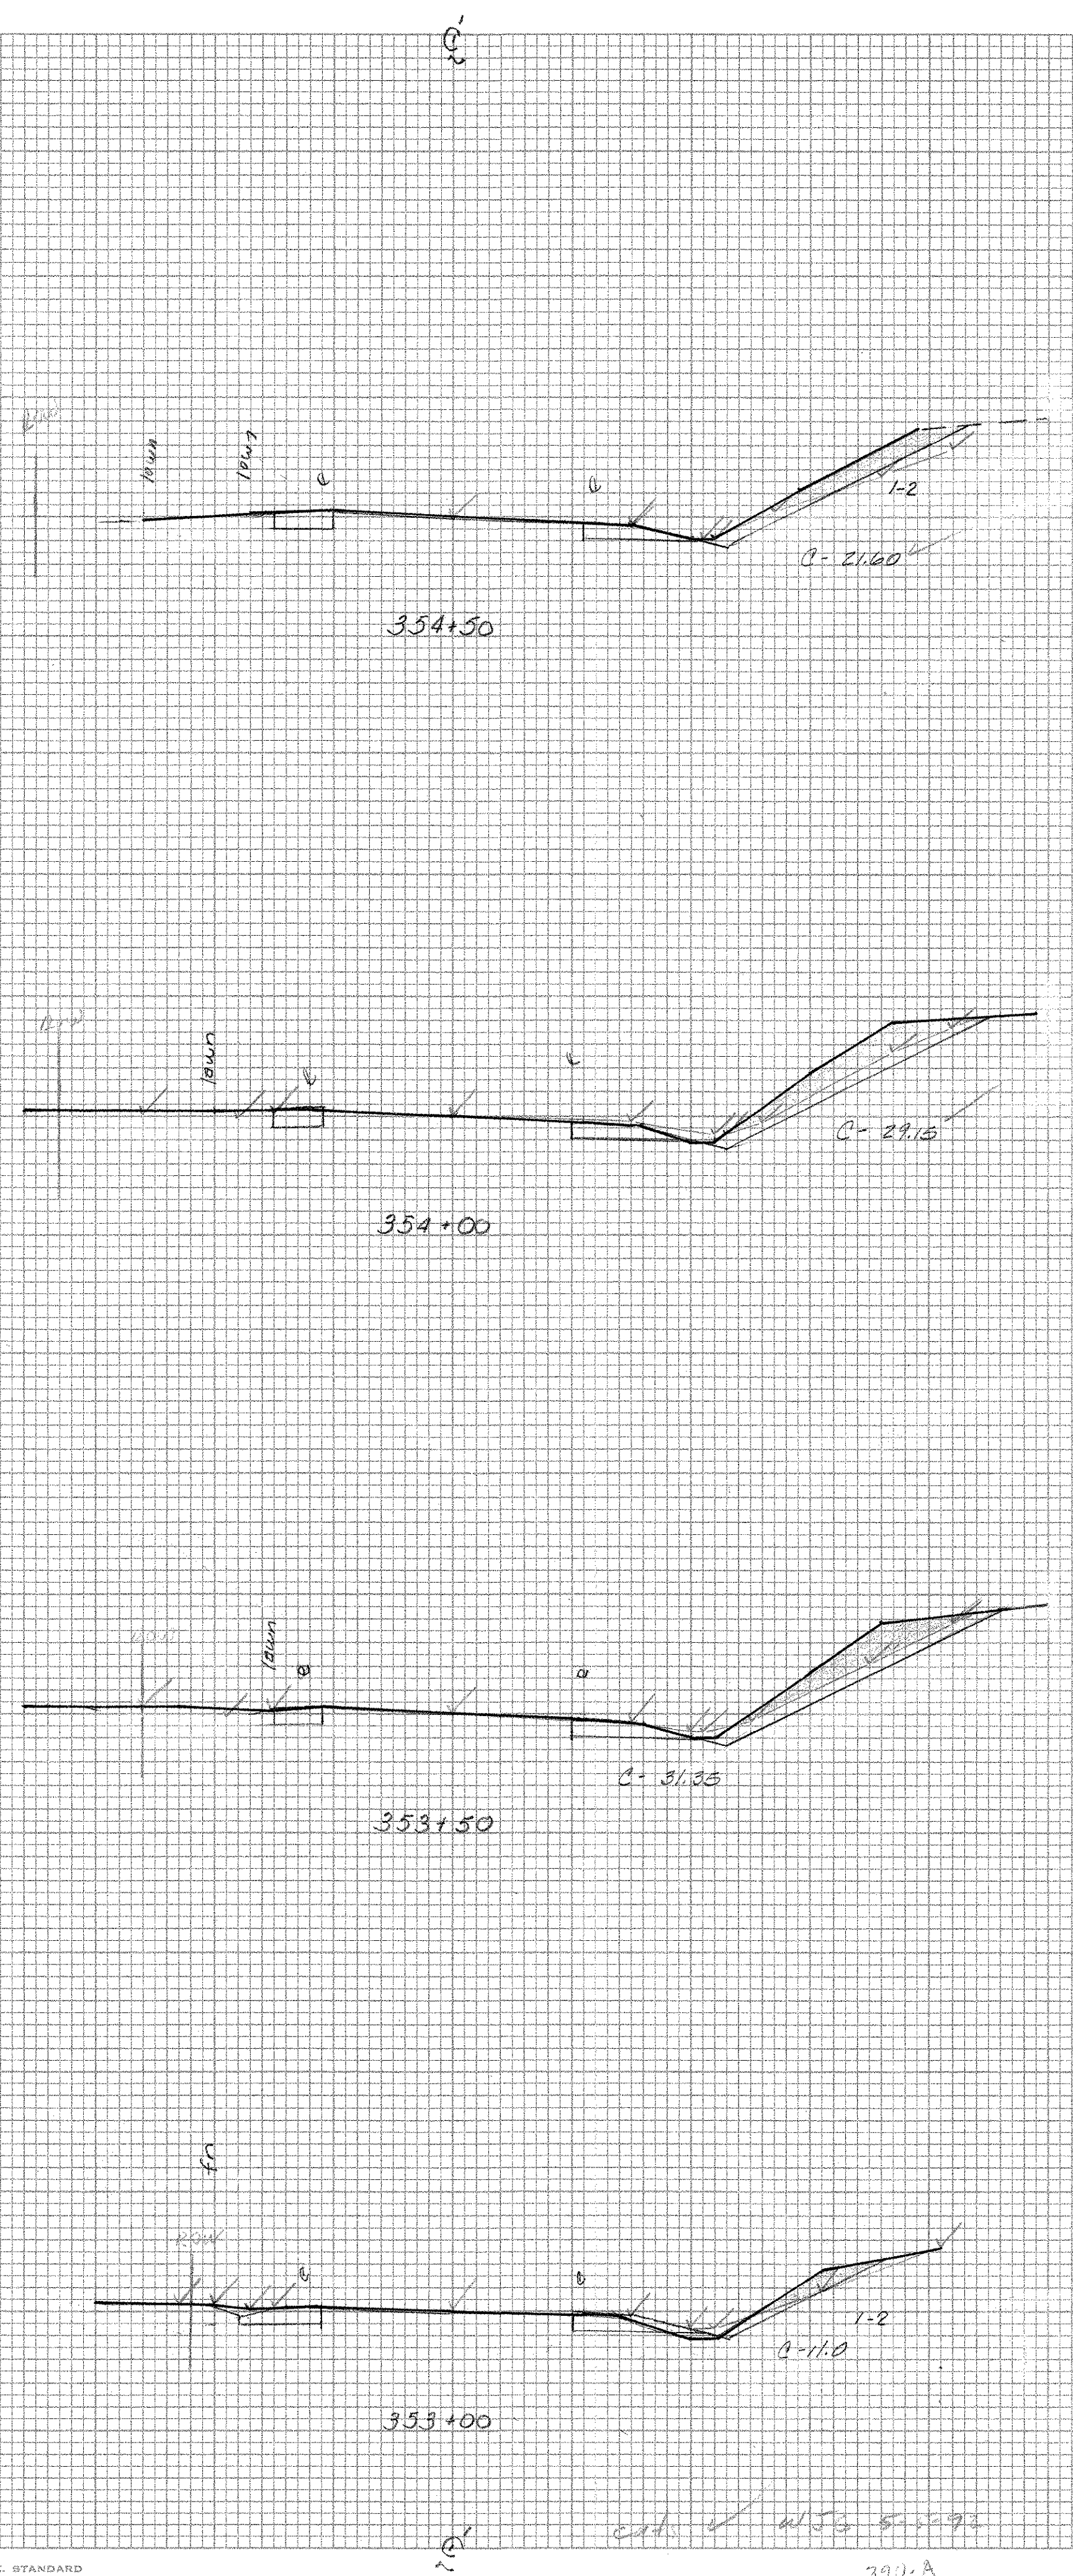


DATE _____
 BY _____
 ORIGINAL SURVEY DRAWING PLOTTED _____
 NOTE BOOK No. _____
 AREAS CHECKED _____

DATE _____
 BY _____
 ORIGINAL SURVEY DRAWING PLOTTED _____
 NOTE BOOK No. _____
 AREAS CHECKED _____

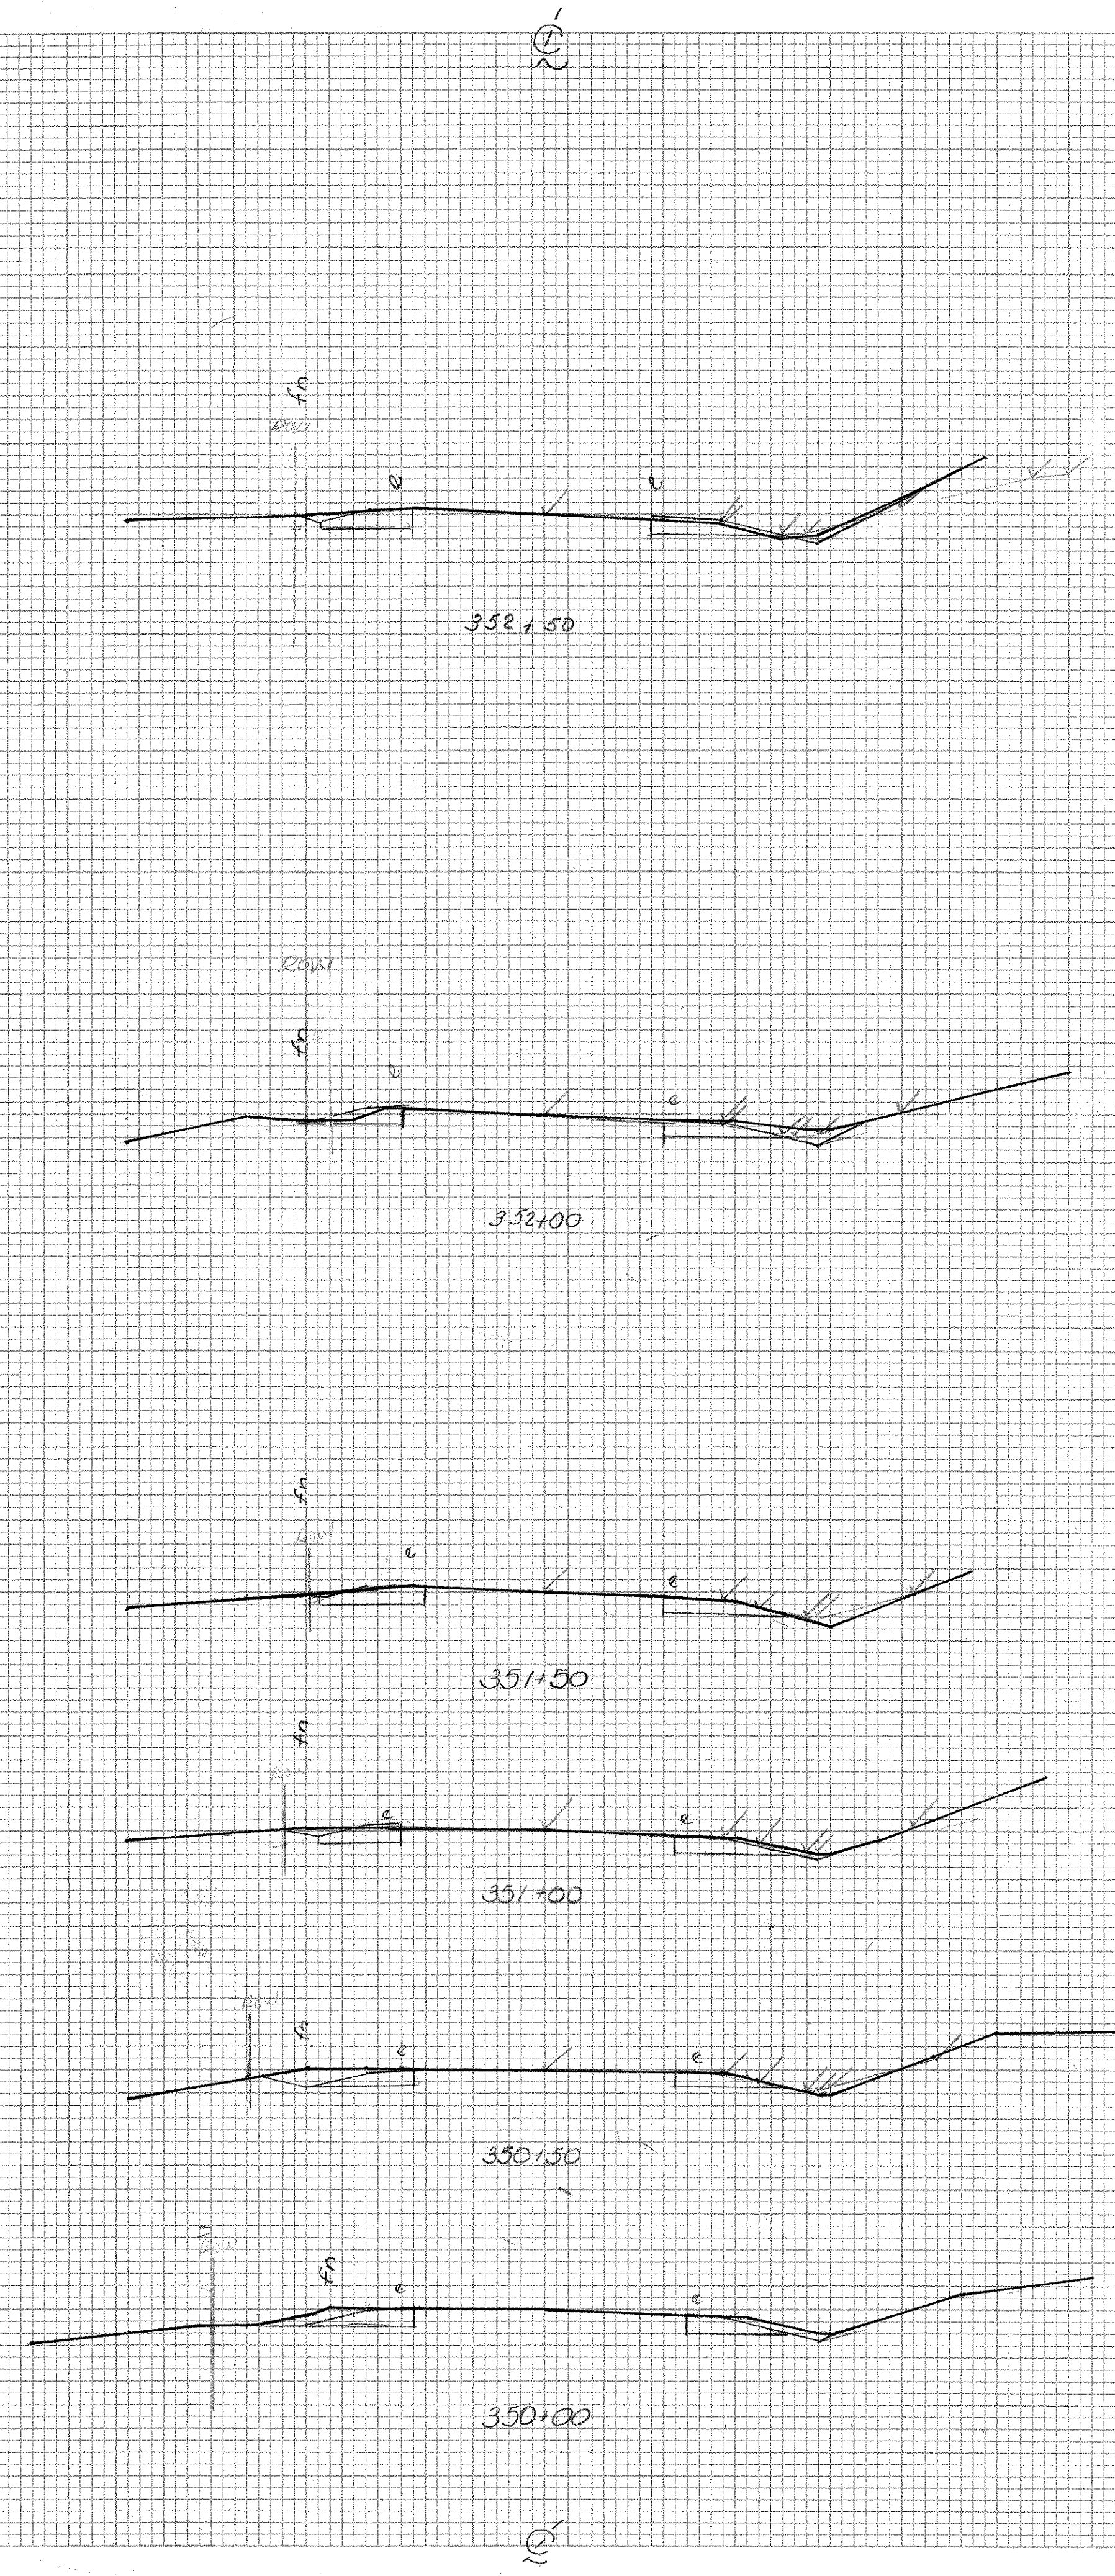

EARTH

22.0	498.2
27.0	500.4
32.0	502.0
37.0	507.9
39.0	507.4
22.0	498.2
21.60	

EARTH

23.0	498.5
26.0	499.6
37.0	505.5
40.0	507.4
44.0	509.3
37.0	509.0
25.0	498.5
29.15	

EARTH

23.5	499.0
25.0	499.6
35.0	504.3
42.0	507.7
45.0	509.2
30.0	507.9
22.5	499.0
31.55	

EARTH

25.0	500.0
31.0	501.6
36.0	502.4
37.0	508.6
25.0	500.0
11.0	

SHOREHAM-BRIDPORT-ADDISON
 FOIT-1 (2)
 350+00 - 354+50