



371+50 Lt.  
Begin Steel Beam Guard Rail

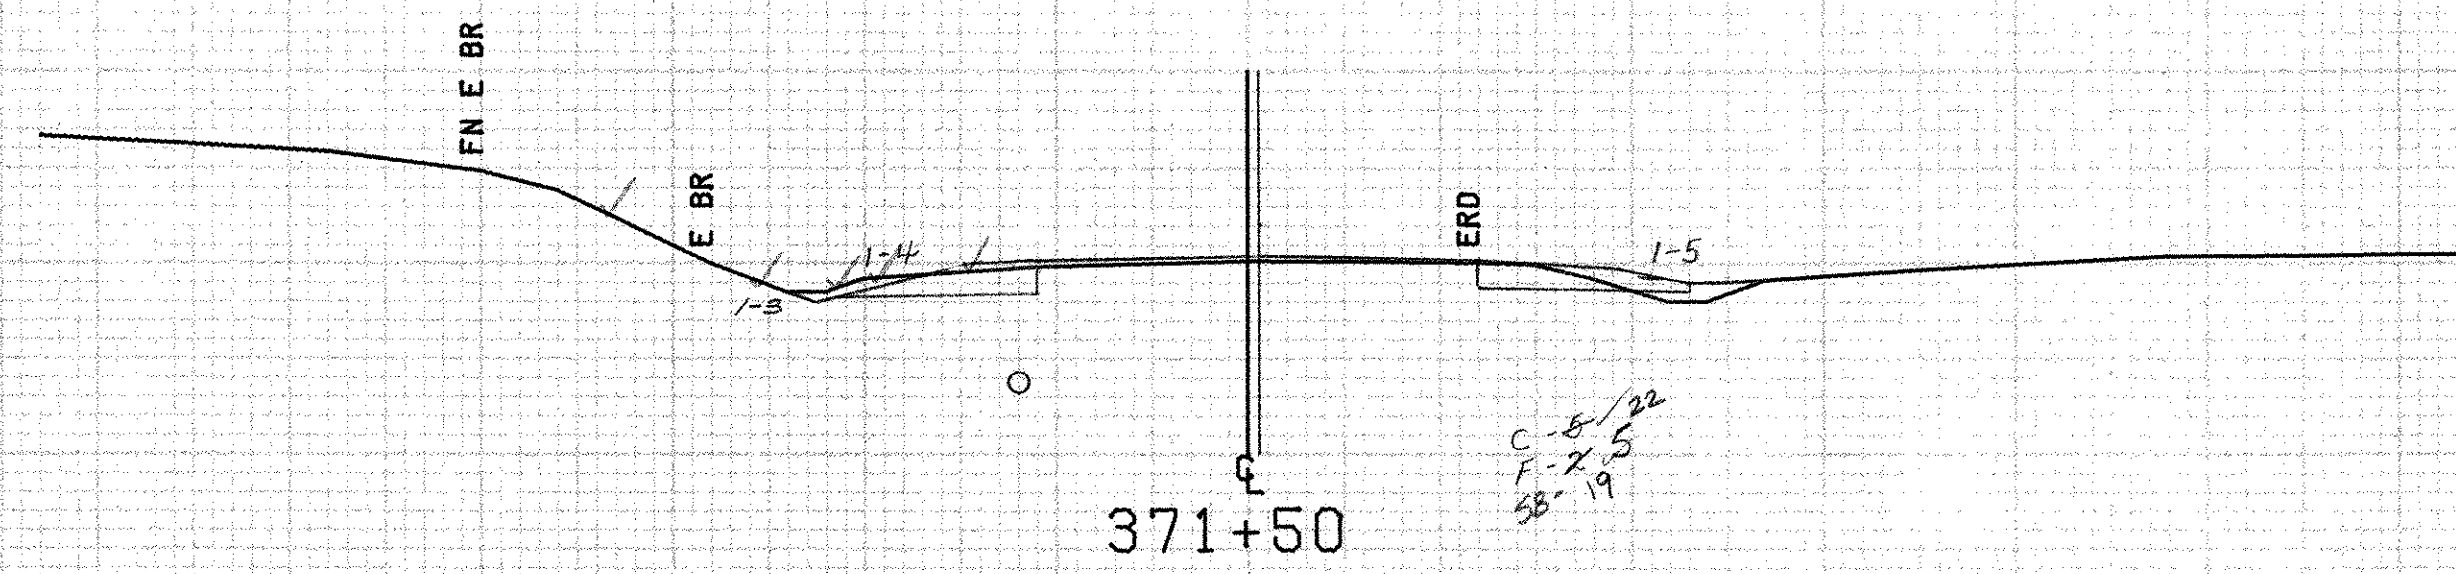

510

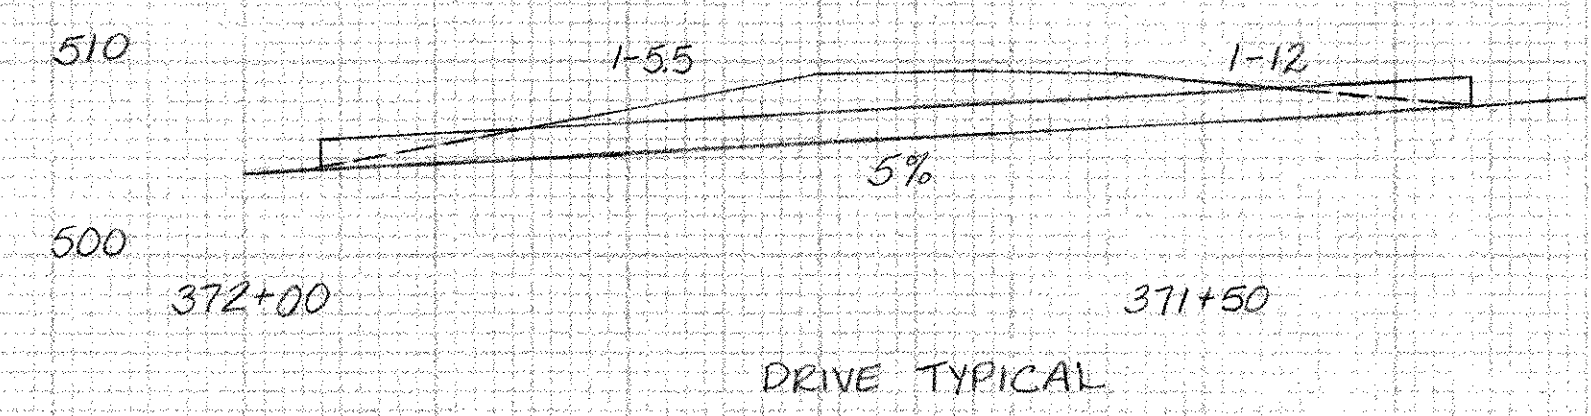


500

371+62 Rt.  
Existing 18" CMP ~ Remove.  
New 18" x 50' CSP(064) or RCP Cl. III

371+62

Pole #113  
+43

371+25 ~ 371+50 Lt.  
Breakaway Cable Terminal

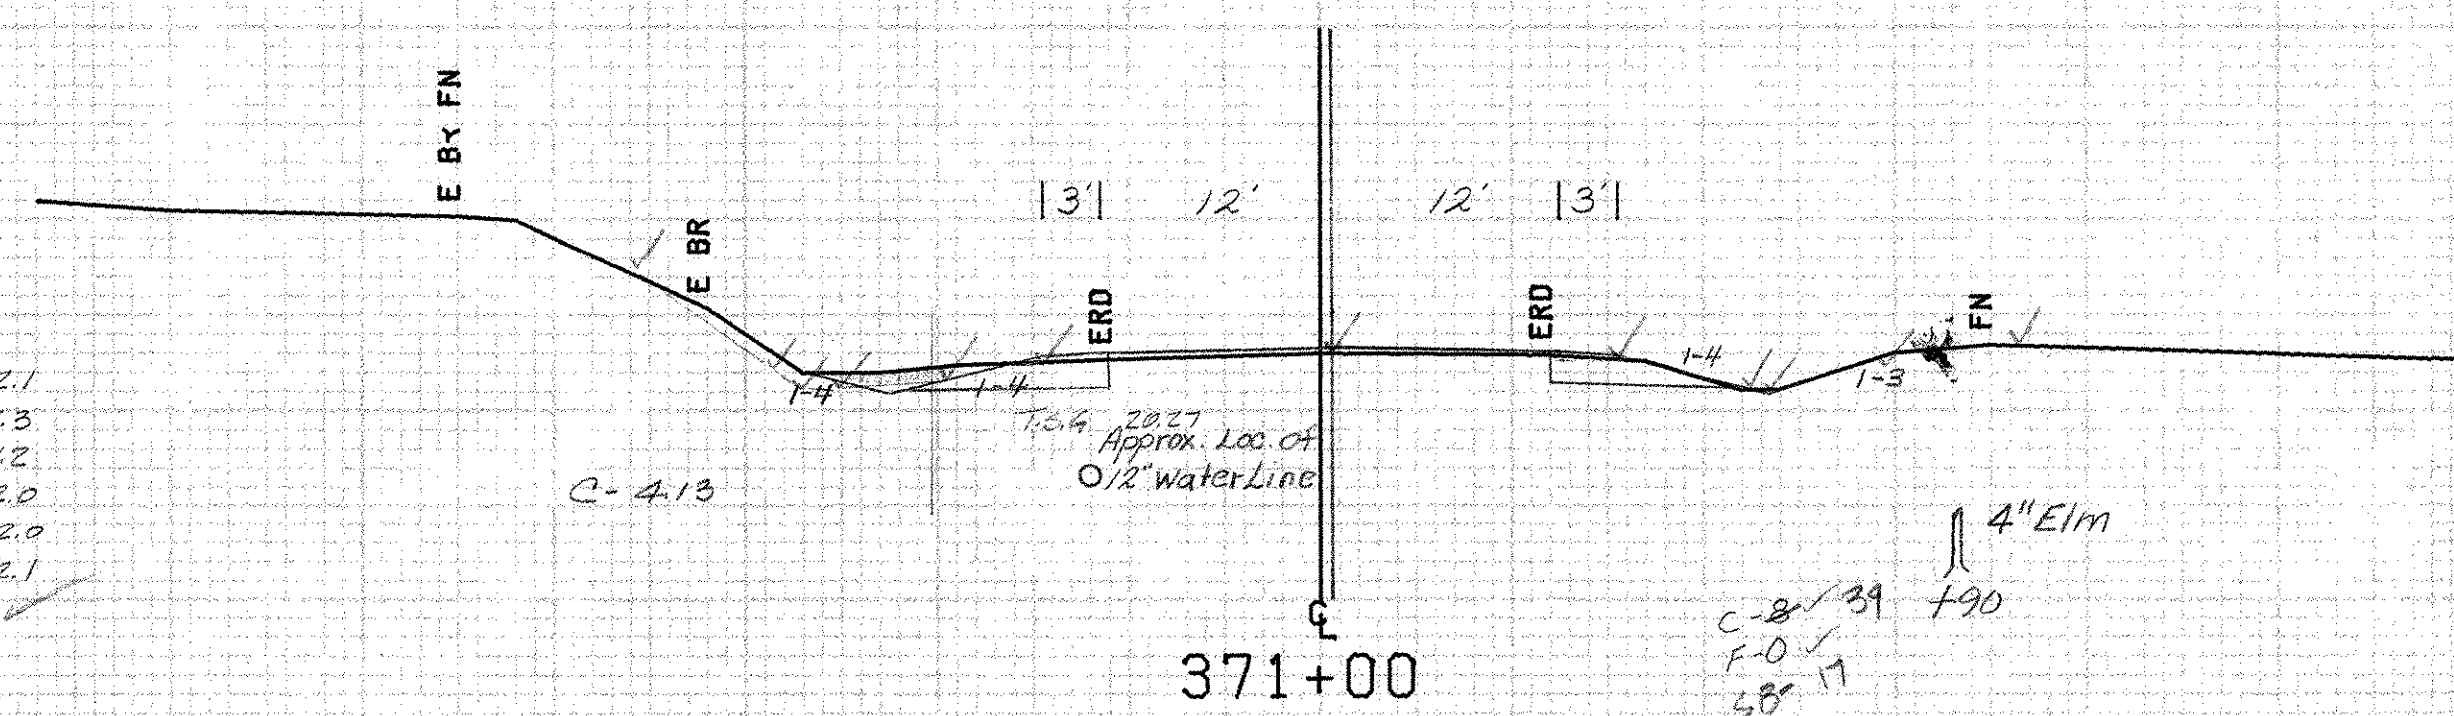

510


EARTH	
20.27	512.1
20.27	511.3
24.0	511.2
27.0	512.0
23.0	512.0
20.27	512.1
4.13	

371+00

4" Elm  
+90  
C-2-19  
F-0-17  
SB-17

C-2-19  
F-0-17  
SB-17

ADDISON MM 0.71 ~ MM 0.94

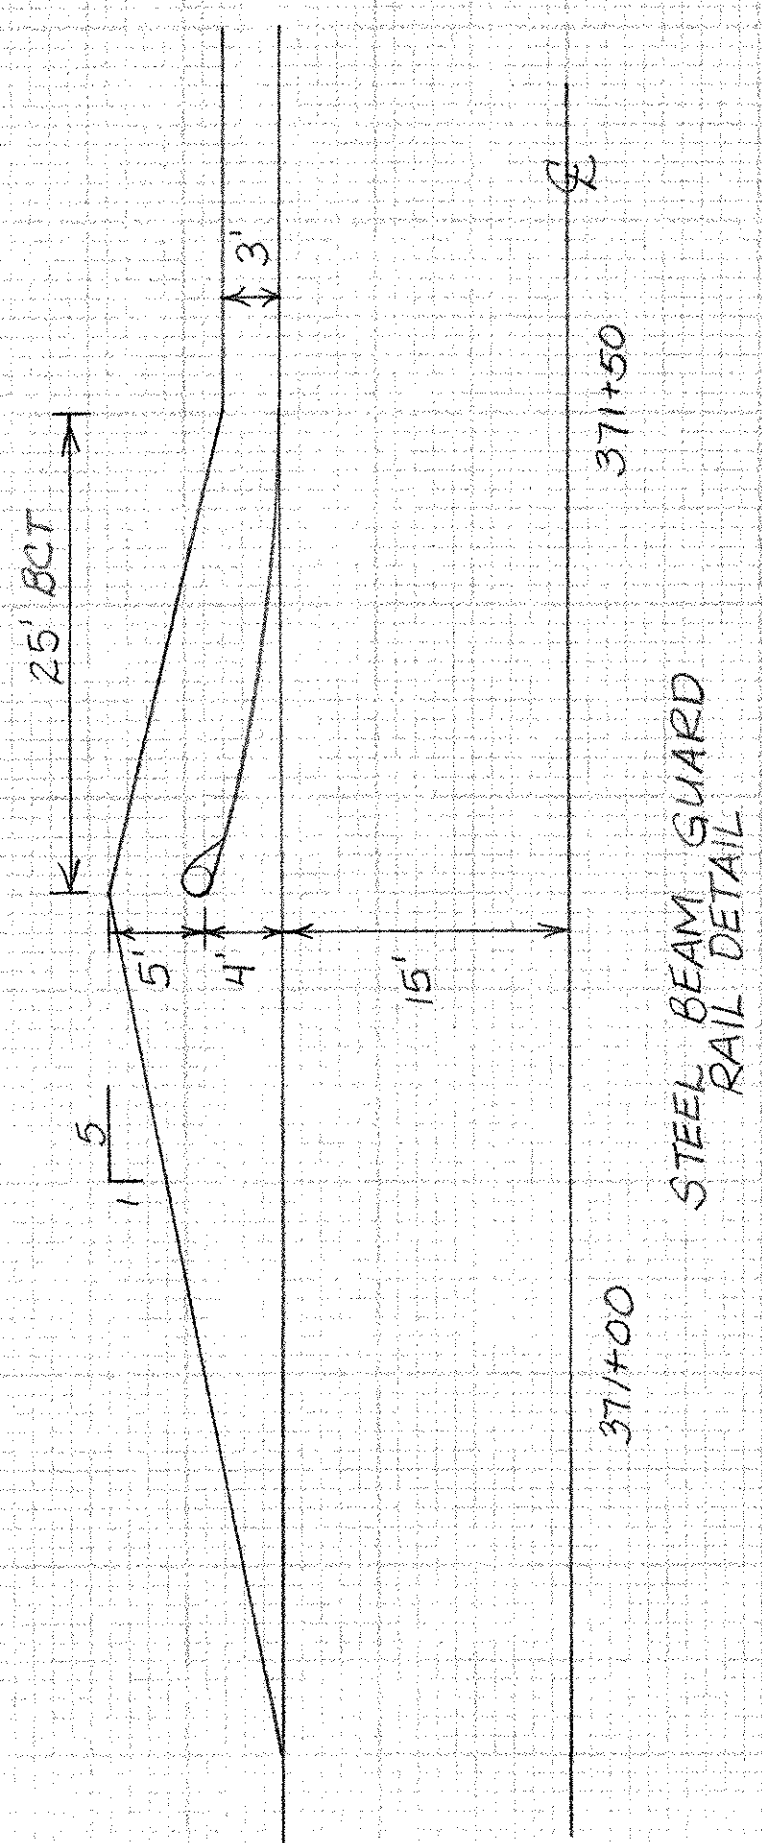

Scale:  
10' (horizontal)  
10' (vertical)

FROM STA.	371+00	TO STA.	371+50
PROJECT NAME	SHOREHAM-BRIDPORT-ADDISON		
NO.	F01-1(2)	PLD	ED 03/13/84
SURVEYED BY	FANTONI	FEB 84	
SHEET	325	OF 420 SHEETS	SHEET 395 OF 477

SCALE 1" = 10 FEET