


373+15 Lt.
Begin Removal & Disposal
of Guard Rail

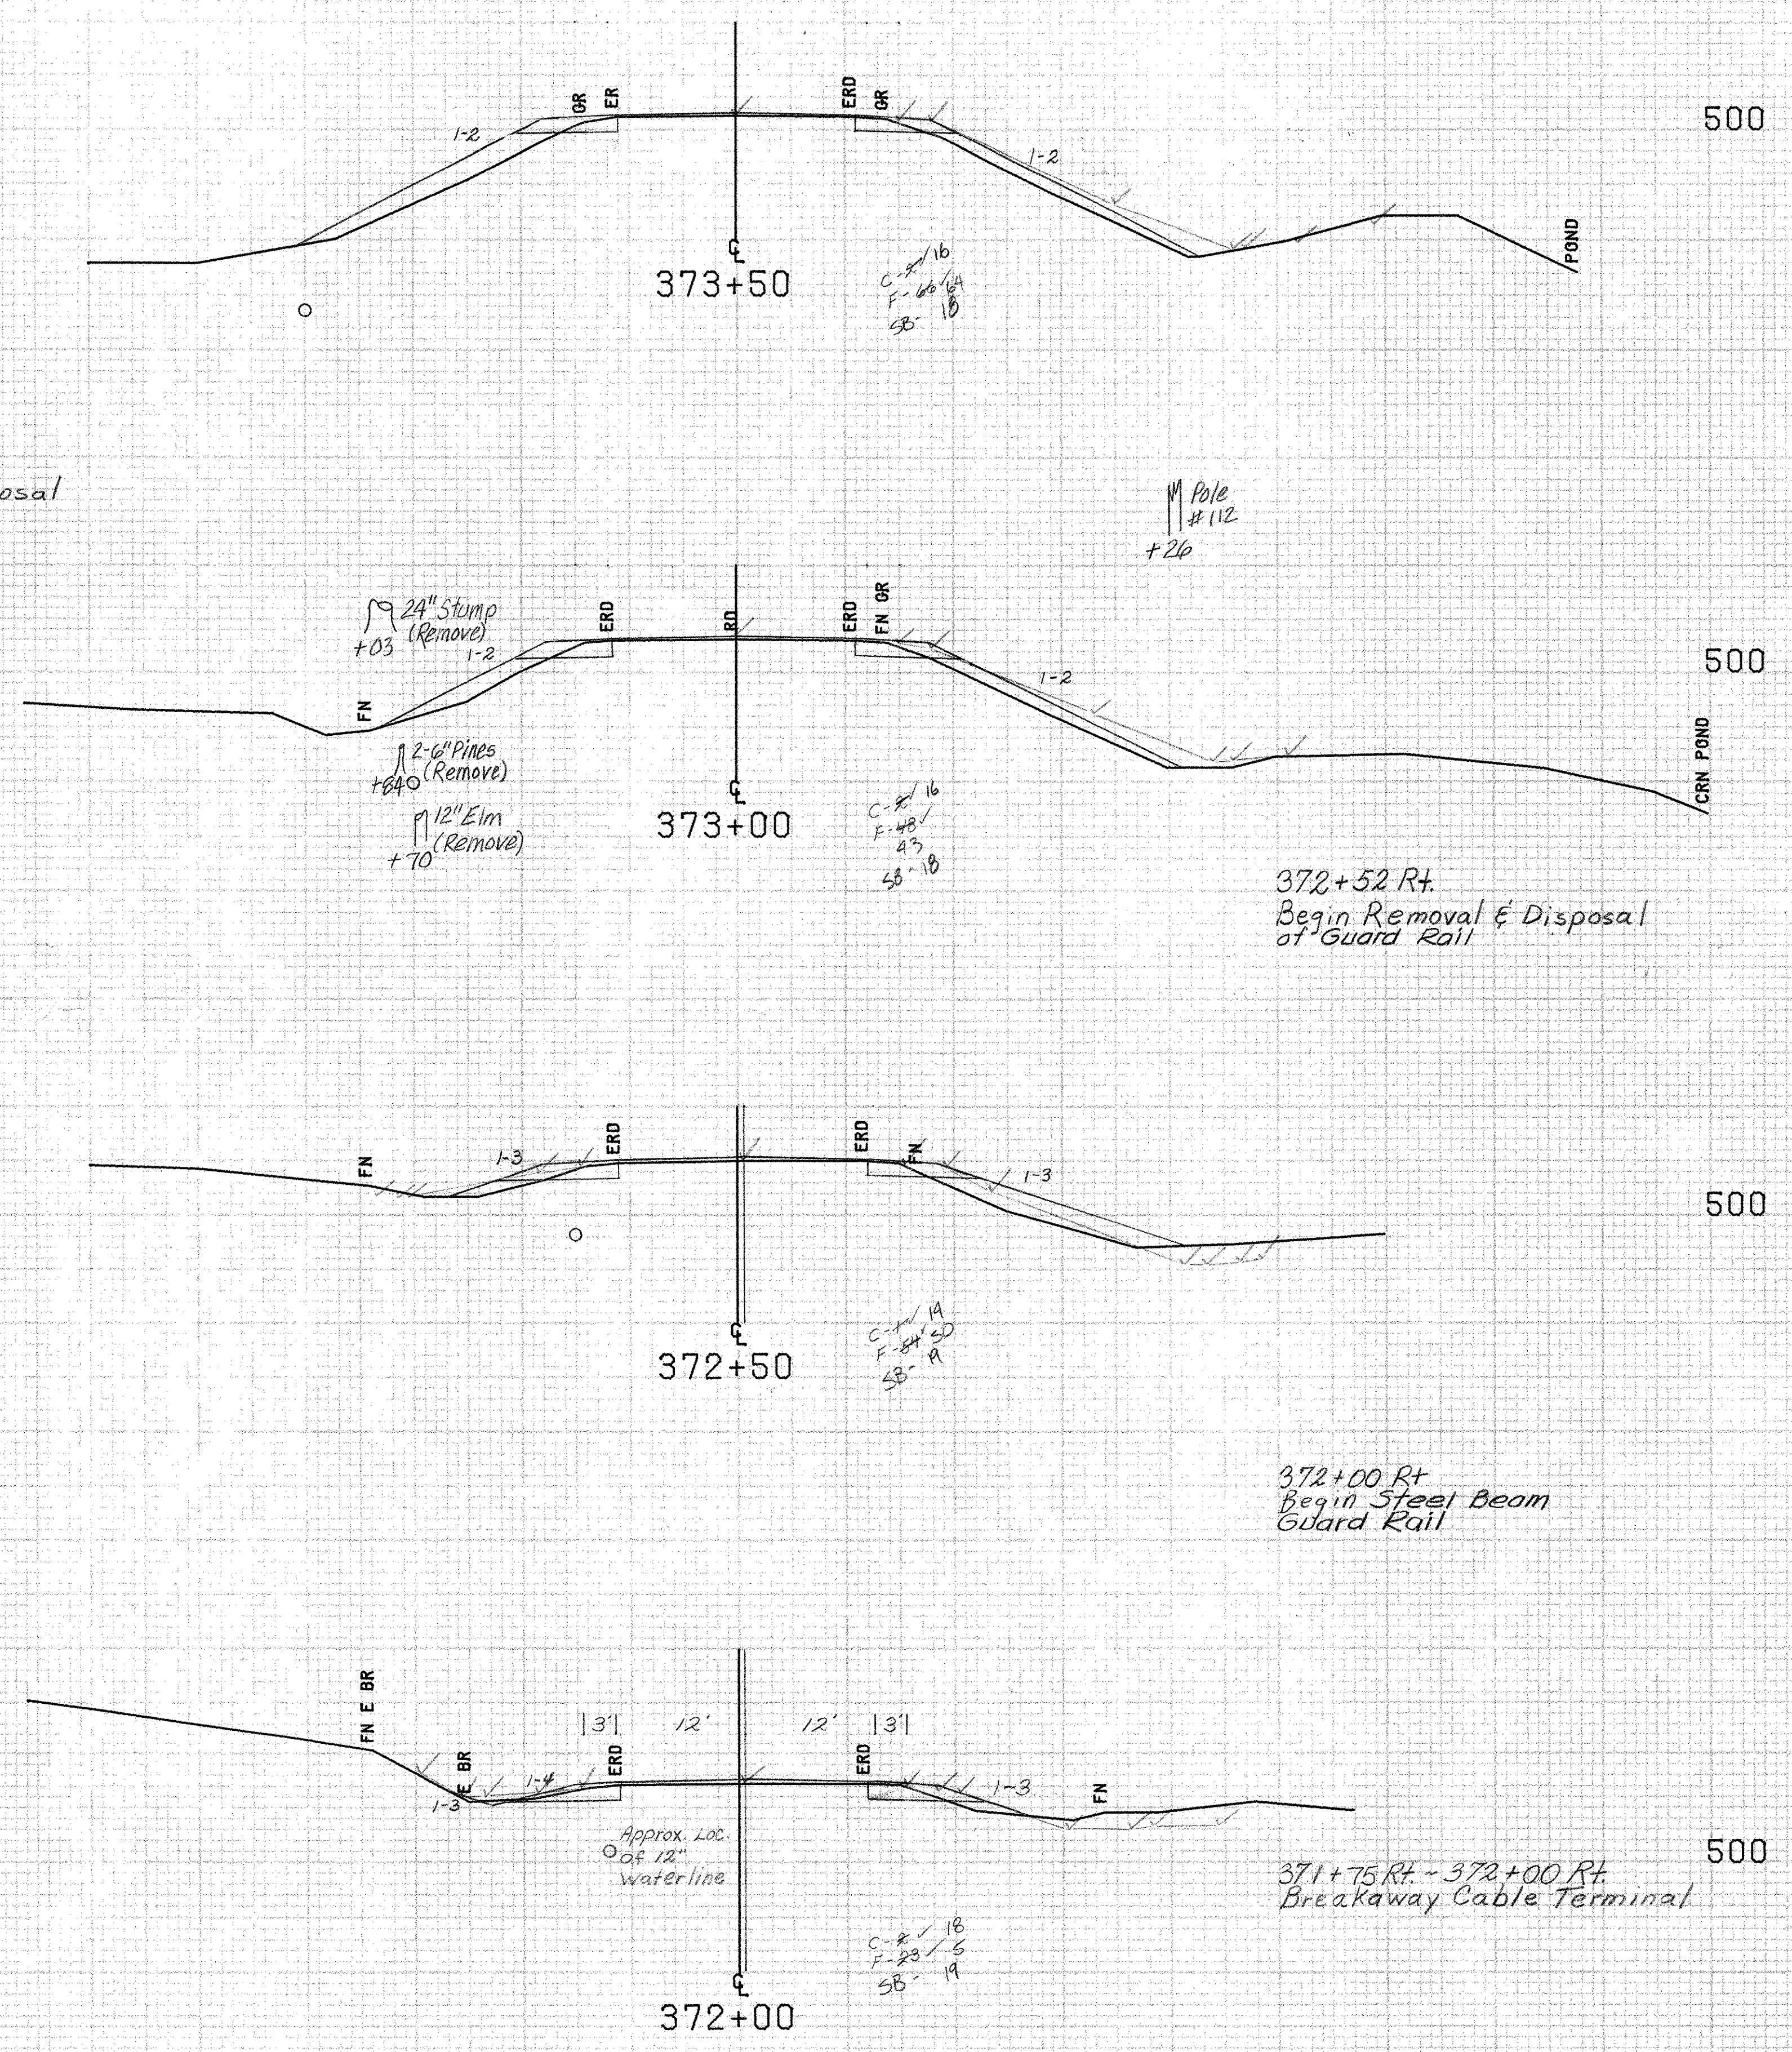

372+52 Rt.
Begin Removal & Disposal
of Guard Rail

372+00 Rt.
Begin Steel Beam
Guard Rail

371+75 Rt. ~ 372+00 Rt.
Breakaway Cable Terminal

For Additional Guard-
rail Detail, See Stan.
Sht. G-1b

For Additional BCT
Detail, See Std. Sheet
G-14

Field
Dr.

ADDISON MM 0.71 ~ MM 0.94

FROM STA.	372+00	TO STA.	373+50
PROJECT NAME	SHOREHAM-BRIDPORT-ADDISON		
NO.	F017-1(2)	PLOTTED	03/13/84
SURVEYED BY	FANTONI	FEB 84	
SHEET	376 OF 422 SHEETS	SHEET	376 OF 477

SCALE 1" = 10 FEET