
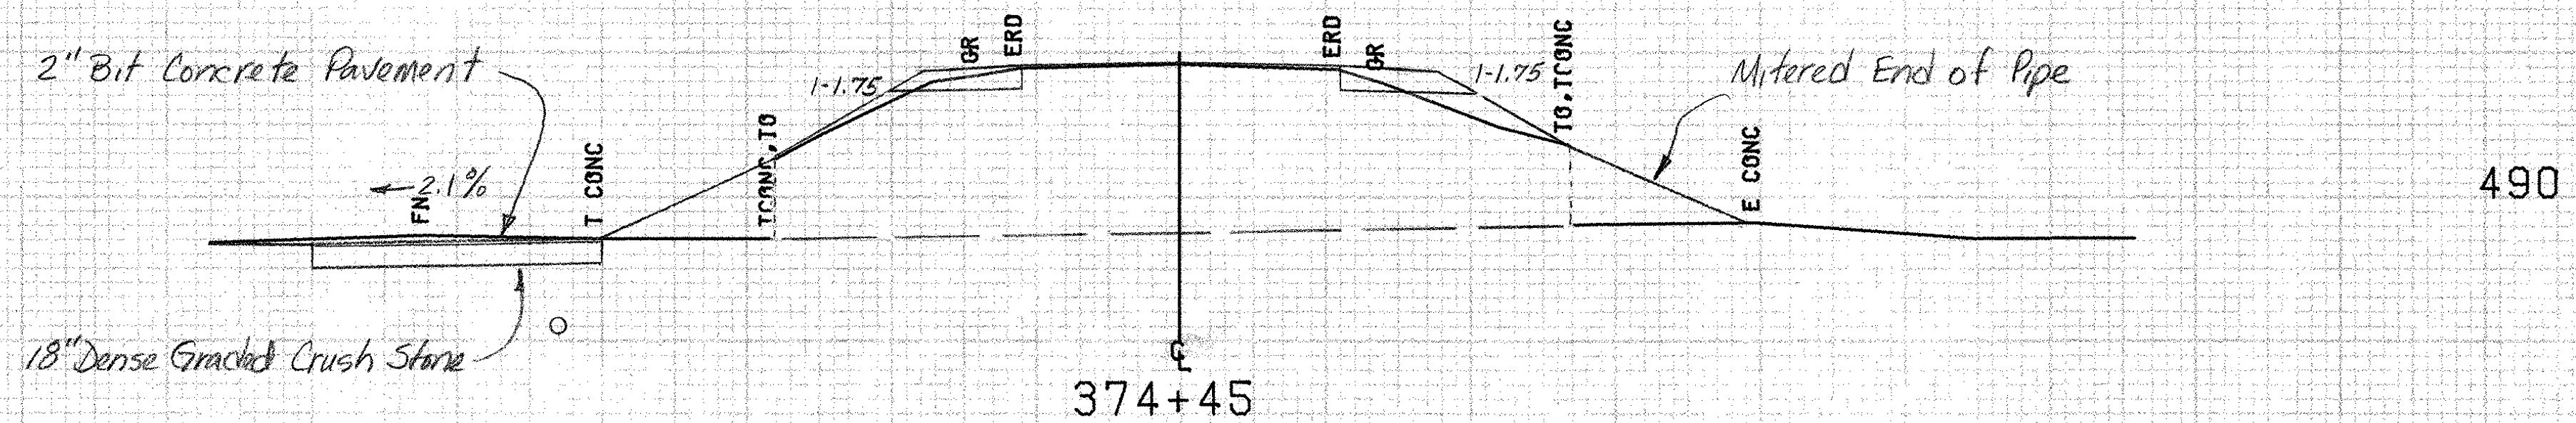




374+82 Lt.  
End Removal & Disposal  
of Guard Rail

374+75 Rt. (20 FT)  
REMOVAL OF EXISTING FENCE (NON-PART.)  
#11 Pole  
374+75 Rt.  
+55 End Removal & Disposal  
of Guard Rail

374+45 Lt.  
2" Bituminous Concrete Pad  
(Paid as Bituminous Concrete Gutters And Traffic Islands)

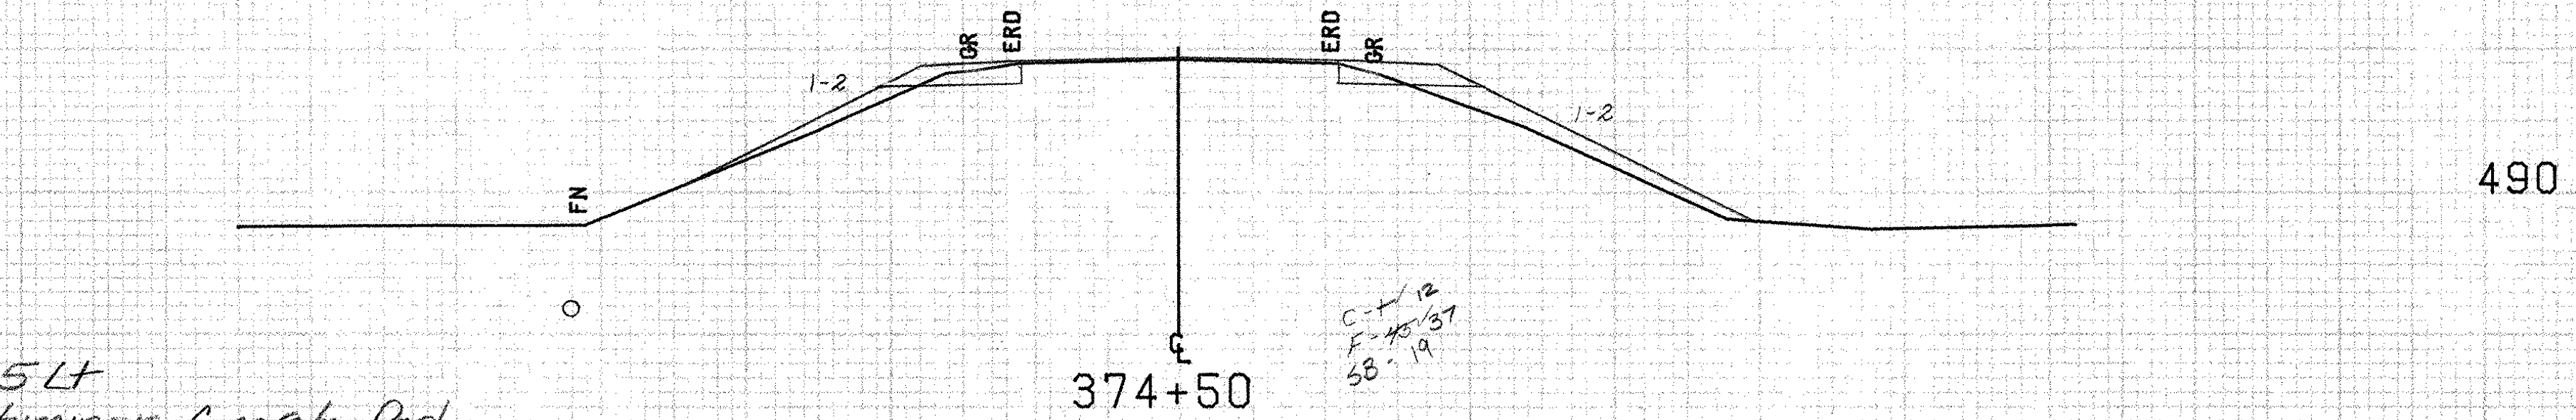

Exist 72" CGMP Cattle Pass - Retain  
Repair Floor w/ 1/4" Bituminous Concrete Pavement See Detail Sheet 173 of 420  
(PAID AS BITUMINOUS CONCRETE GUTTERS AND TRAFFIC ISLANDS WHICH WILL INCLUDE A TACK COAT OF EMULSIFIED ASPHALT OF ALL SURFACES UNDER NEW PAVEMENT.)  
THE EXISTING FLOOR SHALL BE CLEANED OF ALL ORGANIC MATERIAL + BROKEN CONCRETE PRIOR TO THE PLACING OF BITUMINOUS CONCRETE PAVEMENT.  
(PAID AS BLAST CLEANING OF CONCRETE SURFACES - Item 523.10)

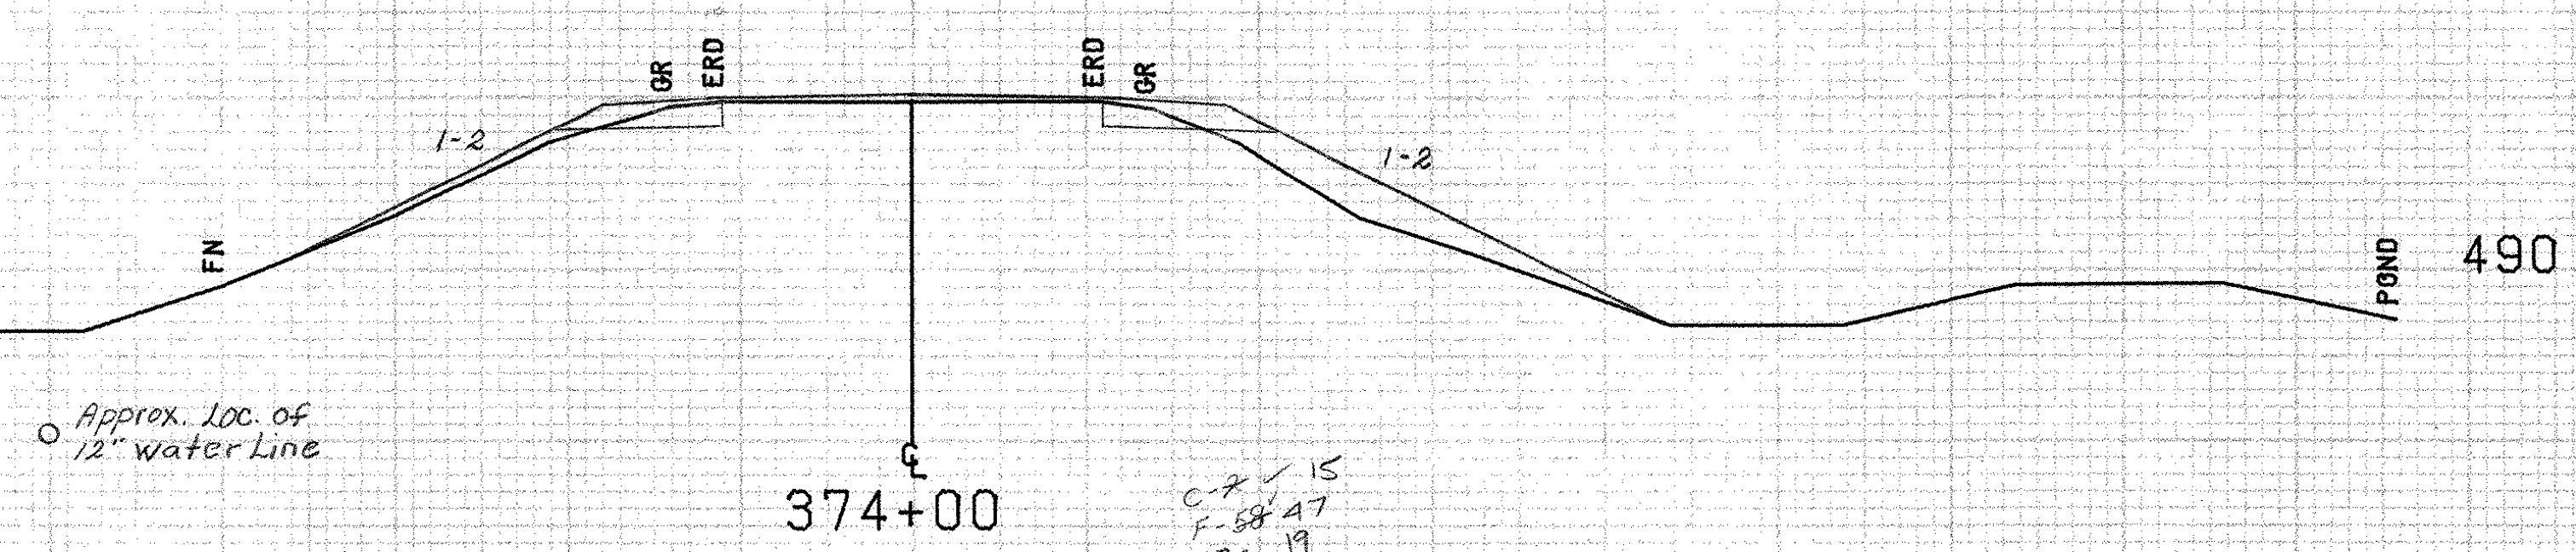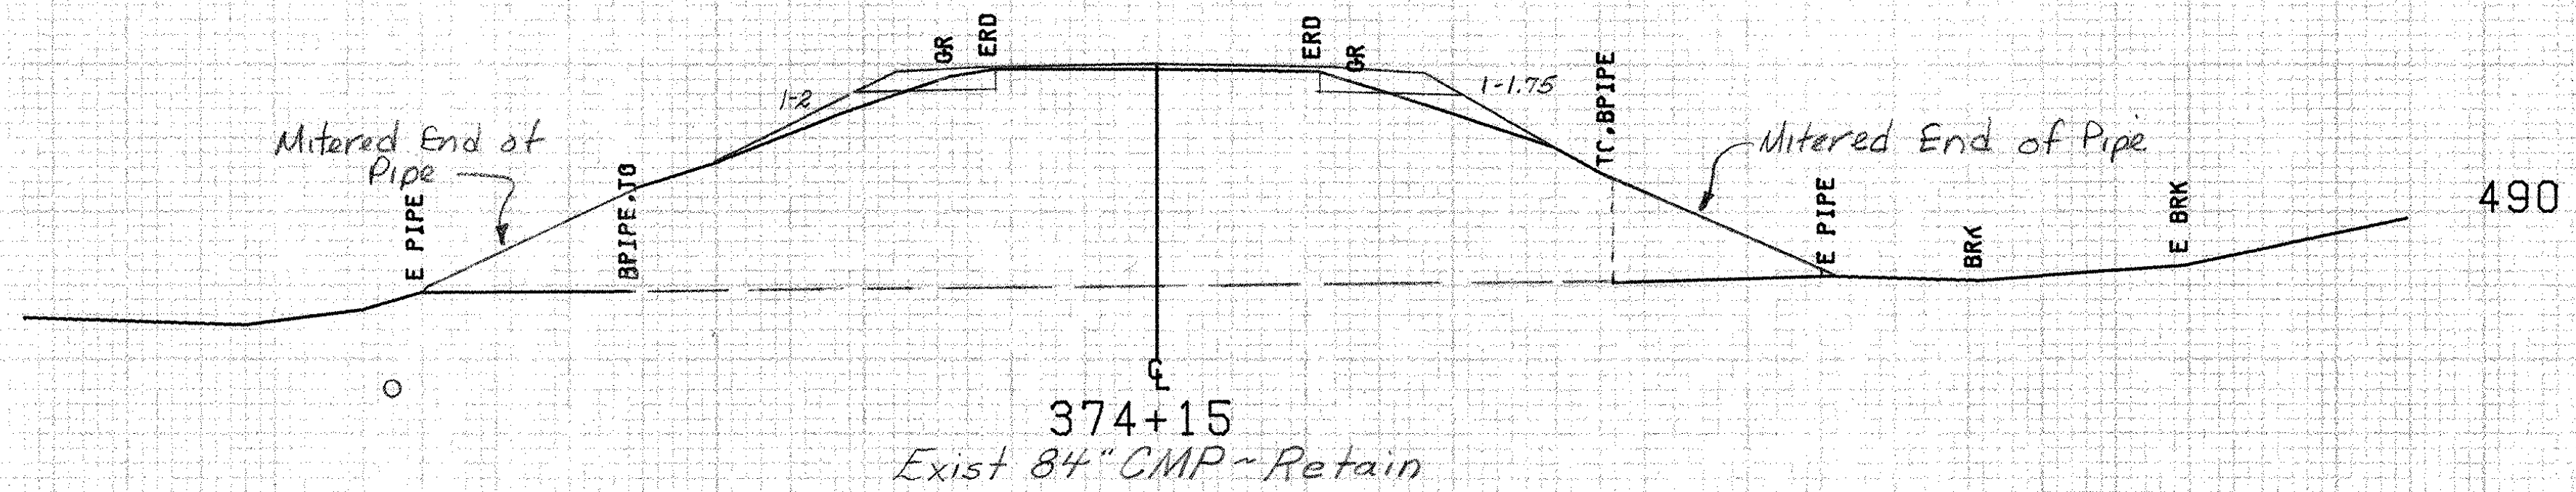

ADDISON MM 0.71 ~ MM 0.94

FROM STA.	374+00	TO STA.	374+50
PROJECT NAME	SHOREHAM-BRIDPORT-ADDISON		
NO.	F017-1(2)	PLOTTED	03/13/84
SURVEYED BY	FANTONI	FEB	84
SHEET	377 OF 420 SHEETS	SHEET	397 OF 477

SCALE 10 FEET