



EARTH	
20.27	499.6
20.27	498.3
25.0	495.3
29.0	492
33.0	501.1
20.27	499.5
24.03 ✓	

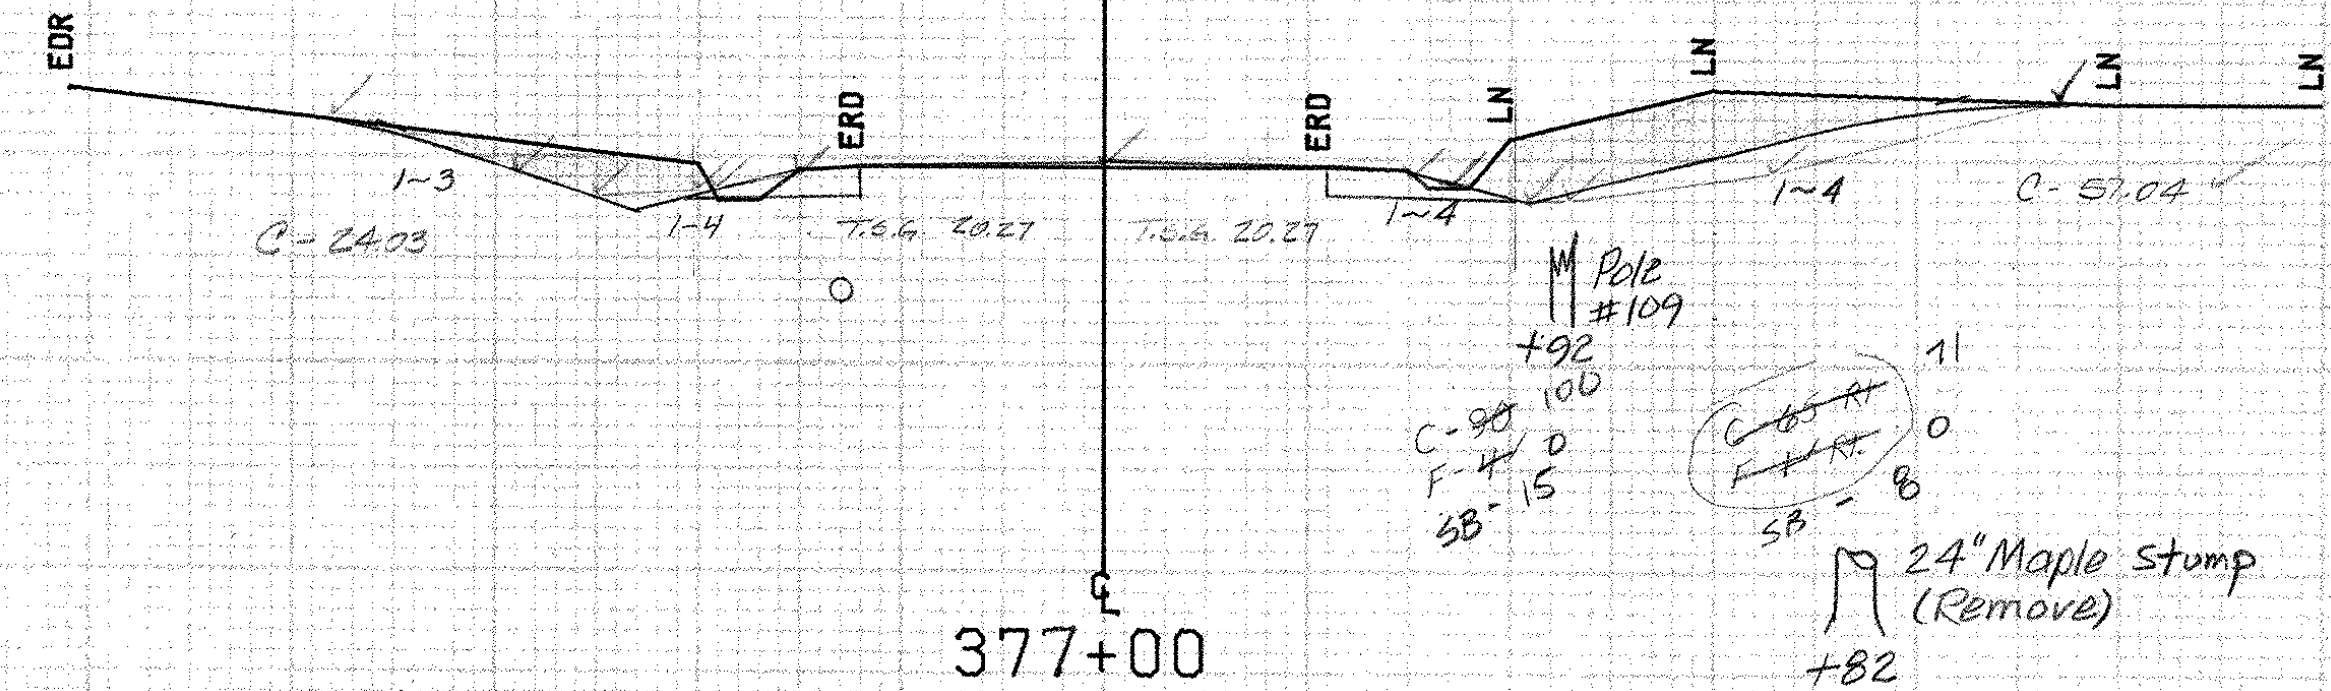

EARTH	
20.27	501.0
20.27	498.0
45.0	503.0
30.0	503.4
20.27	501.0
57.04 ✓	

490



EARTH	
21.0	499.0
23.0	497.4
32.0	501.0
22.0	499.0
21.0	499.0
9.00 ✓	

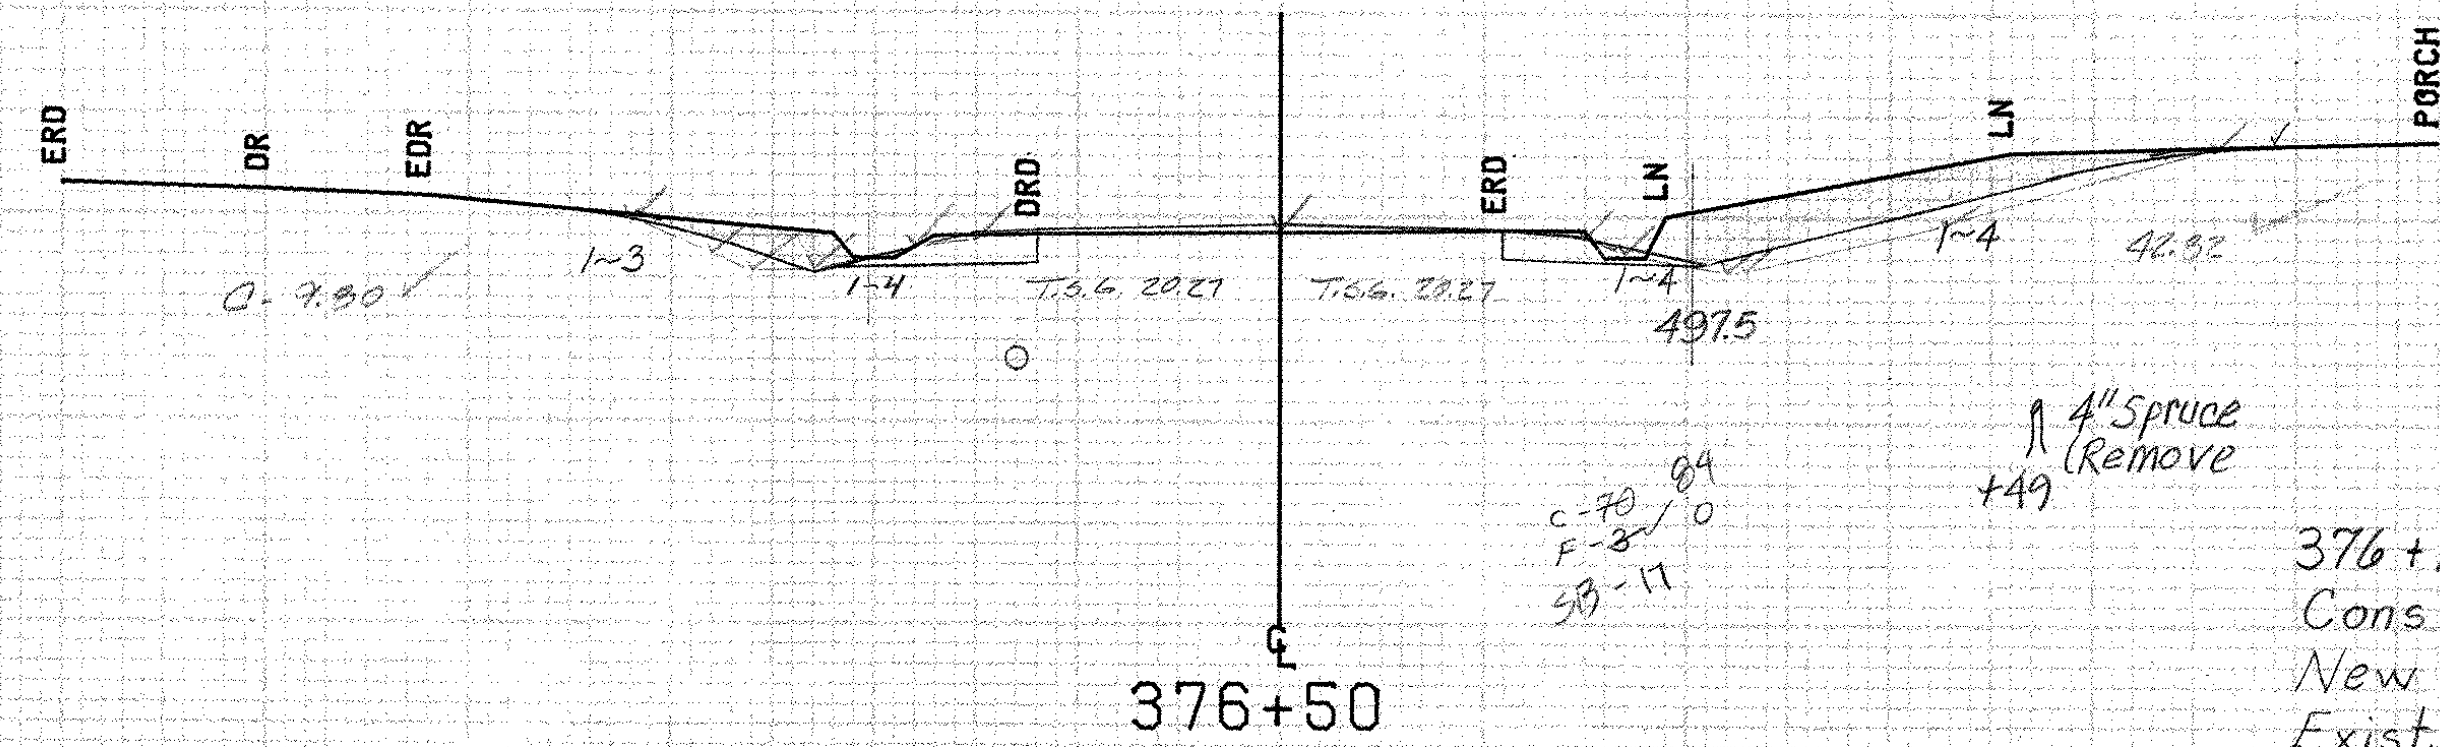

EARTH	
20.27	502.2
20.27	498.0
21.0	497.3
45.0	503.3
36.0	503.2
20.27	502.2
42.82 ✓	

490

376+12 Rt.  
Construct Drive (12' wide - Gravel)  
New 15" x 34' CSP (06A)  
Exist. 15" CMP - Remove

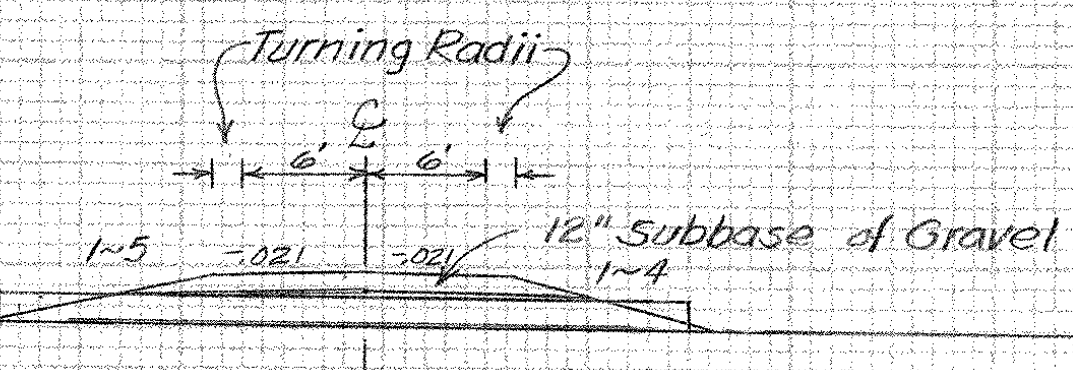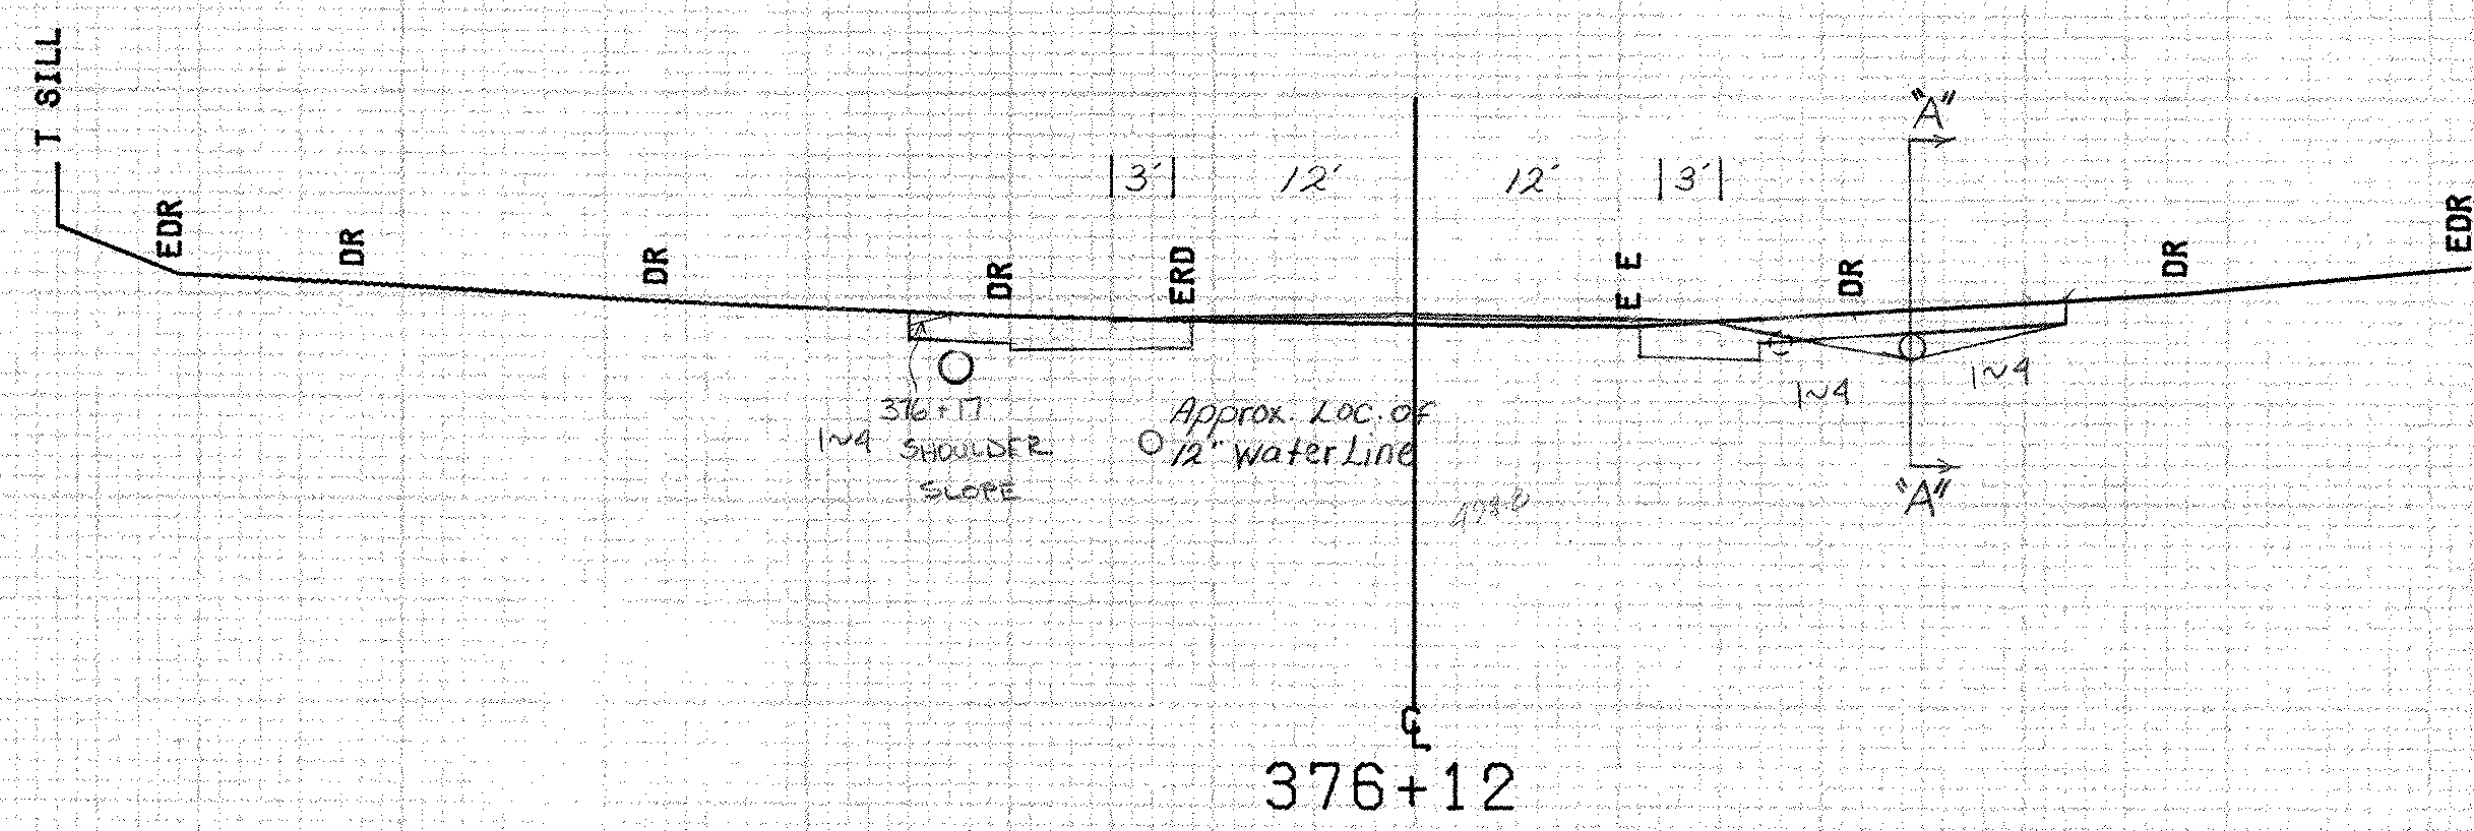

490

490

ADDISON MM 0.71 ~ MM 0.94

FROM STA.	376+12	TO STA.	377+00
PROJECT NAME	SHOREHAM-BRIDPORT-ADDISON		
NO.	F017-1(2)	PLOTTED	03/13/84
SURVEYED BY	FANTONI	FEB	84
SHEET	399 OF 420 SHEETS	SHEET	399 OF 477

SCALE 10 FEET