



EARTH	
19.0	501.0
19.0	500.0
20.0	500.0
25.0	501.2
35.0	505.0
29.0	504.8
24.0	503.2
19.0	501.0
25.0	

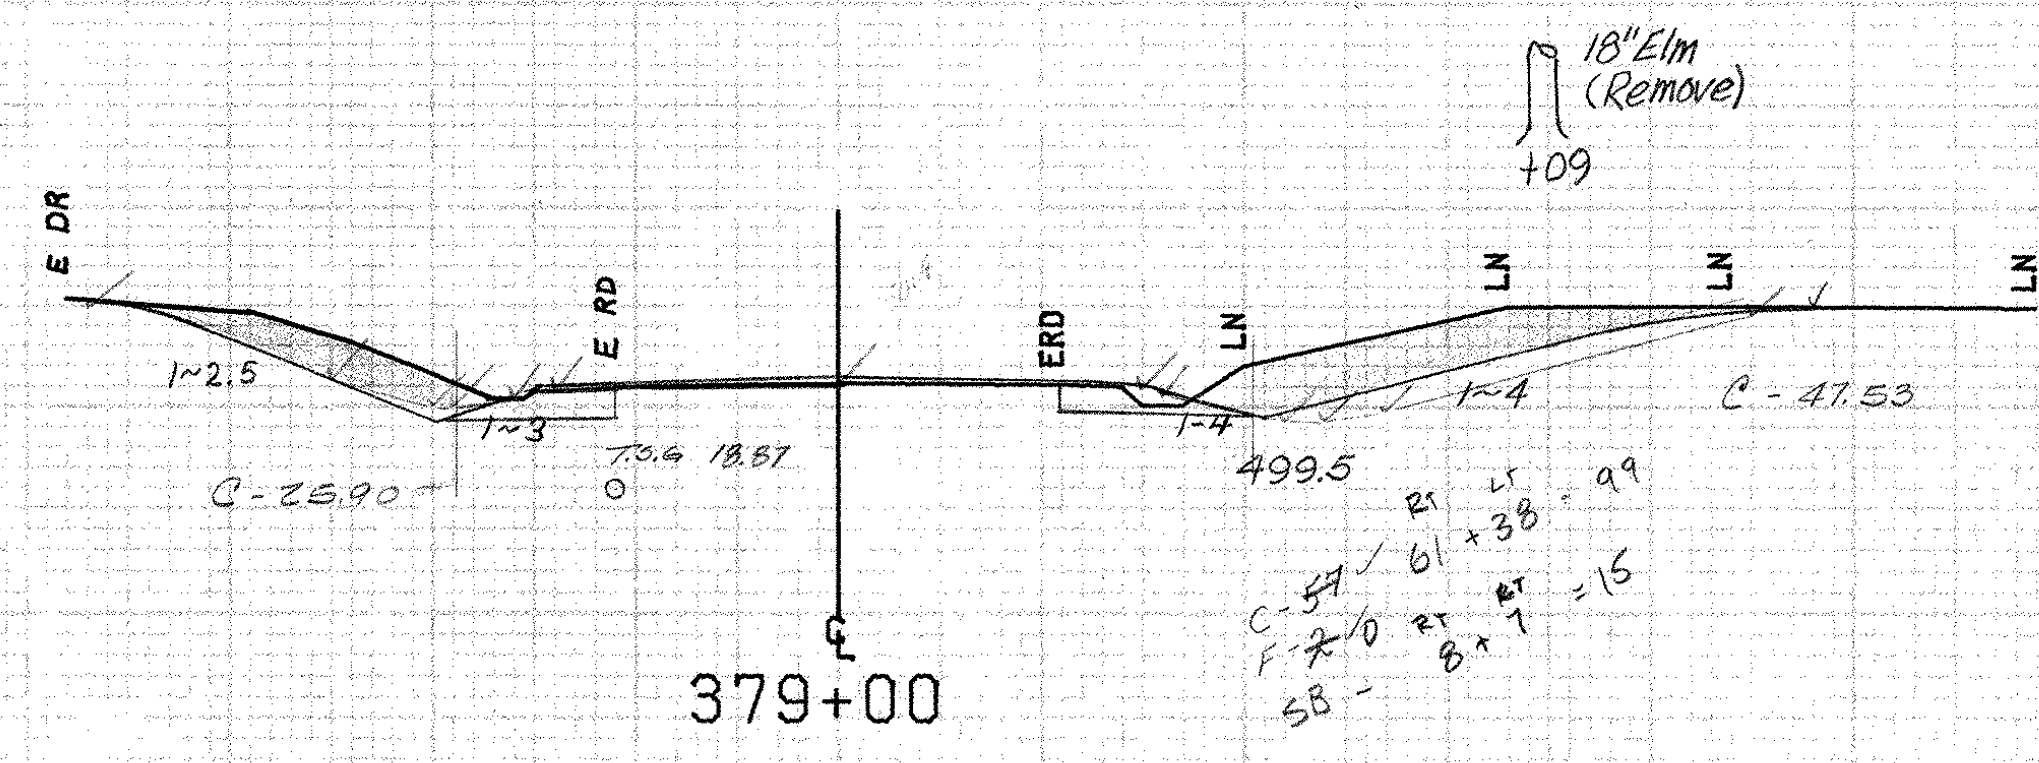

EARTH	
20.27	502.0
20.27	499.6
21.0	499.3
44.0	505.1
33.0	505.0
20.27	501.0
47.53	

500

EARTH	
19.0	500.3
19.0	499.7
20.0	499.1
21.0	500.0
25.0	501.0
37.0	505.8
33.0	505.7
21.0	502.0
19.0	500.3
29.0	

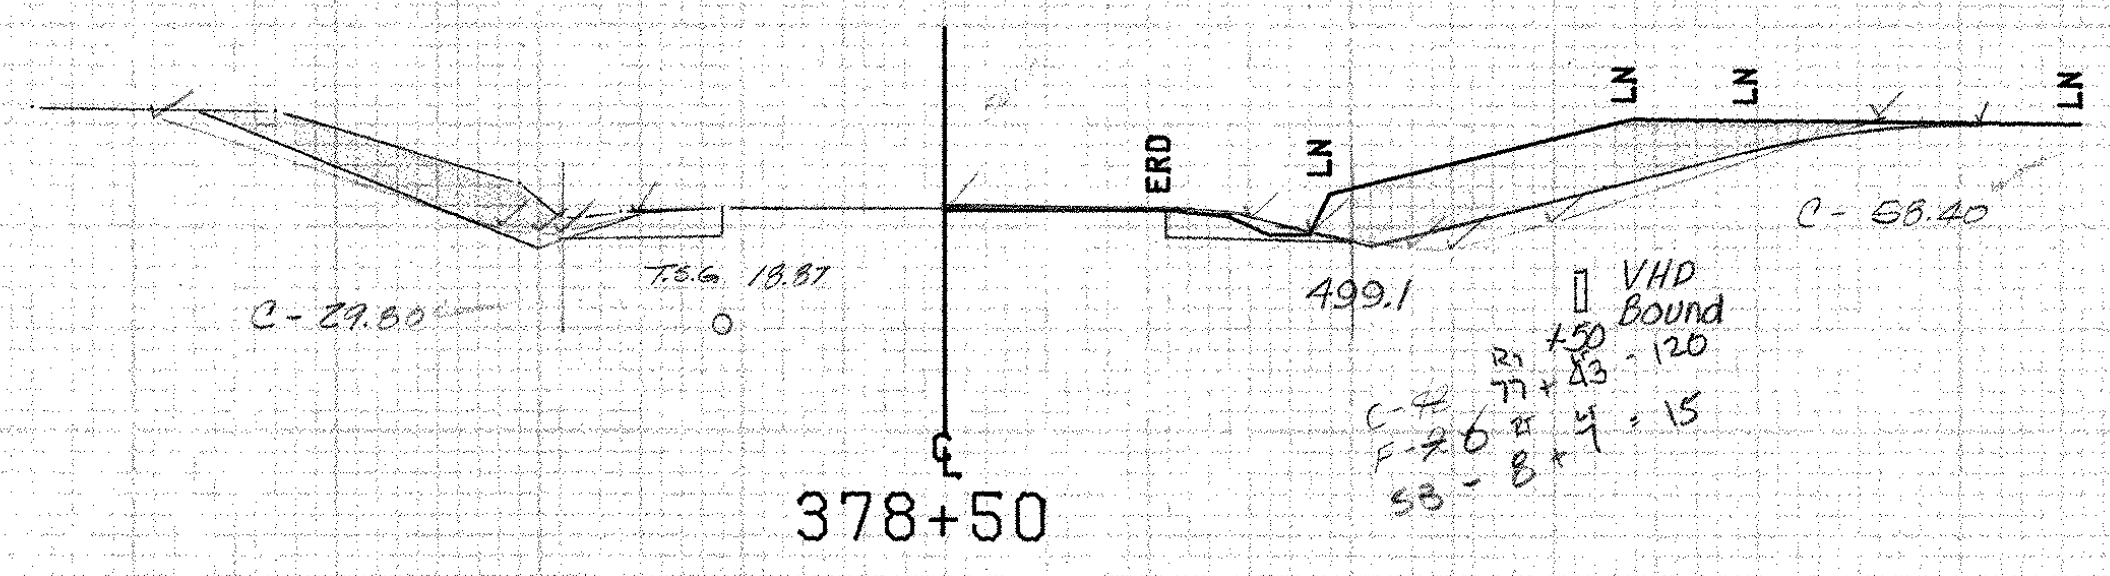


EARTH	
20.27	502.0
20.27	499.2
21.50	499.1
45.0	505.0
34.0	505.2
20.27	502.0
58.40	

500

376+29 ~ 380+10 Rt
Construct Special Ditch (To be paid as Common Excavation)


EARTH	
19.0	499.4
19.0	499.0
21.0	499.0
38.0	504.0
30.0	504.2
24.0	502.0
19.0	499.4
29.25	

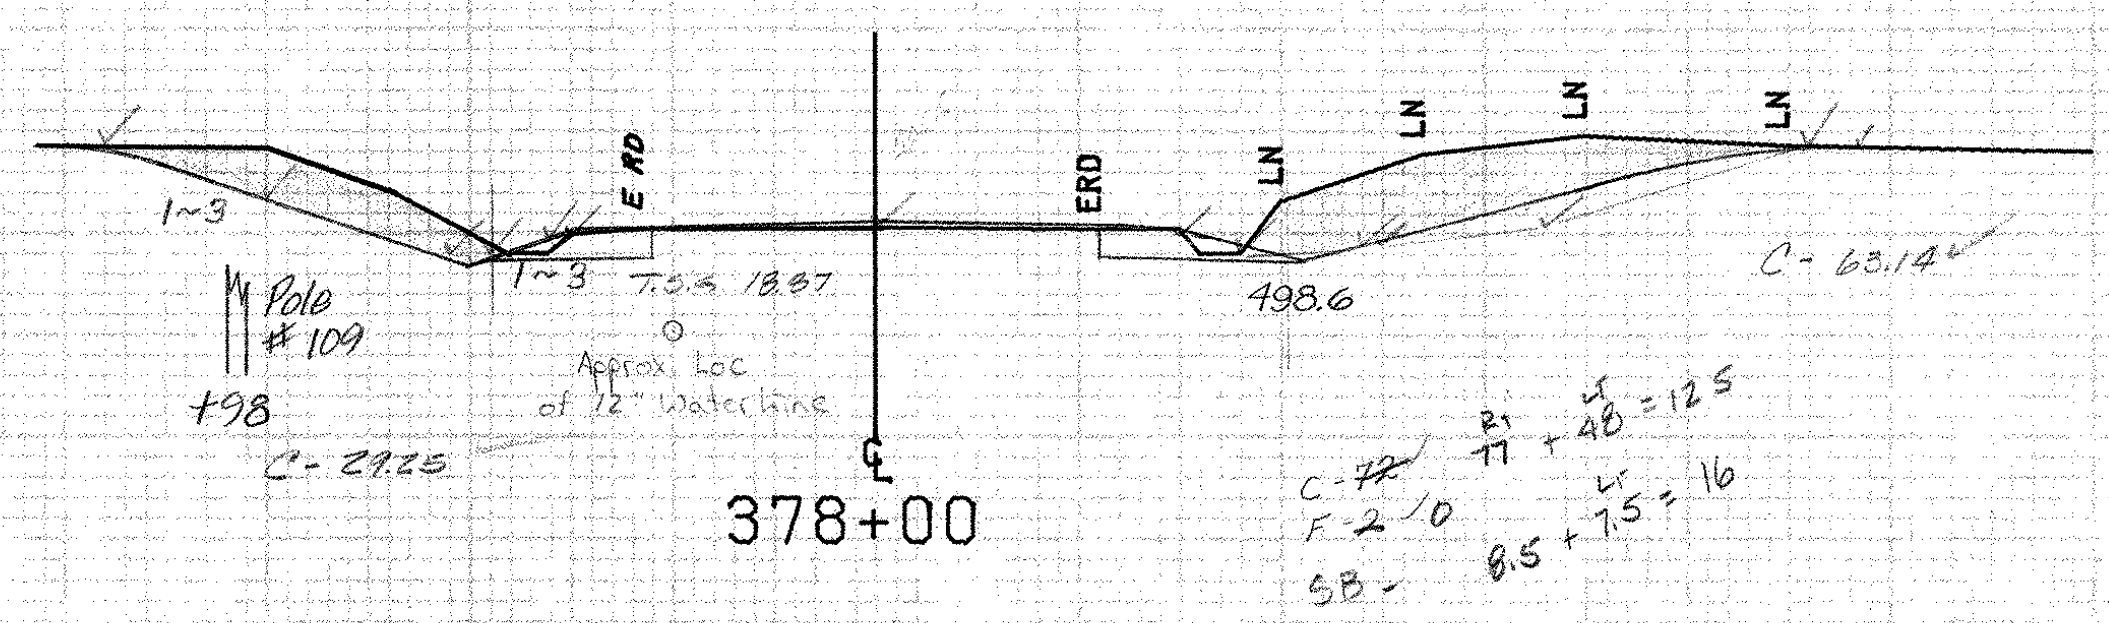

EARTH	
20.27	501.8
20.27	499.0
24.0	499.8
44.0	504.4
35.0	504.9
22.0	504.0
20.27	501.5
63.14	

500

EARTH	
19.0	499.1
19.0	498.9
20.0	498.7
22.0	498.7
36.0	503.5
35.0	503.1
19.0	499.1
13.70	

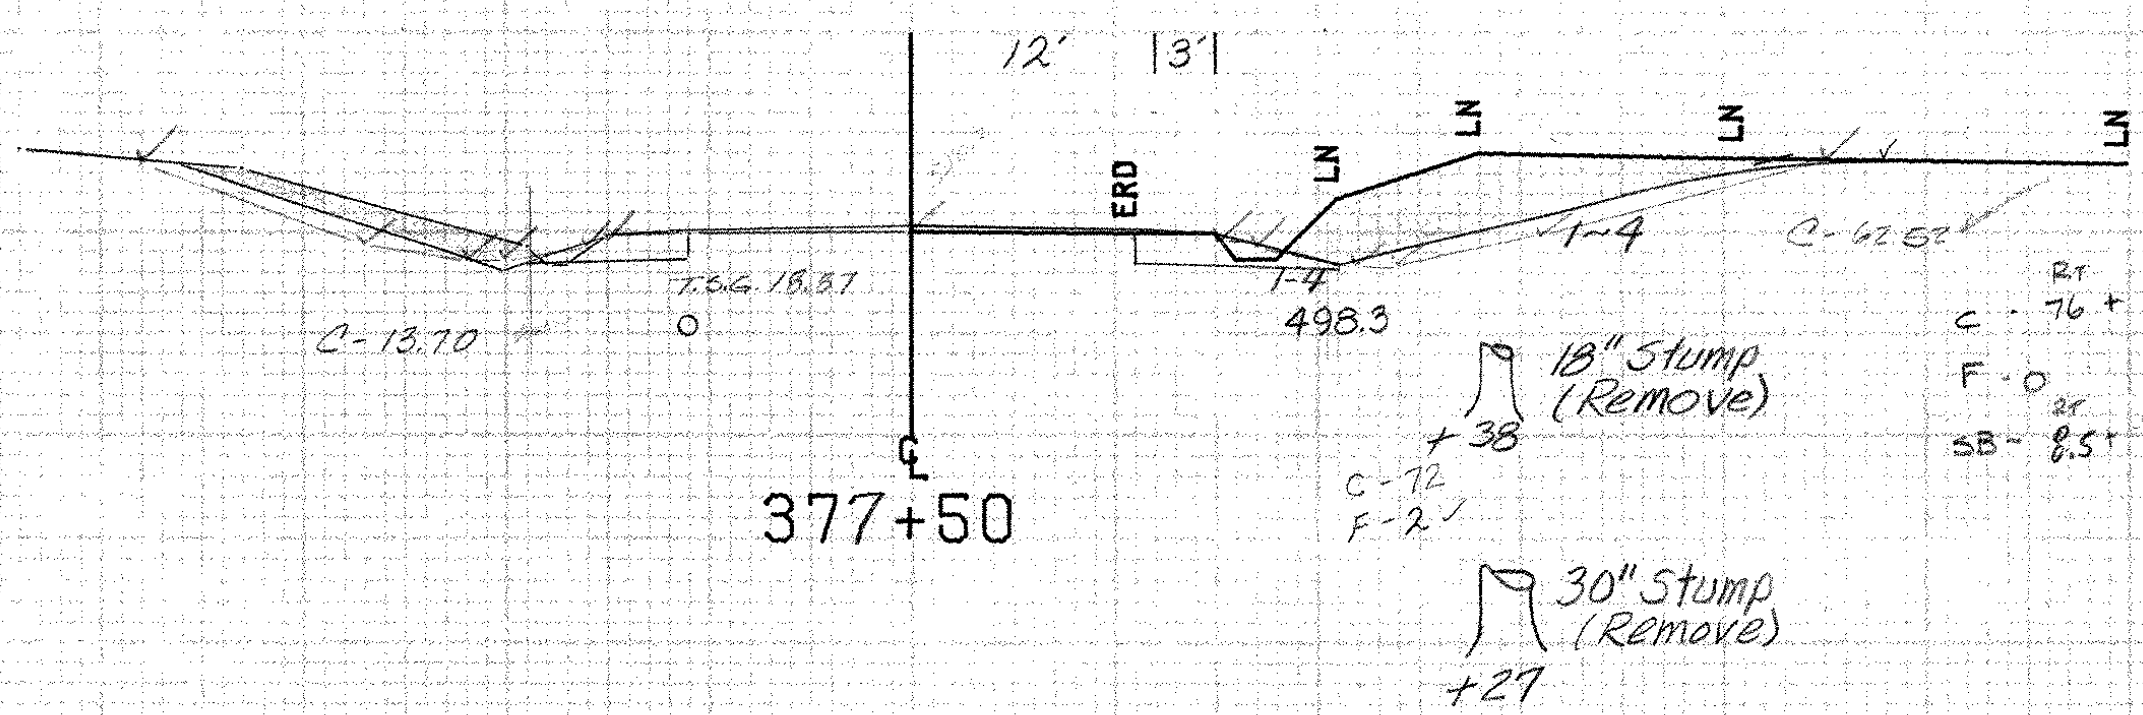

EARTH	
20.27	501.2
20.27	498.4
21.50	498.3
44.0	503.7
22.0	503.0
21.0	501.6
20.27	501.2
62.52	

500

ADDISON MM 0.71 ~ MM 0.94

FROM STA.	377+50	TO STA.	379+00
PROJECT NAME	SHOREHAM-BRIDPORT-ADDISON		
NO.	F017-1(2)	PLOTTED	03/13/84
SURVEYED BY	FANTONI	FEB 84	
SHEET	400	OF	420 SHEETS
		SHEET	400 OF 477

SCALE 1" = 10 FEET