
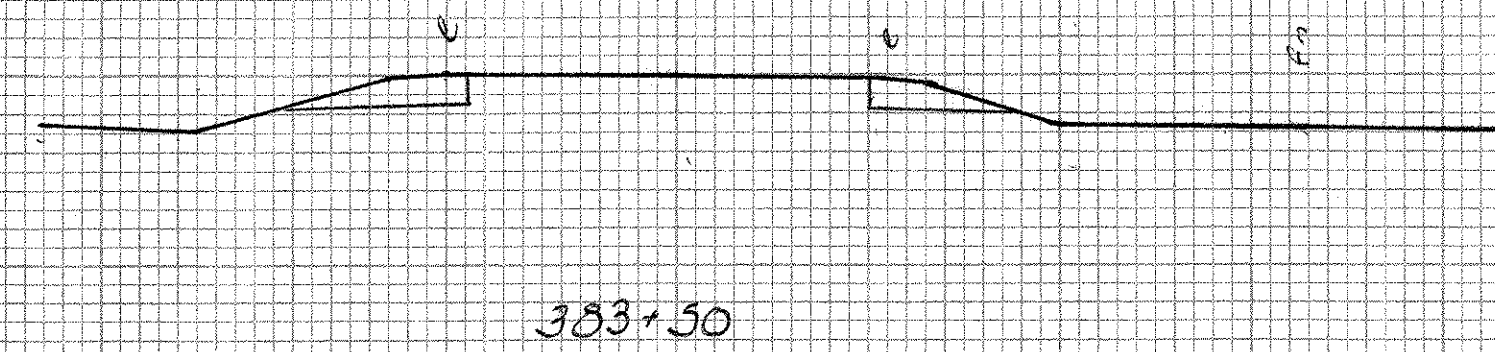
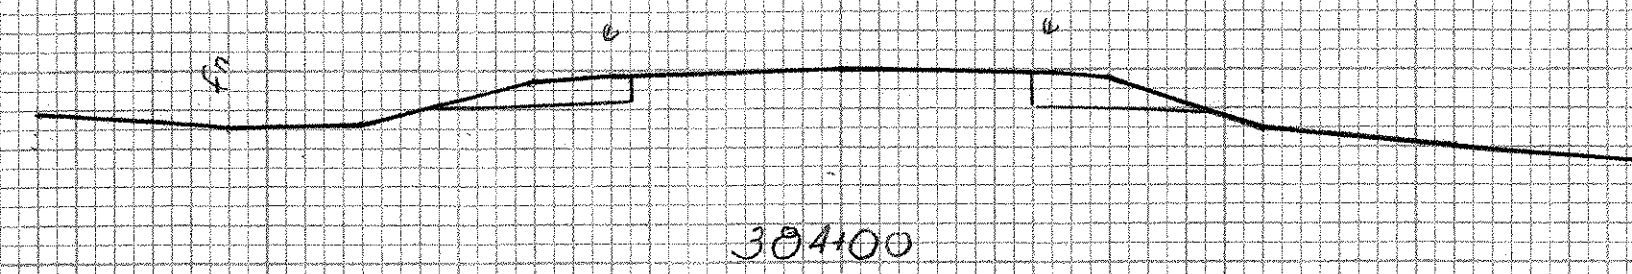


FINAL SURVEY NOTE BOOK No.	REVISIONS	BY	DATE
	PLOTTED		
	TEMPLATE		
	AREAS CHECKED		

ORIGINAL SURVEY NOTE BOOK No.	REVISIONS	BY	DATE
	PLOTTED		
	TEMPLATE		
	AREAS CHECKED		

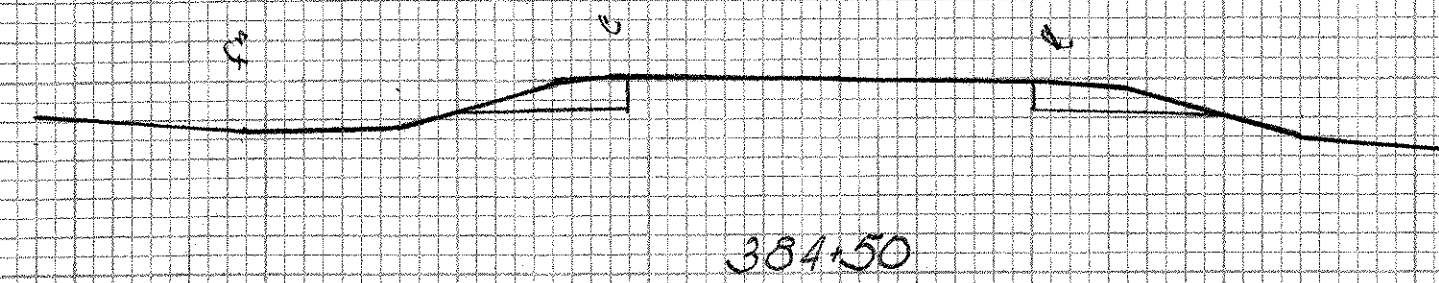

SHOREHAM-BRIDPORT-ADDISON
FOIT-1(2)

383+50-384+50

PIGMEY & HENRY F. ROSSETT