

FINAL SURVEY NOTE BOOK No. _____

DATE _____

BY _____

REVIEWED BY _____

PLOTTED BY _____

DATE _____

AREAS CHECKED _____

ORIGINAL SURVEY NOTE BOOK No. _____

DATE _____











BY _____

REVIEWED BY _____

PLOTTED BY _____

DATE _____

AREAS CHECKED _____

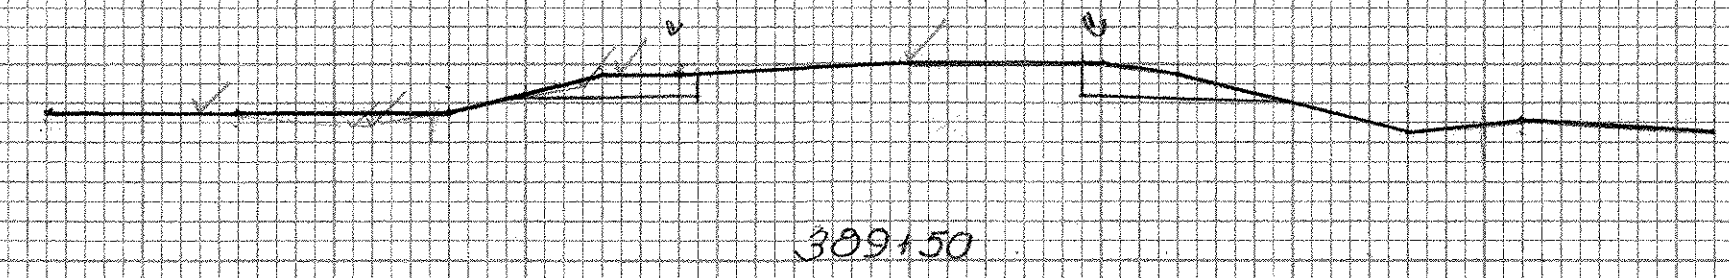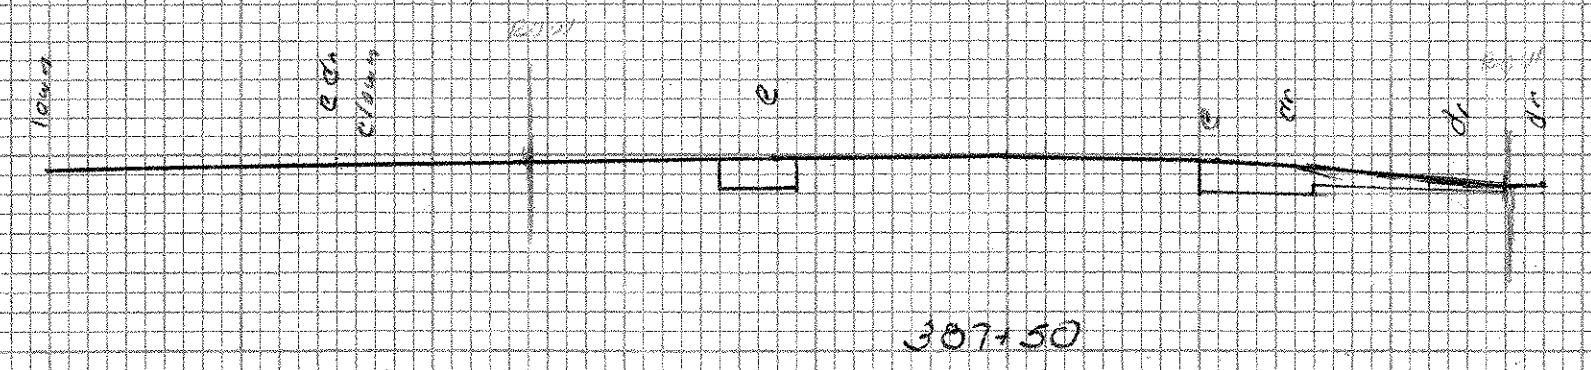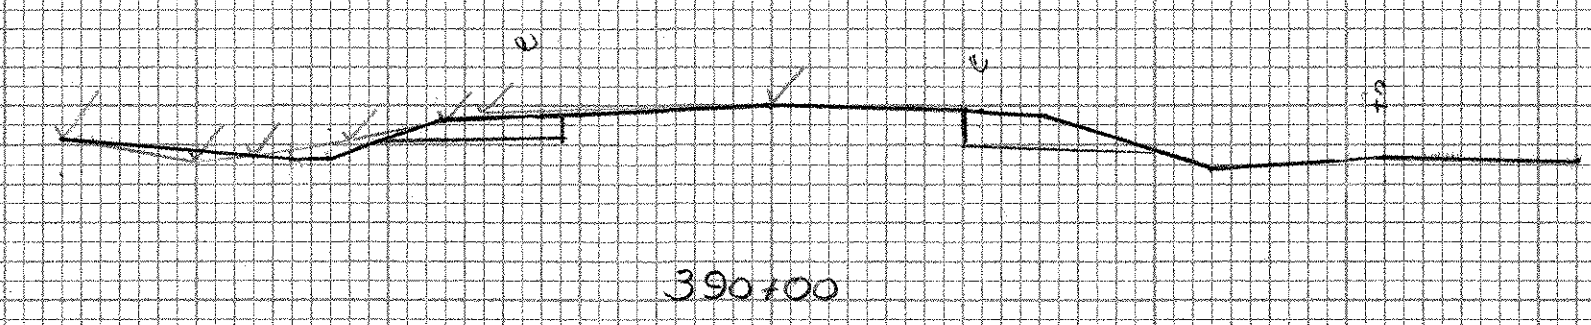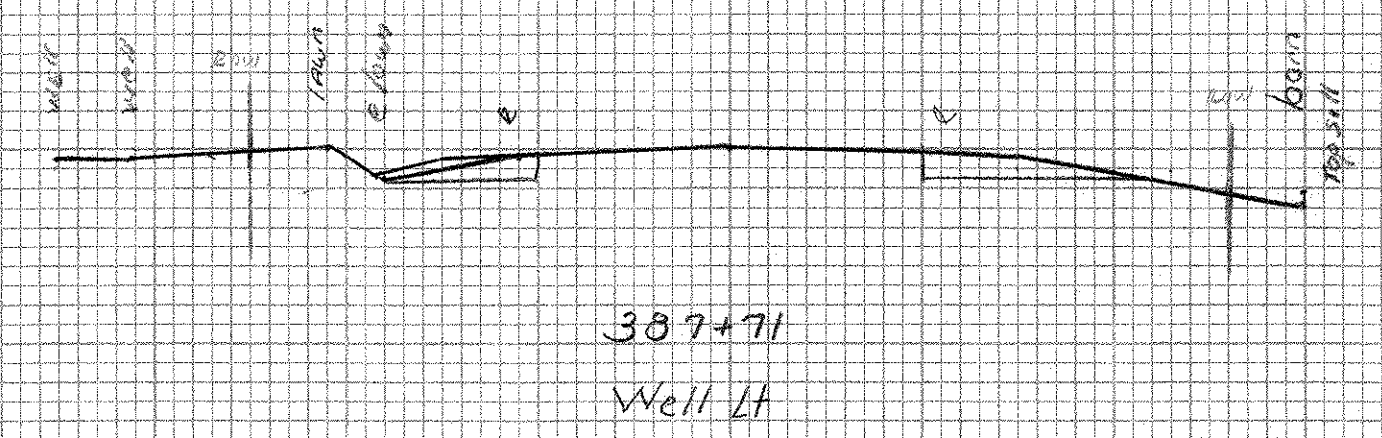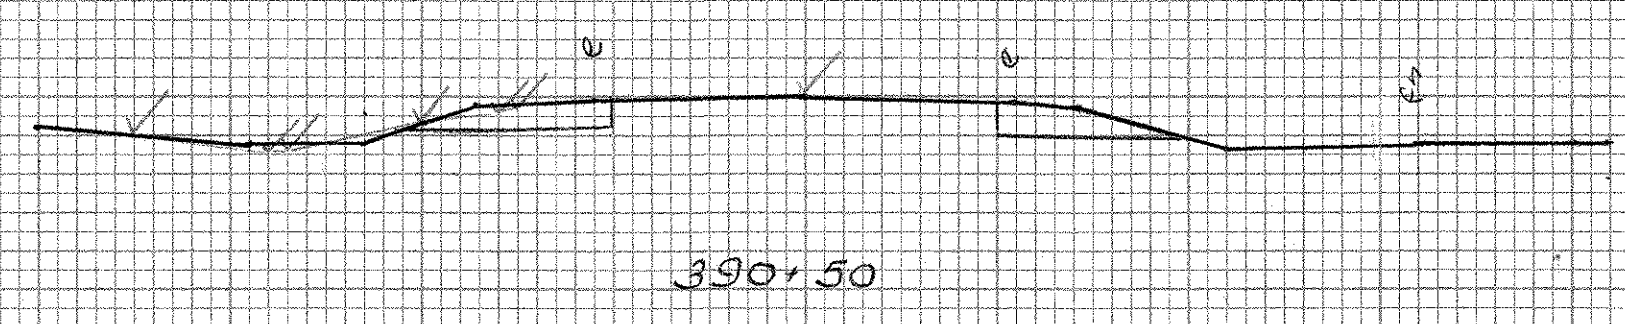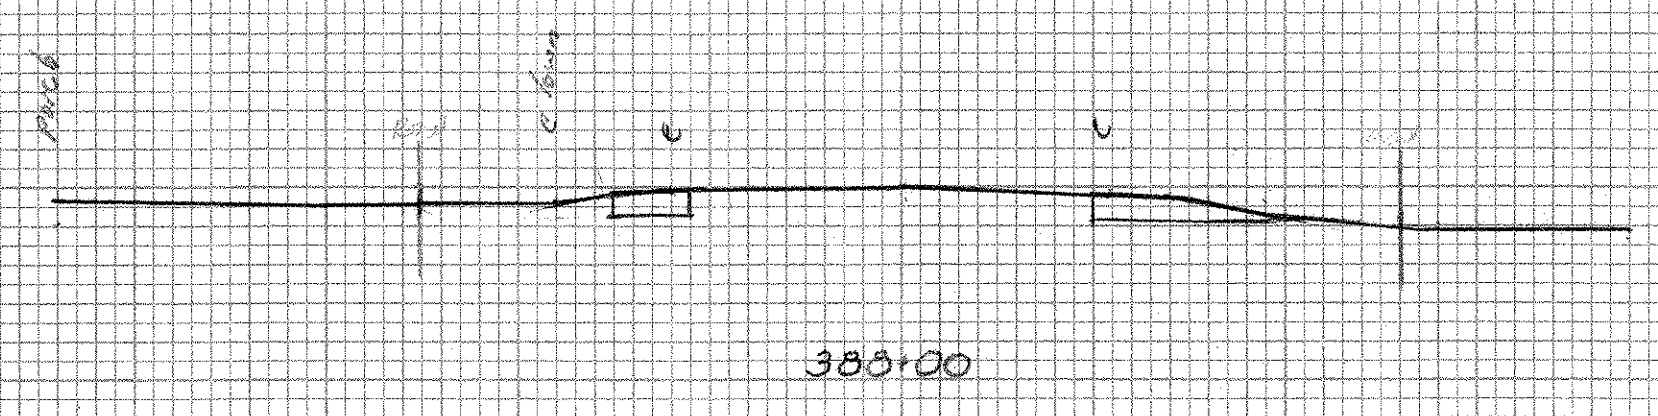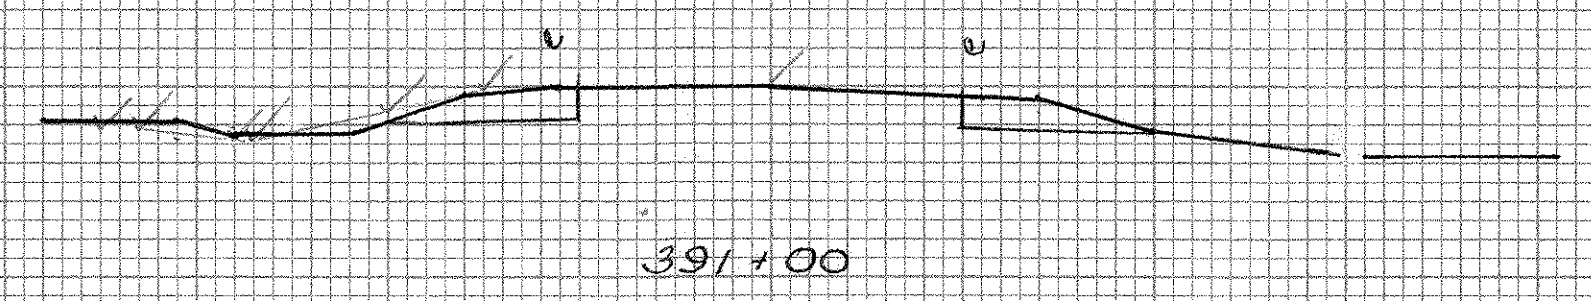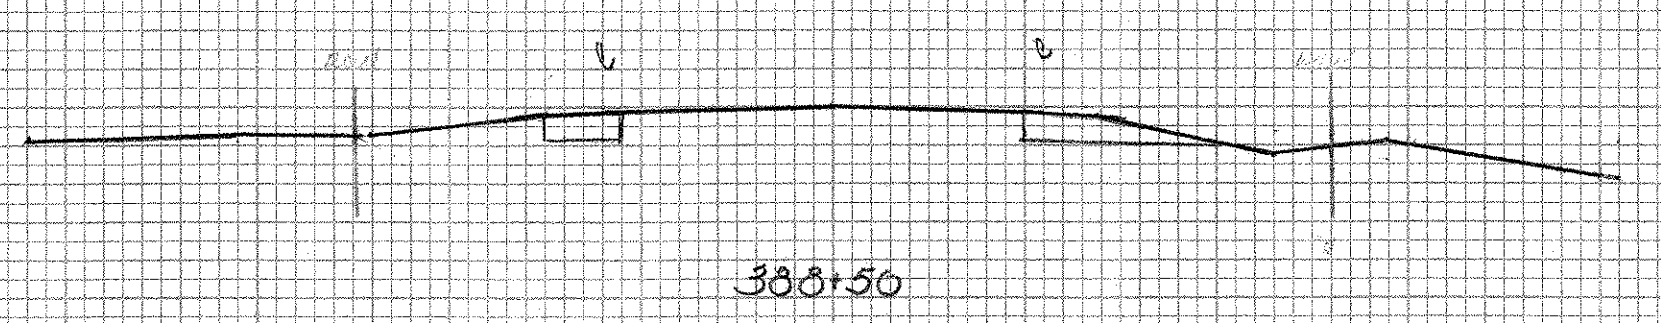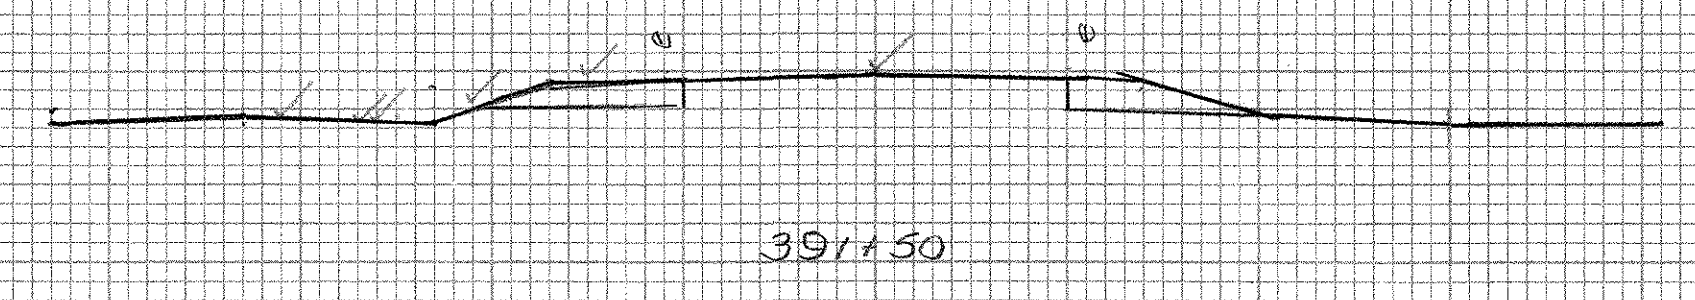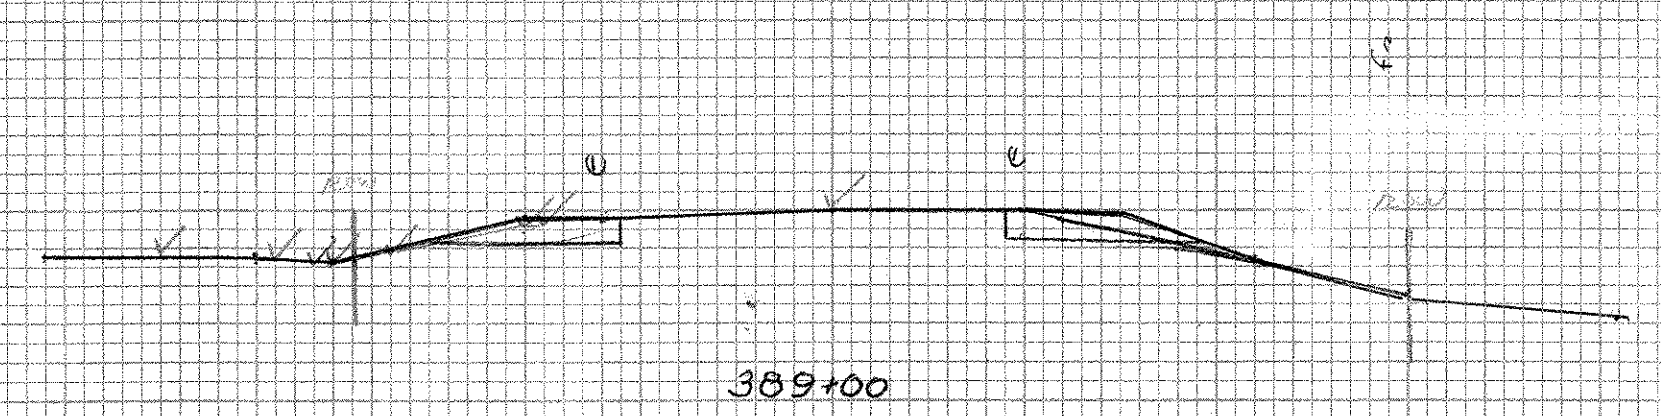

SHOREHAM-BRIDPORT-ADDISON
FOIT-1(2)

387+50 - 391+50