



DATE	
BY	
REVIEWED	
PLOTTED	
AREA CHECKED	
NO.	

DATE	
BY	
REVIEWED	
PLOTTED	
AREA CHECKED	
NO.	

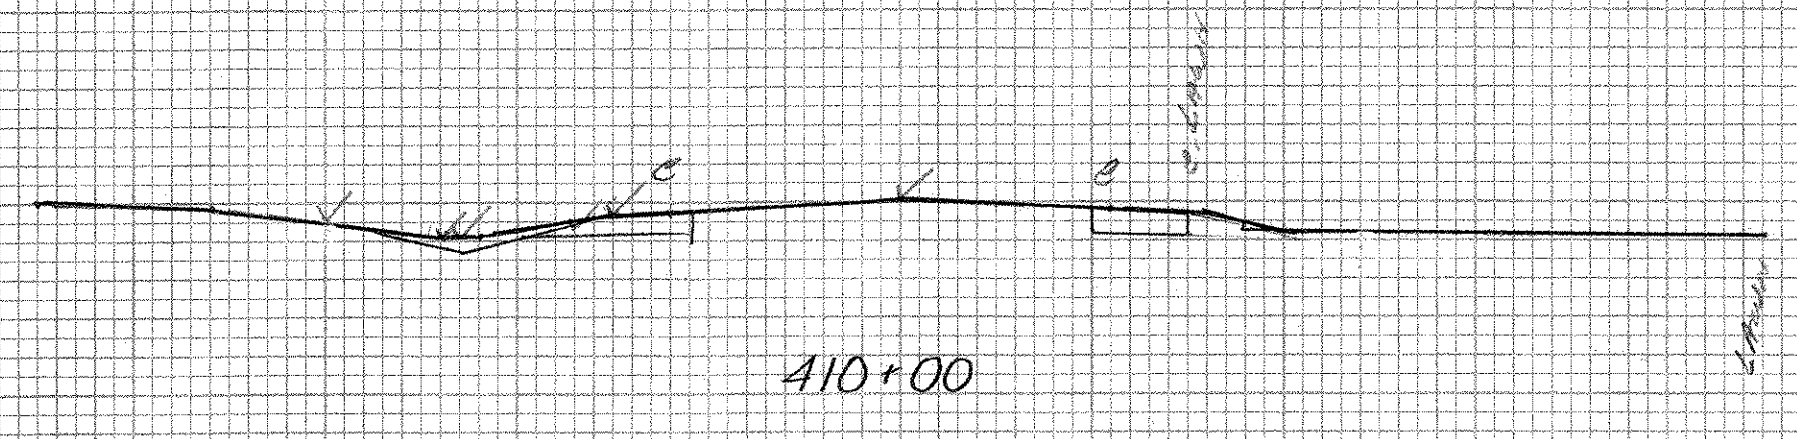


410+00

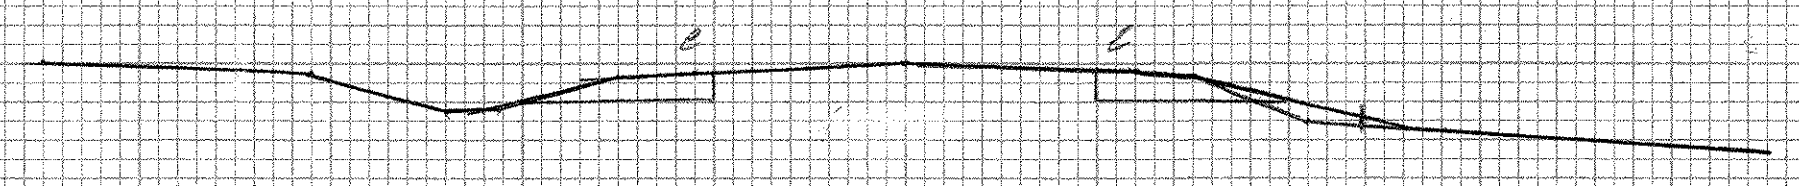


412+00

Earth


22.0	425.0
24.0	427.5
30.0	432.7
32.0	435.0
1.50	

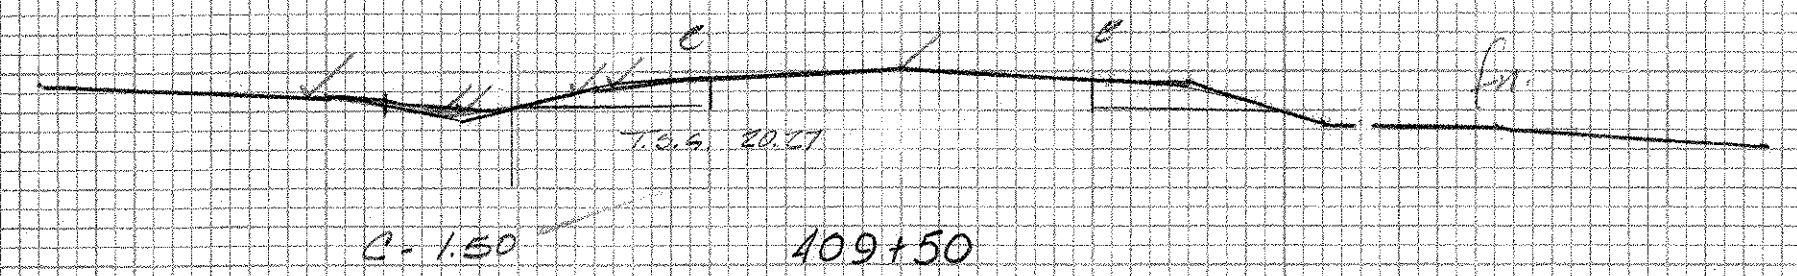


409+50

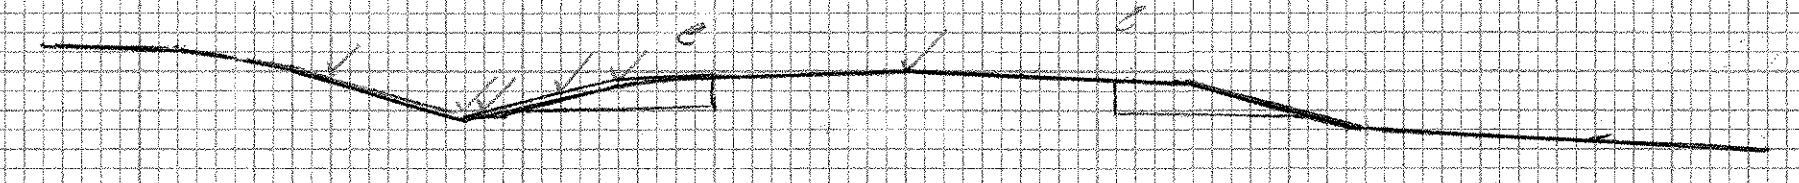


411+50

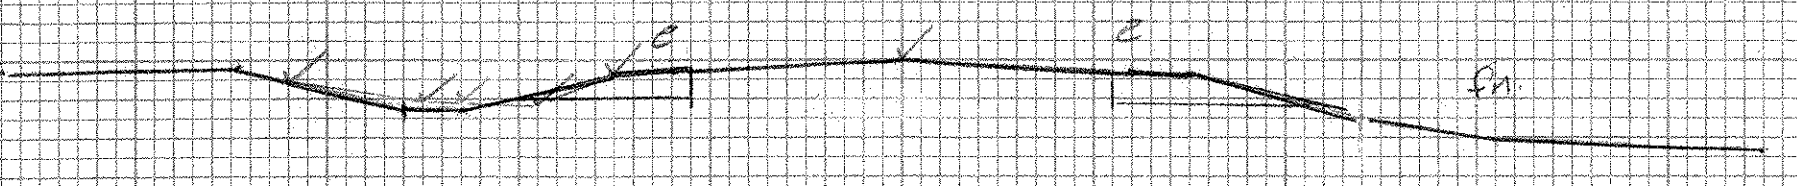

409+00

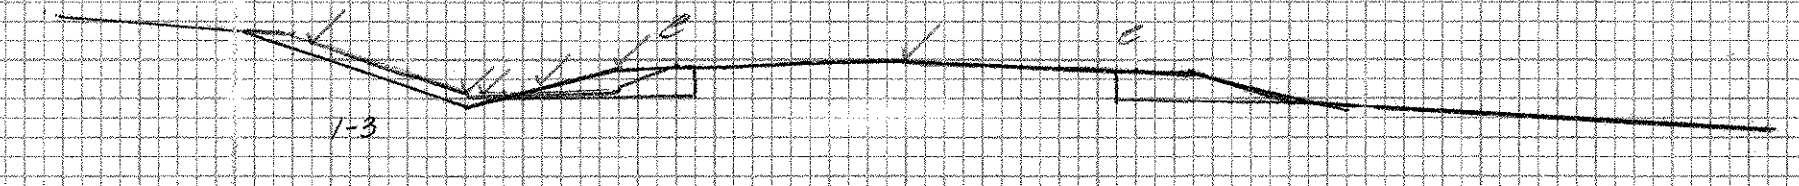

411+00

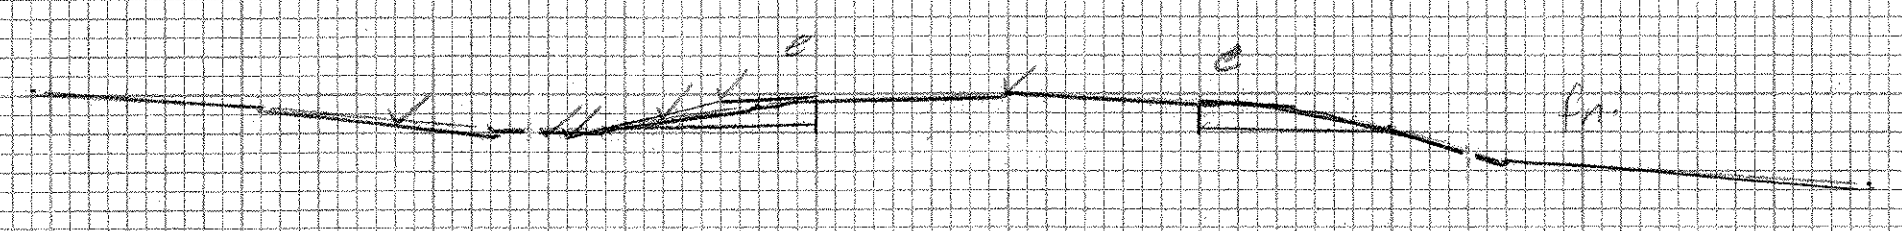

408+50

Earth

22.0	428.5
24.0	431.0
25.0	434.0
32.0	441.0
30.0	438.7
24.0	434.5
22.0	432.0
5.30	



410+50

GRAVEL DRIVE RT

SHOREHAM-BRIDGPORT-ADDIS ON
 F 017-1(2)

408+50-412+00

ADDITION MM 1:50

Plotted R Russell