



DATE	
BY	
NO.	
FINAL SURVEY	
NOTE BOOK	
NO.	
AREAS CHECKED	


DATE	
BY	
NO.	
ORIGINAL SURVEY	
NOTE BOOK	
NO.	
AREAS CHECKED	

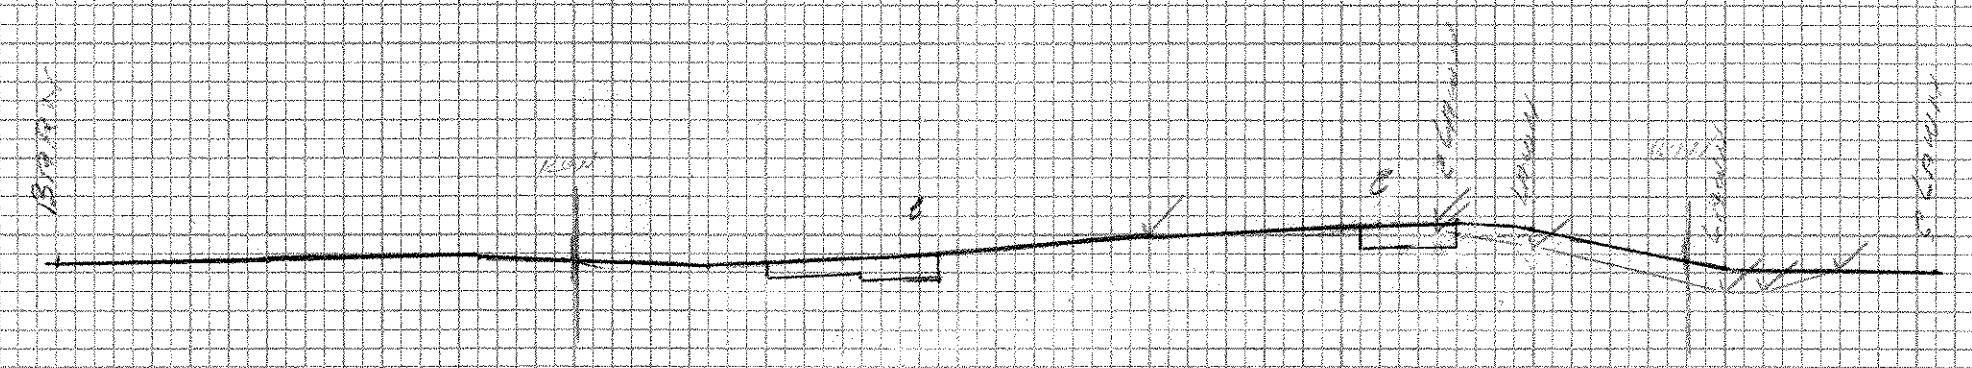

422+00
BARNH BENH LANE RT

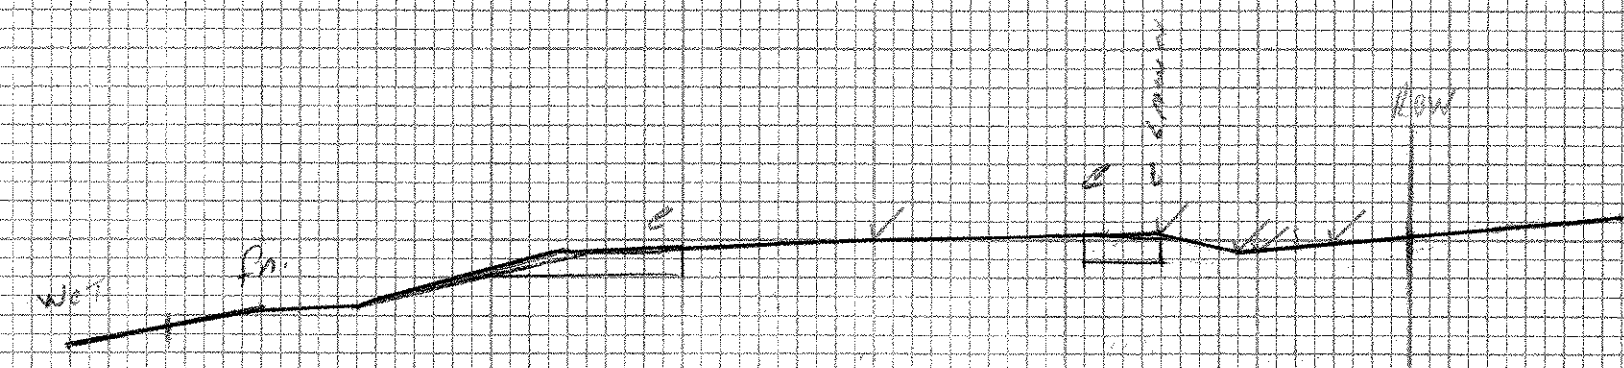

424+00
ENDLAWN RT @ 20

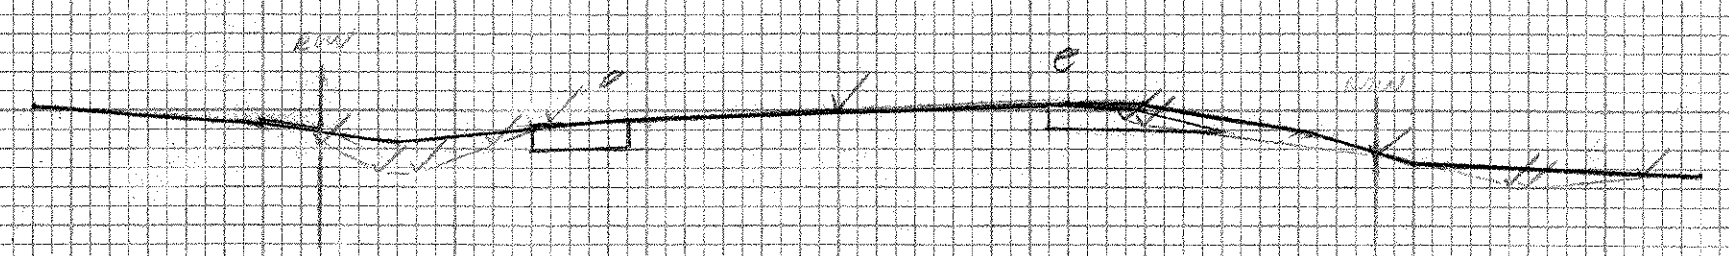


421+50



423+50

EARTH

22.16	419.2
22.16	418.0
22.0	418.8
22.0	418.4
22.0	417.6
22.16	418.2
16.5	

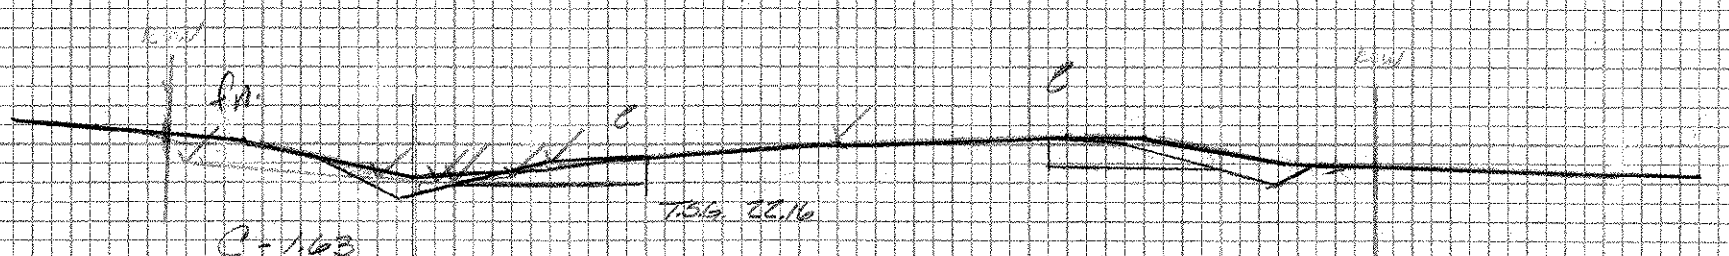


420+50




423+00

EARTH

22.26	500.0
22.26	497.8
24.0	497.9
24.0	499.0
24.0	500.1
24.0	500.2
23.26	500.0
18.30	

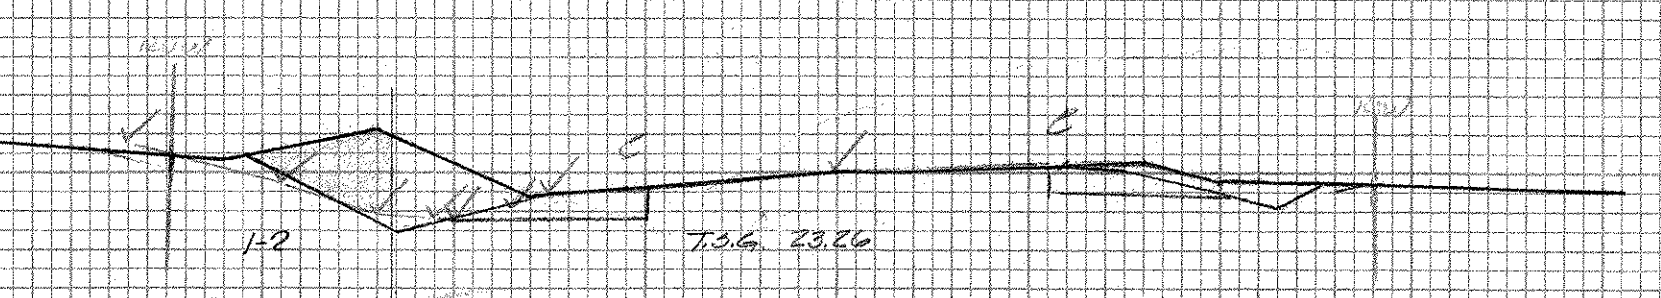

420+00

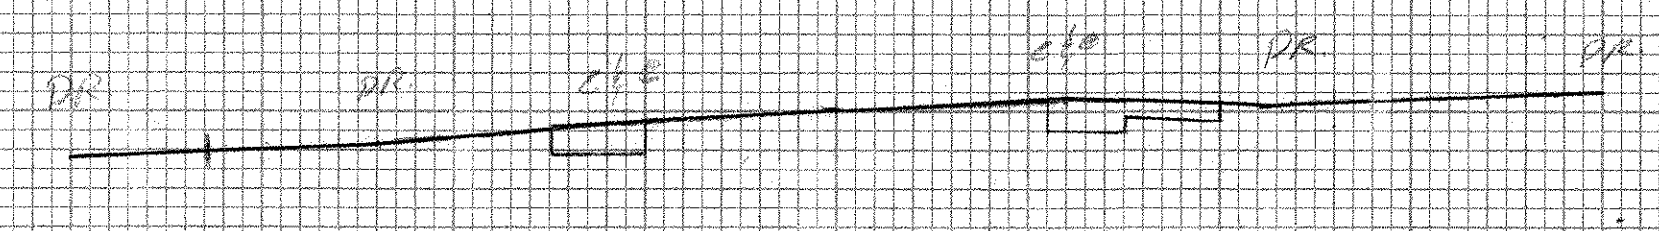

422+50
BARNH RT HQ GR DRIVE RT

SHOREHAM-BRIDPORT-ADDIS ON

F 017-1(2)

420+00-424+00

ADDITIONAL SHEETS

Plotted P. Russell
sheet 404-I of 477