
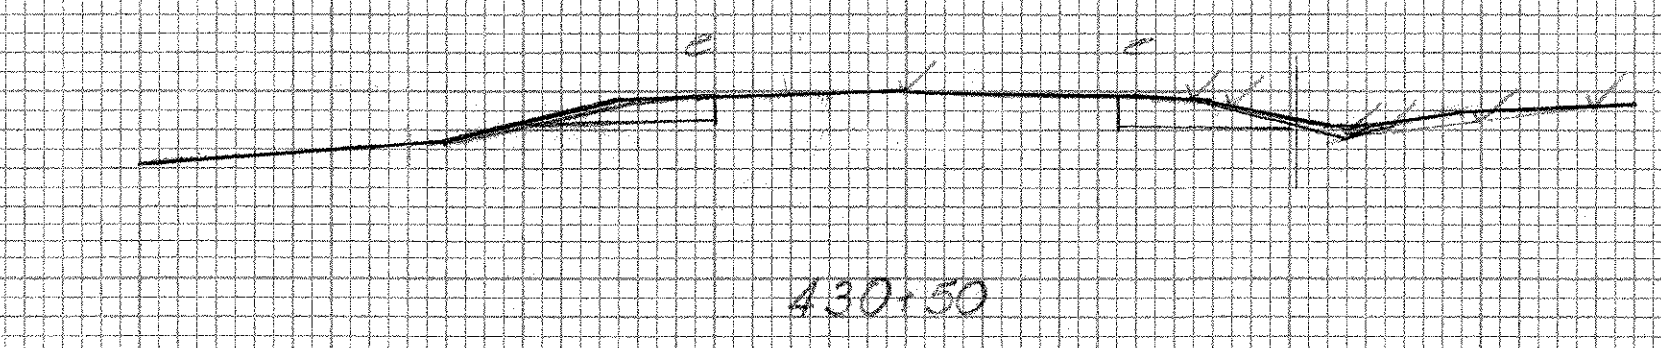
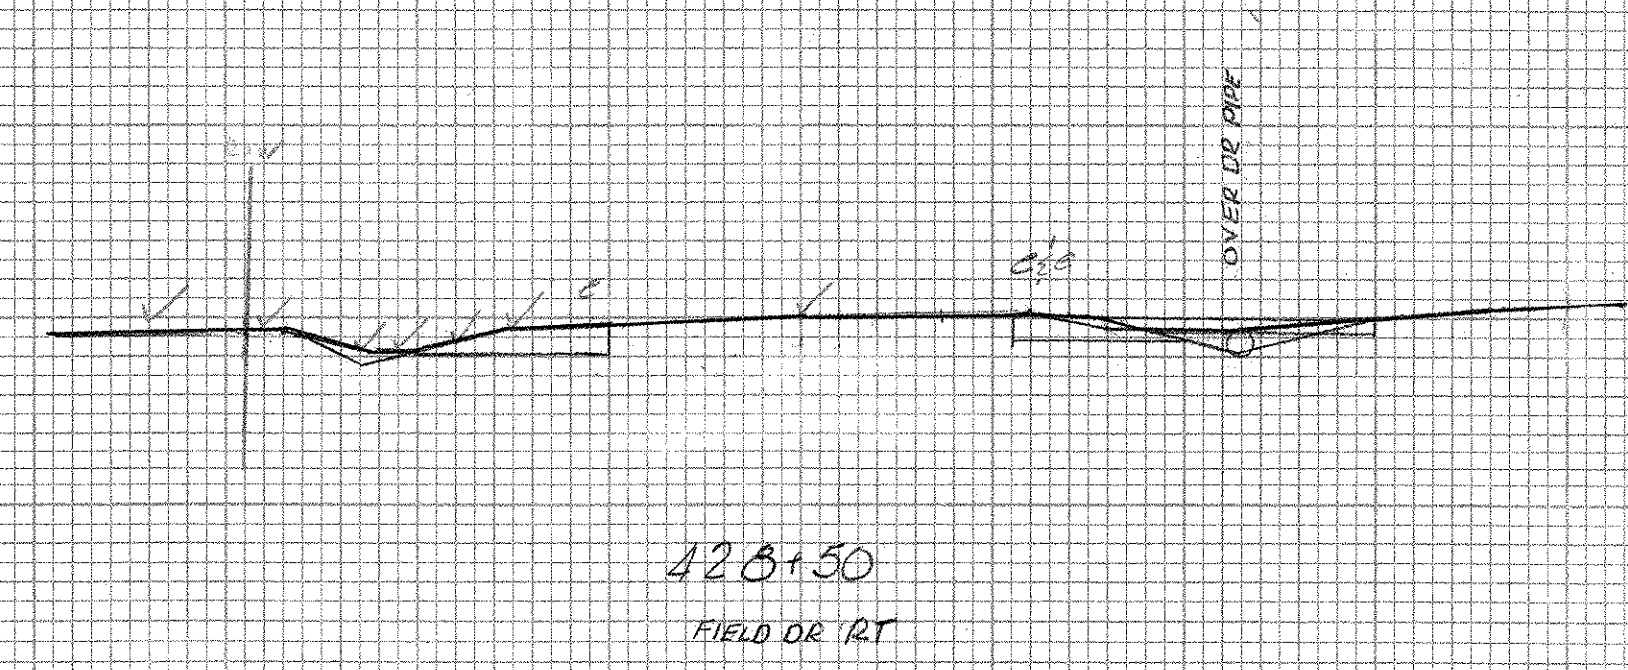
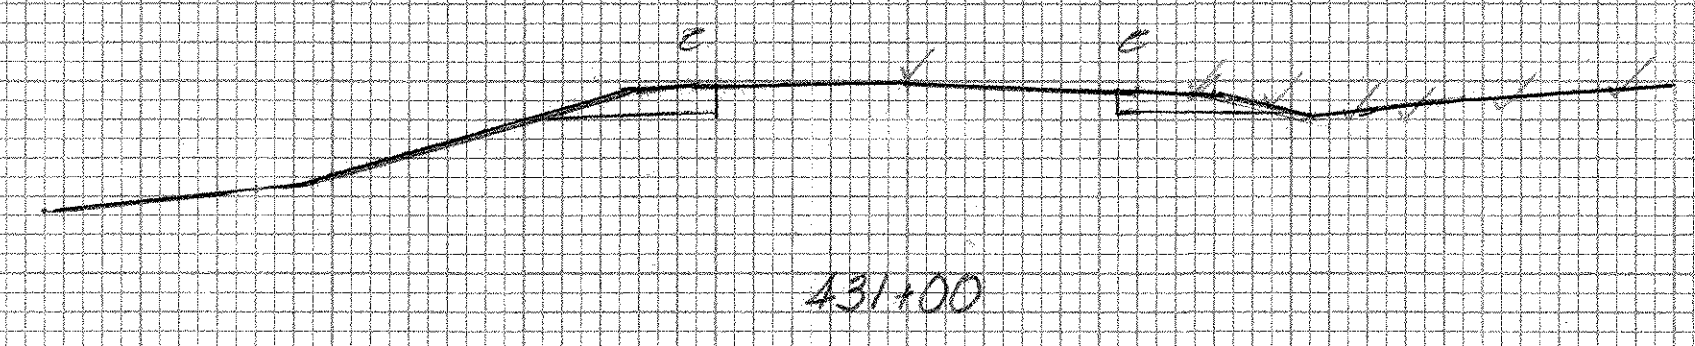
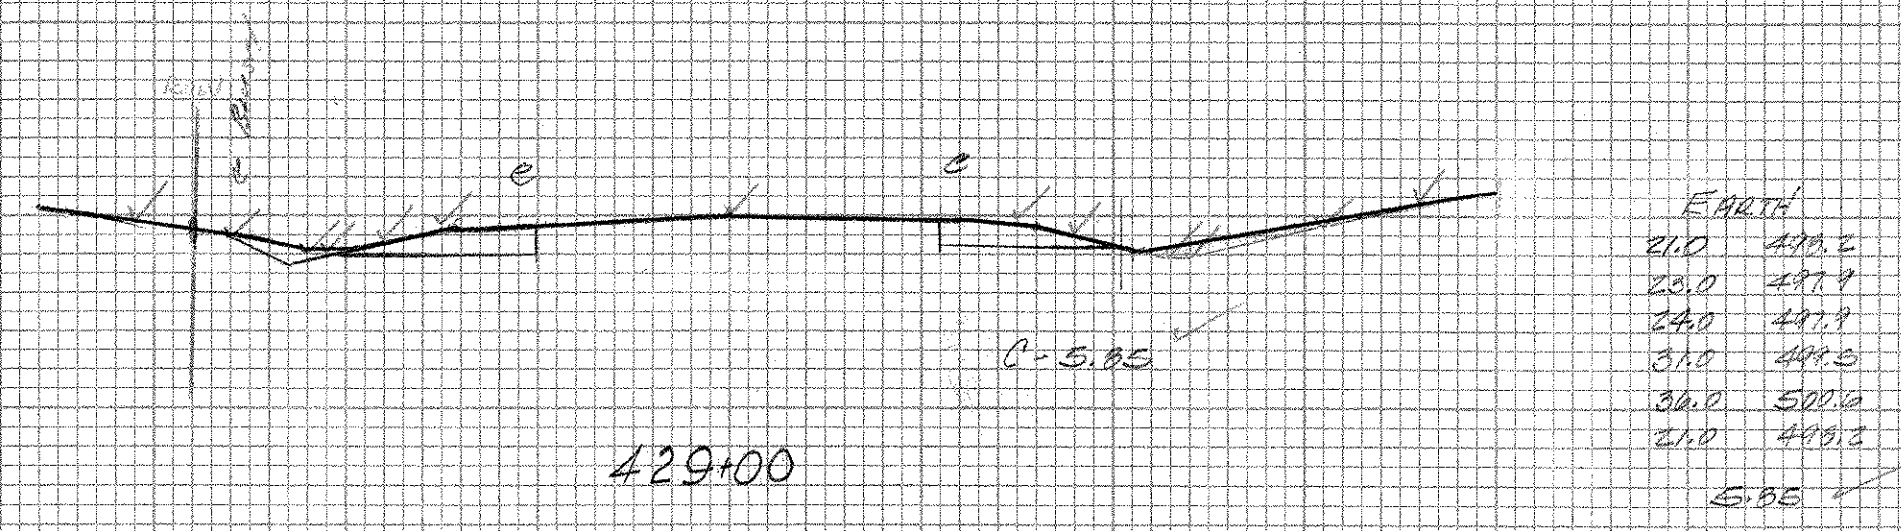
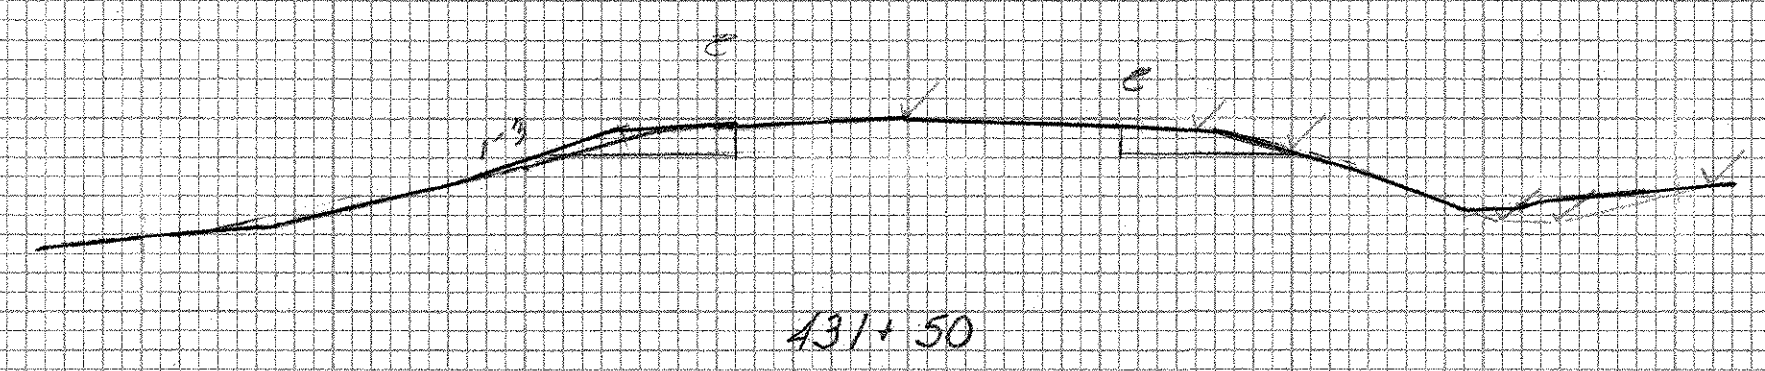
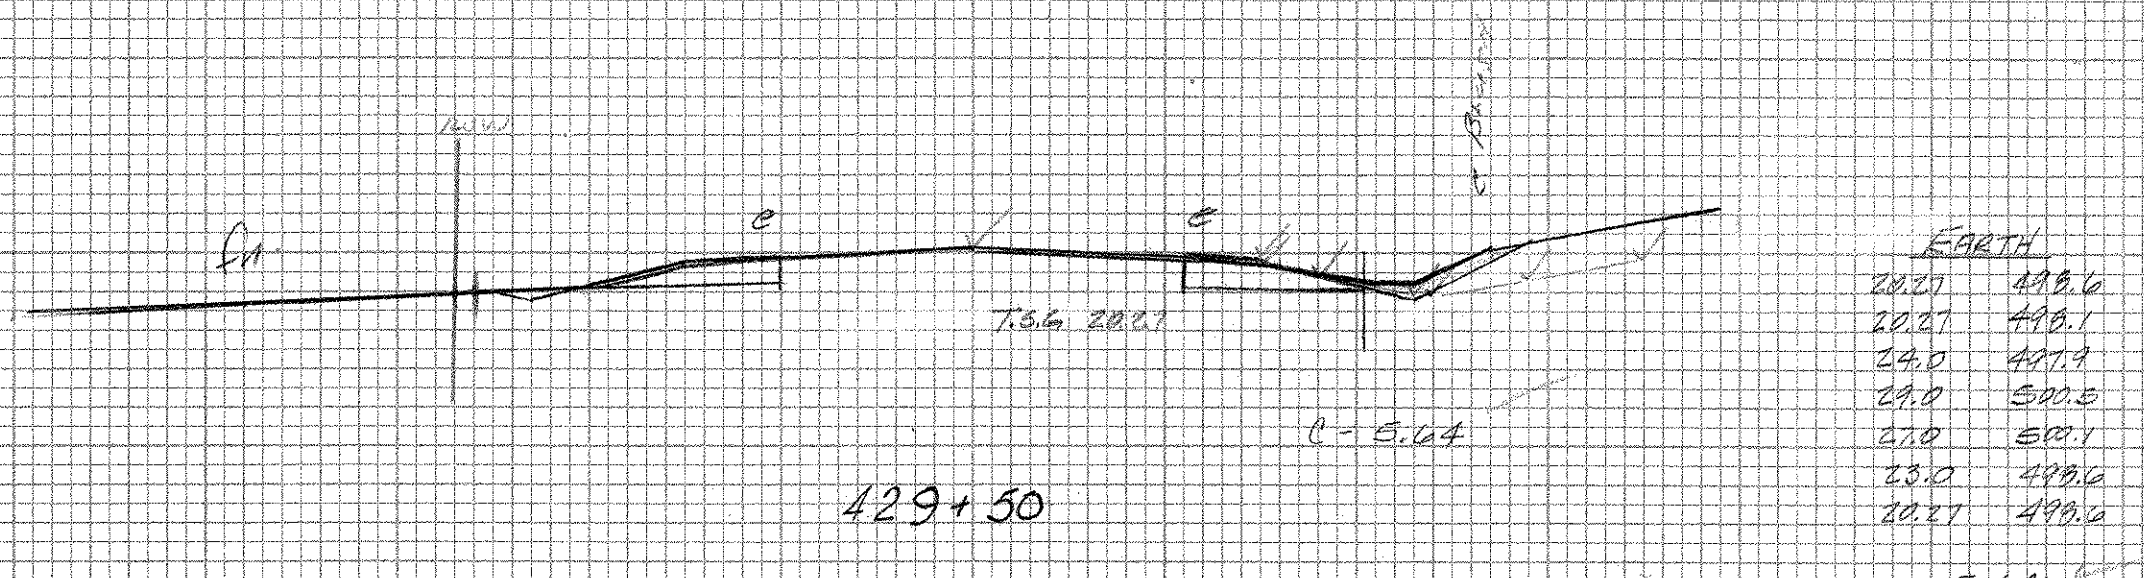
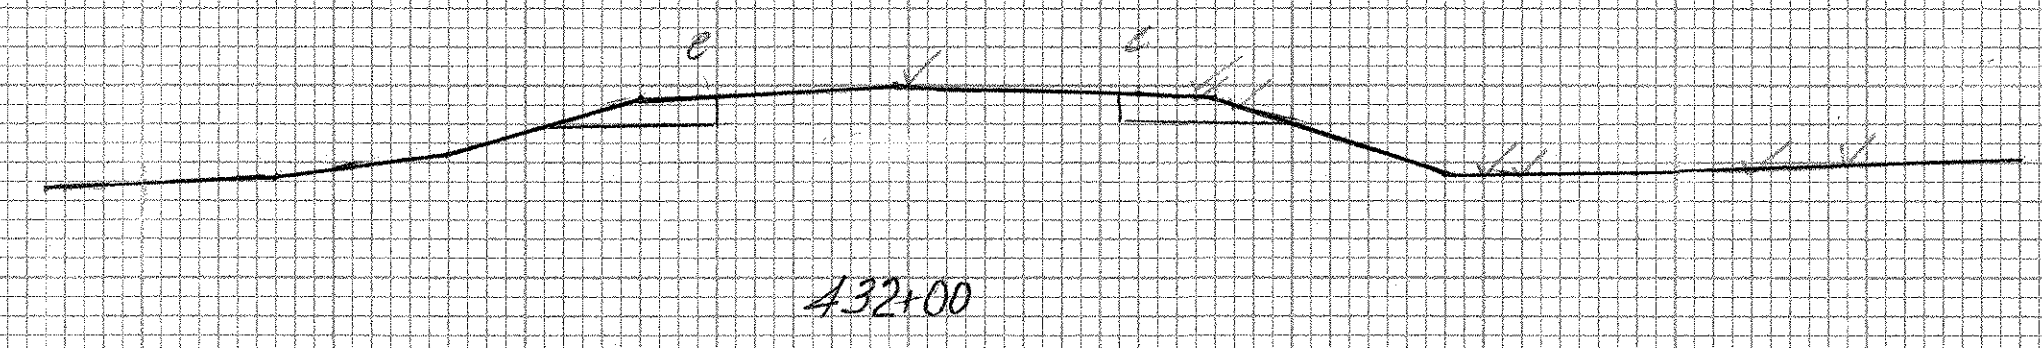


DATE _____ BY _____
 SURVEYED _____ PLOTTED _____
 FINAL SURVEY NOTE BOOK NO. _____
 AREAS CHECKED _____

DATE _____ BY _____
 SURVEYED _____ PLOTTED _____
 ORIGINAL SURVEY NOTE BOOK NO. _____
 AREAS CHECKED _____

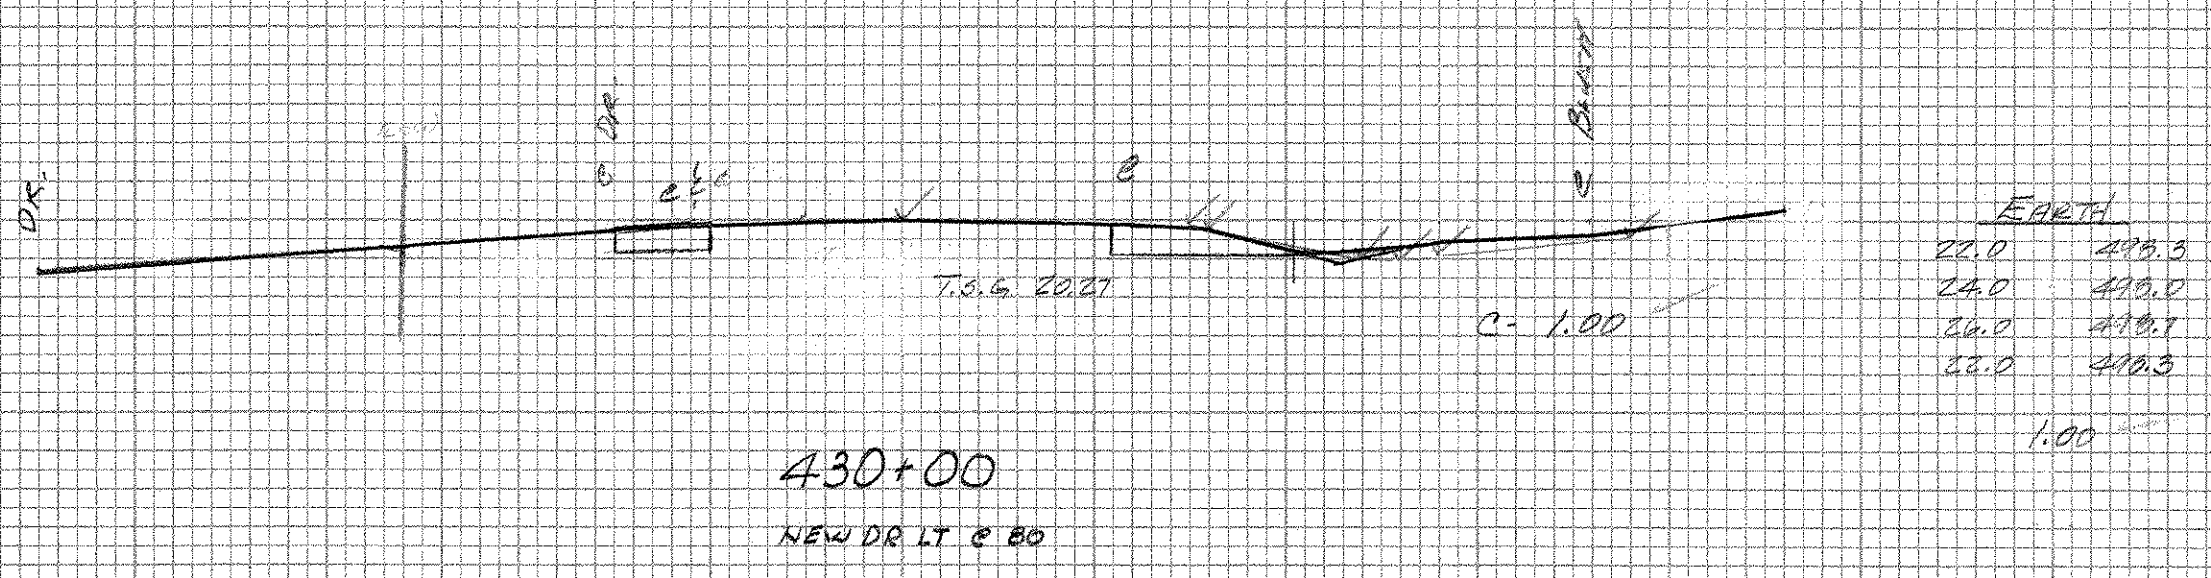

SHOREHAM-BRIDDPOR-ADDISON
 FO17-1(2)
 428+50-432+00
 ADDITION MM 1-601
 Plotted R. Ross
 sheet 404-K of 477

C.S. 456 5-4-92