
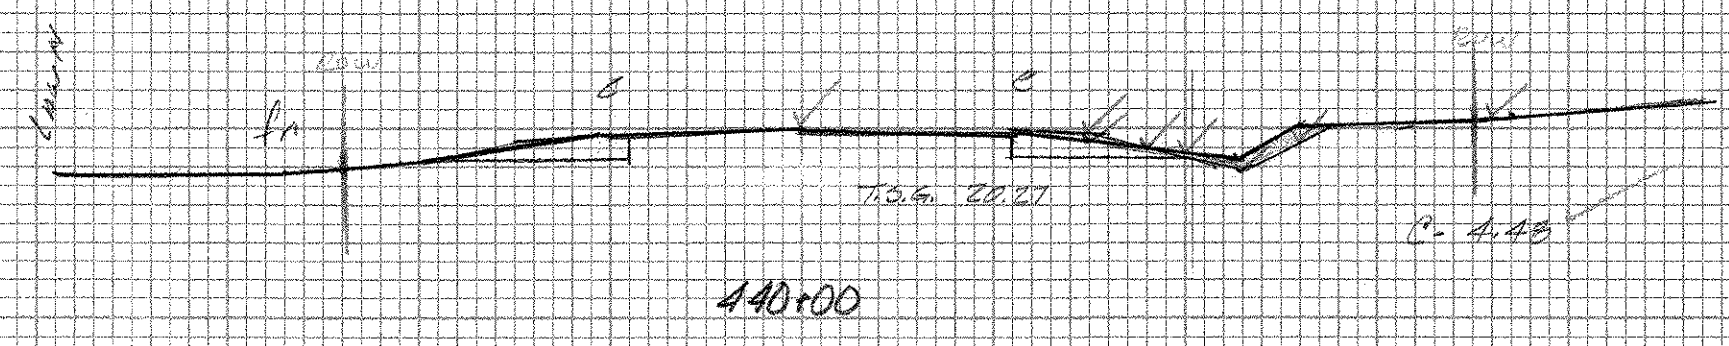


DATE _____ BY _____
 SURVEYED _____ PLOTTED _____
 ORIGINAL SURVEY NOTE BOOK NO. _____
 AREAS CHECKED _____






DATE _____ BY _____
 SURVEYED _____ PLOTTED _____
 ORIGINAL SURVEY NOTE BOOK NO. _____
 AREAS CHECKED _____

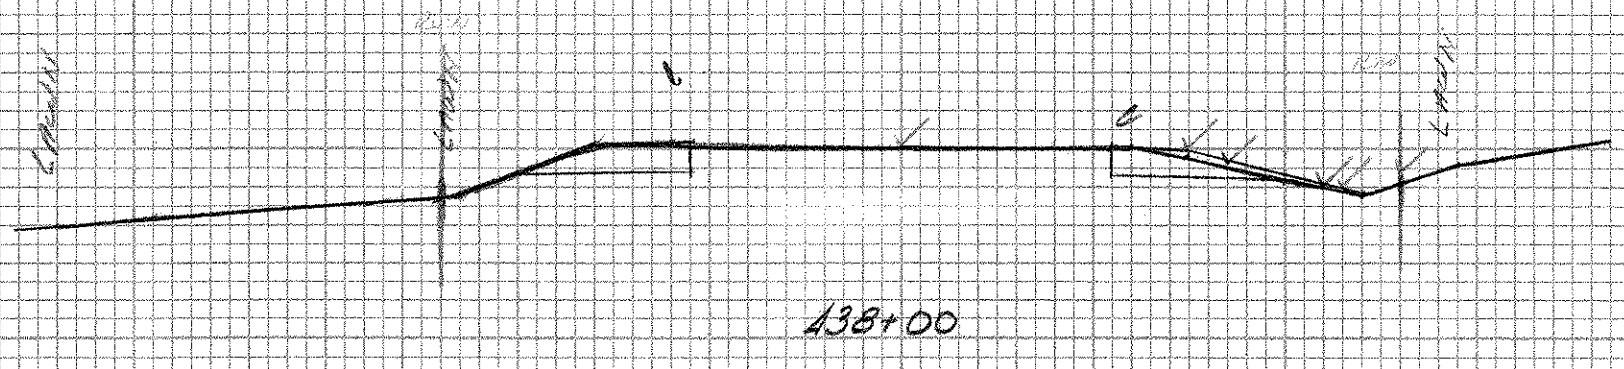

EARTH

20.27	428.1
22.0	428.5
23.0	428.8
24.0	429.0
25.0	429.3
26.0	429.7
28.0	430.7
28.0	430.7

4.45

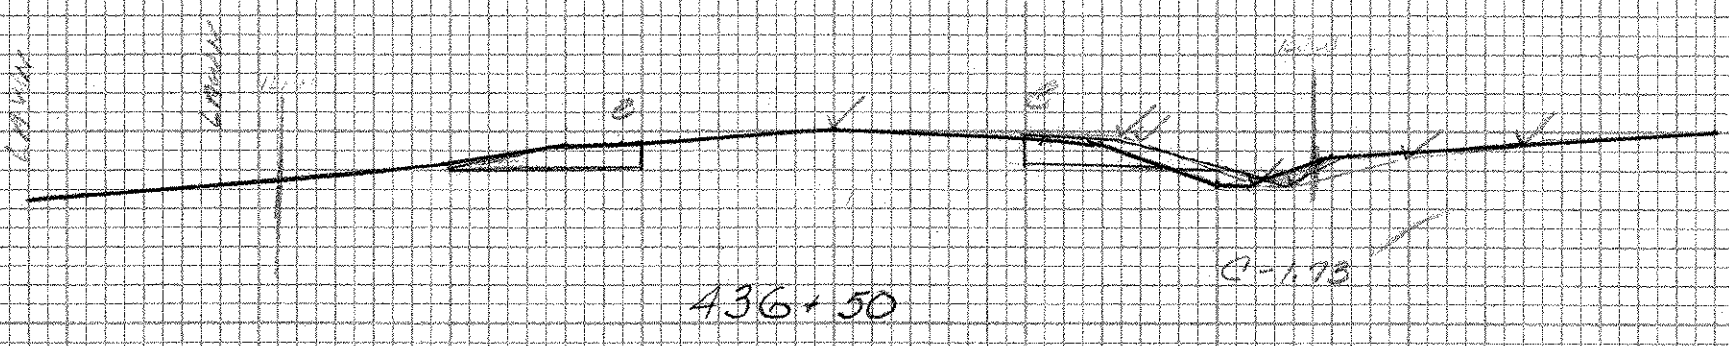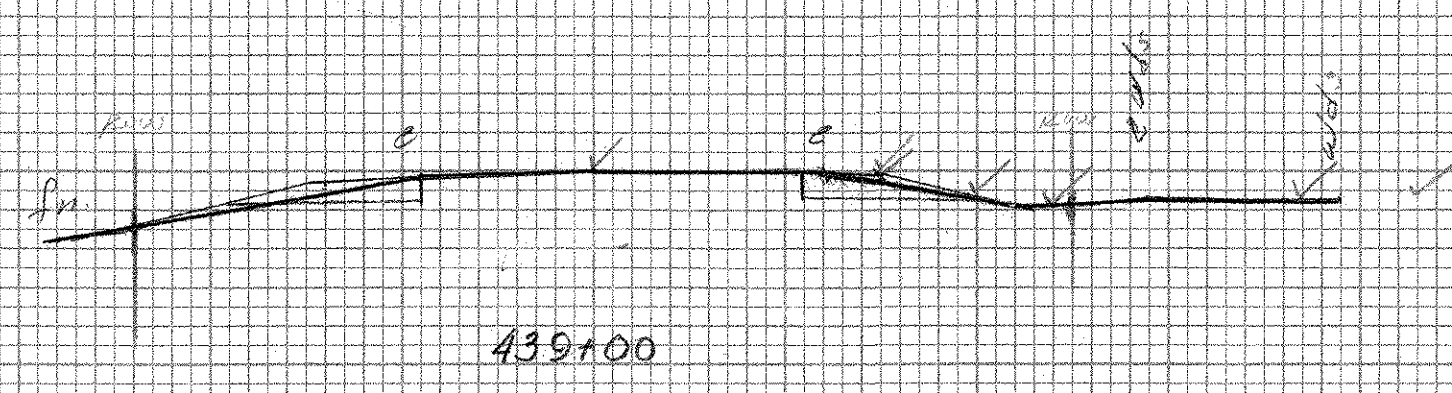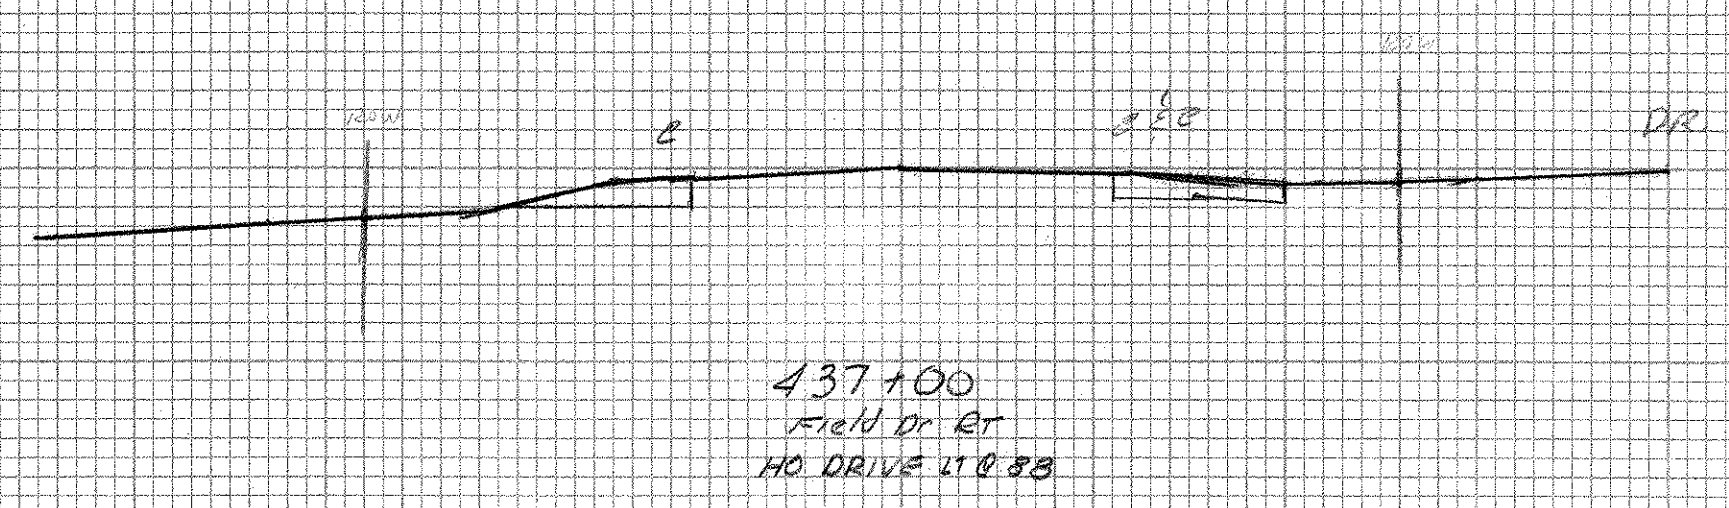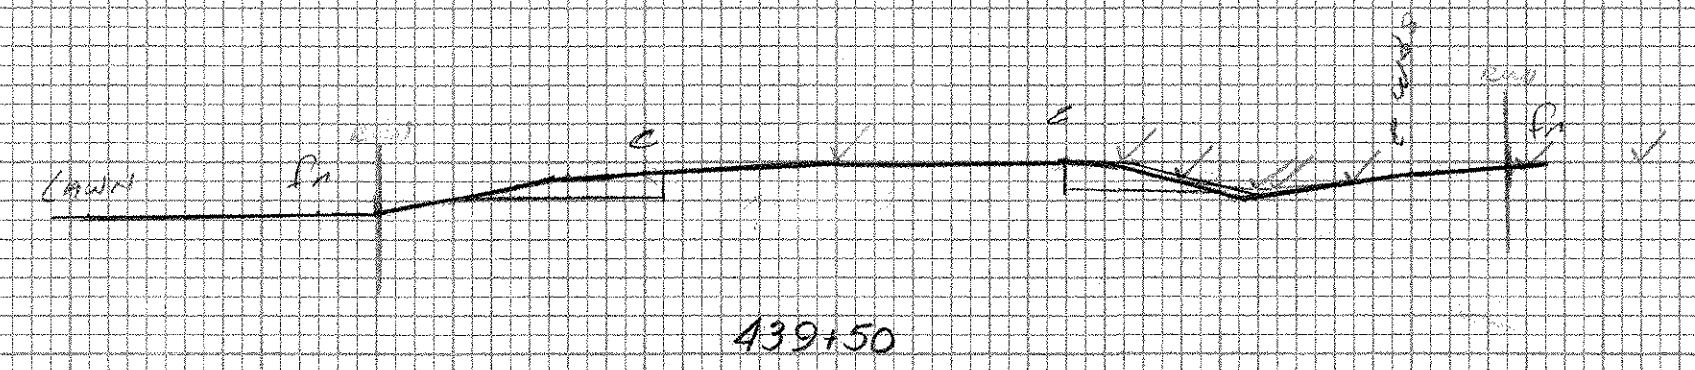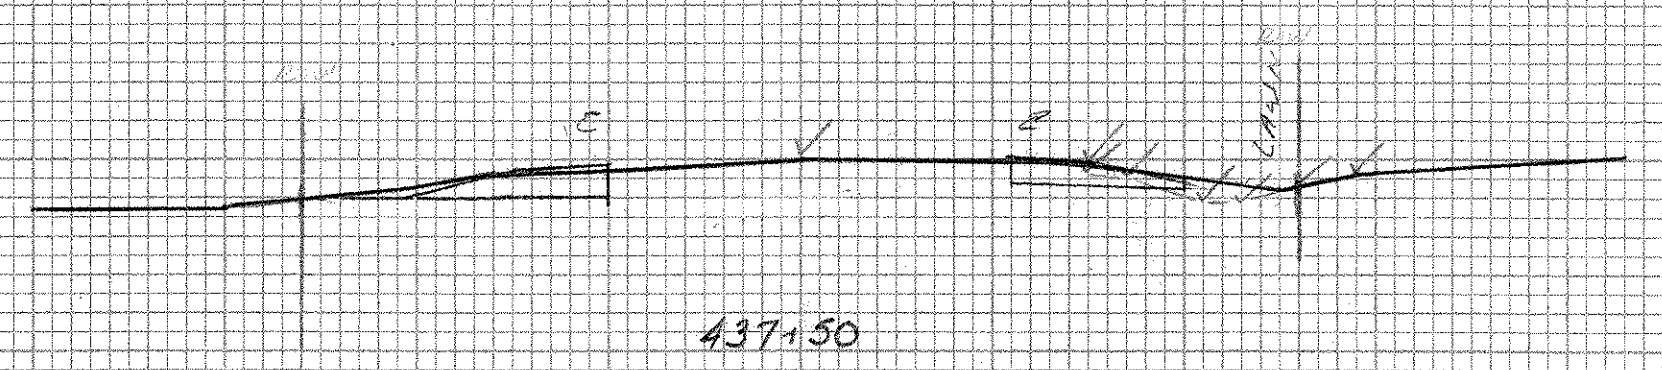

EARTH

22.5	427.0
22.0	427.2
21.0	426.7
22.5	427.0

1.75



SHOREHAM-BRIDPORT-ADDISON
 FO17-1(2)
 ADDISON MM 160+
 436+50-440+00
 11/15/92 E. Russell
 sheet 404-M of 477

436 5-4-92