



DATE	
BY	
APPROVED	
ADJUSTED	
TEMPLATE	
NOTE BOOK	
NO.	


DATE	
BY	
APPROVED	
ADJUSTED	
TEMPLATE	
NOTE BOOK	
NO.	

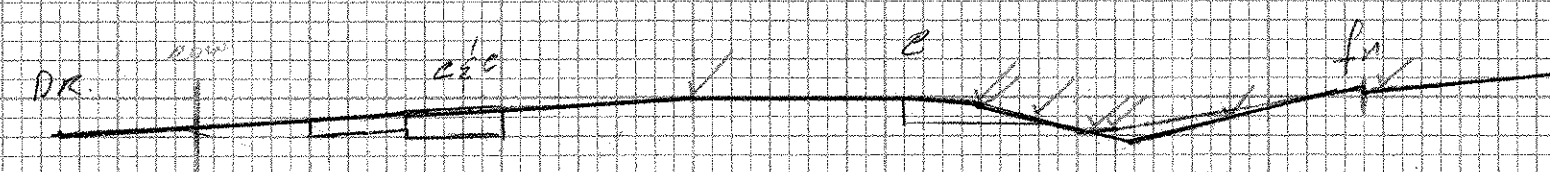


422+00
HOUSE OR LOT

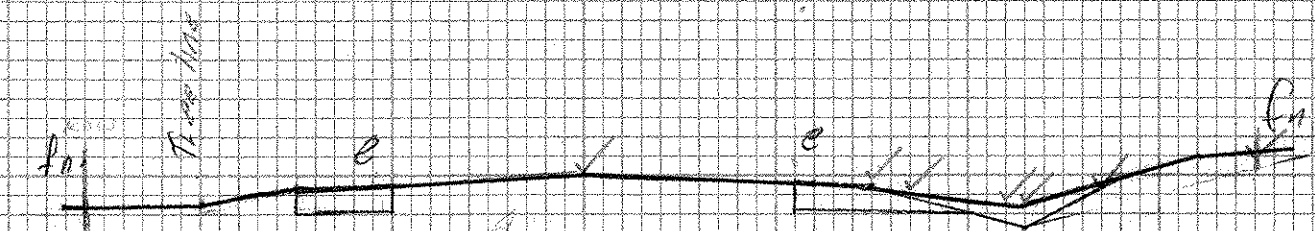


441+50

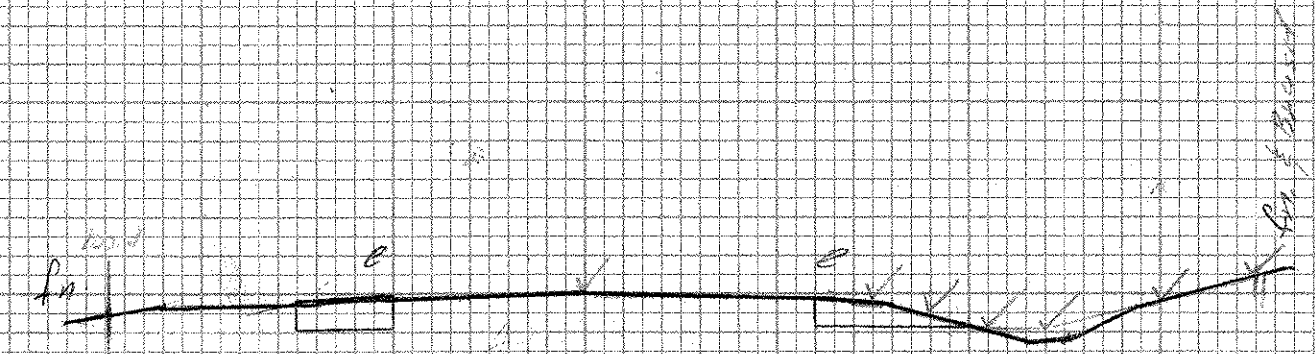


441+00

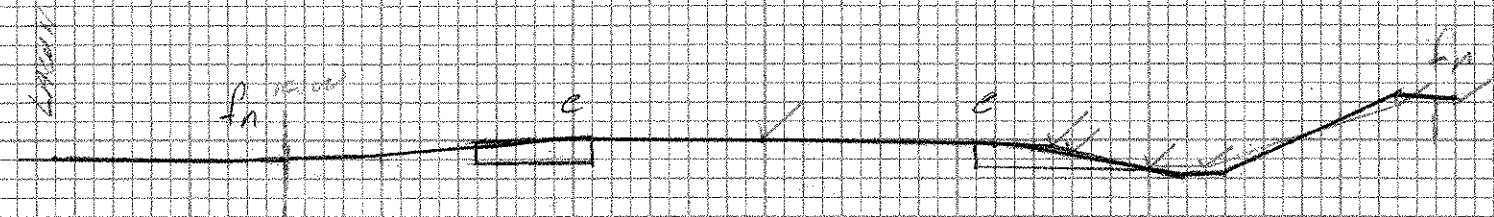


440+50

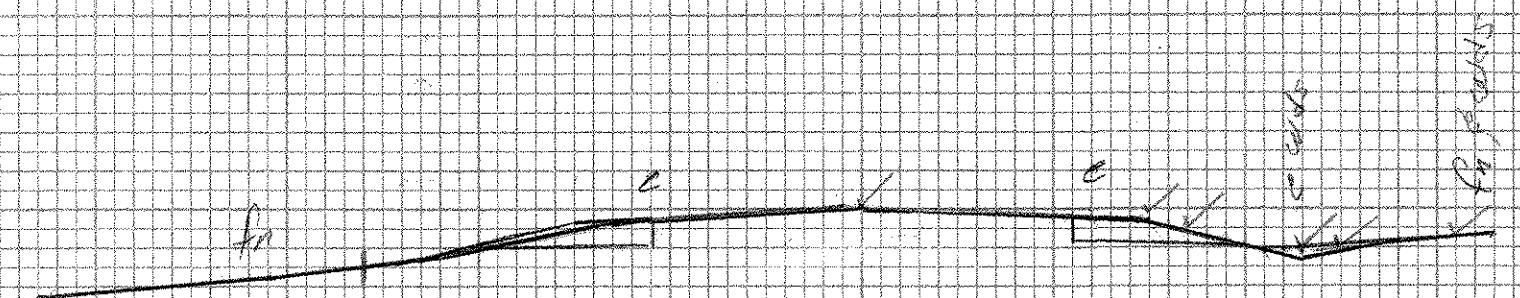

443+50

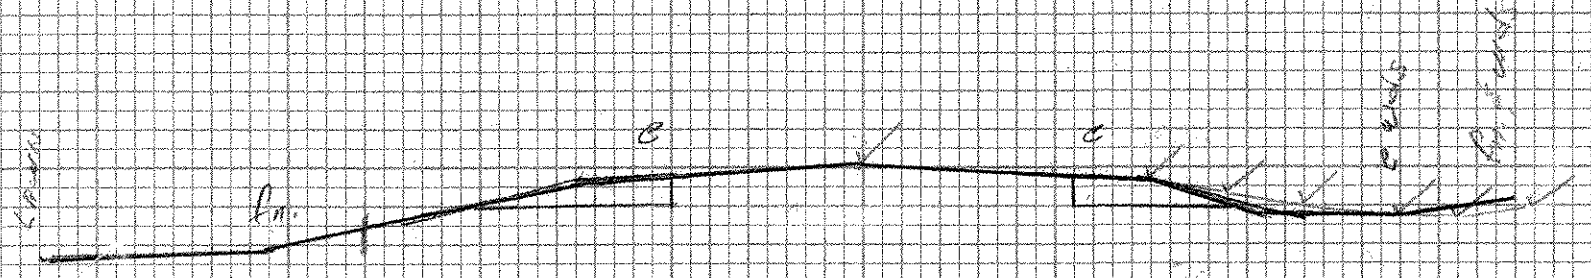

443+00

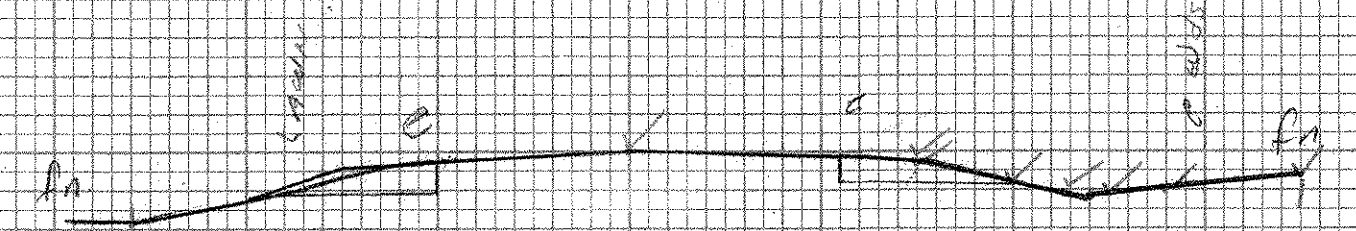

442+50

SHOREHAM-BRIDPORT-ADDISON

F 017-1(2)

440+50-443+50

Photo B Russell
sheet 404-N of 477